

O.D.O.T. DISTRICT 2 SURVEY OFFICE (USE ONLY)

PERSONNEL

REFERENCE NO. 15 B

SHEET 37 OF 47

NOTES RHOADES

DATE 4/29/19

ROUTE SR 120

H.C. O'DONNELL

WEATHER CLOUDY

COUNTY FULTON

R.C. RHOADES

TEMP. 42°

TOWNSHIP AMBOY

SECTION 8

DWG BY NASON

PID 101243

T 9 N R 4 E

TYPE MONUMENT MAG/WASHER

ON SURFACE - ~~BELOW~~ ON

OFFSET ☐ PAVEMENT 1.2' LT : RT

8.9' TO RT EDGE PAVEMENT


STATION: 586+09.99

HORZ.DATUM: NAD83(2011)


GEOID: 2012A

GRID: NORTHING: 748692.913

EASTING: 1567767.024

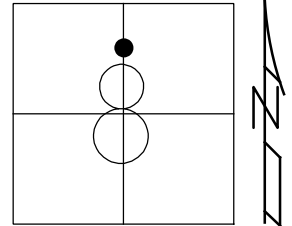



FD MAG/WASHER
5/20/11, RJL
REFB15
5/23/11, RJL
FD MAG/WASHER
REFB15
3/5/19, JFO
SET MAG/WASHER
7/26/19

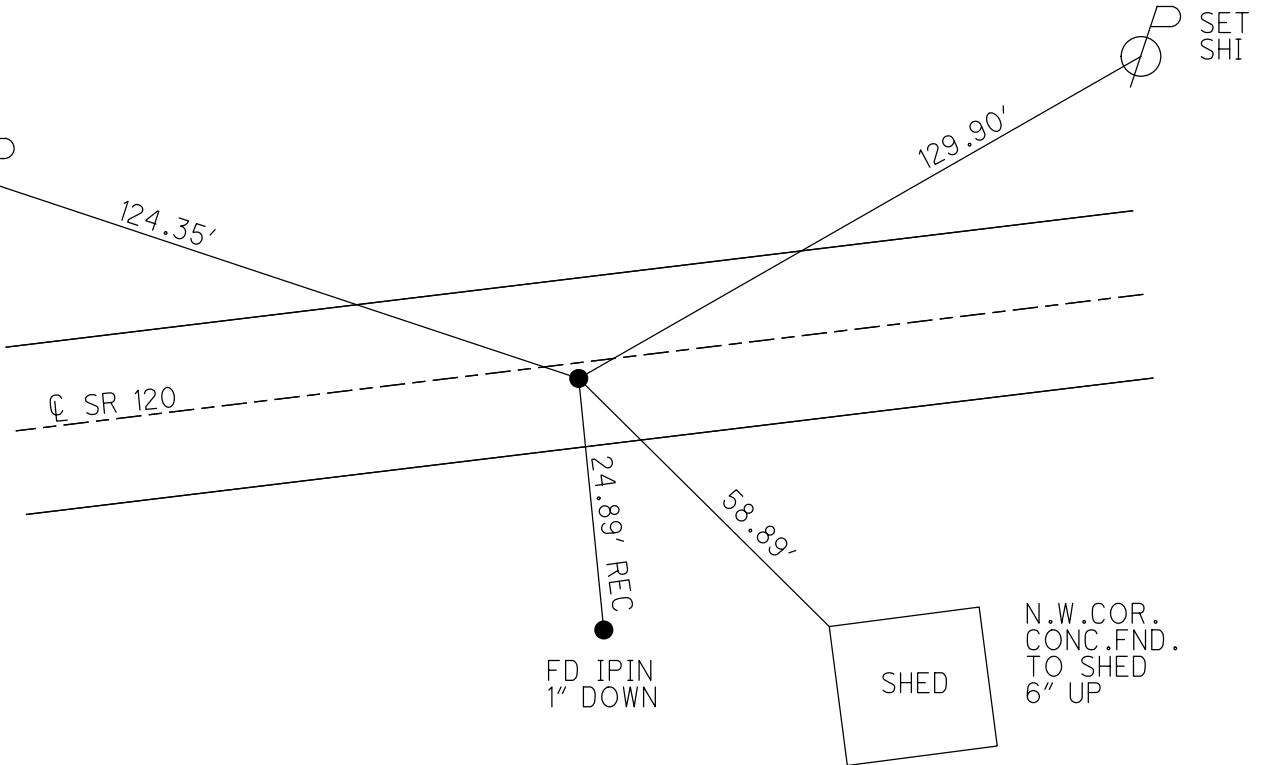

O.D.O.T. DISTRICT 2 SURVEY OFFICE

PERSONNEL	REFERENCE NO. <u>15 B</u>	SHEET <u>37</u> OF <u>45</u>
NOTES <u>FINGER</u>	DATE <u>5/23/11</u>	ROUTE <u>SR 120</u>
H.C. <u>LUMBREZER</u>	WEATHER <u>CLOUDY</u>	COUNTY <u>FULTON</u>
R.C. <u>MOSER</u>	TEMP. <u>65°</u>	TOWNSHIP <u>AMBOY</u>
		SECTION <u>8</u>
		T <u>9</u> N R <u>4</u> E

TYPE MONUMENT MAG/WASHER
 ON SURFACE - ~~BELOW~~ ON
~~LEFT~~ - Q PAV'T - RIGHT 1.2'
8.9' TO RT EDGE PAVEMENT
 S.L.M. 585+77

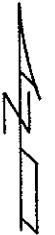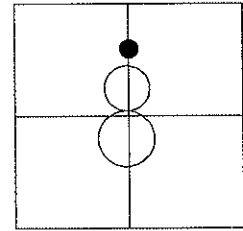


Grid: Northing: 748692.873 Easting: 1567766.950

FD MAG/WASHER
5/20/11, RJL

GPS, REFB15
5/23/11, RJL

FD SHI
SW/S

FD SHI
SE/S

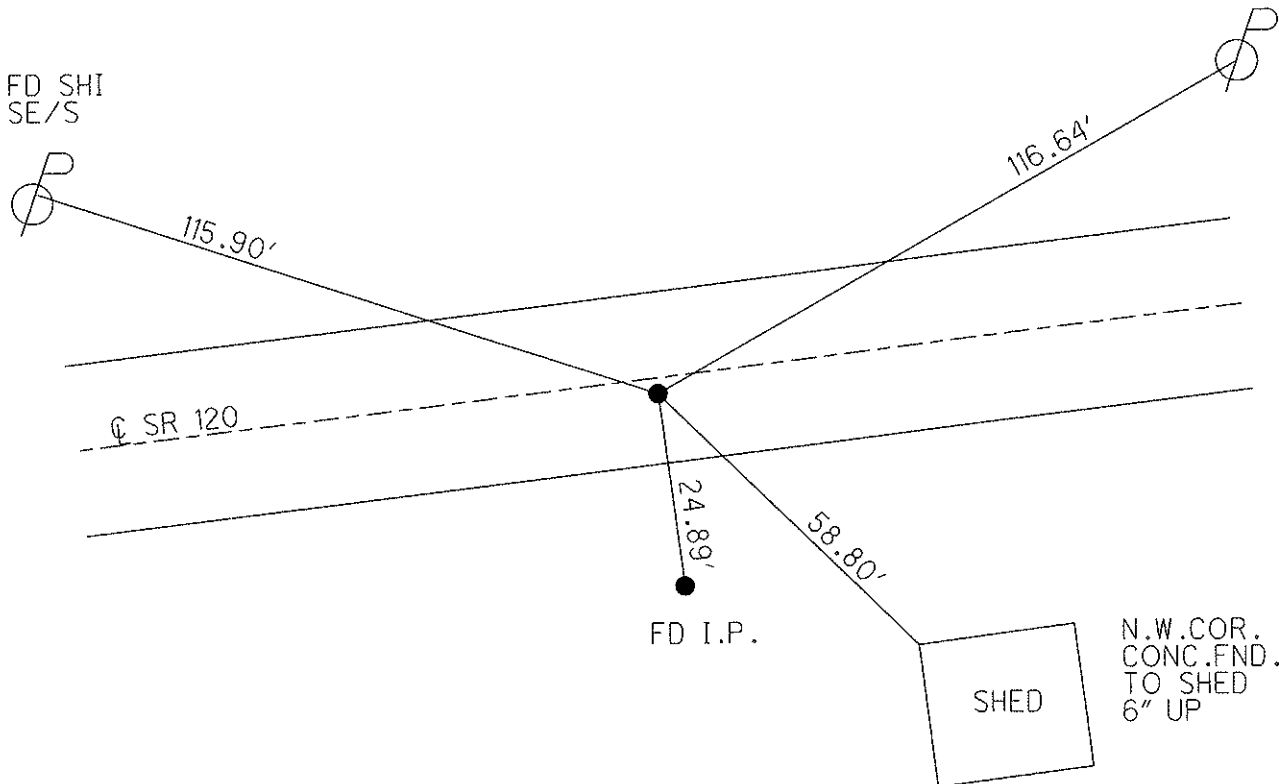

O.D.O.T. DISTRICT 2 SURVEY OFFICE

PERSONNEL _____

REFERENCE NO. 15-B

SHEET 13 OF 18

NOTES HOMAN

DATE 8-15-03

ROUTE SR 120

H.C. HOMAN

WEATHER SUNNY

COUNTY FULTON

R.C. MEYERS

TEMP. 75°

TOWNSHIP AMBOY

SECTION 8

T 9 S R 4 E



TYPE MONUMENT PK NAIL & WASHER

ON SURFACE - ~~BELOW~~ ON

~~LEFT - C~~ PAV'T - RIGHT 1.2'

8.9 TO RT EDGE PAVEMENT

S.L.M. 585+77

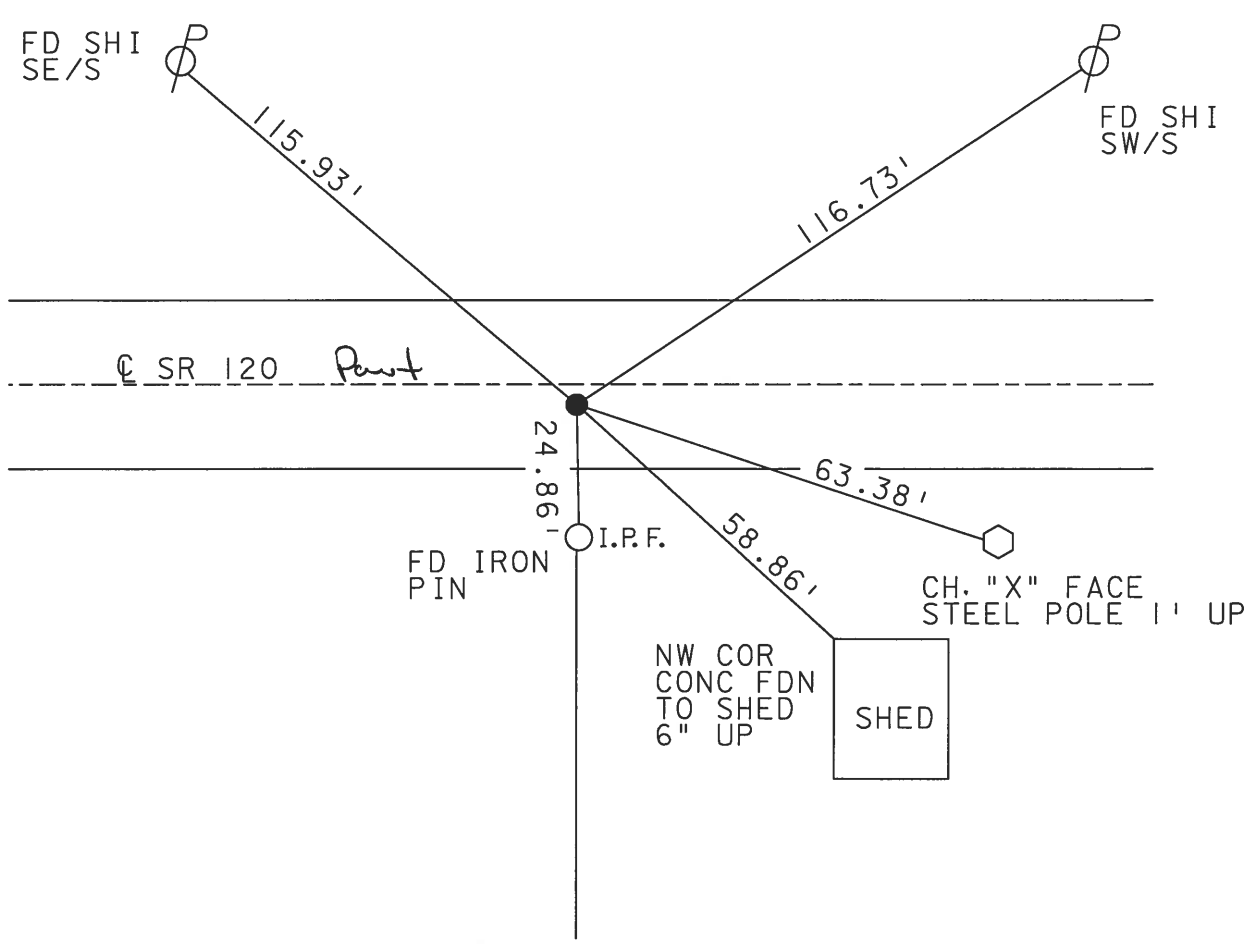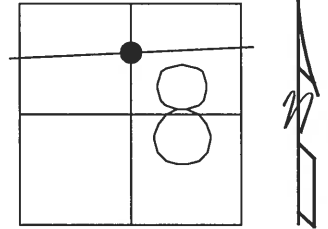

O.D.O.T. DISTRICT 2 SURVEY OFFICE

PERSONNEL

REFERENCE NO. 15-A SHEET 8 OF _____

NOTES 1. Stone

H.C. D. Curtis

R.C. J. Householder

DATE 18 April 91

WEATHER Cool

TEMP. 50°

ROUTE SR#120

COUNTY Fulton

TOWNSHIP Amboy

SECTION _____

T _____ R _____

TYPE MONUMENT PK Nail



ON SURFACE - BELOW Surface

~~LEFT~~ - C PAV'T. - RIGHT 1.2'

8.9 TO Rt EDGE PAVEMENT

S.L.M. 585+77

Set PK/WASHER
3-18-92

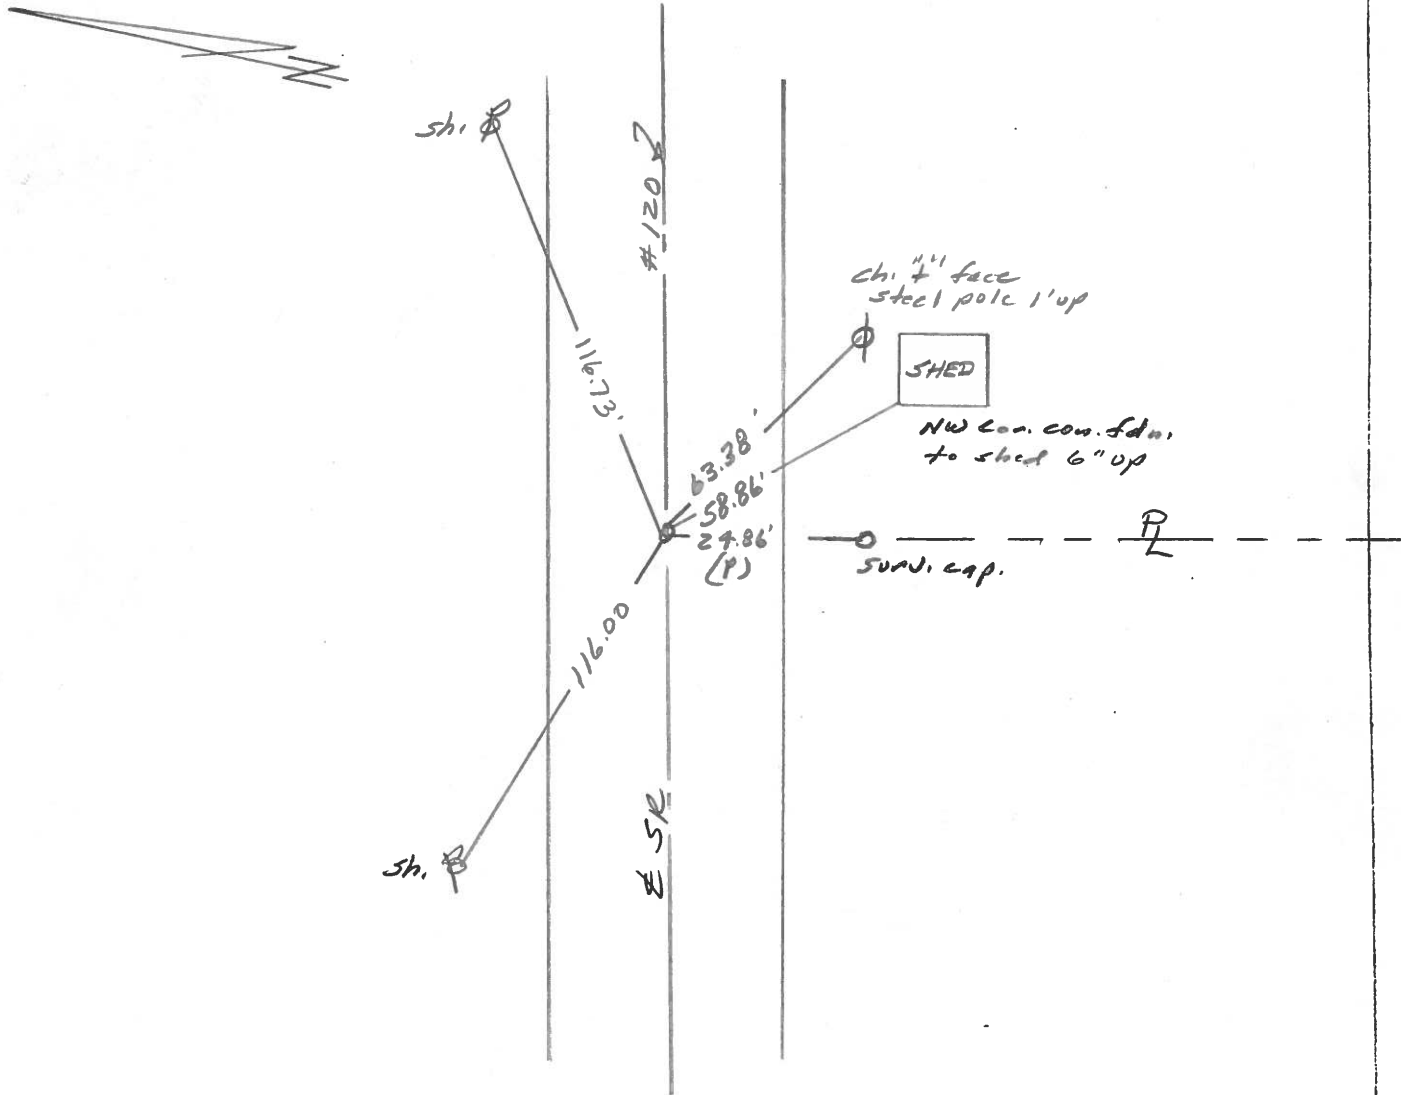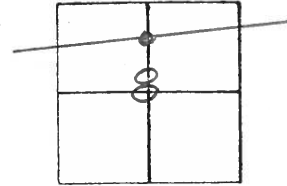

O.D.O.T. DISTRICT 2 SURVEY OFFICE

SHEET 6 OF

County Fulton S.R. 120

Date 12 May 81

Township Amboy

Weather Clear

Section 8

Temp. 58°


T N, R E

Personnel I. Stone


P. Neuser

R. Michalski

D. Curtis

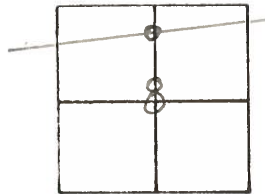

REF. No. 15-A

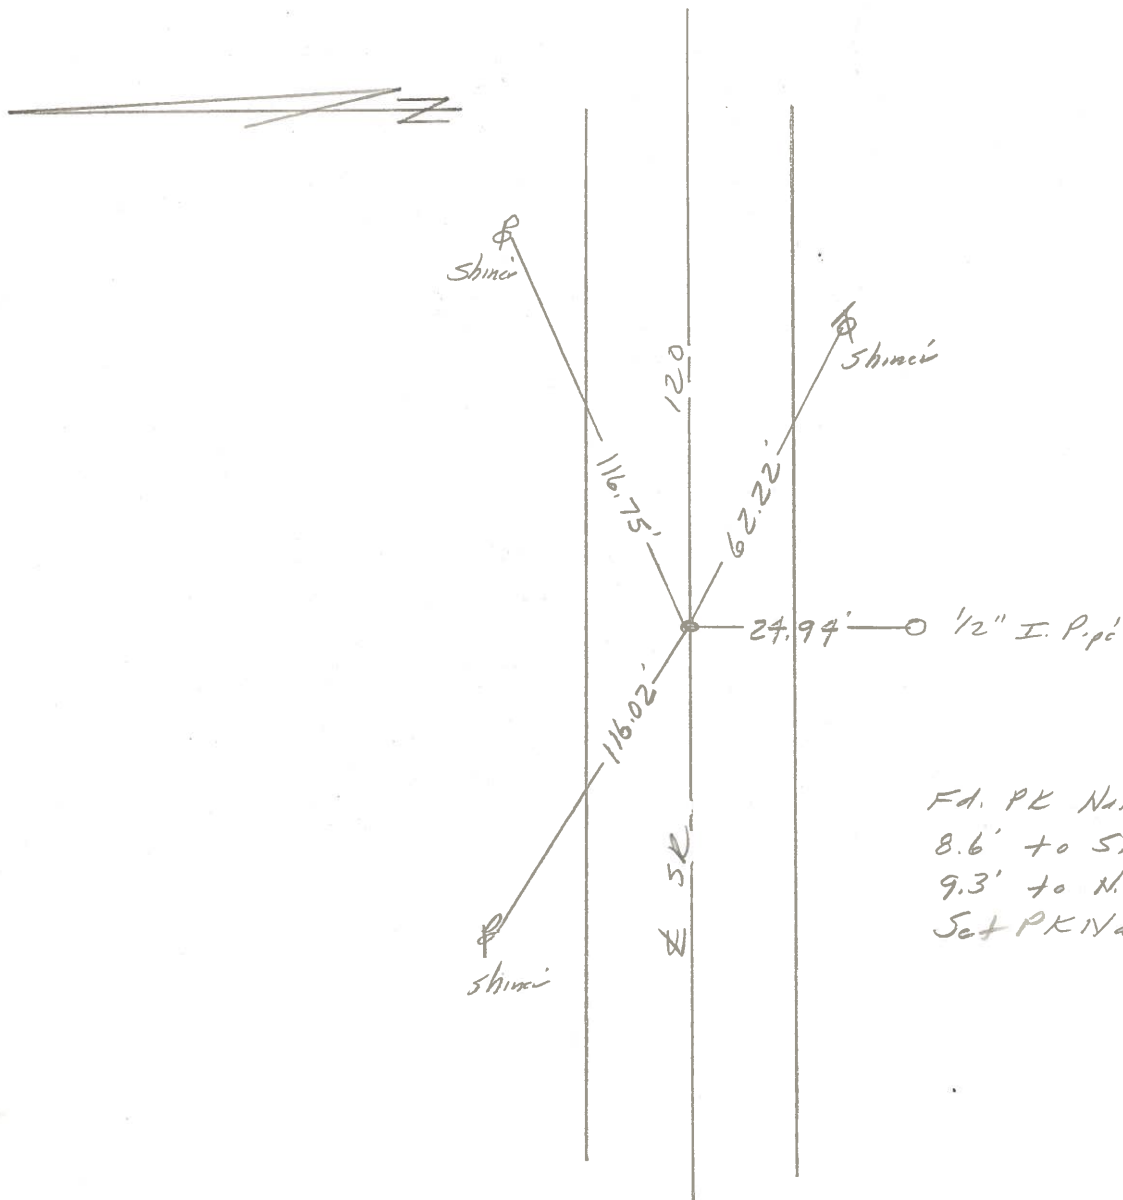

Fd. PK Nail To Surface
8.6' to S. edge put,
9.3' to N. edge put.
Set PK Nail 7/28/81