


O.D.O.T. DISTRICT 2 SURVEY OFFICE (USE ONLY)


PERSONNEL _____ REFERENCE NO. 16 A SHEET 41 OF 47
 NOTES O'DONNELL DATE 4/29/19 ROUTE SR 120
 H.C. RHOADES WEATHER CLOUDY COUNTY FULTON
 R.C. O'DONNELL TEMP. 47° TOWNSHIP AMBOY
 DWG BY NASON PID 101243 SECTION 9
 T 9 N R 4 E

TYPE MONUMENT P.K. NAIL
 ON SURFACE - ~~BELOW~~ ON _____
 OFFSET \odot PAVEMENT 0.8' LT : ~~RT~~
9.4' TO LT EDGE PAVEMENT
 STATION: 641+01.17

HORZ. DATUM: NAD83 (2011) GEOID: 2012A
 GRID: NORTHING: 749146.674 EASTING: 1573238.326

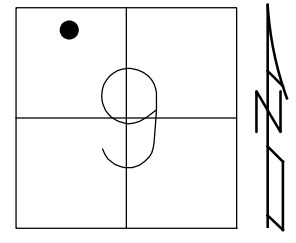

FD P.K. NAIL
 5/20/11, RJL
 REF A17
 5/23/11, RJL
 FD P.K. NAIL
 REFA16
 3/5/18, JFO
 SET MAG/WASHER
 8/7/19, JFO

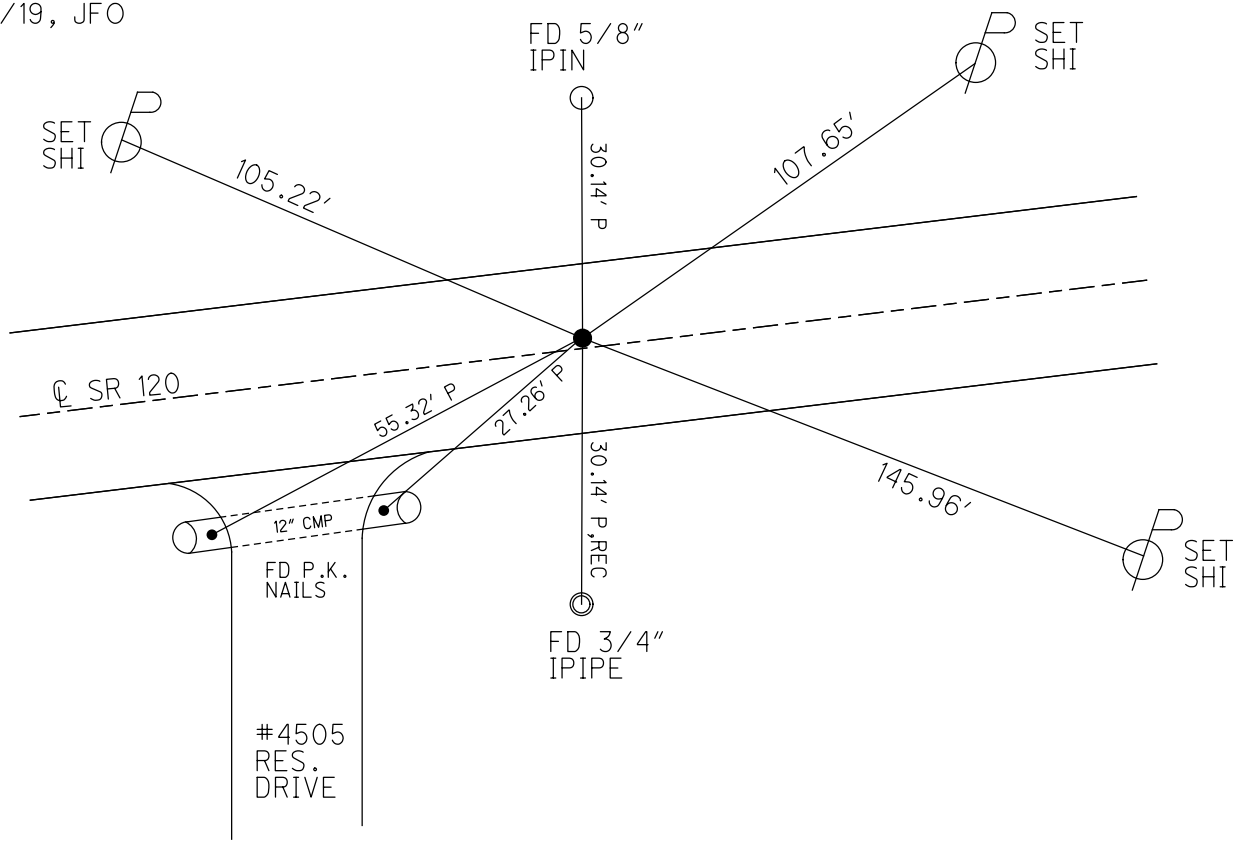

O.D.O.T. DISTRICT 2 SURVEY OFFICE

PERSONNEL

REFERENCE NO. 17

SHEET 42 OF 45

NOTES FINGER

DATE 5/20/11

ROUTE SR 120

H.C. LUMBREZER

WEATHER CLOUDY

COUNTY FULTON

R.C. MOSER

TEMP. 64°

TOWNSHIP AMBOY

SECTION 9

T 9 N R 4 E

TYPE MONUMENT MAG/WASHER


ON SURFACE - ~~BELOW~~ ON

LEFT - ☉ PAV'T - RIGHT ON

10.1' TO LT EDGE PAVEMENT

S.L.M. 654+14


Grid: Northing: 749264.475 Easting: 1574578.817

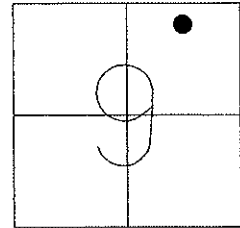

SET MAG/WASHER
8/18/03, DCH

FD MAG/WASHER
5/20/11, RJL

GPS, REF 17
5/20/11, RJL

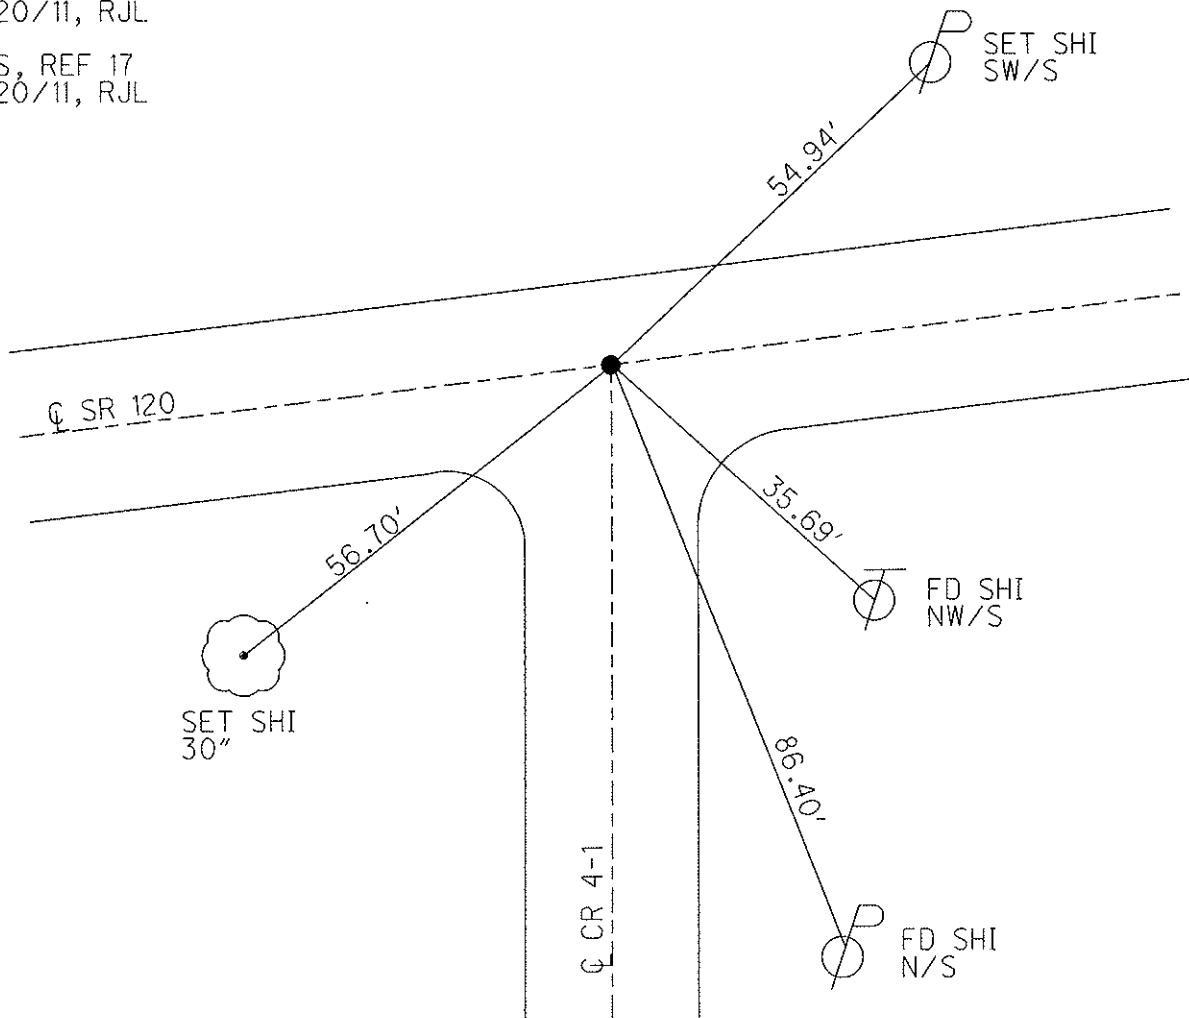

O.D.O.T. DISTRICT 2 SURVEY OFFICE

PERSONNEL

REFERENCE NO. 17

SHEET 17 OF 18

NOTES HOMAN

DATE 8-18-03

ROUTE S.R. 120

H.C. NUFER

WEATHER SUNNY

COUNTY FULTON

R.C. MEYERS

TEMP. 75°

TOWNSHIP AMBOY

SECTION 9 *

T 9 S R 4 E


TYPE MONUMENT PK NAIL & WASHER

ON SURFACE - ~~BELOW~~ ON


~~LEFT - C~~ PAV'T - ~~RIGHT~~ ON

10' TO RT EDGE PAVEMENT

S.L.M. 654+14

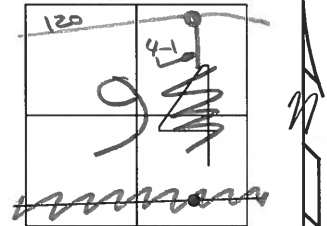

SET MAG & WASHER
8-18-03
DCH

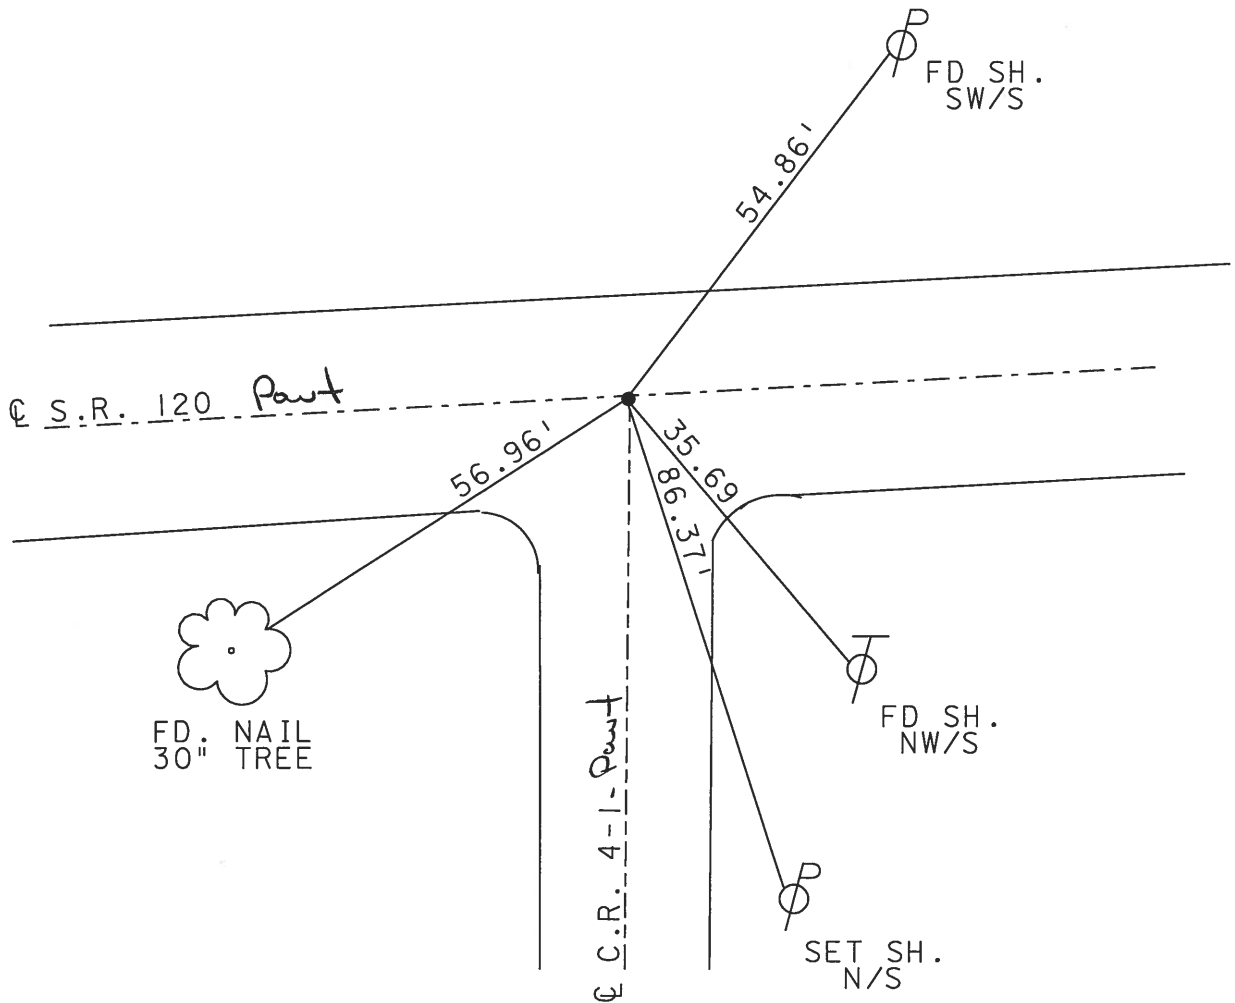

O.D.O.T. DISTRICT 2 SURVEY OFFICE

PERSONNEL _____ REFERENCE NO. 17 SHEET 12 OF _____

NOTES 1. Stone

H.C. D. Curtis

R.C. J. Household

DATE 18 April 91

WEATHER Cool

TEMP. 520

ROUTE SR # 120

COUNTY Fulton

TOWNSHIP Amber

SECTION 4

T. _____ R. _____

TYPE MONUMENT PK Nail



ON SURFACE - BELOW Surface

LEFT - C PAV'T. - RIGHT Yes

10' TO Lt EDGE PAVEMENT

S.L.M. 654419

Set P.K. / WASHER
3-10-92

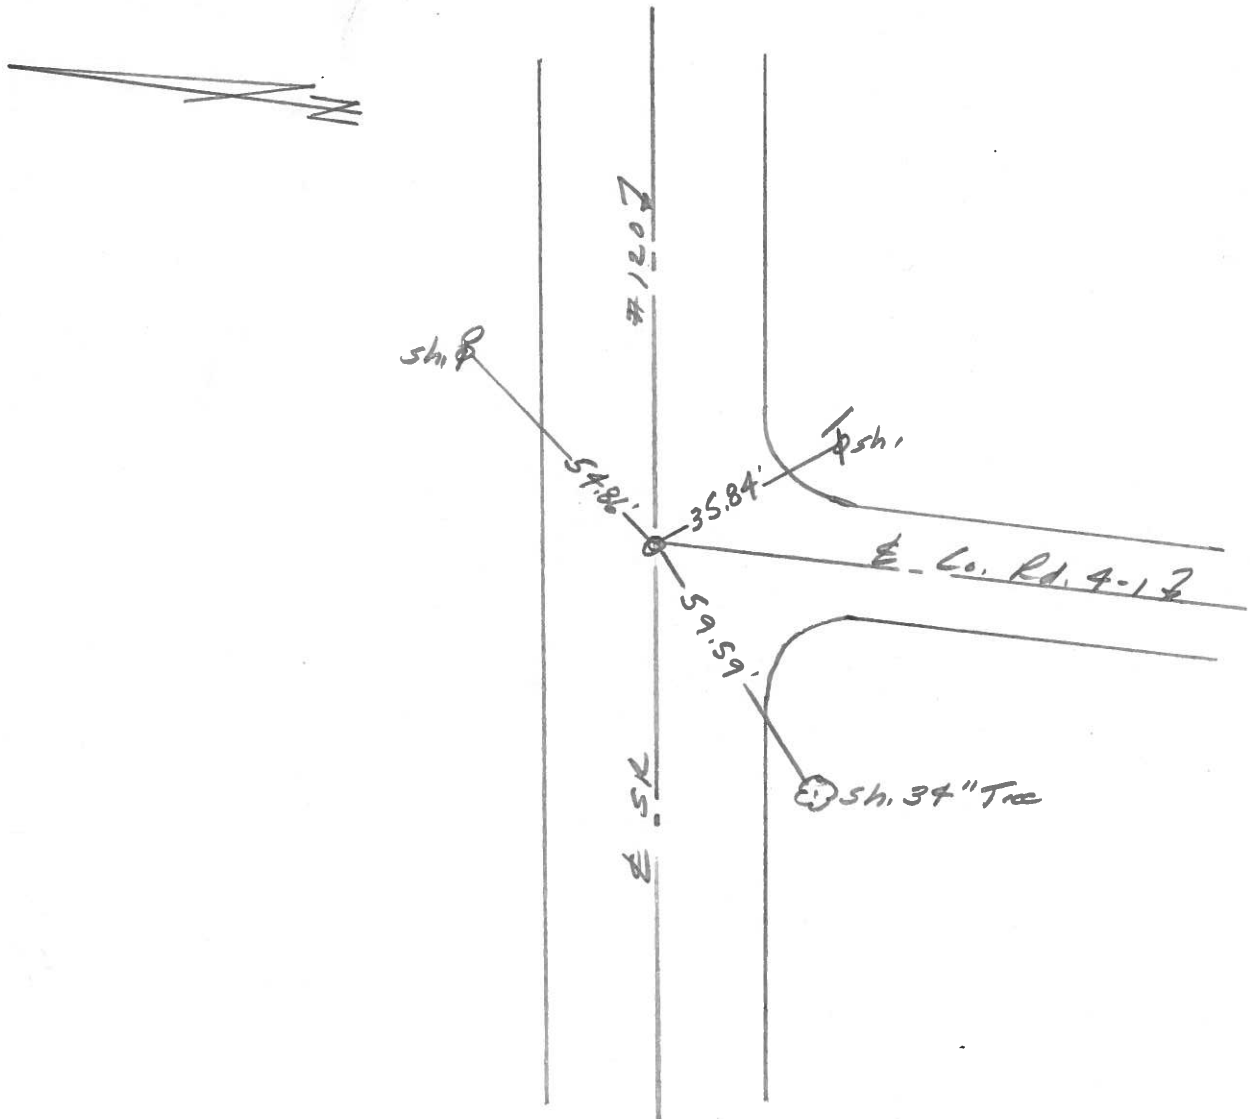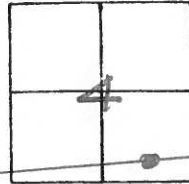

O.D.O.T. DISTRICT 2 SURVEY OFFICE

SHEET _____ OF _____

County Fulton S.R. 120

Date 12 May 81

Township Am 304

Weather Clear

Section 9


Temp. 59°

T N, R E

Personnel J. Stone

P. Neuser

R. Michalak

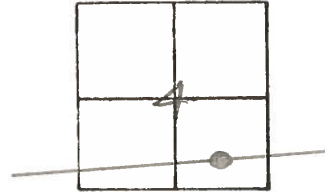

REF. No. 171



Shiner

No. 120

54.87'

35.87'

Shiner

Co. Rd. 4-1

59.82'

Shiner in 24" Tree

SK

Fd. Small Spk. To Surface
 8.1' to N. edge put
 Set PK Nail 7/28/81

| PERSONNEL | TITLE | PERSONNEL | TITLE |
|-----------|-------|-----------|-------|
| Tomsic | | | |
| Granata | | | |
| Vanyo | | | |
| Boyle | | | |

COUNTY Fulton DATE July 12, 1978


S. R. 120 WEATHER _____

SEC. _____ TEMP. _____

DESCRIPTION LEFT CENTER LINE RIGHT JOB NO.


Jct. Co. Rd. #4-1
E.S.R. 120

(17)

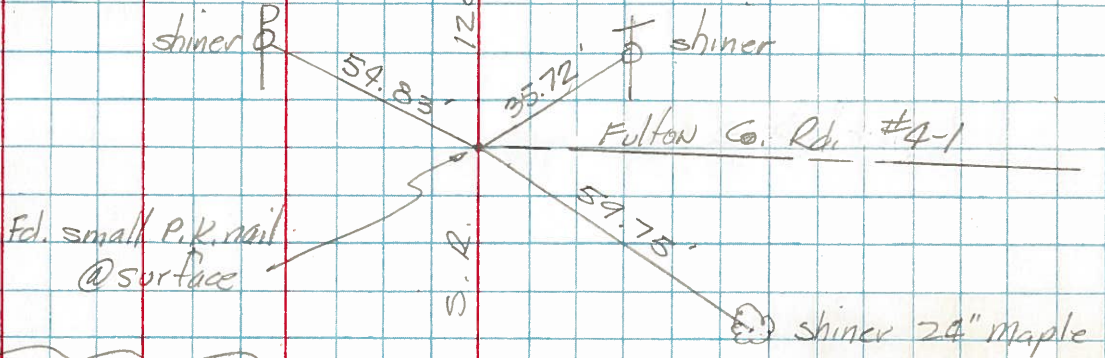

1/2 mi. W.
Fulton Co. Rd. #3

(18)

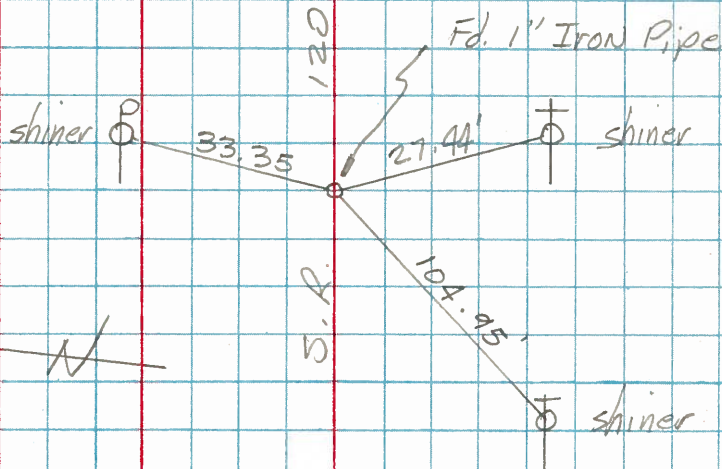

Jct. Co. Rd. #3
E.S.R. 120

METAMORA CORP. LIMIT.

(19)

