

O.D.O.T. DISTRICT 2 SURVEY OFFICE (USE ONLY)

PERSONNEL

REFERENCE NO. 18

SHEET 45 OF 47

NOTES RHOADES

DATE 4/29/19

ROUTE SR 120

H.C. O'DONNELL

WEATHER CLOUDY

COUNTY FULTON

R.C. RHOADES

TEMP. 47°

TOWNSHIP AMBOY

DWG BY NASON PID 101243

SECTION 10

T 9 N R 4 E

TYPE MONUMENT MAG/WASHER

ON SURFACE - ~~BELOW~~ ON

OFFSET \odot PAVEMENT 3' LT : ~~RT~~
7.4' TO LT EDGE PAVEMENT


STATION: 694+39.04

HORZ.DATUM: NAD83(2011)


GEOID: 2012A

GRID: NORTHING: 749505.684

EASTING: 1578544.312

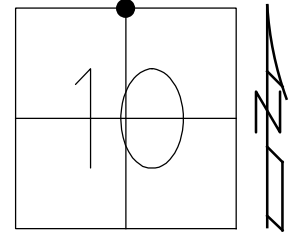

SET MAG/WASHER
 8/18/03, DCH
 FD MAG/WASHER
 5/20/11, RJL
 REF 18
 5/20/11, RJL
 FD MAG/WASHER
 REF18
 3/5/18, JFO
 SET MAG/WASHER
 8/7/19, JFO

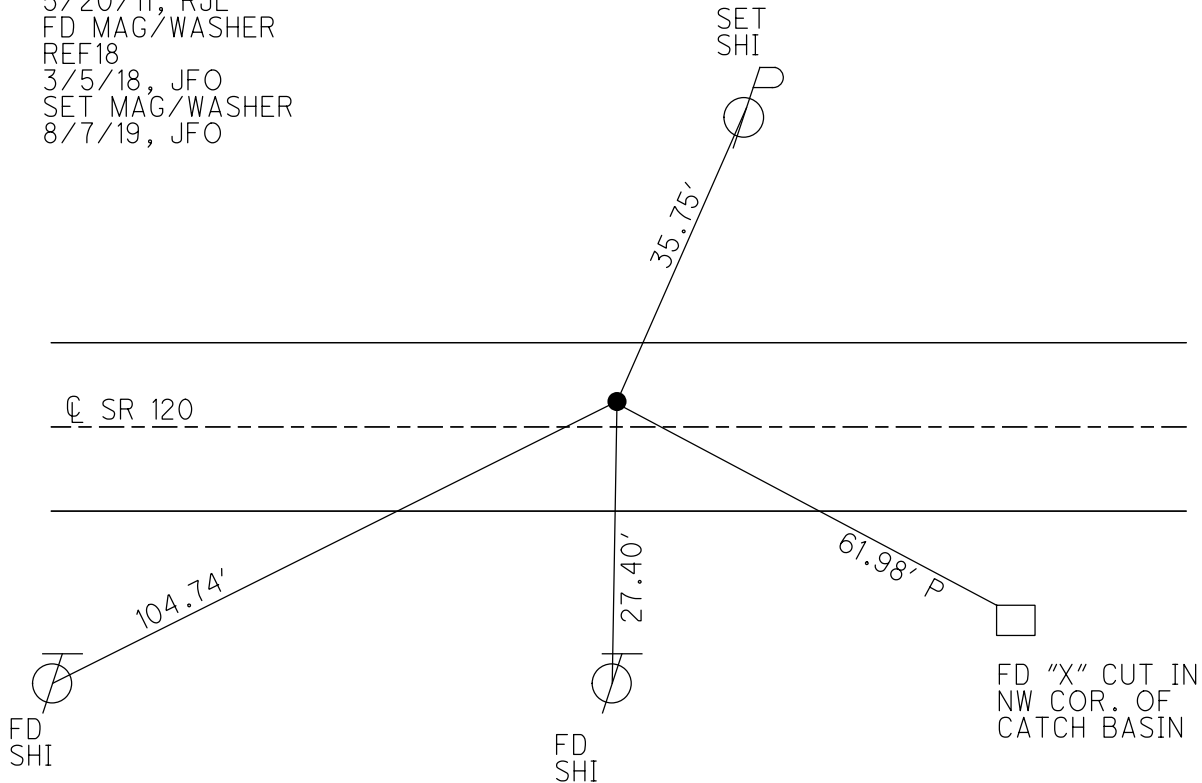

O.D.O.T. DISTRICT 2 SURVEY OFFICE

PERSONNEL

REFERENCE NO. 18

SHEET 43 OF 45

NOTES FINGER

DATE 5/20/11

ROUTE SR 120

H.C. LUMBREZER

WEATHER CLOUDY

COUNTY FULTON

R.C. MOSER

TEMP. 64°

TOWNSHIP AMBOY

SECTION 10

T 9 N R 4 E

TYPE MONUMENT MAG/WASHER


ON SURFACE - ~~BELOW~~ ON

LEFT - ℄ PAV'T - ~~RIGHT~~ 3'

7.4' TO LT EDGE PAVEMENT

S.L.M. 694+08


Grid: Northing: 749505.712 Easting: 1578544.225

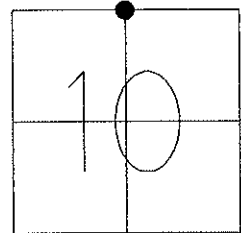

SET MAG/WASHER
8/18/03, DCH

FD MAG/WASHER
5/20/11, RJL

GPS, REF 18
5/20/11, RJL

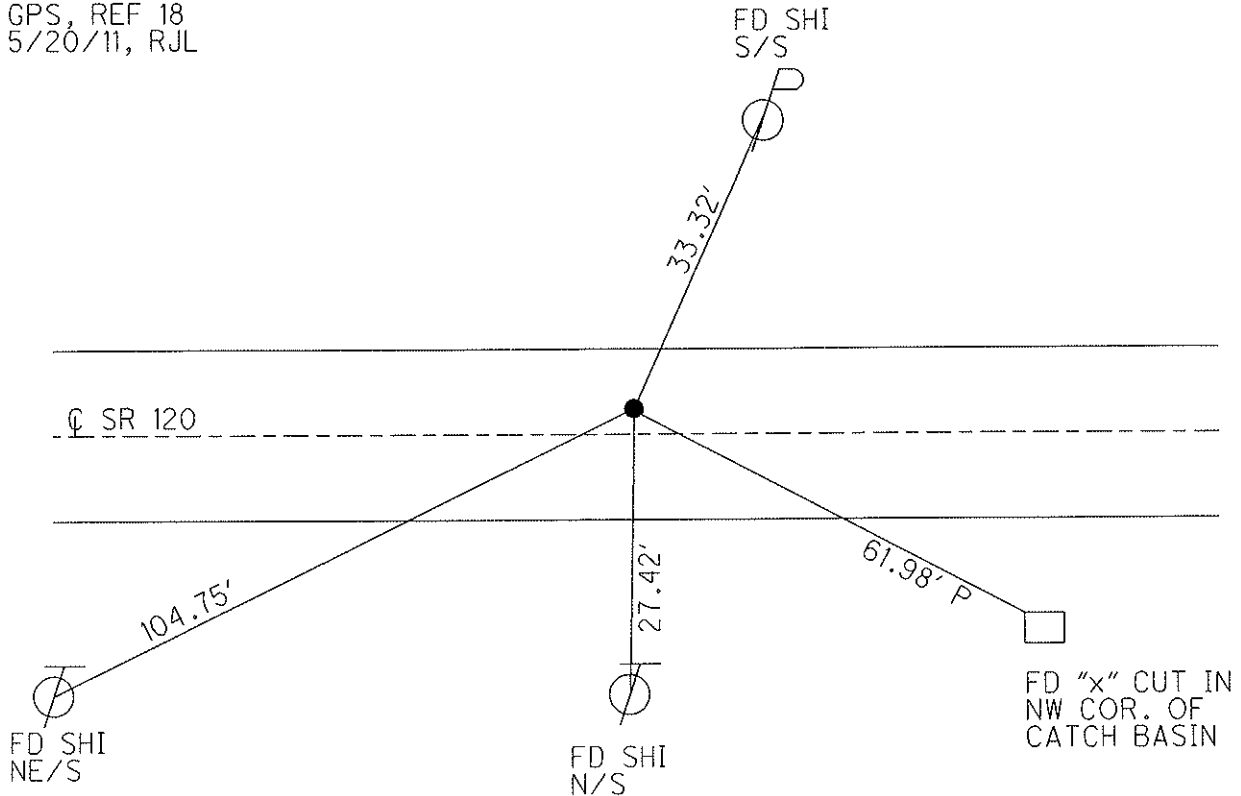

O.D.O.T. DISTRICT 2 SURVEY OFFICE

PERSONNEL

REFERENCE NO. 18

SHEET 18 OF 18

NOTES HOMAN

DATE 8-18-03

ROUTE S.R. 120

H.C. NUFER

WEATHER SUNNY

COUNTY FULTON

R.C. MEYERS

TEMP. 75°

TOWNSHIP AMBOY

SECTION 3

T 9 S R 4 E


TYPE MONUMENT PK NAIL & WASHER

ON SURFACE - ~~BELOW~~ ON


LEFT ~~- C PAVT - RIGHT~~ 3'

TO EDGE PAVEMENT

S.L.M. 694+08

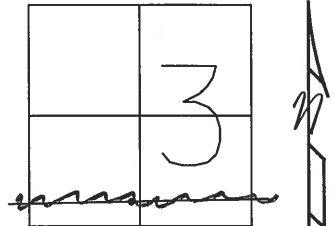

SET MAG & WASHER
8-18-03
DCH

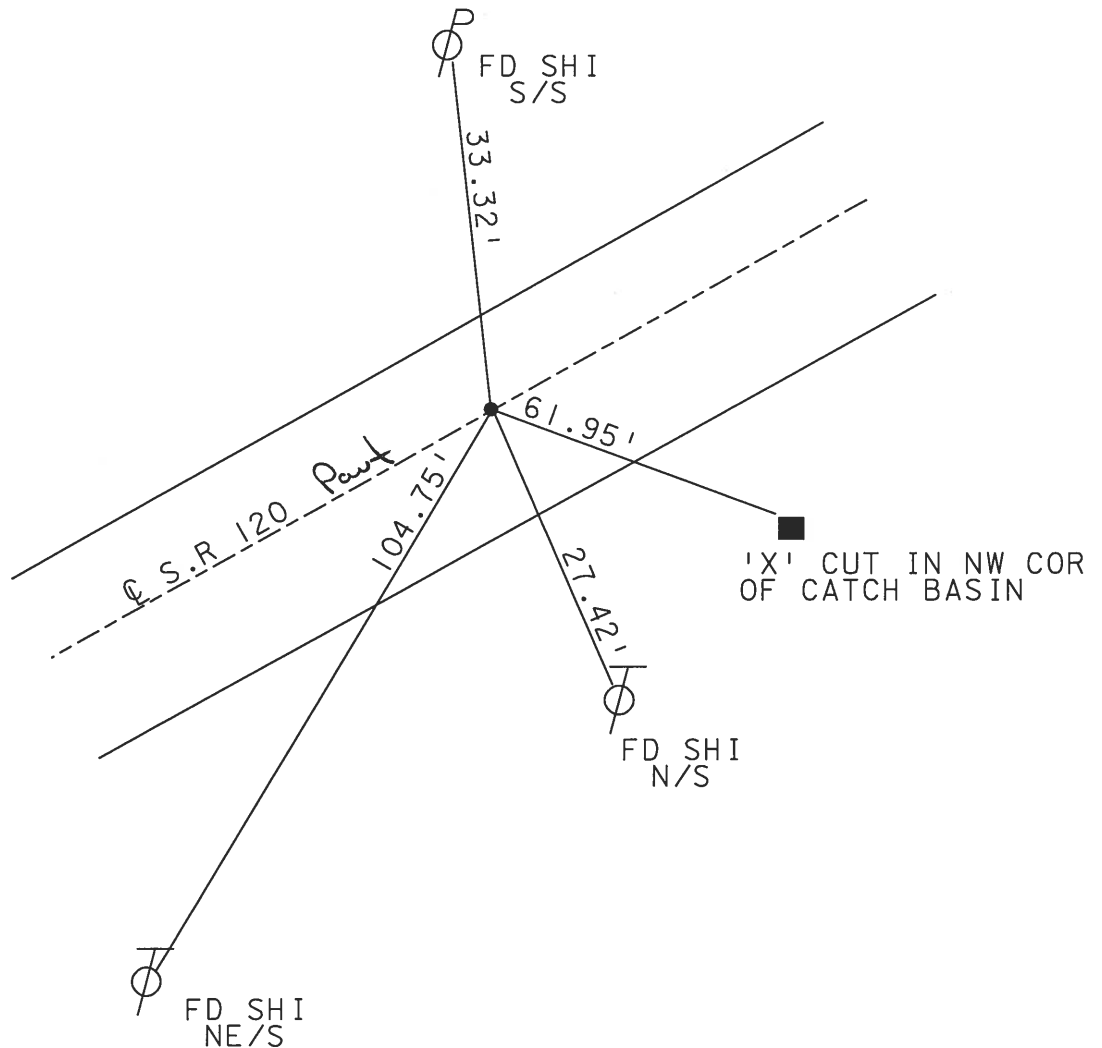

O.D.O.T. DISTRICT 2 SURVEY OFFICE

PERSONNEL

REFERENCE NO. 18

SHEET 13 OF

NOTES L. Stone

H.C. D. Curtis

R.C. J. Householder

DATE 18 April 91

WEATHER Cool

TEMP. 55°

ROUTE SR#120

COUNTY Fulton

TOWNSHIP Amboy

SECTION 3

T. R.

TYPE MONUMENT RR Spk.



Set P.K. WASHER
3-18-92

ON SURFACE - BELOW 4" deep

LEFT - \odot PAV'T. - RIGHT

 TO EDGE PAVEMENT

S.L.M. 694+08

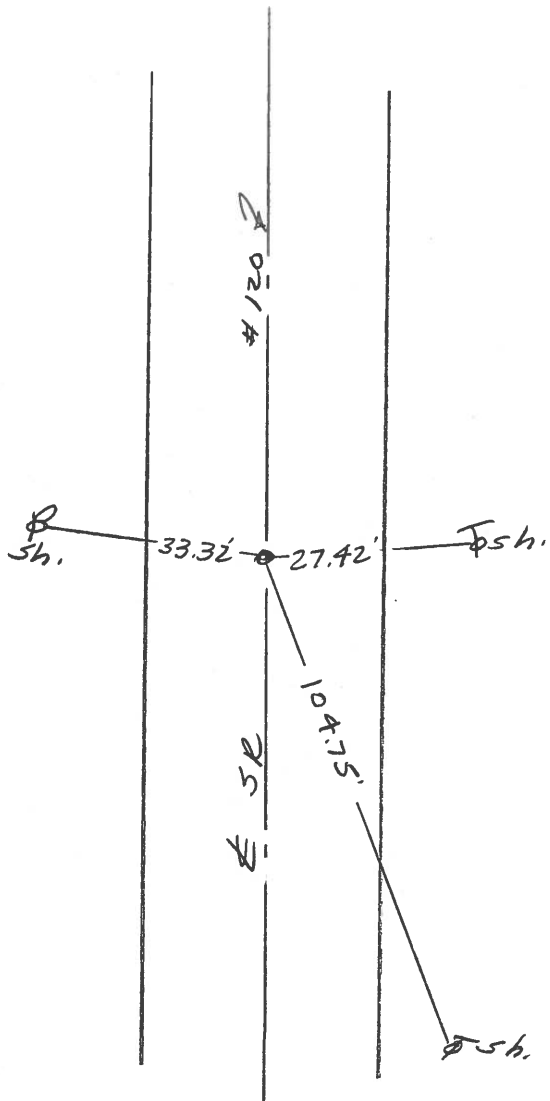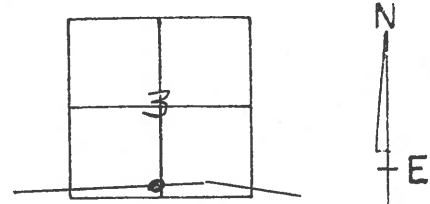

O.D.O.T. DISTRICT 2 SURVEY OFFICE

SHEET _____ OF _____

County Fulton S.R. 120

Date 12 May 81

Township Royalton


Weather Clear

Section 3

Temp. 59°

T N, R E

Personnel J. Stone

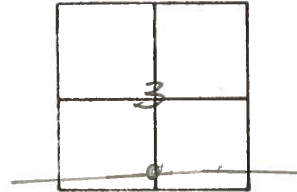


P. Neuser

R. Michalek

D. Curtis

REF. No. 18

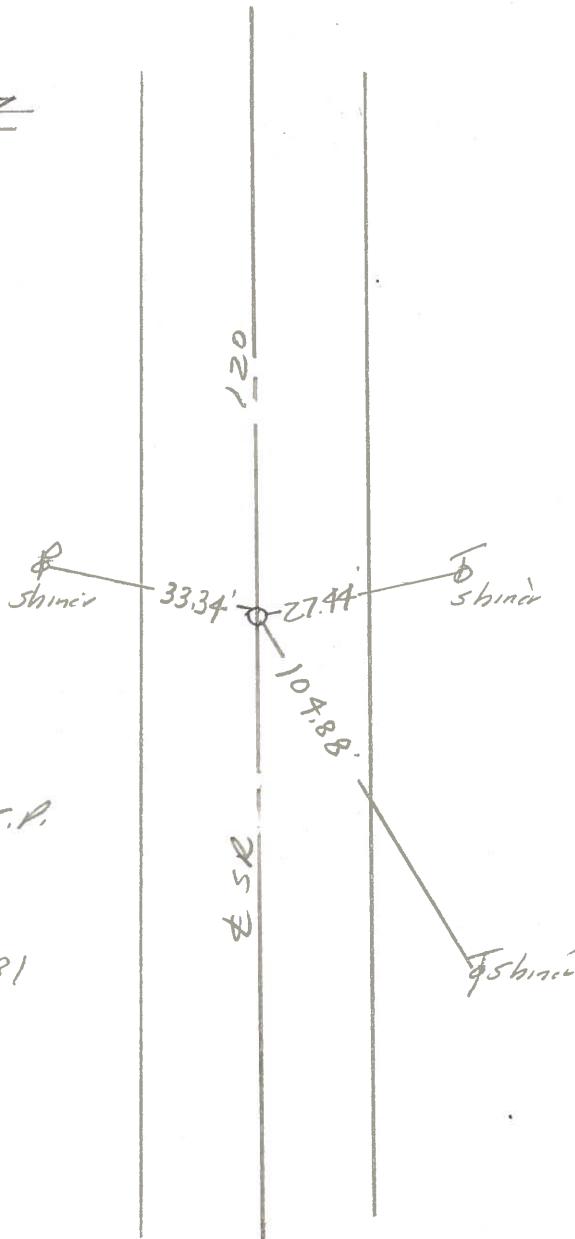


Fd. RR Spt. over 1" I.P.
5.7' to N. edge put
10.2' to S. edge put.
Set PK Nail 7/28/81

PERSONNEL	TITLE	PERSONNEL	TITLE
Tomsic			
Granata			
Vanyo			
Boyle			

COUNTY Fulton DATE July 12, 1973
 S. R. 120 WEATHER _____
 SEC. _____ TEMP. _____

DESCRIPTION _____ LEFT _____ CENTER LINE _____ RIGHT _____ JOB NO. _____

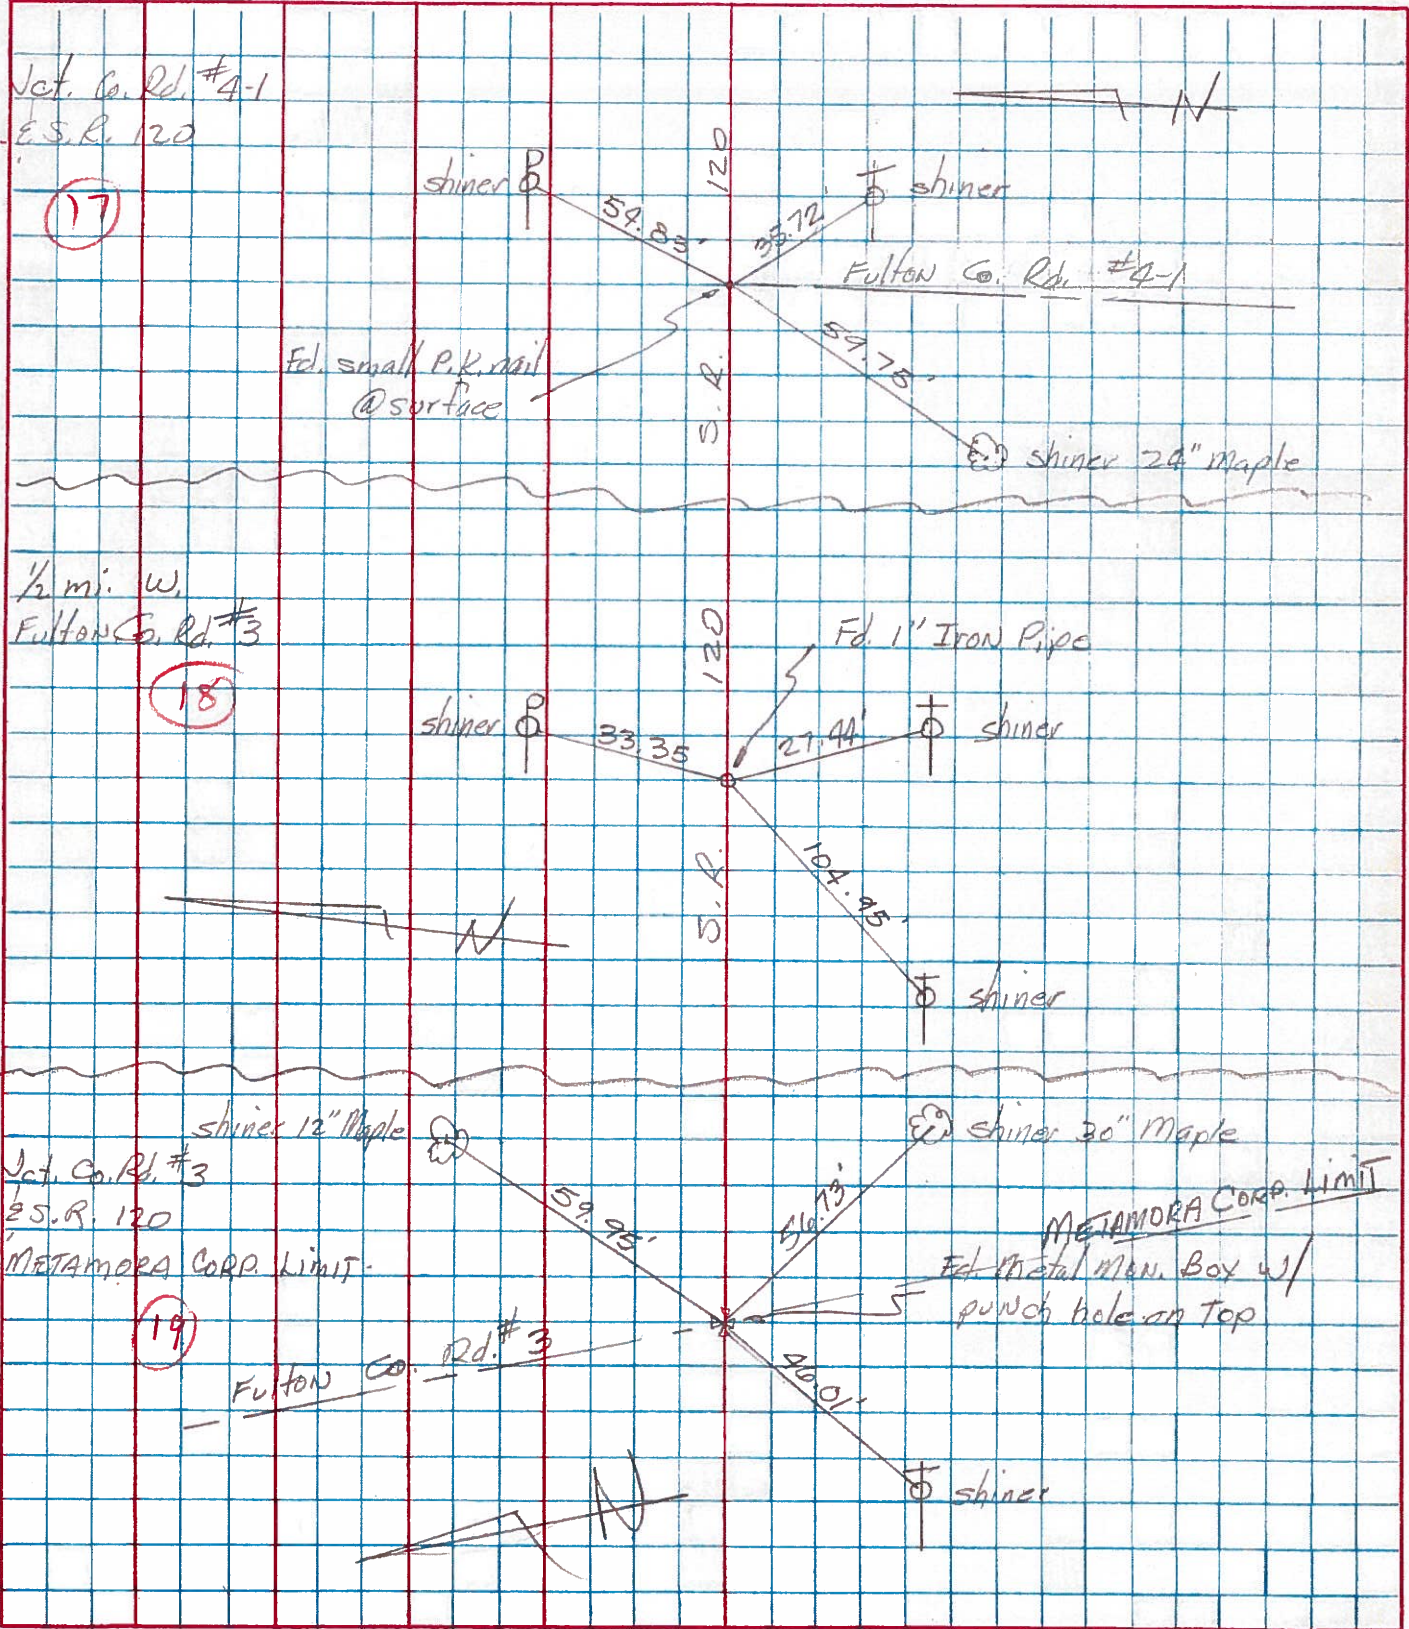

COMPUTATION SHEET

STATE OF OHIO - DEPARTMENT OF HIGHWAYS - BUREAU OF LOCATION AND DESIGN _____ COLUMBUS, OHIO
 BY Denno - Granata - Curtis - Omev DATE June 7, 1966 NO. _____ OF _____ SHEETS
 COUNTY Fulton SECTION _____
 DIV. NO. _____ S.R. 120 U.S.R. _____ I. R. _____
 SUBJECT OF THIS SHEET _____

