



O.D.O.T. DISTRICT 2 SURVEY OFFICE (USE ONLY)

PERSONNEL _____ REFERENCE NO. 3 A SHEET 8 OF 10
 NOTES LOEHRKE DATE 5/22/97 ROUTE US 127
 H.C. HUSS WEATHER NICE COUNTY FULTON
 R.C. COX TEMP. 62° TOWNSHIP GORHAM
 DWG BY RHOADES PID PAVETRAIN SECTION 18
 T 9 N R 1 E

TYPE MONUMENT SM.R.R.SPIKE
~~ON SURFACE~~ - BELOW 2"
 OFFSET ϕ PAVEMENT 0.7' LT : ~~RT~~
12.7' TO RT EDGE PAVEMENT
 STATION: 208+43

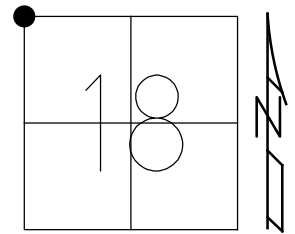

HORZ.DATUM: NAD83 2011 GEOID: NAVD88 2018
 GRID: NORTHING: 744528.801 EASTING: 1460446.851

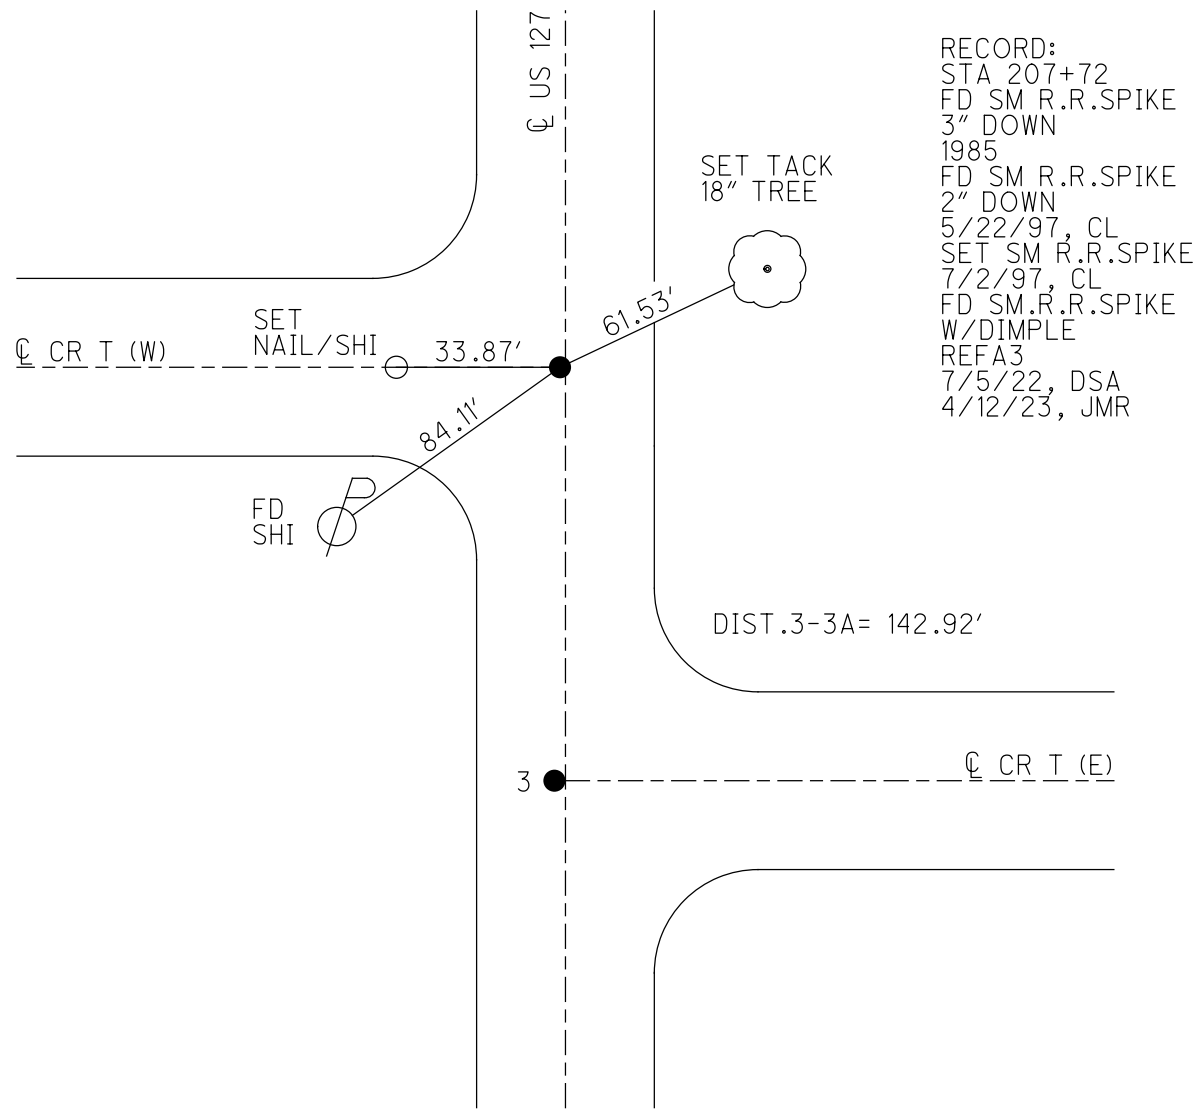

RECORD:
 STA 207+72
 FD SM R.R.SPIKE
 3" DOWN
 1985
 FD SM R.R.SPIKE
 2" DOWN
 5/22/97, CL
 SET SM R.R.SPIKE
 7/2/97, CL
 FD SM.R.R.SPIKE
 W/DIMPLE
 REFA3
 7/5/22, DSA
 4/12/23, JMR

DIST.3-3A= 142.92'

3 ϕ CR T (E)

O.D.O.T. DISTRICT 2 SURVEY OFFICE

PERSONNEL _____

REFERENCE NO. 3

SHEET 4 OF 6

NOTES LoENRKE

H.C. Huss

DATE 5-22-97

ROUTE U.S. # 127

R.C. Cox

WEATHER Nice

COUNTY FULTON

TEMP. _____

TOWNSHIP GORNAM

SECTION 7-12-13-18

T 9 S R 1 W 1 E

Reset

TYPE MONUMENT Sm. R.R. SPTS.

7-2-97

~~ON~~-SURFACE - BELOW 2"

LEFT-~~C~~ PAV'T. - ~~RIGHT~~ 1.0 5 0.7

TO EDGE PAVEMENT


S.L.M. 207+00 208+43

12	7
13	18



RECORD: SLM = 206+29(A), 207+72(B)

FD. Sm. R.R. SPTS 3" DEEP - 1985.

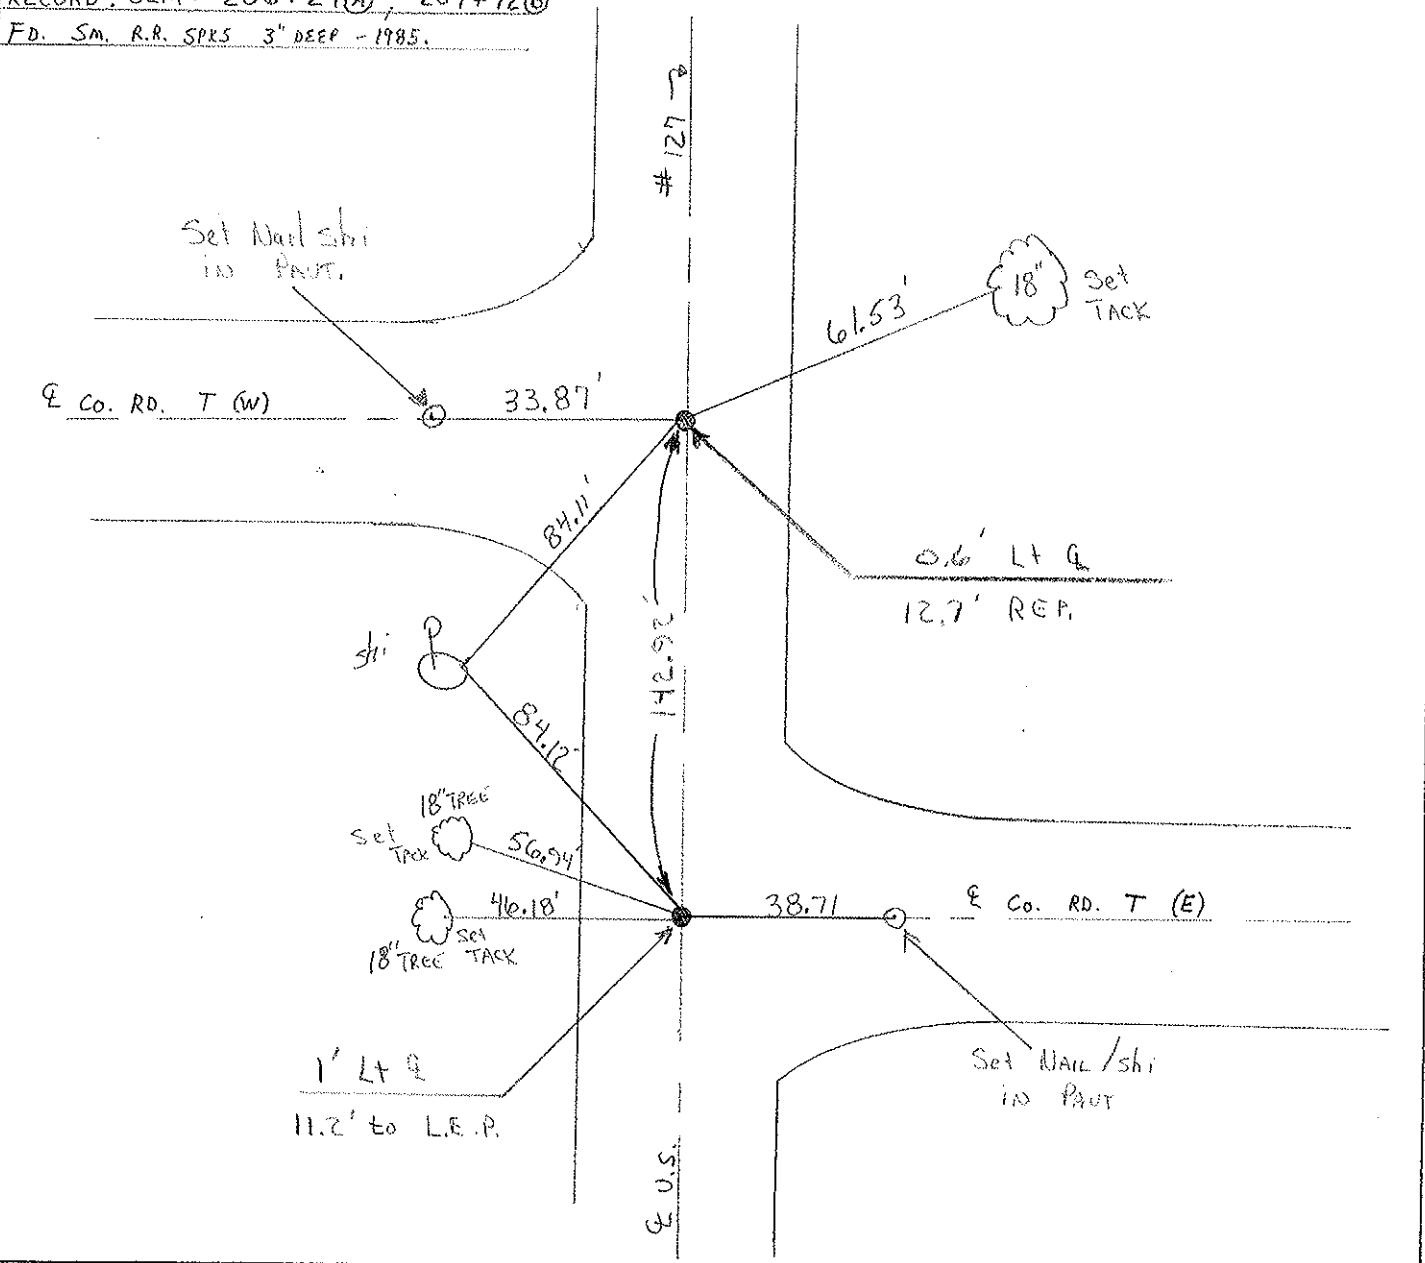

O.D.O.T. DISTRICT 2 SURVEY OFFICE

PERSONNEL _____

REFERENCE NO. 3

SHEET 4 OF _____

NOTES 1. Stone

H.C. D. Curtis

R.C. R. Michalak

J. Hauscholder

DATE 2 Oct. 85

WEATHER Cool

TEMP. 59°

ROUTE US #127

COUNTY Fulton

TOWNSHIP Goehon

SECTION 7-12-13-18

T _____ R _____

TYPE MONUMENT Small RR Spks.

ON SURFACE - BELOW Surface

LEFT - \odot PAW'T. - RIGHT _____


_____ TO _____ EDGE PAVEMENT

S.L.M. $\odot A = 206+29$, $\odot B = 207+72$

12	7
13	18



Fd. Small R.R. Spks. 3" Deep - 12-13-85

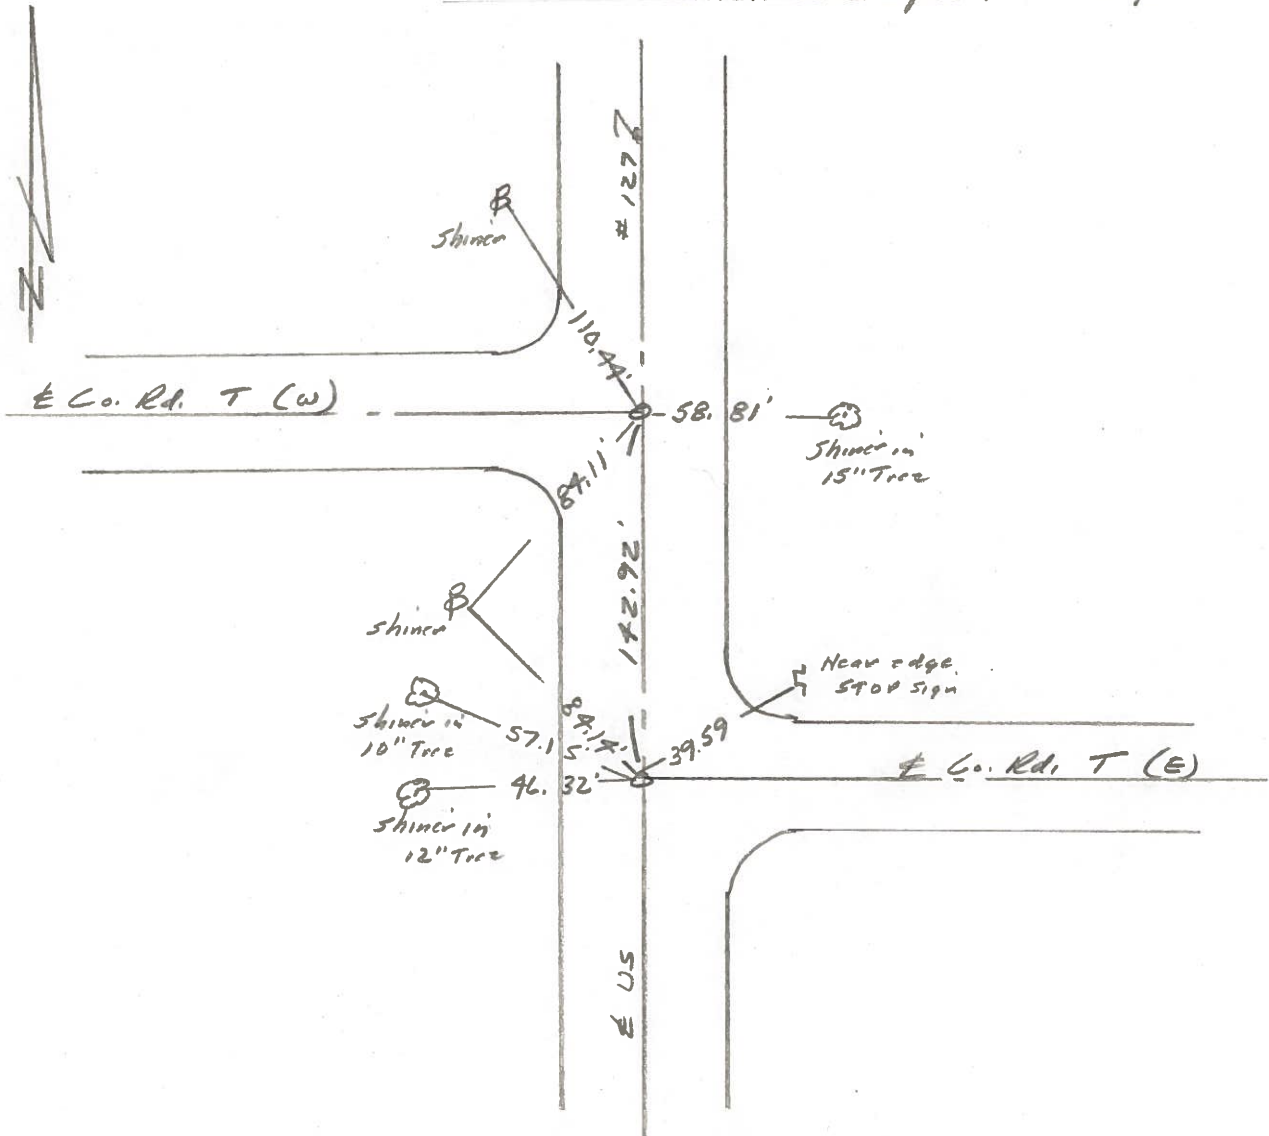

County Fulton US #127

Date 26 June 79

Township Gorham

Weather Warm

Section 13

Temp. 78°


T. N, R. E

Personnel L. Stone

R. Michalak


D. Curtis

D. Grenala

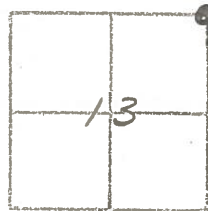

REF. No. 3

5th BLKTOP STA. 205+43

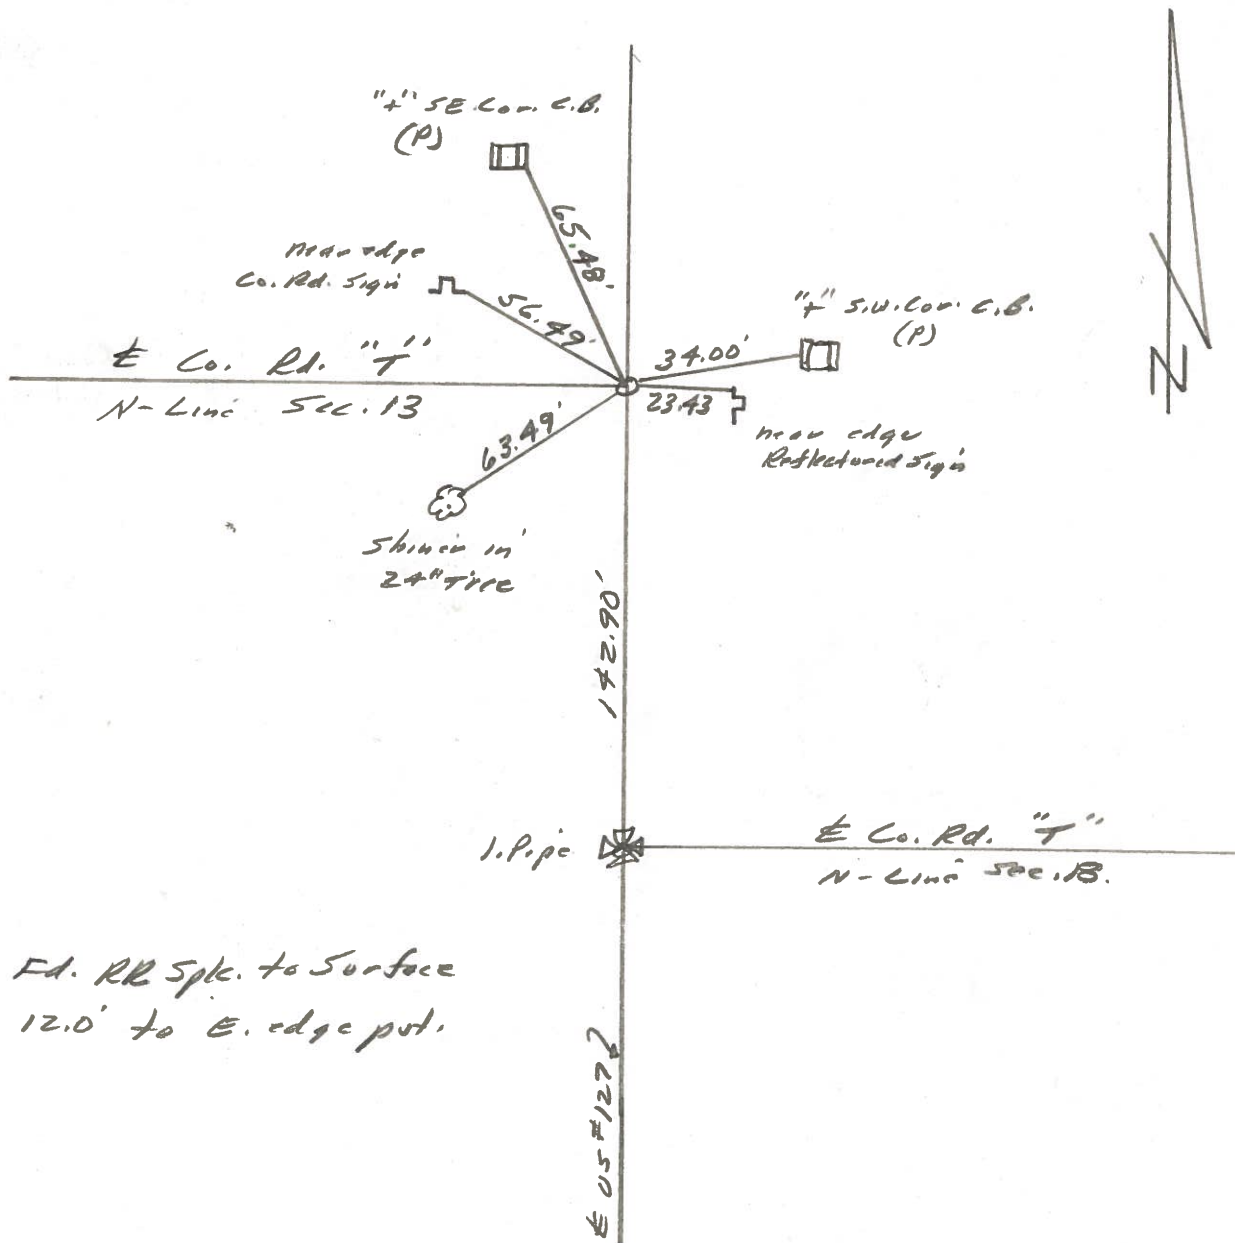


PERSONNEL	TITLE	PERSONNEL	TITLE
Tomsic			
Granata			
Vanyo			
Boyle			

COUNTY Fulton DATE AUG, 27, 1913

S. R. 127 WEATHER _____

SEC. _____ TEMP. _____

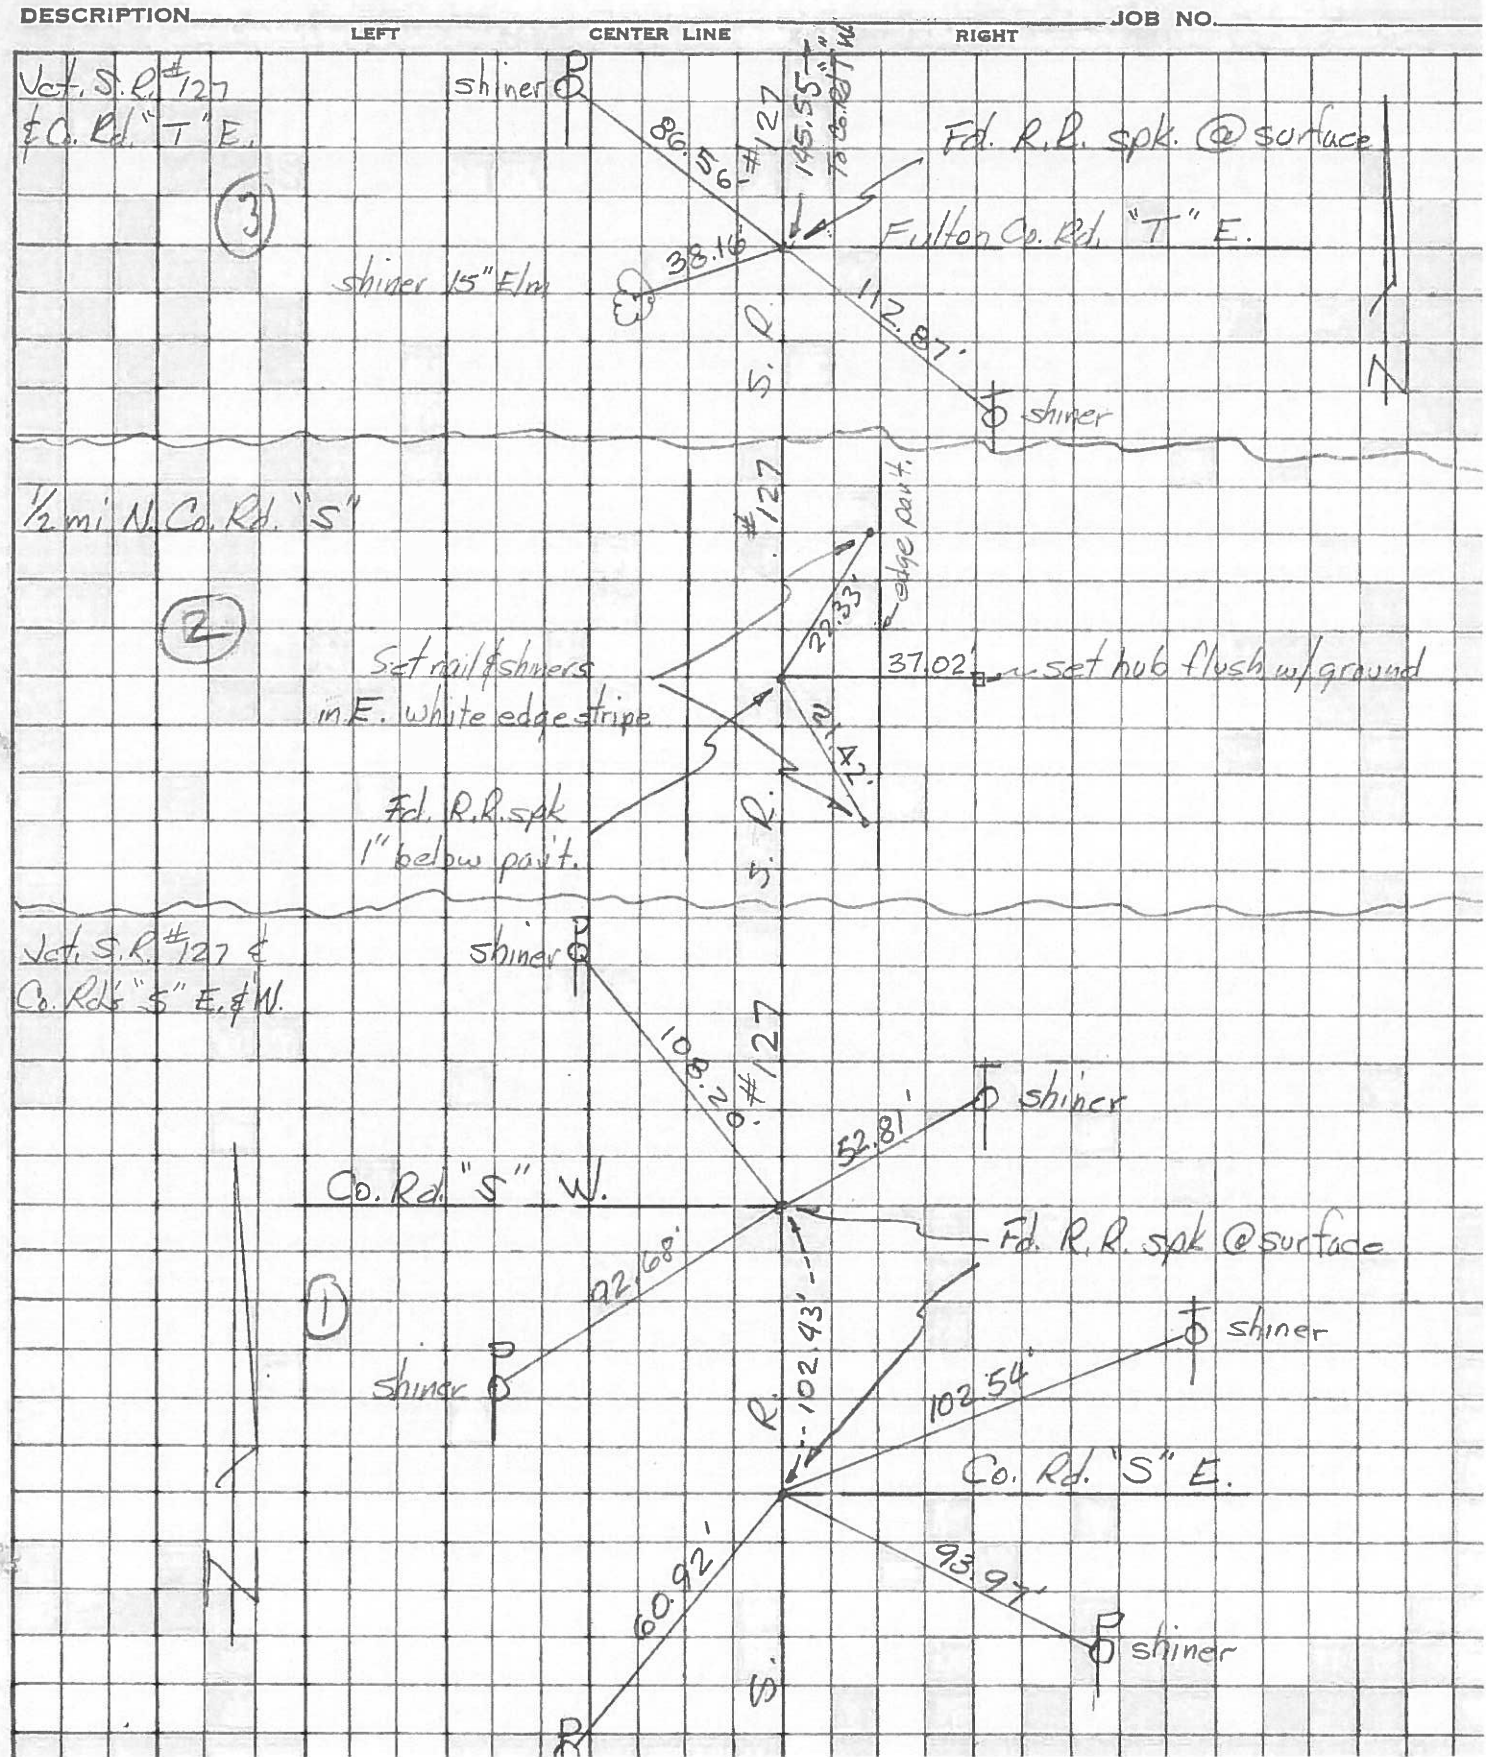


PERSONNEL	TITLE	PERSONNEL	TITLE
Tomsic			
Granata			
Yanyo			
Boyle			

COUNTY Fulton DATE Aug. 28, 1913

S. R. 127 WEATHER _____

SEC. _____ TEMP. _____

DESCRIPTION _____ LEFT _____ CENTER LINE _____ RIGHT _____ JOB NO. _____

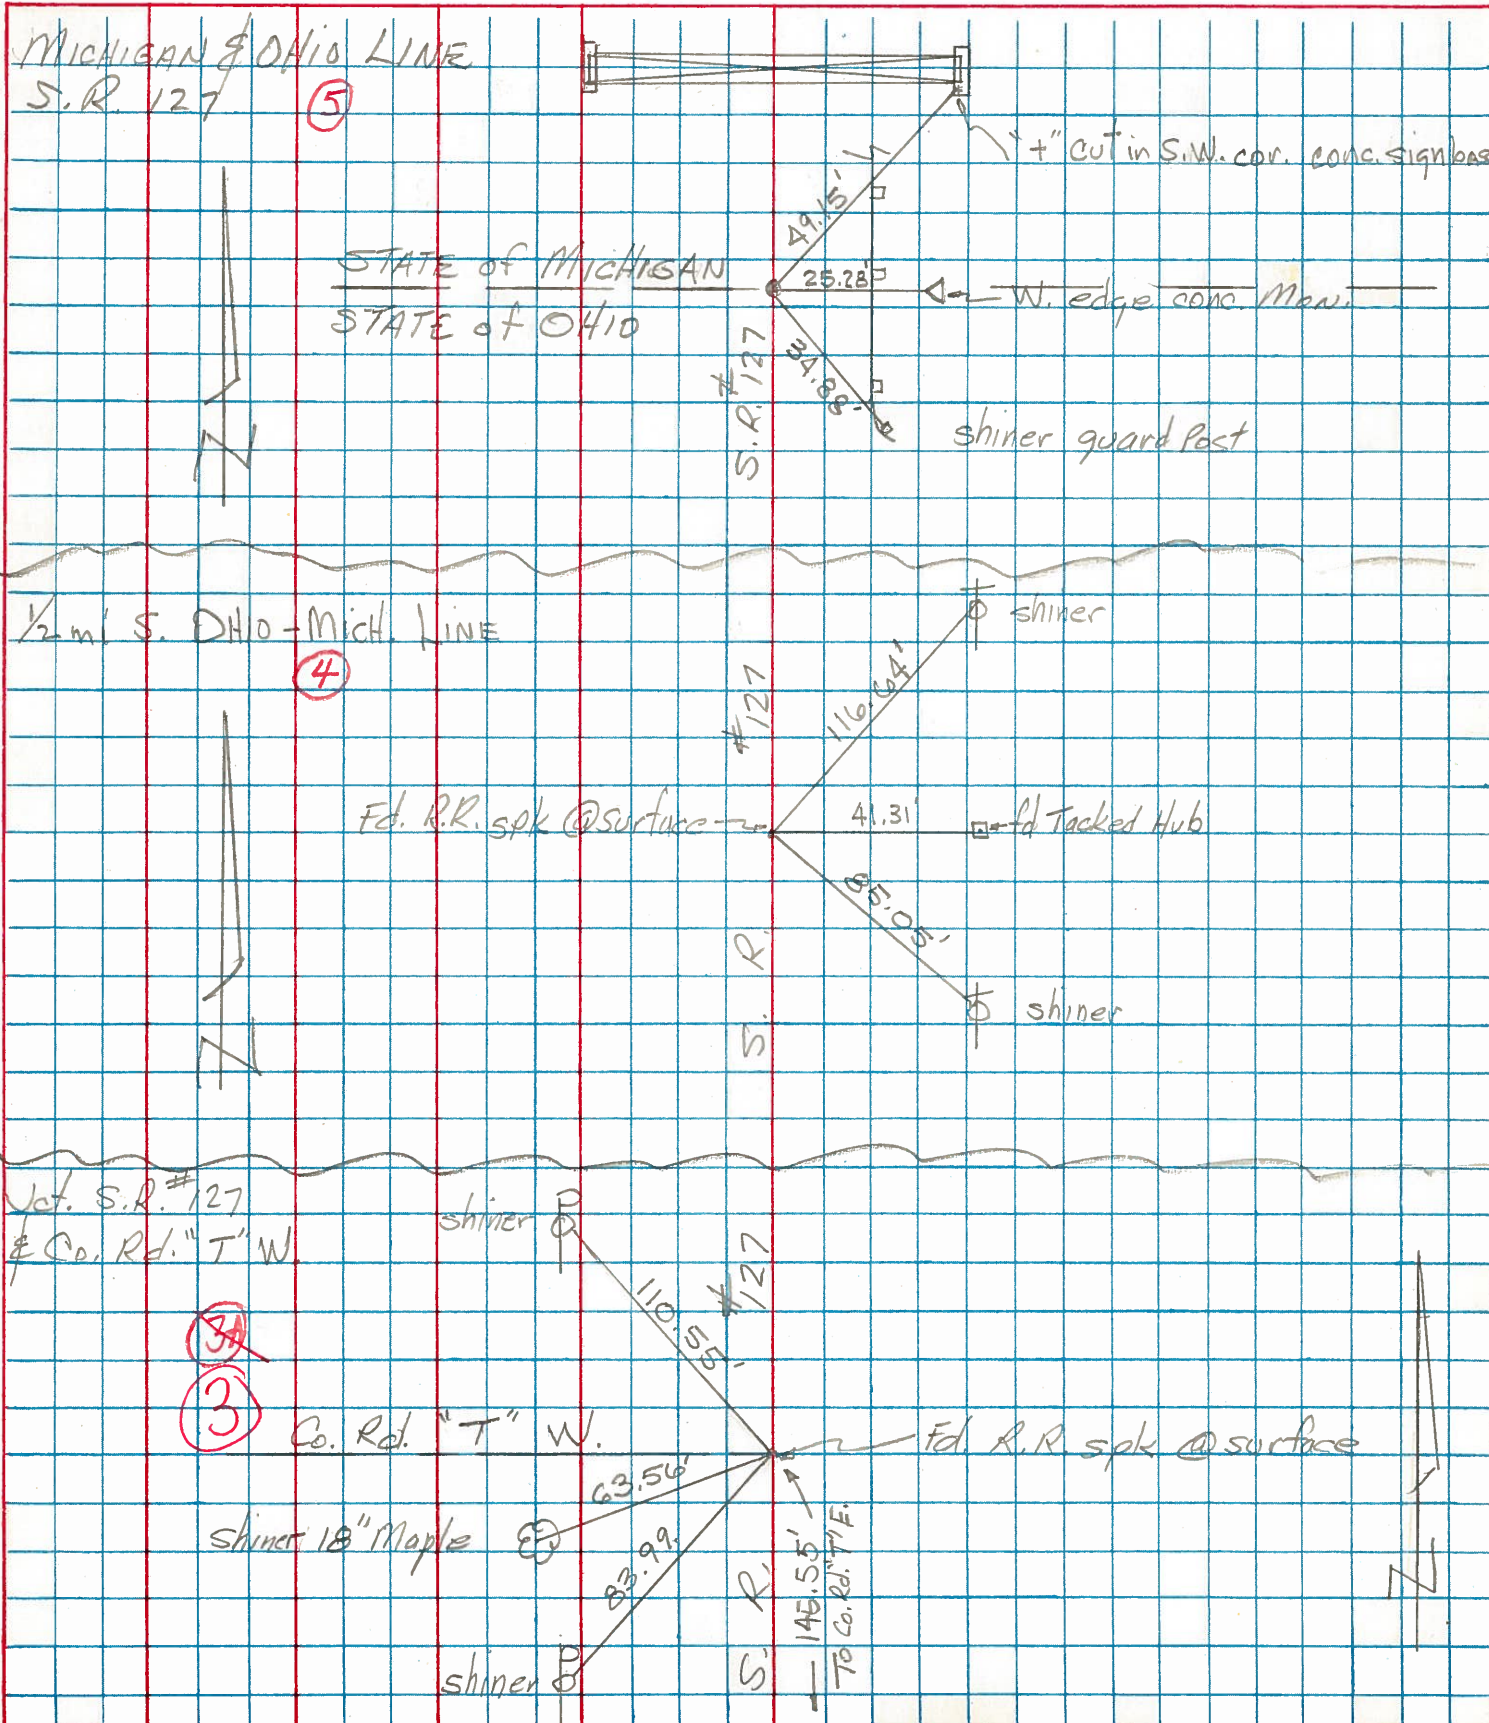

PERSONNEL TITLE PERSONNEL TITLE

COUNTY Fulton

DATE July 6, 1966

Danna

Curtis

Granata

Oney

S. R. 127

WEATHER Sunny

SEC. _____

TEMP. 85°


DESCRIPTION Monument Ref us 127

JOB NO. _____

LEFT

CENTER LINE

RIGHT

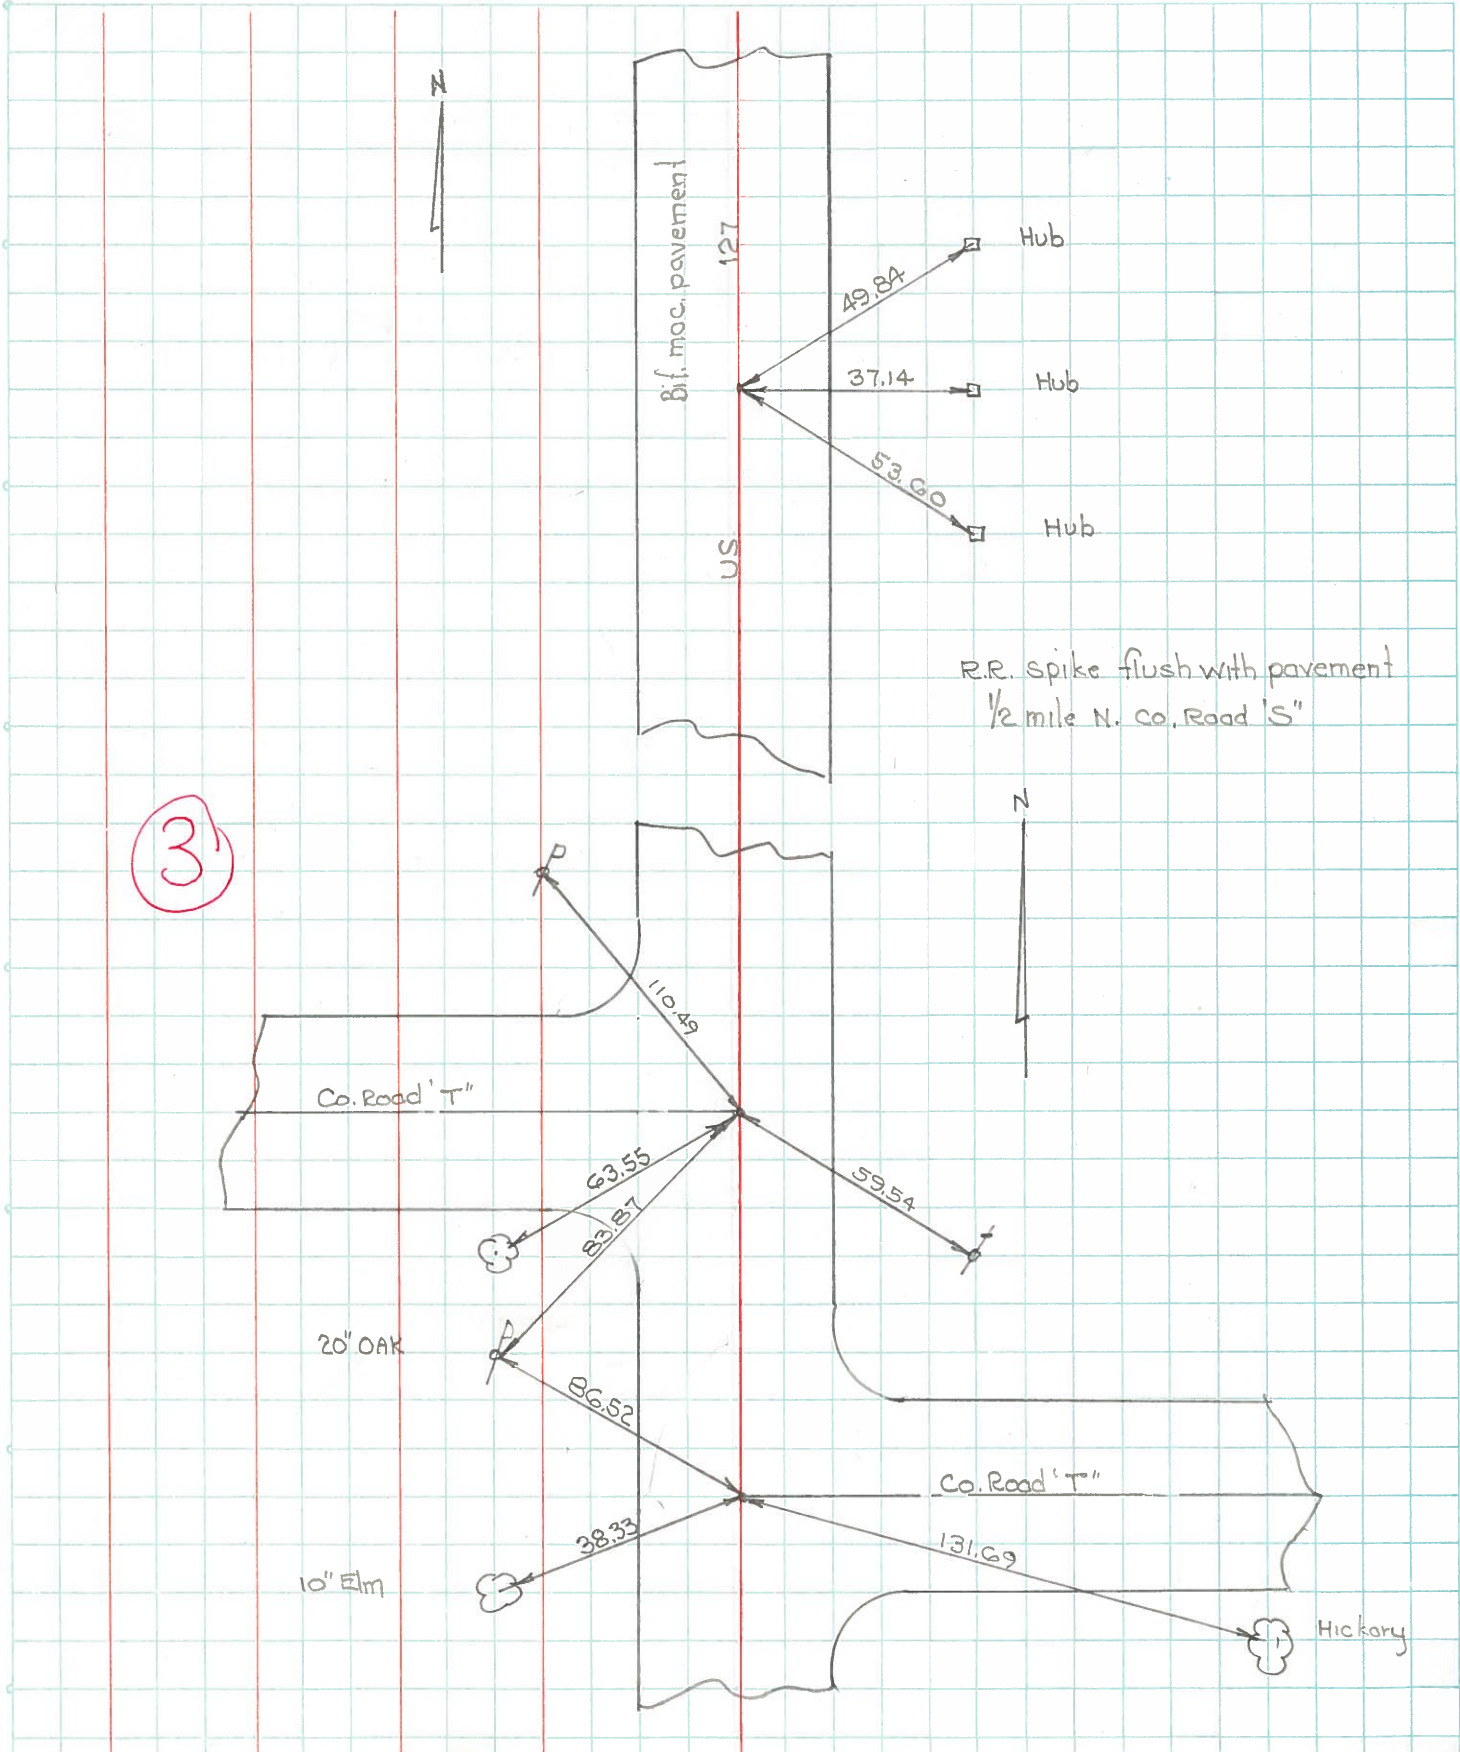

PERSONNEL	TITLE	PERSONNEL	TITLE	COUNTY	DATE	S. R. #	WEATHER	TEMP.
Burnside				Fulton	8-20-65	127	Clear	+75°
Smith								
Ketcham								

DESCRIPTION	LEFT	CENTER LINE	RIGHT	JOB NO.
-------------	------	-------------	-------	---------

