


O.D.O.T. DISTRICT 2 SURVEY OFFICE (USE ONLY)


PERSONNEL _____ REFERENCE NO. 4 SHEET 9 OF 10
 NOTES LOEHRKE DATE 5/22/97 ROUTE US 127
 H.C. HUSS WEATHER COOL COUNTY FULTON
 R.C. COX TEMP. 64° TOWNSHIP GORHAM
 DWG BY RHOADES PID PAVETRAIN SECTION 7
 T 9 N R 1 E

TYPE MONUMENT SM.R.R.SPIKE
 ON SURFACE - ~~BELOW~~ ON
 OFFSET ☐ PAVEMENT 0.2' LT : ~~RT~~
12.5' TO LT EDGE PAVEMENT
 STATION: 233+69

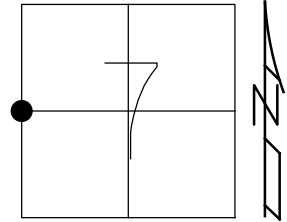

HORIZ.DATUM: NAD83 2011 GEOID: NAVD88 2018
 GRID: NORTHING: 747040.997 EASTING: 1460485.776


RECORD:
 STA 232+84
 D.N.F
 1985, IRS
 FD SM.R.R.SPIKE
 3" DOWN
 1985
 FD SM R.R. SPIKE
 5/22/97, CL
 FD SM.R.R.SPIKE
 REF4
 7/5/22, DSA
 4/12/23, JMR

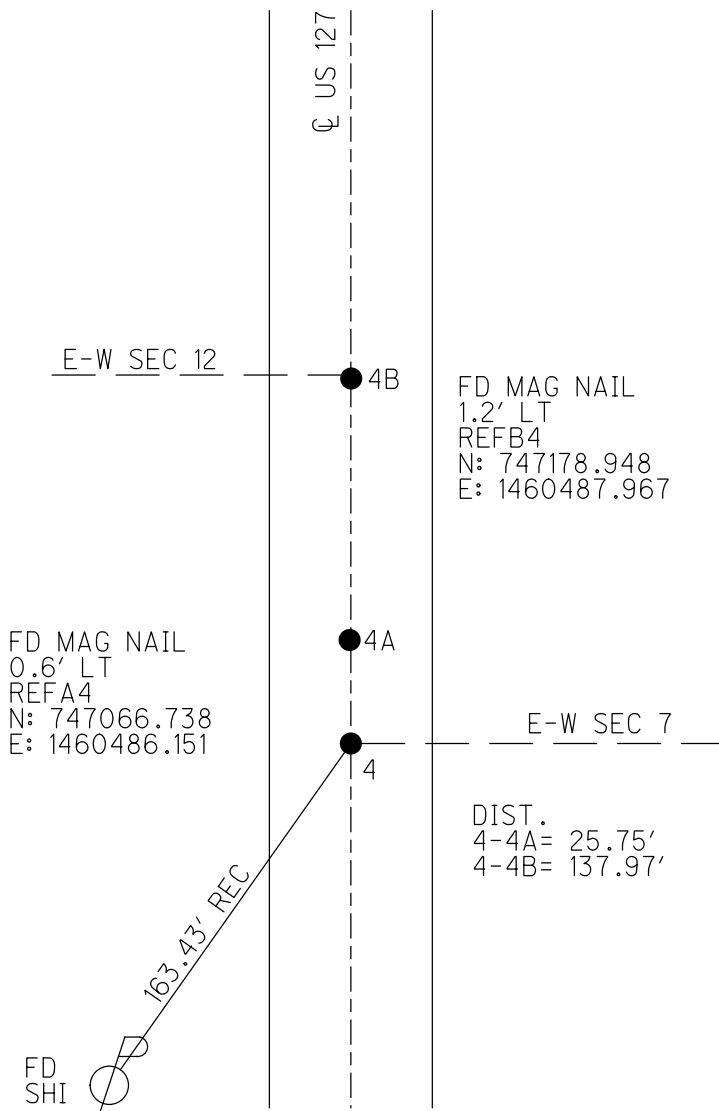

O.D.O.T. DISTRICT 2 SURVEY OFFICE (USE ONLY)

PERSONNEL _____ REFERENCE NO. 4 SHEET 9 OF 10
 NOTES LOEHRKE DATE 5/22/97 ROUTE US 127
 H.C. HUSS WEATHER COOL COUNTY FULTON
 R.C. COX TEMP. 64° TOWNSHIP GORHAM
 _____ SECTION 7
 DWG BY NIESE PID _____ T 9 N R 1 E


TYPE MONUMENT SM.R.R.SPIKE
 ON SURFACE - ~~BELOW~~ ON
 OFFSET Q PAVEMENT 0.2' LT : ~~RT~~
12.5' TO LT EDGE PAVEMENT
 STATION: 233+69

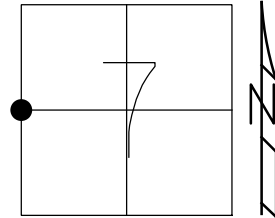

HORZ.DATUM: _____ GEOID: _____
 GRID: NORTHING: _____ EASTING: _____

RECORD:
 STA 232+84
 FD SM.R.R.SPIKE
 3" DOWN
 1985
 FD SM R.R. SPIKE
 5/22/97, CL

NOTE: COULD NOT LOCATE
 E-W Q SEC 12
 PER 1985 NOTES
 1985, STONE

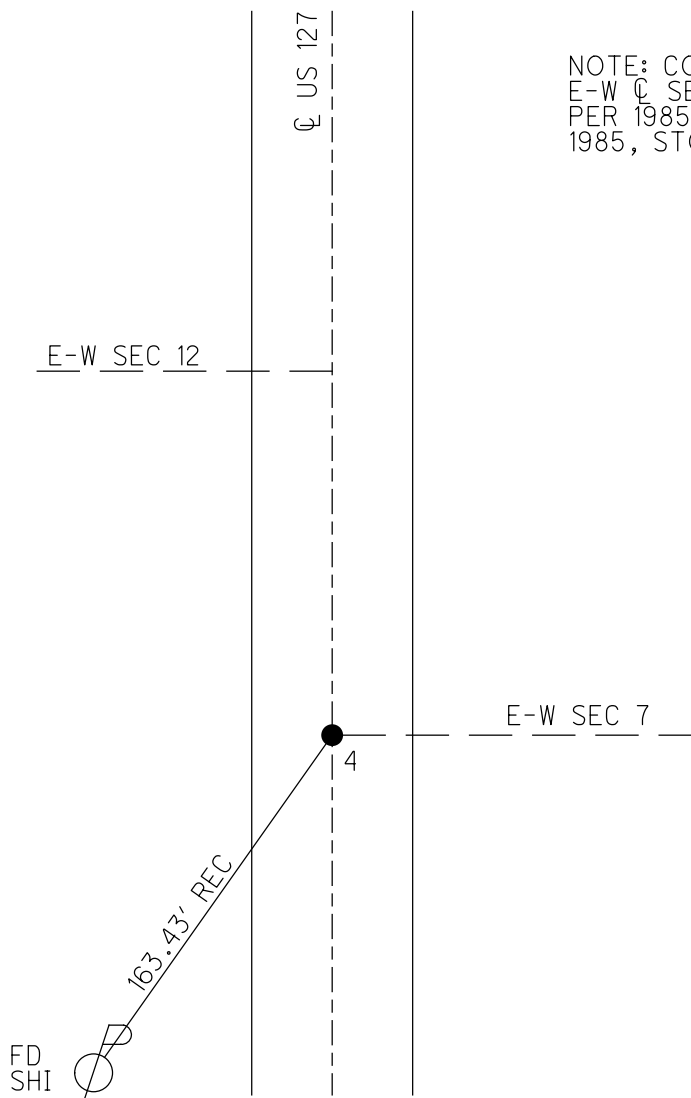

O.D.O.T. DISTRICT 2 SURVEY OFFICE

PERSONNEL

REFERENCE NO. 4

SHEET 5 OF 6

NOTES C. Loerkhe

H.C. S. Huss

R.C. C. COX

DATE 5-22-97

WEATHER COOL

TEMP. 64°

ROUTE U.S. # 127

COUNTY FULTON

TOWNSHIP GORHAM

SECTION 12, 7

T 9 S R 1 W / 1 E


TYPE MONUMENT SM. R.R. SPK.

ON SURFACE - ~~BELOW~~ SURFACE


LEFT - ~~Q~~ PAV'T. - ~~RIGHT~~ 0.2

12.5 TO Lt. EDGE PAVEMENT

S.L.M. 233 + 69

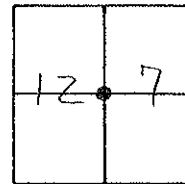

RECORD: SLM = 232 + 84
Fd. Sm. R.R. SPK. 3" DEEP - 1985

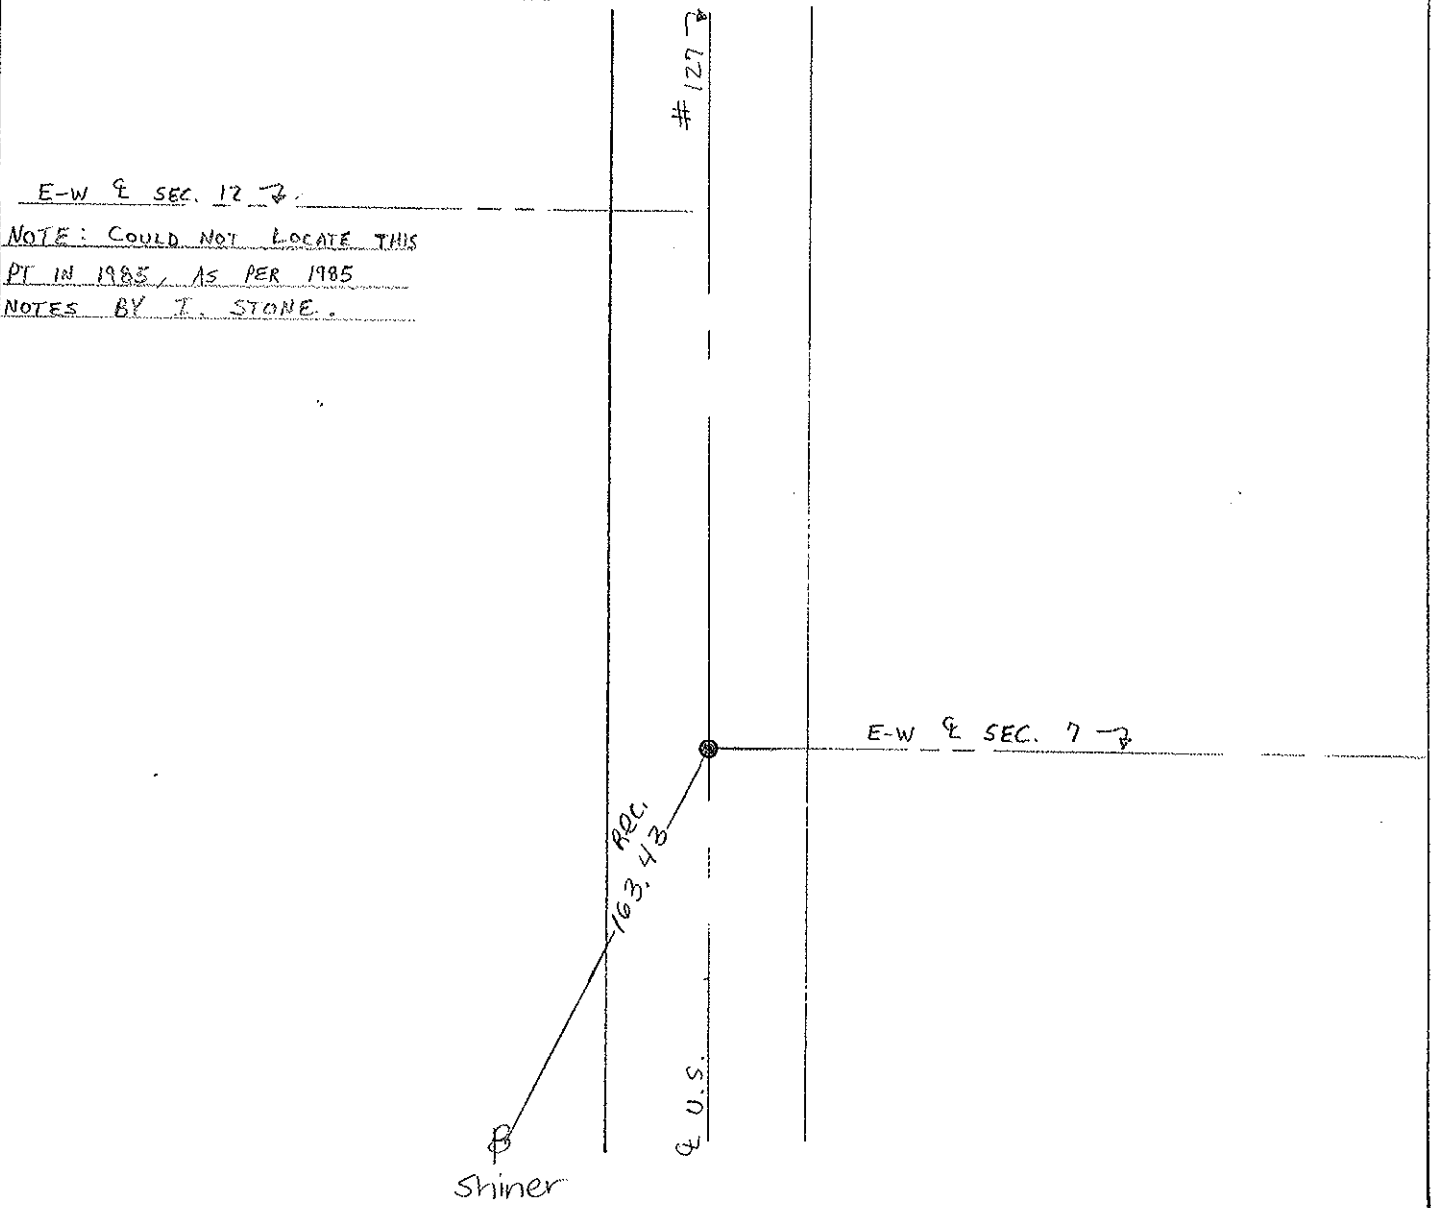

E-W & SEC. 12 →
NOTE: COULD NOT LOCATE THIS
PT IN 1985, AS PER 1985
NOTES BY J. STONE.

E-W & SEC. 7 →

Shiner

O.D.O.T. DISTRICT 2 SURVEY OFFICE

PERSONNEL

REFERENCE NO. 4

SHEET 5 OF

NOTES 1. Stone

H.C. D. Curtis

R.C. R. Michalak

J. Householder

DATE 2 Oct. 85

WEATHER Cool

TEMP. 54°

ROUTE US #127

COUNTY Fulton

TOWNSHIP Gorham

SECTION

T R



TYPE MONUMENT Small RR Spk

ON SURFACE - BELOW Surface

LEFT - ☉ PAV'T. - RIGHT

 TO EDGE PAVEMENT

S.L.M. 232+84

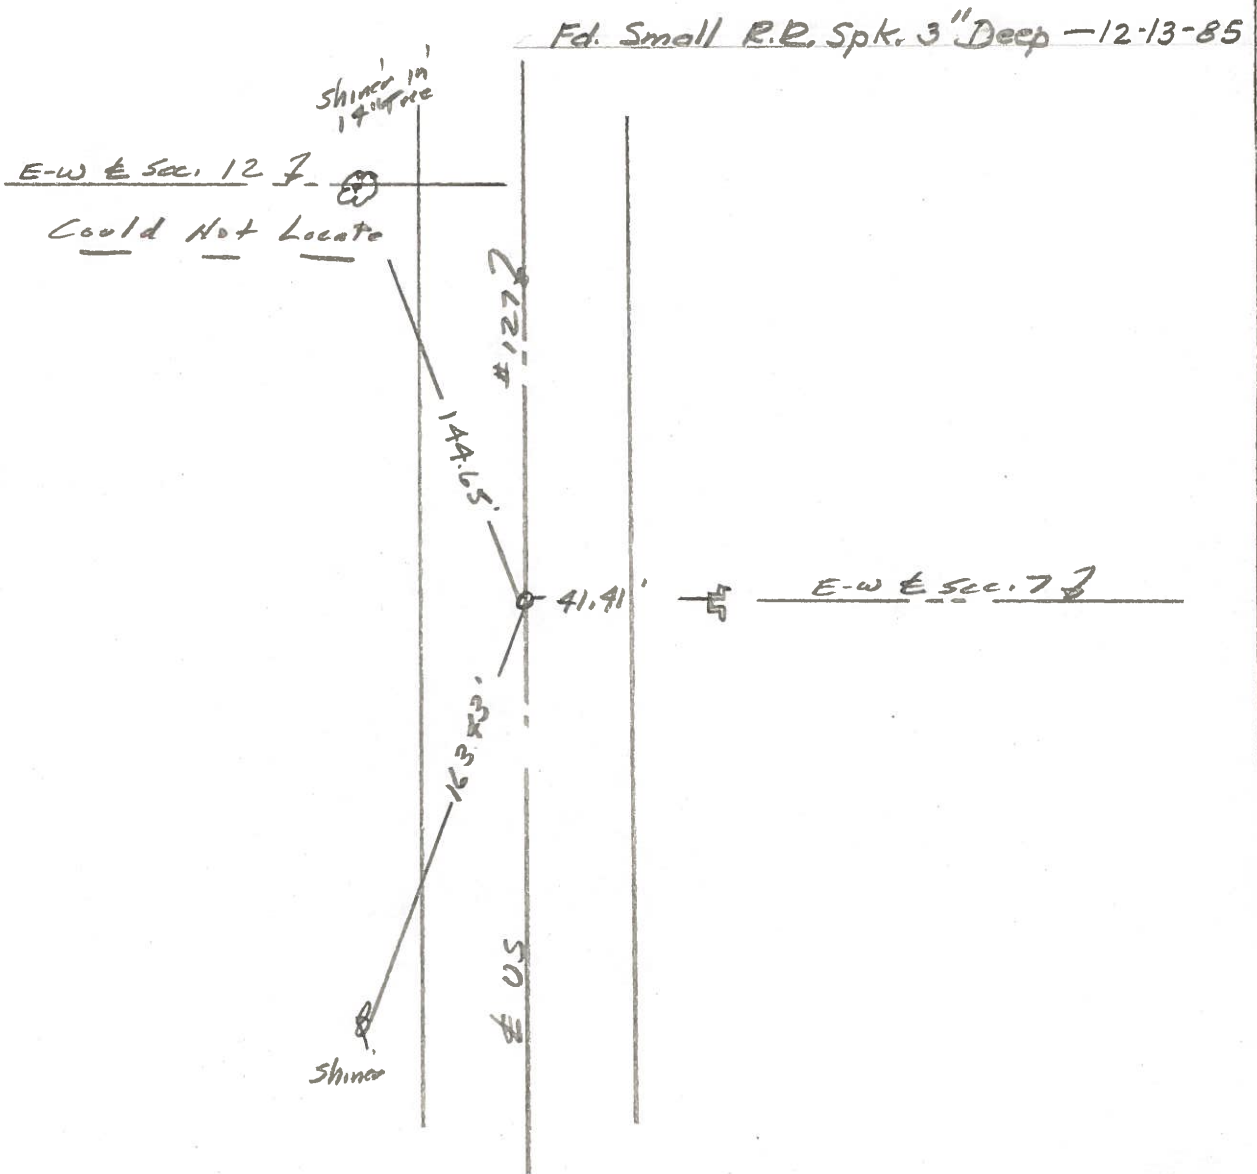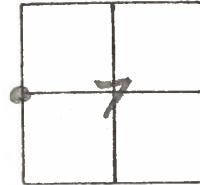

County Fulton US #127

Date 26 June 79

Township Gorham

Weather Warm

Section 7

Temp. 78°


T. N, R. E

Personnel I. Stone

R. Michalak


D. Curtis

D. Granata

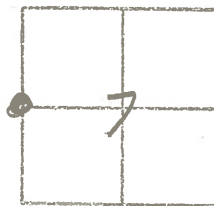

REF. NO. 4

SLM BLKTOP STA. 230+56

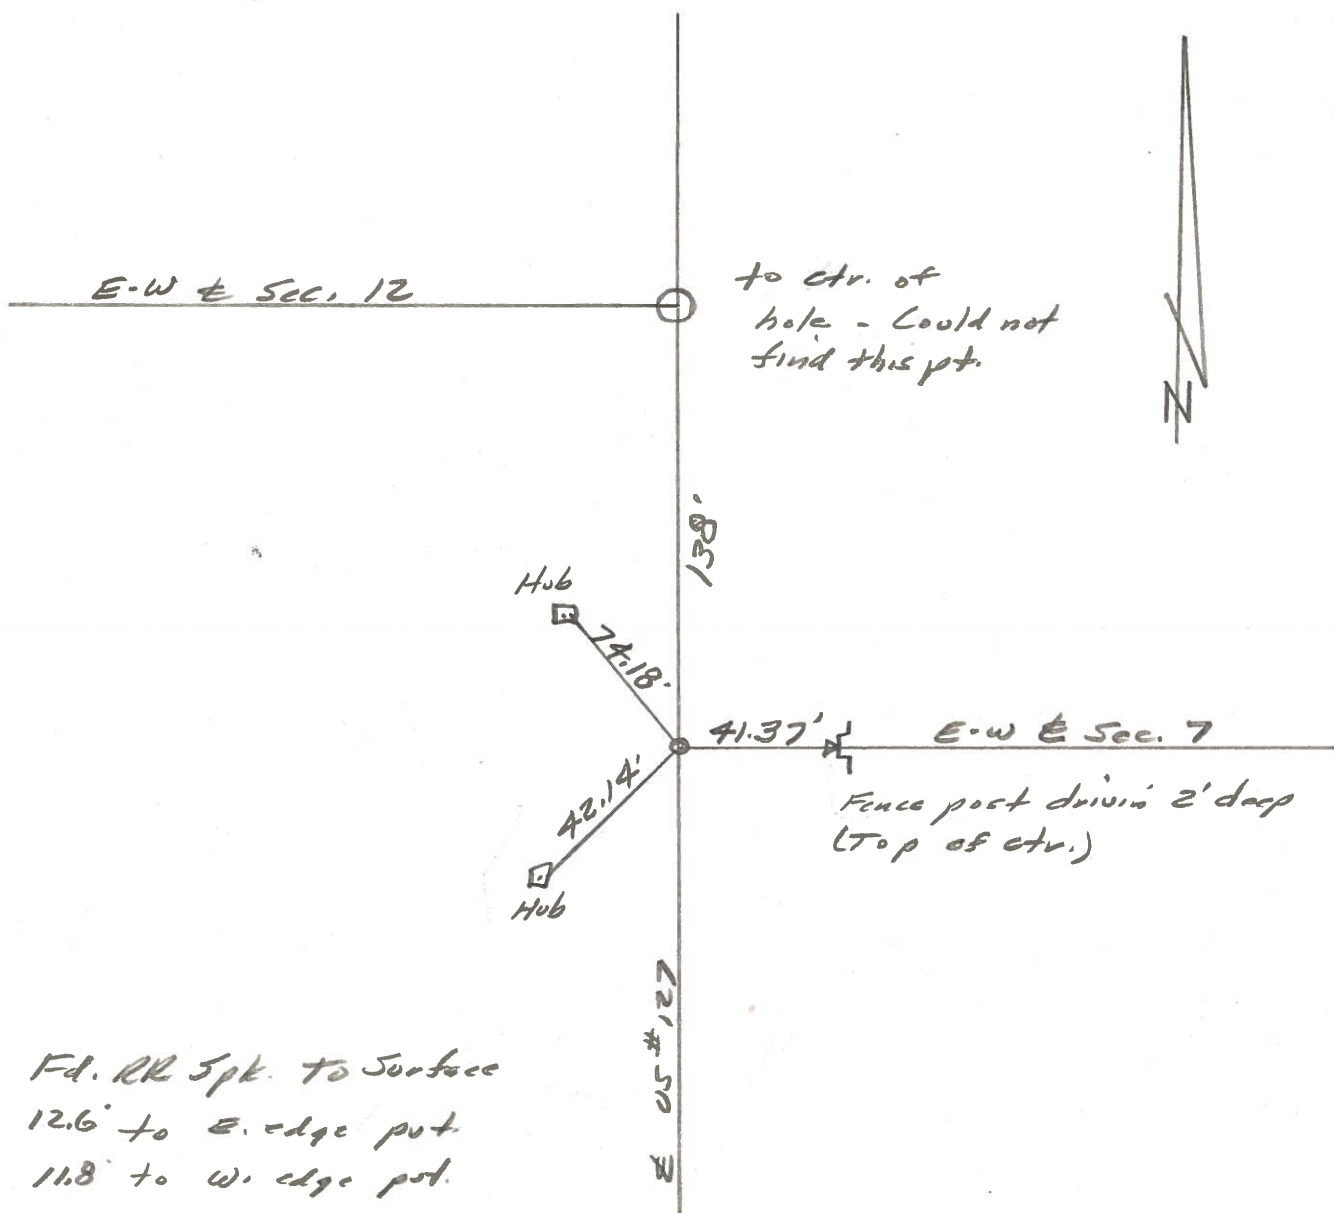

PERSONNEL TITLE PERSONNEL TITLE

COUNTY Fulton DATE July 7, 1966

Denne _____

Curtis _____

S. R. US 127 WEATHER Sunny

Granata _____


SEC. _____ TEMP. 80°

Oney _____

DESCRIPTION Monument Ref us 127 JOB NO. _____

LEFT CENTER LINE RIGHT

~~(H)~~

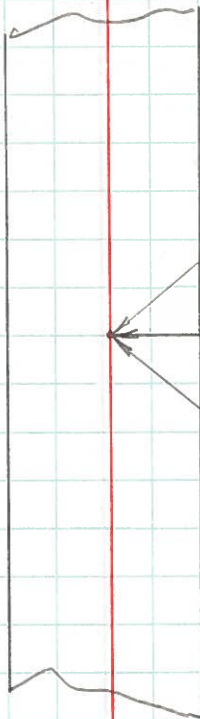

Did not find R.R. spike at Michigan State line

PERSONNEL TITLE PERSONNEL TITLE

COUNTY Fulton DATE July 7, 1966

Denne _____

Curtis _____

S. R. US 127 WEATHER Sunny

Granata _____


SEC. _____ TEMP. 80°

Oney _____

DESCRIPTION Monument Ref us 127 JOB NO. _____

LEFT CENTER LINE RIGHT

~~(H)~~

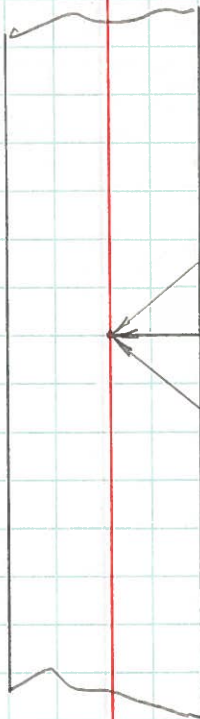

did not find R.R. spike at Michigan State line