

O.D.O.T. DISTRICT 2 SURVEY OFFICE (USE ONLY)

PERSONNEL

REFERENCE NO. 4A


NOTES MILLER
H.C. NIESE
R.C. BARRIERE

DATE 7/7/25
WEATHER CLOUDY
TEMP. 75°

ROUTE US 127
COUNTY FULTON
TOWNSHIP GORHAM
SECTION 7
T 9 N R 1 E

DWG BY BARRIERE PID 94331

TYPE MONUMENT MAG NAIL/WASHER
ON SURFACE - BELOW ON
OFFSET $\odot$ PAVEMENT 0.2' LT

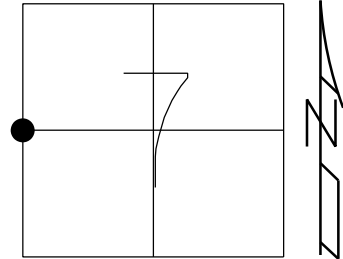

STATION: 233+94.75

HORZ.DATUM: NAD83(11)/FUL OCCS GEOID: 18

GRID: NORTHING: 747066.696 EASTING: 1460486.224

LDP: NORTHING: 401867.847 EASTING: 106574.527

RECORD: P.I.
STA 236+62.90 (1957 PLANS)
 $\Delta=00^{\circ}27'45''$ RT

FD MAG
4/17/25, TDN
SET MAG/WASHER
NEWREF4A
7/7/25, TDN

