

O.D.O.T. DISTRICT 2 SURVEY OFFICE (USE ONLY)

PERSONNEL

REFERENCE NO. 4B


NOTES MILLER
H.C. NIESE
R.C. BARRIERE

DATE 7/7/25
WEATHER CLOUDY
TEMP. 75°

ROUTE US 127
COUNTY FULTON
TOWNSHIP GORHAM
SECTION 7
T 9 N R 1 E

DWG BY BARRIERE PID 94331

TYPE MONUMENT MAG NAIL/WASHER
ON SURFACE - BELOW ON
OFFSET $\odot$ PAVEMENT 1.5' LT

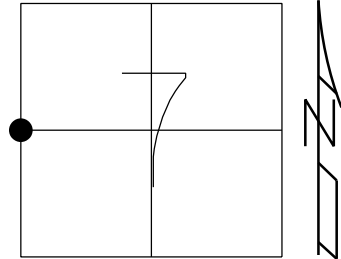

STATION: 235+07.00

HORZ.DATUM: NAD83(11)/FUL OCCS GEOID: 18

GRID: NORTHING: 747178.917 EASTING: 1460488.007

LDP: NORTHING: 401980.085 EASTING: 106574.189

RECORD:
FD MAG
4/17/25, TDN
SET MAG/WASHER
NEWREF 4B
7/7/25, TDN

FD SHI
80.43'

$\odot$ US 127

SET HUB/TACK
35.69'-P

4B

● FD BARN SPIKE
23.24'-D

SET HUB/TACK
76.55'-P

4A
112.24'

● FD BARN SPIKE
33.45'-D

4 138.00' E-W SEC 7