

PRIORITY NO. 31 PART 1 OF 2 SHEET 1 OF 3
 COUNTY Fulton ROUTE US 20 A SECTION 0.00
 BEGIN LOG (SLM) 0.00 TERMINI Williams County line 0-01 JOINT
 END LOG (SLM) 4.13 TERMINI Const joint west of SR 66 Sta 212+77
 TOTAL LENGTH 4.13 MILES
 MUNICIPALITY N/A BEGIN LOG (SLM) _____ END LOG (SLM) _____
 MUNICIPALITY _____ BEGIN LOG (SLM) _____ END LOG (SLM) _____
 PROPOSED WORK:
 PAVEMENT 1 1/2" 404 SHOULDER Same, 617

OTHER Remove RR hump, take topo & x-sections.

EXISTING DATA:

SLM	TO	PAV'T WIDTH	(type)	SHLD WIDTH	(type)
SLM 0+00	TO Co. LINE	20.6'	(type Asph.)	1.8/2.3	(type Asph.)
SLM 53+09	TO M.M. 4	20.1'	(type ")	2.4/2.9	(type ")
SLM 105+60	TO M.M. 2	20.3	(type ")	2.6/3.0	(type ")
SLM 160+53	TO M.M. 3	20.6	(type ")	3.2/2.5	(type ")
SLM 211+94	TO M.M. 4	21.2	(type ")	2.3/2.0	(type ")
SLM 212+77	TO Joint	21.2	(type ")	2.3/2.0	(type ")
SLM _____	TO _____	_____	(type _____)	_____	(type _____)
SLM _____	TO _____	_____	(type _____)	_____	(type _____)
STRUCTURES:

STR. NO.	WIDTH	LENGTH	PROP. WORK
STR. NO. <u>FULTON 20A-0127</u>	<u>44.3</u>	<u>60'</u>	<u>See Add. Sheet</u>
STR. NO. <u>Sta 66+90</u>	_____	_____	_____
STR. NO. _____	_____	_____	_____
STR. NO. <u>Fulton 20A-0253</u>	<u>36.0</u>	<u>222</u>	<u>See Additional Sheet</u>
STR. NO. <u>Sta 133+61</u>	_____	_____	_____
STR. NO. _____	_____	_____	_____

RAILROAD CROSSING: Removed (no work)
 NAME _____ STATION _____ NO. TRACKS _____ LENGTH ALONG C L _____ ft
 NAME _____ STATION _____ NO. TRACKS _____ LENGTH ALONG C L _____ ft
 NAME _____ STATION _____ NO. TRACKS _____ LENGTH ALONG C L _____ ft

MISCELLANEOUS:

NO. RAISED PAVEMENT MARKERS; EDGE OF PAVEMENT 90, CENTERLINE 368
 NO. MAILBOX APPROACHES 0, MAILBOX SUPPORTS 0
 REMARKS: Sta Established; Ref #1 FULTON U.S. 20-A as 0+00 FULTON/WILLIAMS Co. line
Butt joint @ bridge decks

FOUND SURVEY (for possible Culvert Replacement) from Sta 174+00 to Sta 184+00
 Structure Ful 20A-0339

COUNTY Fulton ROUTE US 20 A SECTION 0.00

L = Prop Pav't Depth(in.) x 10; W = Width @ Mouth; W-1 = Width @ Throat

[illegible]


UTILITIES (Catch Basin, Manhole, Inlet, Watervalue Box and Monument Box)

COUNTY Fulton ROUTE US20A SECTION 0.00

R = Raise F = Feather

[illegible]

PERSONNEL	TITLE	PERSONNEL	TITLE	COUNTY	DATE
LOEHRKE				FULTON	8-4-92
E				S. R. V.S. 20-A	WEATHER CLOUDY
CREW				SEC. 0.00	TEMP. +75
DESCRIPTION BRIDGE DECK INFO				FUL 20A - 0127	JOB NO.
LEFT		CENTER LINE		RIGHT	

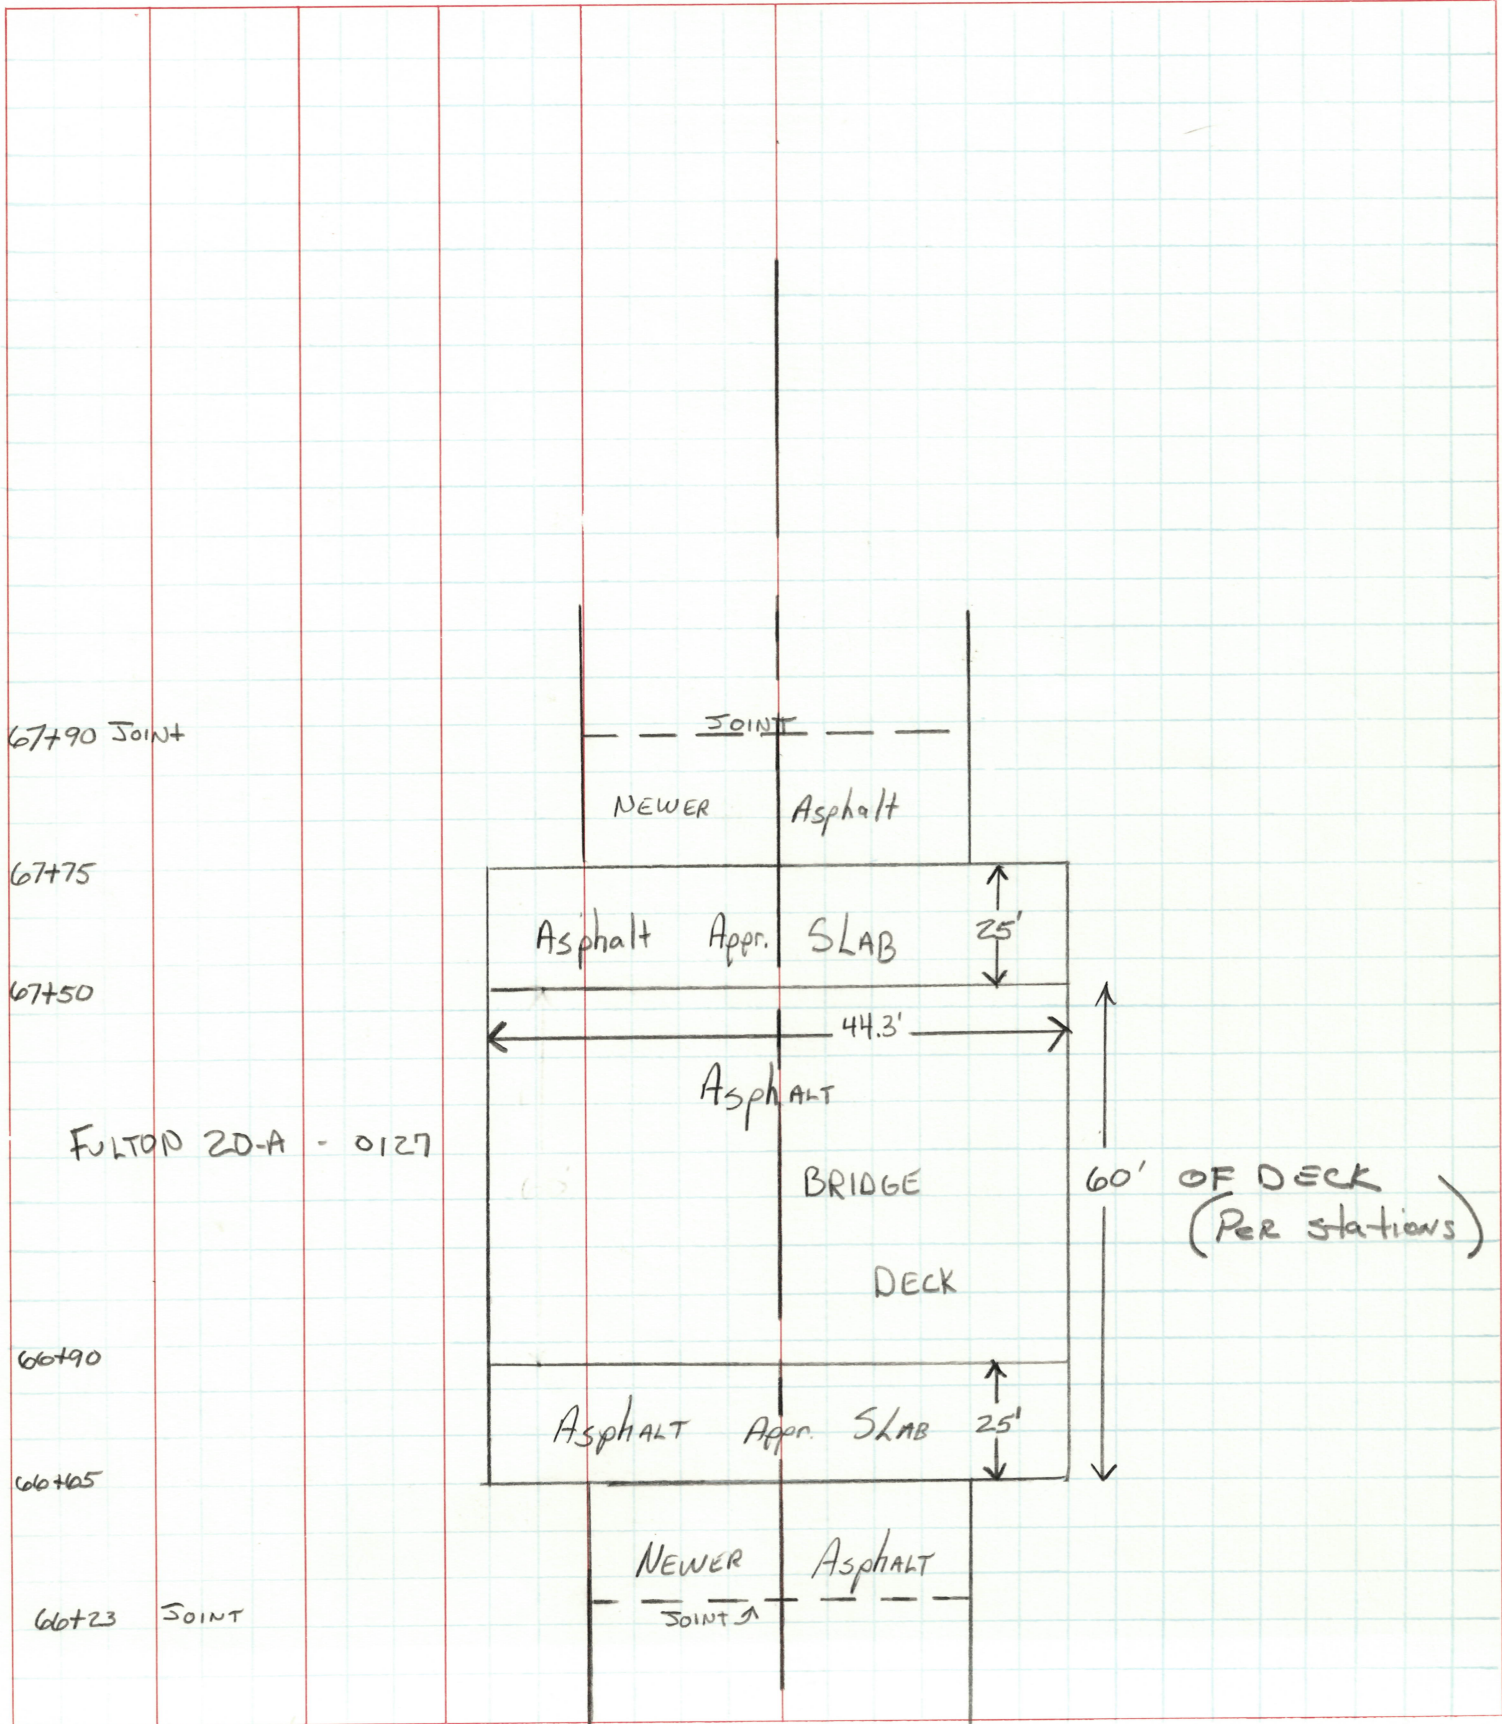

PERSONNEL

TITLE

PERSONNEL

TITLE

COUNTY FULTON

DATE

8-4-92

LOEHKE

S. R. U.S. 20-A

WEATHER

CLOUDY

CREW

SEC. 0.00

TEMP.

+75

DESCRIPTION

BRIDGE DECK INFO


FUL 20-A - 0253

JOB NO.

LEFT

CENTER LINE

RIGHT

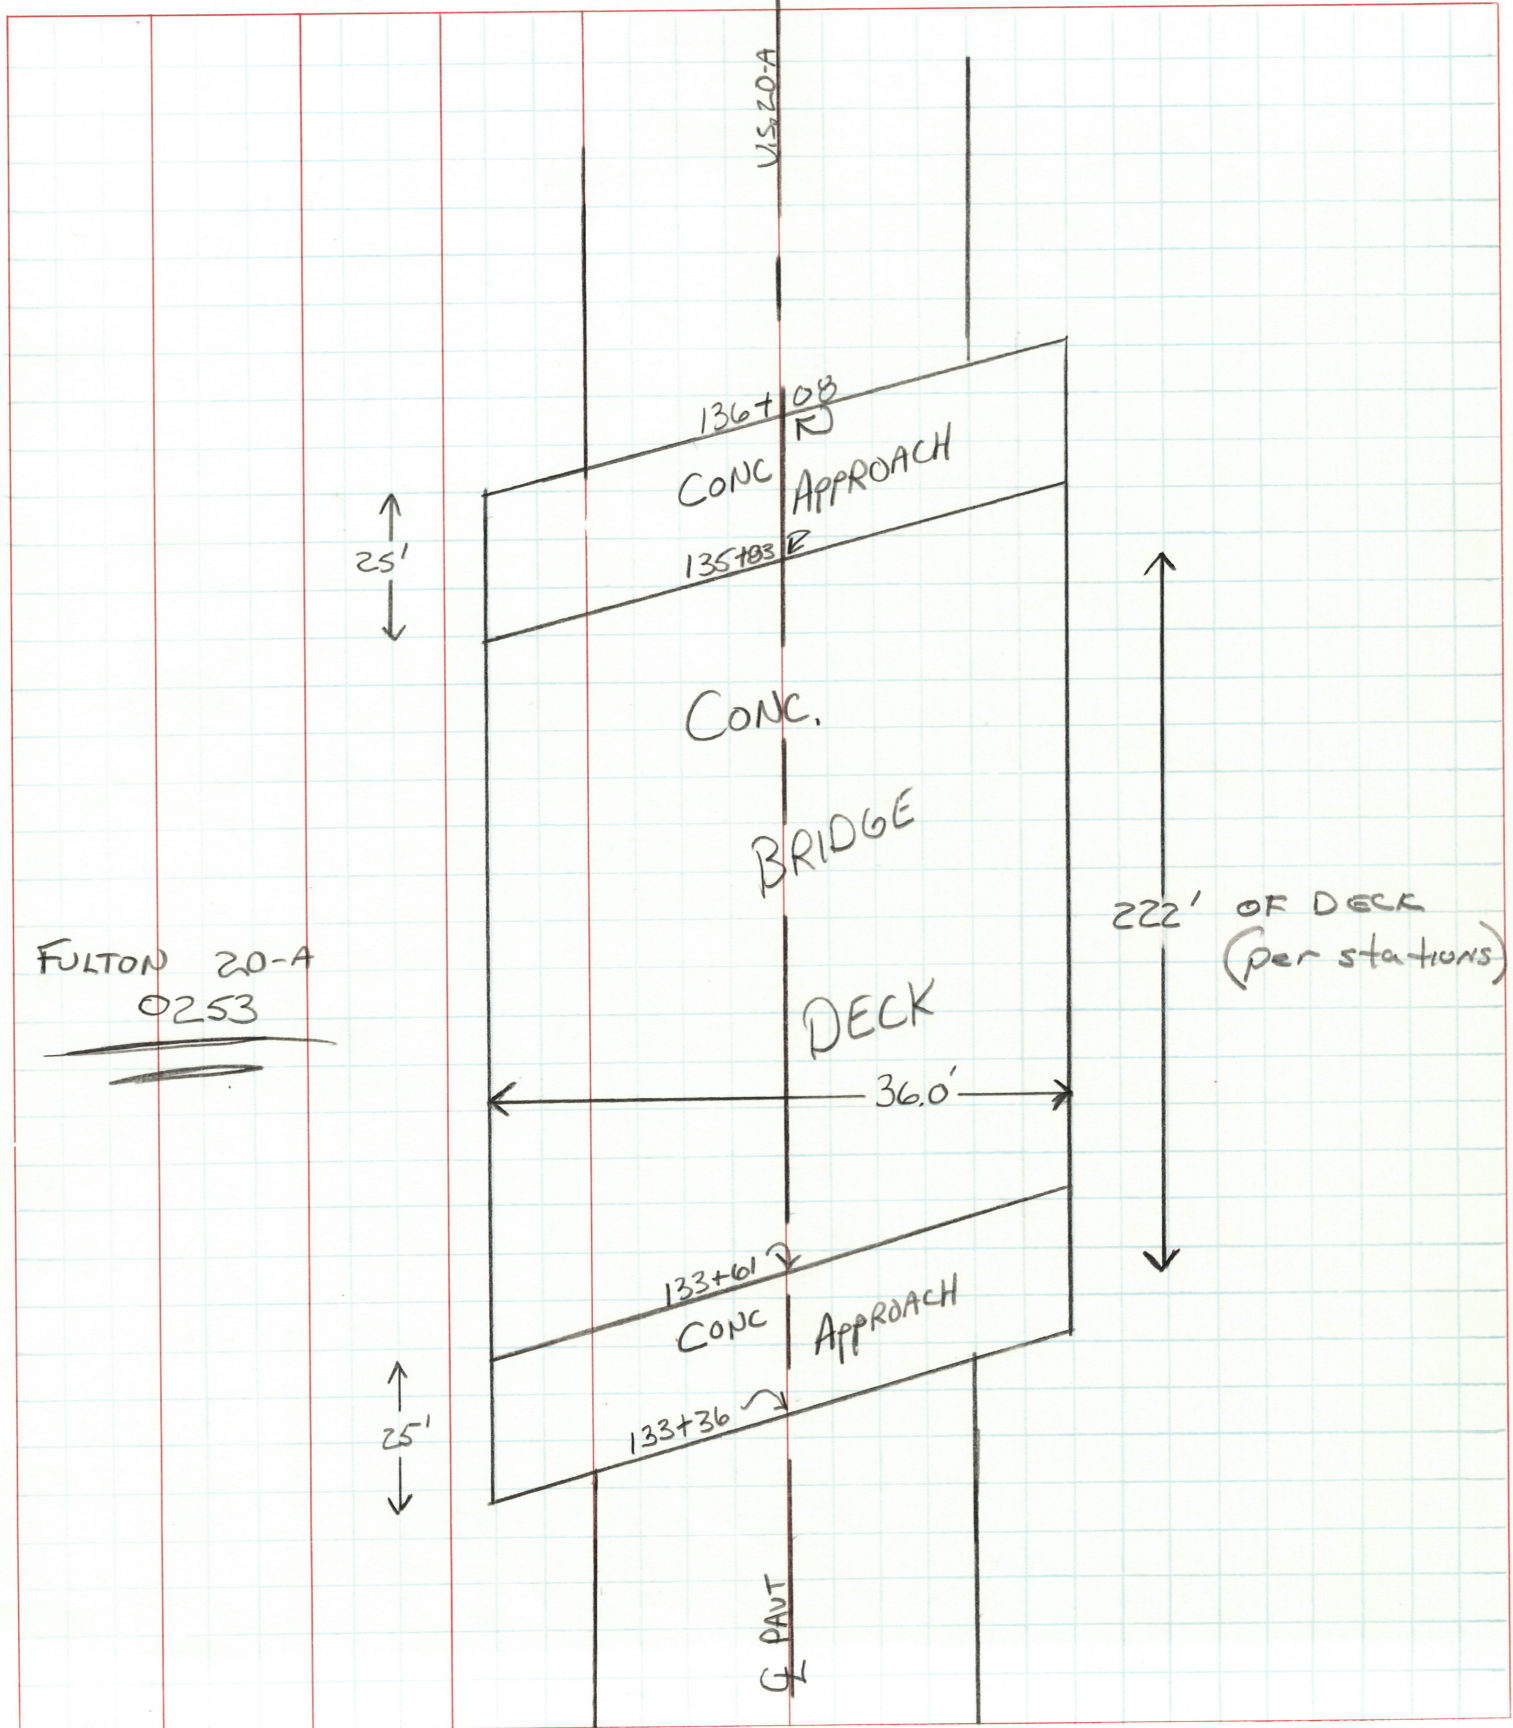

PERSONNEL	TITLE	PERSONNEL	TITLE	COUNTY	DATE
LOEHRKE				FULTON	8-4-92
E				S. R. U.S. 20-A	WEATHER Cloudy
Crew				SEC. 0-00	TEMP. +75
DESCRIPTION <u>INTERSECTION INFO</u>				JOB NO.	
LEFT		CENTER LINE		RIGHT	

