


R/W PLANS
S.H. 20 SEC. F BRIDGE
FULTON COUNTY.

FUL-20A

*R/W checked
and easements obtained
by assessment as shown
J.P.
2/25/44*

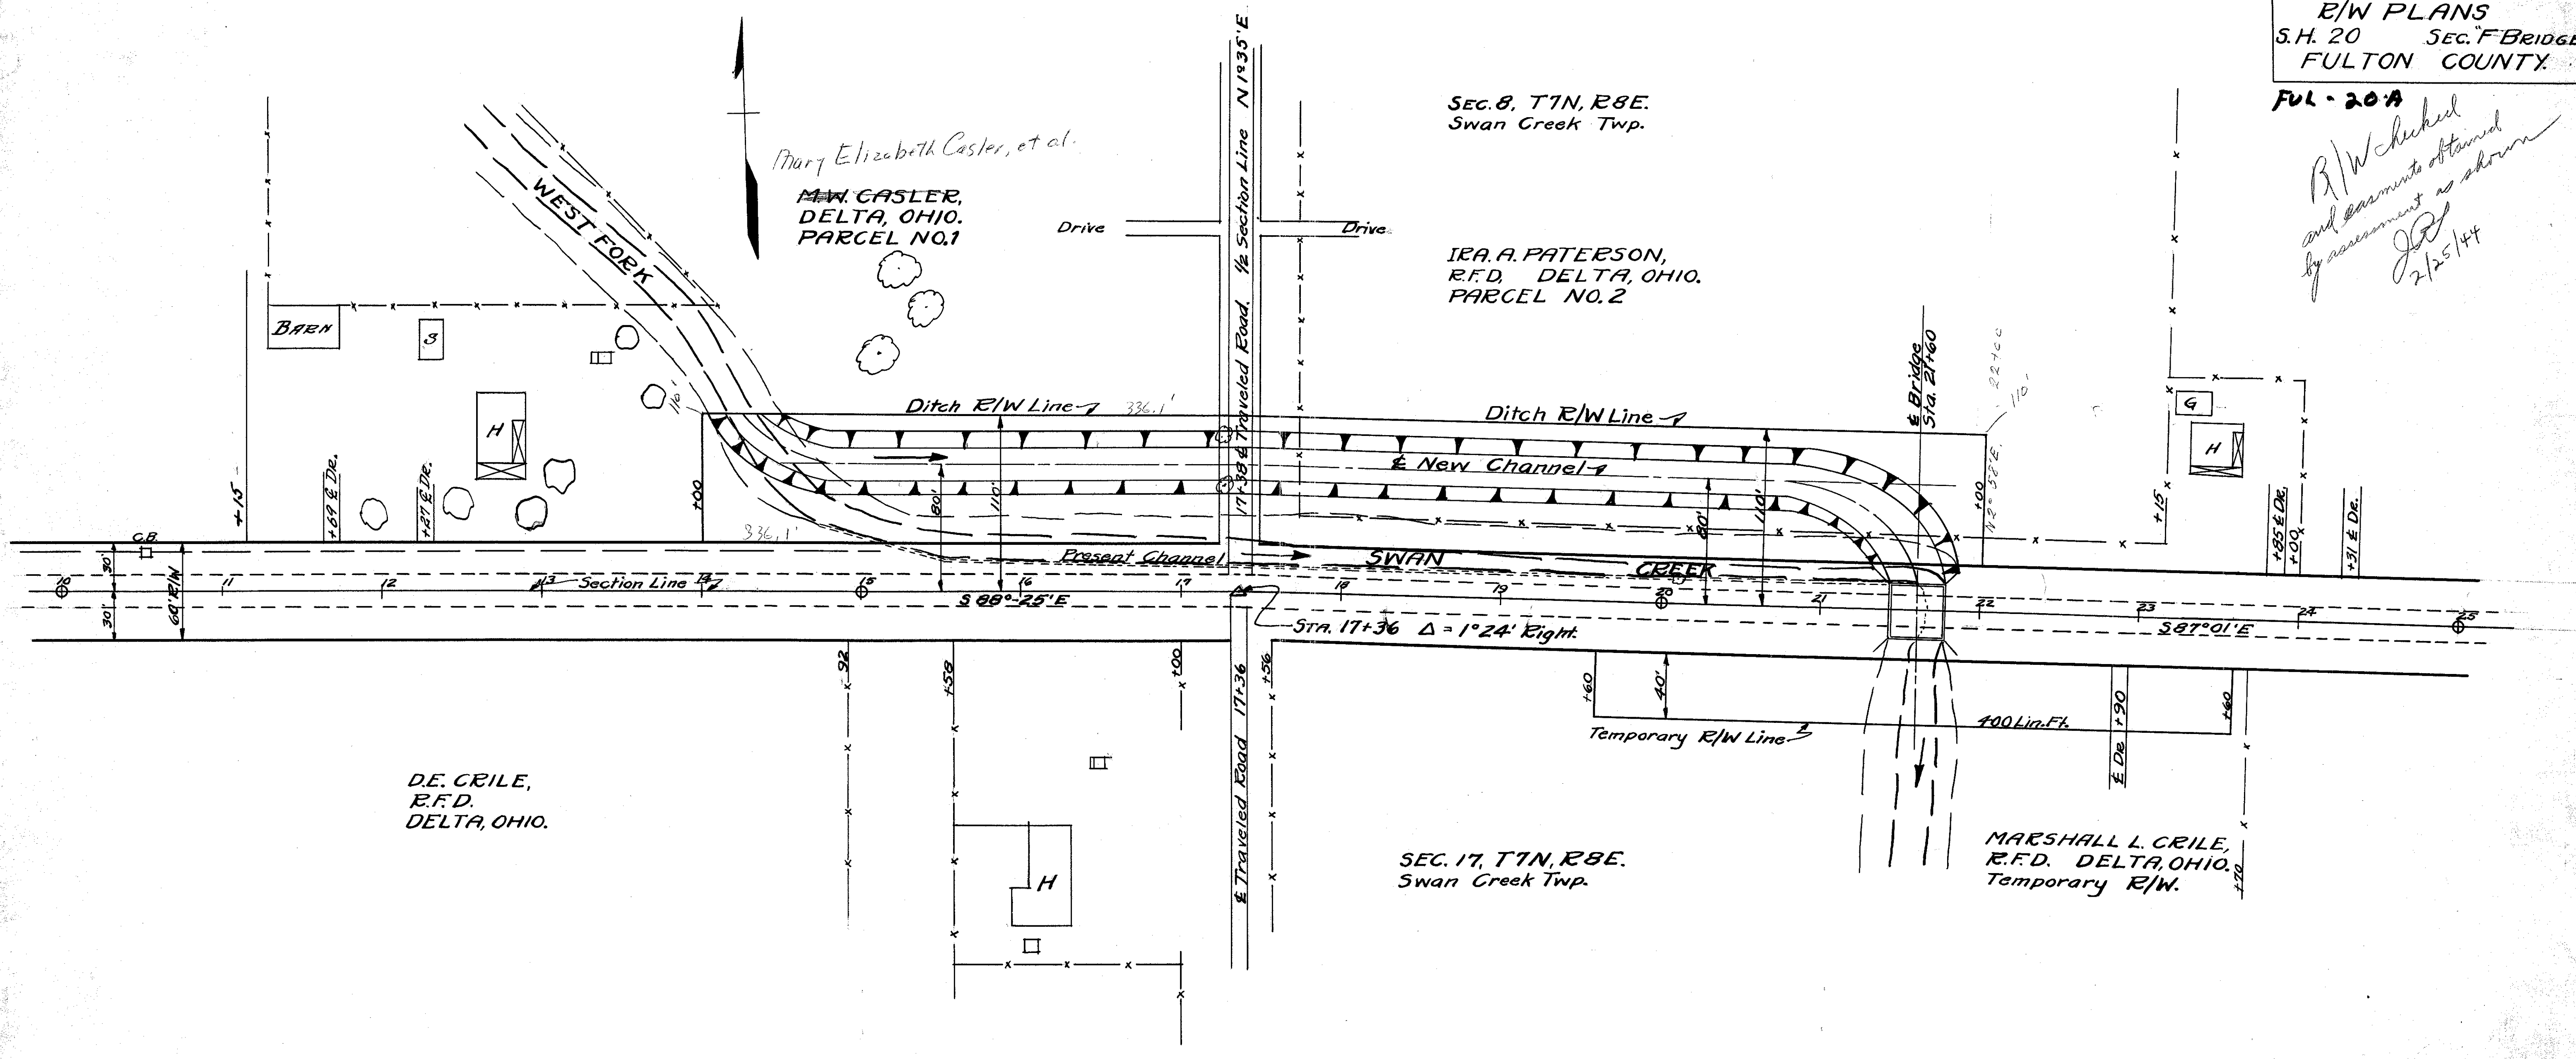

03/20/00
J.P.

R1234A
A-15

A-2

2/25/44

A-2