


PERSONNEL	TITLE	PERSONNEL	TITLE	COUNTY	FULTON	DATE	SEPT. '71
Red Beach				S. R.	US 20-A	WEATHER	
Newcomb				SEC.	10, YORK TWP., T-7-N	TEMP.	
Knape							

DESCRIPTION ALIGNMENT & CONTROLS JOB NO. _____

LEFT CENTER LINE RIGHT

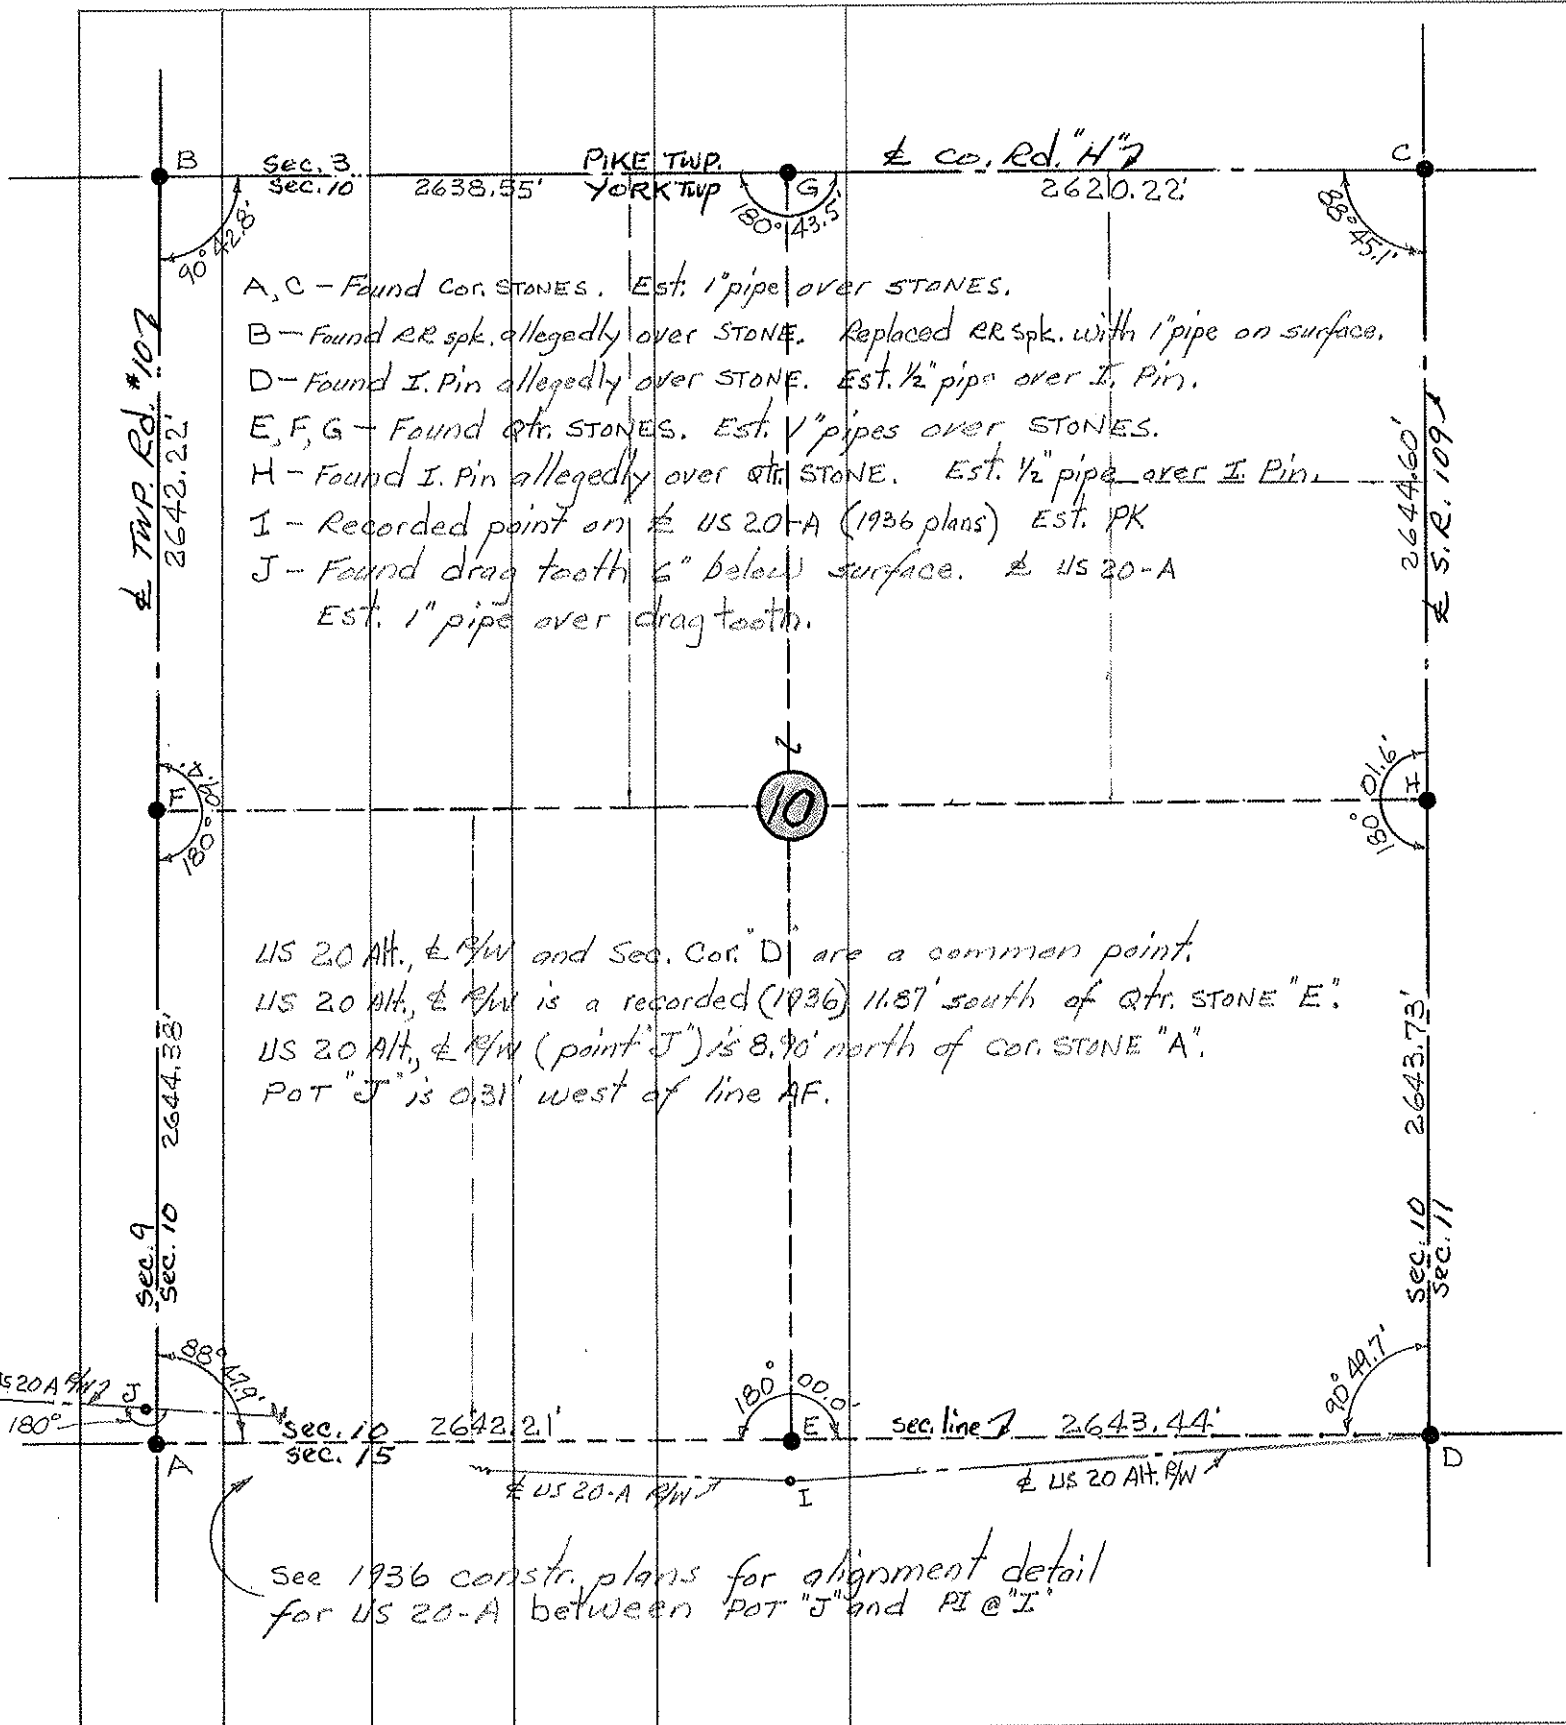

see 1936 constr. plans for alignment detail for US 20-A between POT "J" and PI @ "I"