


O.D.O.T. DISTRICT 2 SURVEY OFFICE (USE ONLY)


PERSONNEL _____ REFERENCE NO. 4 A SHEET 5 OF 63
 NOTES NIESE DATE 2/26/21 ROUTE US 20A
 H.C. RHOADES WEATHER CLOUDY COUNTY FULTON
 R.C. _____ TEMP. 31° TOWNSHIP GERMAN
 DWG BY NIESE PID PAVETRAIN SECTION 12
 T 7 N R 4 E

TYPE MONUMENT MAG NAIL
 ON SURFACE - ~~BELOW~~ ON
 OFFSET C PAVEMENT 39.76' LT : RT
- TO - EDGE PAVEMENT
 STATION: 79+15

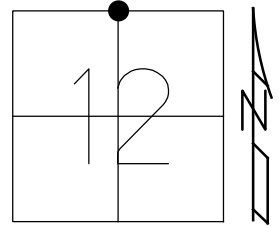

HORZ. DATUM: NAD83 2011 GEOID: NAVD88 2012A
 GRID: NORTHING: 704950.856 EASTING: 1461857.855

RECORD:
 FD IPIPE
 2004
 FD LG.R.R.SPIKE
 7/9/04, DCH
 FD MAG/WASHER
 REFA4
 9/23/20, JFO
 2/26/21, JMR

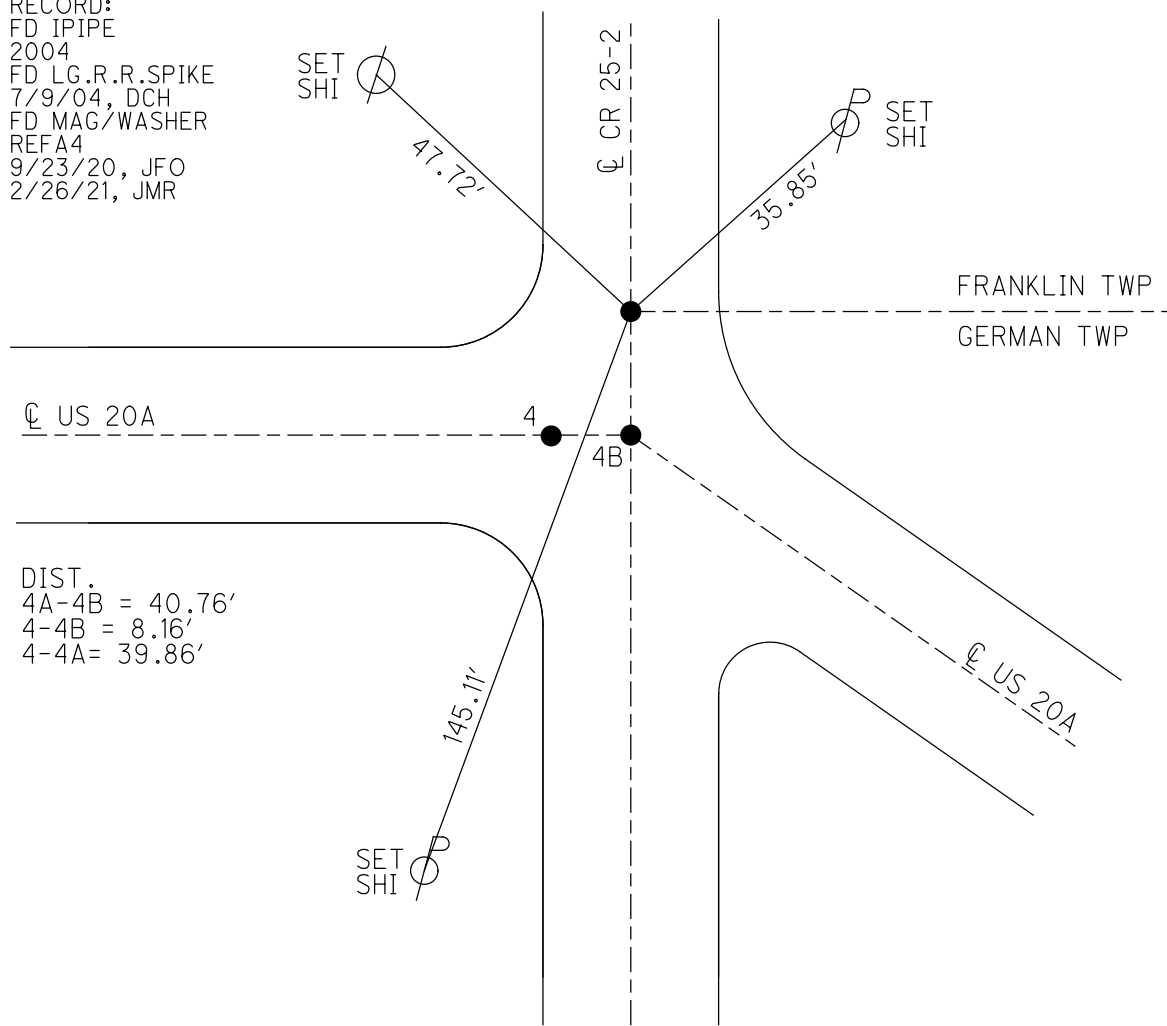


DIST.
 4A-4B = 40.76'
 4-4B = 8.16'
 4-4A = 39.86'

O.D.O.T. DISTRICT 2 SURVEY OFFICE (USE ONLY)


PERSONNEL _____ REFERENCE NO. 4 A SHEET 5 OF 63
 NOTES NIESE DATE 2/26/21 ROUTE US 20A
 H.C. RHOADES WEATHER CLOUDY COUNTY FULTON
 R.C. _____ TEMP. 31° TOWNSHIP GERMAN
 _____ SECTION 12
 DWG BY NIESE PID PAVETRAIN T 7 N R 4 E

TYPE MONUMENT MAG NAIL
 ON SURFACE - ~~BELOW~~ ON
 OFFSET Q PAVEMENT 39.76' LT : ~~RT~~
- TO - EDGE PAVEMENT
 STATION: 79+15

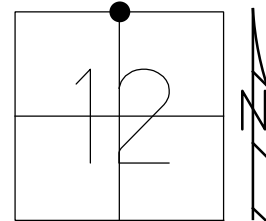

HORZ.DATUM: NAD83 2011 GEOID: NAVD88 2012A
 GRID: NORTHING: 704950.856 EASTING: 1461857.855

RECORD:
 FD IPIPE
 2004
 FD LG.R.R.SPIKE
 7/9/04, DCH
 FD MAG/WASHER
 REFA4
 9/23/20, JFO
 2/26/21, JMR

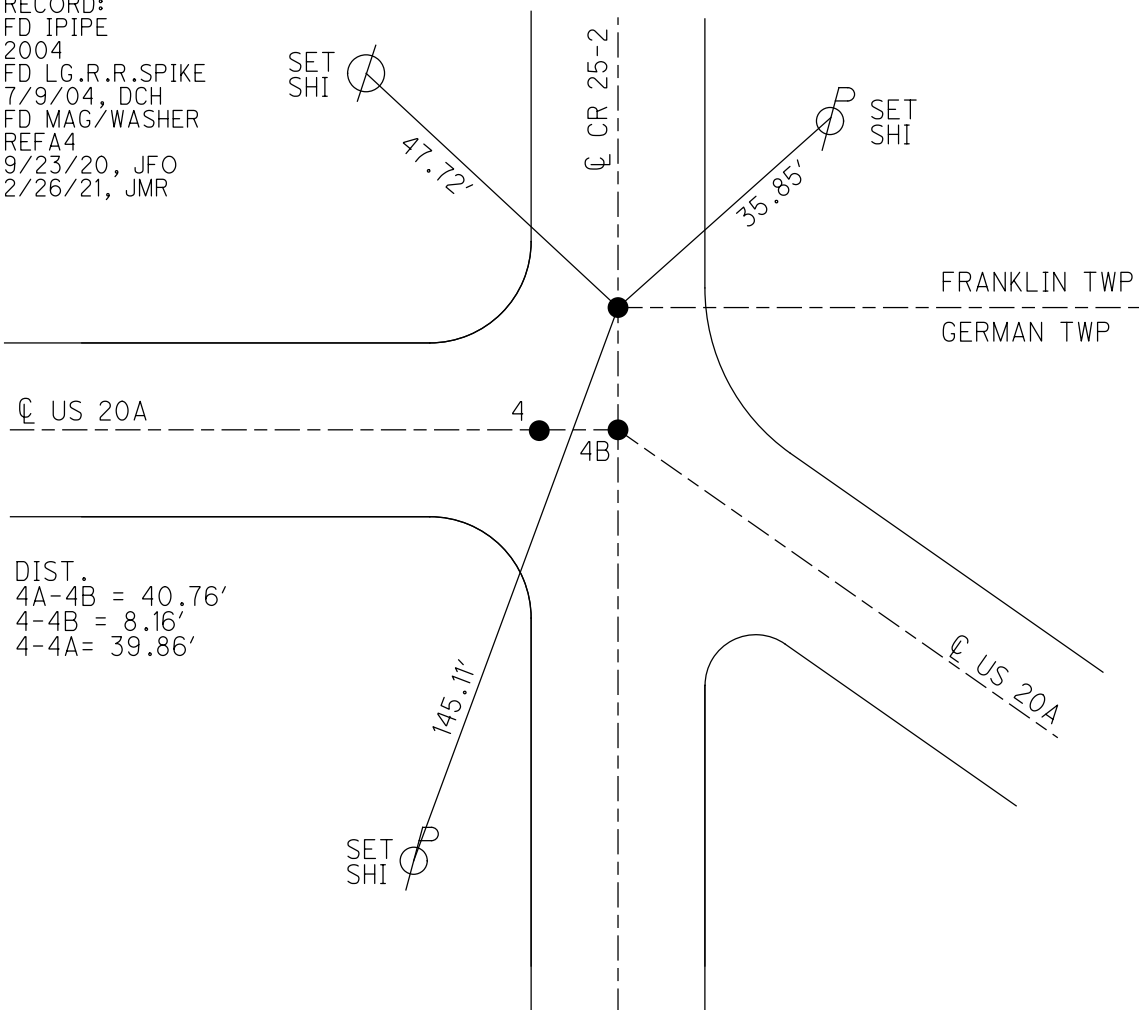


DIST.
 4A-4B = 40.76'
 4-4B = 8.16'
 4-4A = 39.86'

O.D.O.T. DISTRICT 2 SURVEY OFFICE (USE ONLY)


PERSONNEL _____ REFERENCE NO. 4 A SHEET 5 OF 63
 NOTES RHOADES DATE 9/23/20 ROUTE US 20A
 H.C. O'DONNELL WEATHER SUNNY COUNTY FULTON
 R.C. AUBLE TEMP. 62° TOWNSHIP GERMAN
 DWG BY RHOADES PID PAVETRAIN SECTION 12
 T 7 N R 4 E

TYPE MONUMENT MAG NAIL
 ON SURFACE - ~~BELOW~~ ON
 OFFSET \varnothing PAVEMENT 39.76' LT : ~~RT~~
- TO - EDGE PAVEMENT
 STATION: 79+15

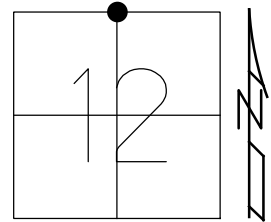

HORIZ.DATUM: NAD83 2011 GEOID: NAVD88 2012A
 GRID: NORTHING: 704950.856 EASTING: 1461857.855

RECORD:
 FD IPIPE
 2004
 FD LG.R.R.SPIKE
 7/9/04, DCH
 FD MAG/WASHER
 REFA4
 9/23/20, JFO

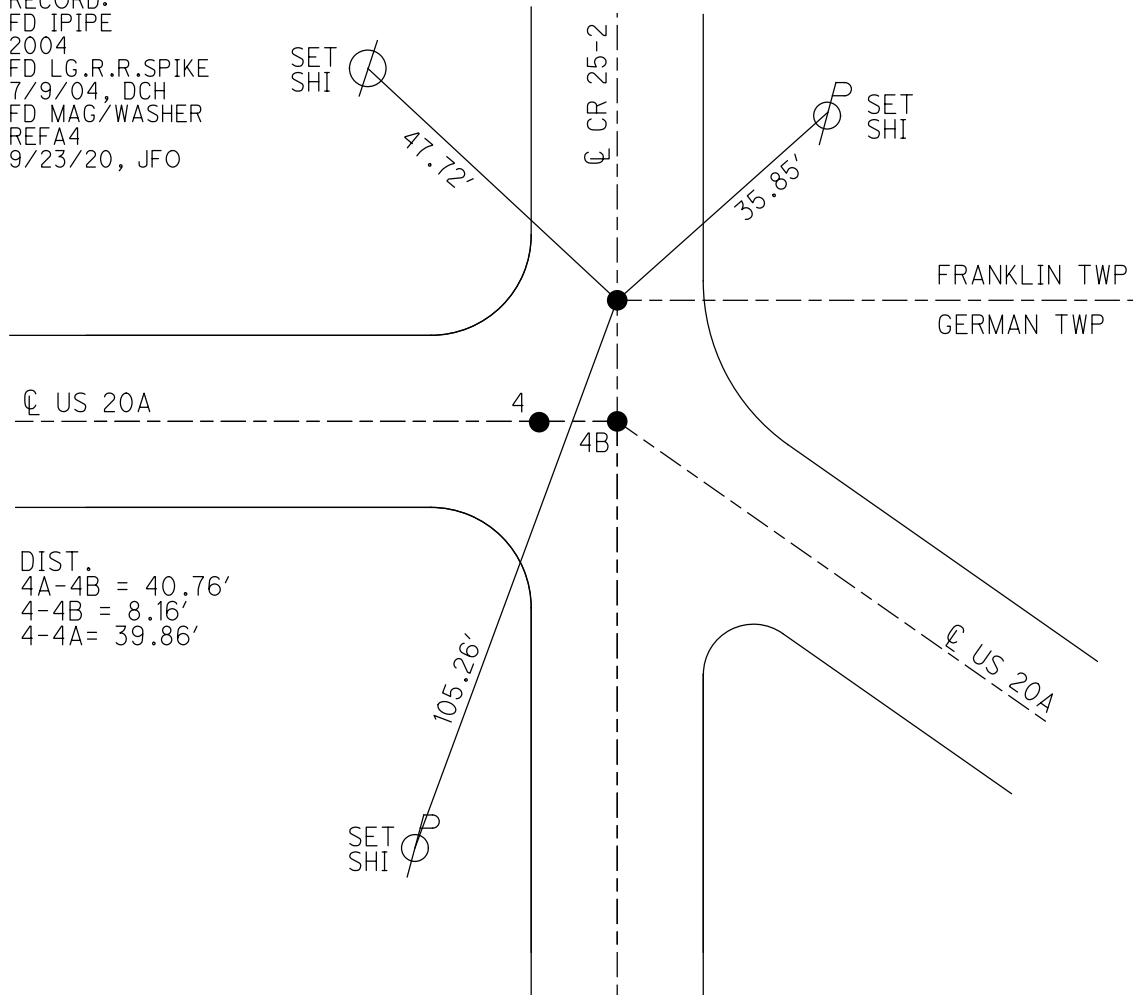


DIST.
 4A-4B = 40.76'
 4-4B = 8.16'
 4-4A = 39.86'


O.D.O.T. DISTRICT 2 SURVEY OFFICE (USE ONLY)

PERSONNEL _____ REFERENCE NO. 4 A SHEET 4 OF 61
 NOTES HOMAN DATE 7/9/04 ROUTE US 20A
 H.C. HUSS WEATHER SUNNY COUNTY FULTON
 R.C. NUHFER TEMP. 75° TOWNSHIP GERMAN
 SECTION 12
 T 7 N R 4 E

TYPE MONUMENT LG.R.R.SPIKE
 ON SURFACE - ~~BELOW~~ ON _____
 LEFT-Q PAV'T-~~RIGHT~~ 39.76'
 - TO - EDGE PAVEMENT
 S.L.M. 79+15
 GRID: NORTHING: _____ EASTING: _____

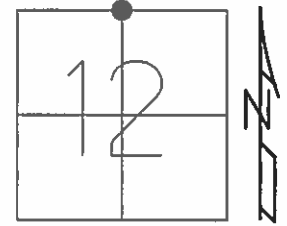

RECORD: 2004
 PIPE ON SECTION CORNER

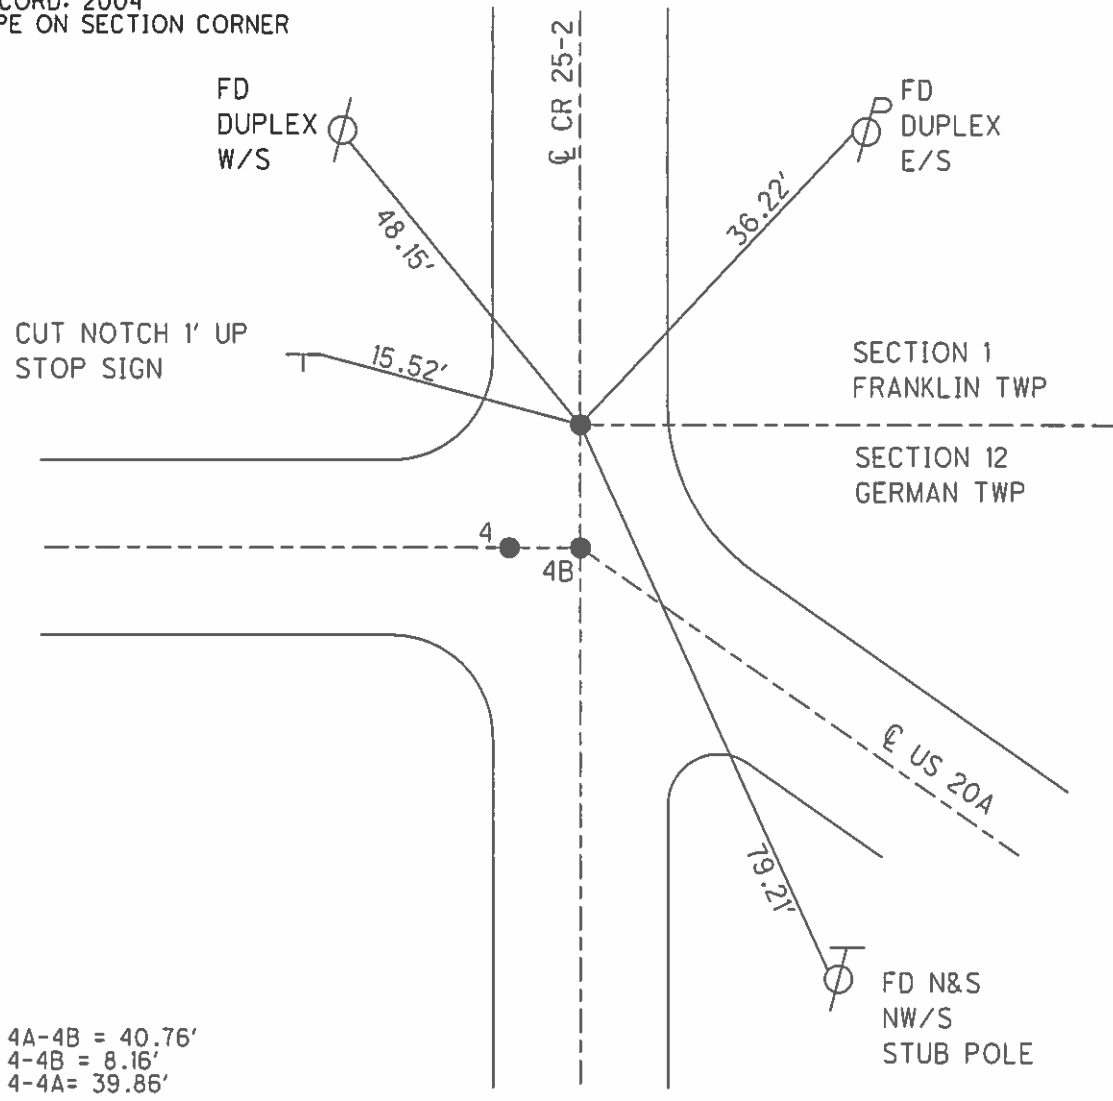

PERSONNEL	TITLE	PERSONNEL	TITLE	COUNTY	DATE	WEATHER	TEMP.
TOMSK		Boyle		Fulton	Aug 15, 1973		
Naxel				S. R. U.S. 20A			
Granata				SEC. German TWP.			
Vanyo							

DESCRIPTION _____ LEFT _____ CENTER LINE _____ RIGHT _____ JOB NO. _____

