


O.D.O.T. DISTRICT 2 SURVEY OFFICE (USE ONLY)


PERSONNEL _____ REFERENCE NO. 4 B SHEET 6 OF 63
 NOTES NIESE DATE 2/26/21 ROUTE US 20A
 H.C. RHOADES WEATHER CLOUDY COUNTY FULTON
 R.C. _____ TEMP. 31° TOWNSHIP GERMAN
 DWG BY NIESE PID PAVETRAIN SECTION 12
 T 7 N R 4 E

TYPE MONUMENT MAG/WASHER
 ON SURFACE - ~~BELOW~~ ON
 OFFSET \odot PAVEMENT 1.1' LT : RT
- TO - EDGE PAVEMENT
 STATION: 79+15

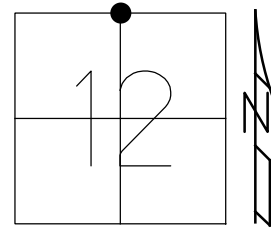

HORZ. DATUM: NAD83 2011 GEOID: NAVD88 2012A
 GRID: NORTHING: 704910.134 EASTING: 1461857.214

RECORD:
 FD P.K./WASHER
 7/9/04, DCH
 SET P.K./WASHER
 8/24/04, MB
 FD MAG/WASHER
 REFB4
 9/23/20, JFO
 2/26/21, JMR
 8/26/21, JFO

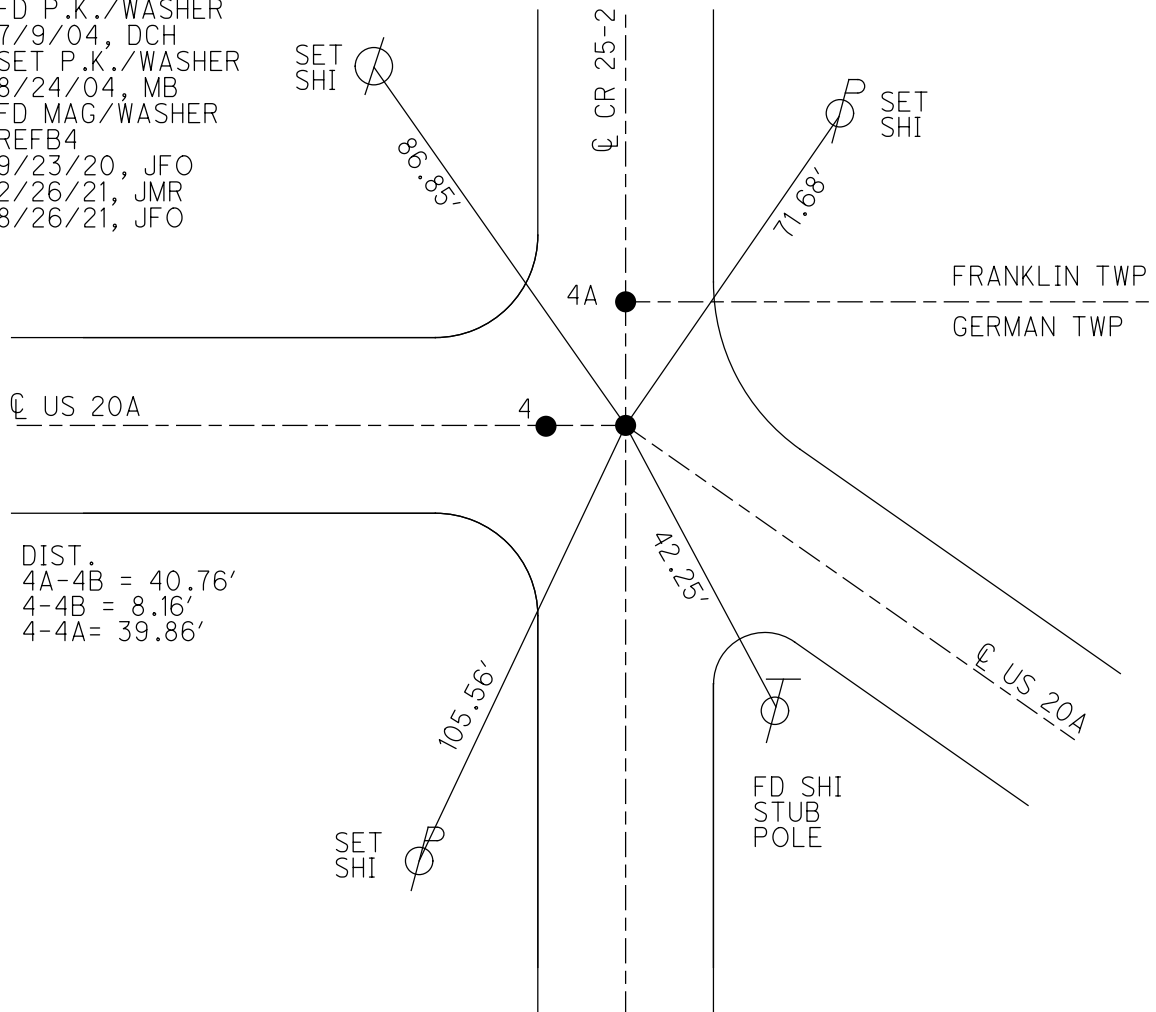


DIST.
 4A-4B = 40.76'
 4-4B = 8.16'
 4-4A = 39.86'

O.D.O.T. DISTRICT 2 SURVEY OFFICE (USE ONLY)


PERSONNEL _____ REFERENCE NO. 4 B SHEET 6 OF 63
 NOTES NIESE DATE 2/26/21 ROUTE US 20A
 H.C. RHOADES WEATHER CLOUDY COUNTY FULTON
 R.C. _____ TEMP. 31° TOWNSHIP GERMAN
 DWG BY RHOADES PID PAVETRAIN SECTION 12
 T 7 N R 4 E

TYPE MONUMENT MAG/WASHER
 ON SURFACE - ~~BELOW~~ ON
 OFFSET \odot PAVEMENT 1.1' ~~±~~ : RT
- TO - EDGE PAVEMENT
 STATION: 79+15

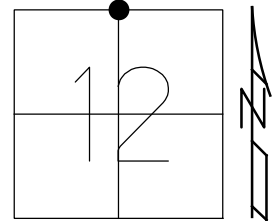

HORZ. DATUM: NAD83 2011 GEOID: NAVD88 2012A
 GRID: NORTHING: 704910.134 EASTING: 1461857.214

RECORD:
 FD P.K./WASHER
 7/9/04, DCH
 SET P.K./WASHER
 8/24/04, MB
 FD MAG/WASHER
 REFB4
 9/23/20, JFO
 2/26/21, JMR

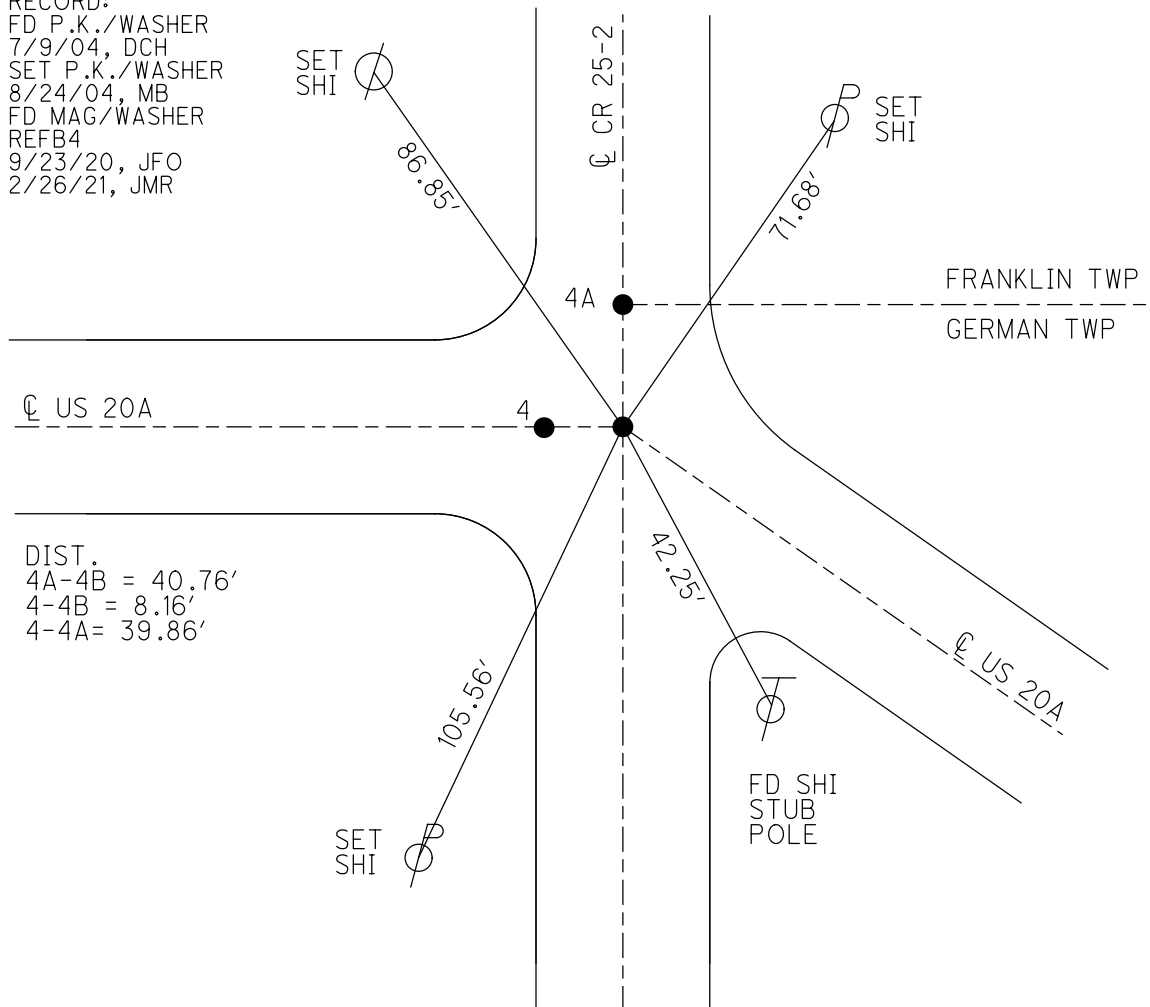


DIST.
 4A-4B = 40.76'
 4-4B = 8.16'
 4-4A = 39.86'

O.D.O.T. DISTRICT 2 SURVEY OFFICE (USE ONLY)


PERSONNEL _____ REFERENCE NO. 4 B SHEET 6 OF 63
 NOTES RHOADES DATE 9/23/20 ROUTE US 20A
 H.C. O'DONNELL WEATHER SUNNY COUNTY FULTON
 R.C. AUBLE TEMP. 62° TOWNSHIP GERMAN
 DWG BY RHOADES PID PAVETRAIN SECTION 12
 T 7 N R 4 E

TYPE MONUMENT MAG/WASHER
 ON SURFACE - ~~BELOW~~ ON _____
 OFFSET \varnothing PAVEMENT 1.1' ~~LT~~ : RT
 _____ TO _____ EDGE PAVEMENT
 STATION: 79+15

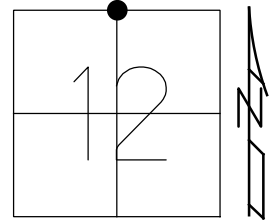

HORZ. DATUM: NAD83 2011 GEOID: NAVD88 2012A
 GRID: NORTHING: 704910.134 EASTING: 1461857.214

RECORD:
 FD P.K./WASHER
 7/9/04, DCH
 SET P.K./WASHER
 8/24/04, MB
 FD MAG/WASHER
 REFB4
 9/23/20, JFO

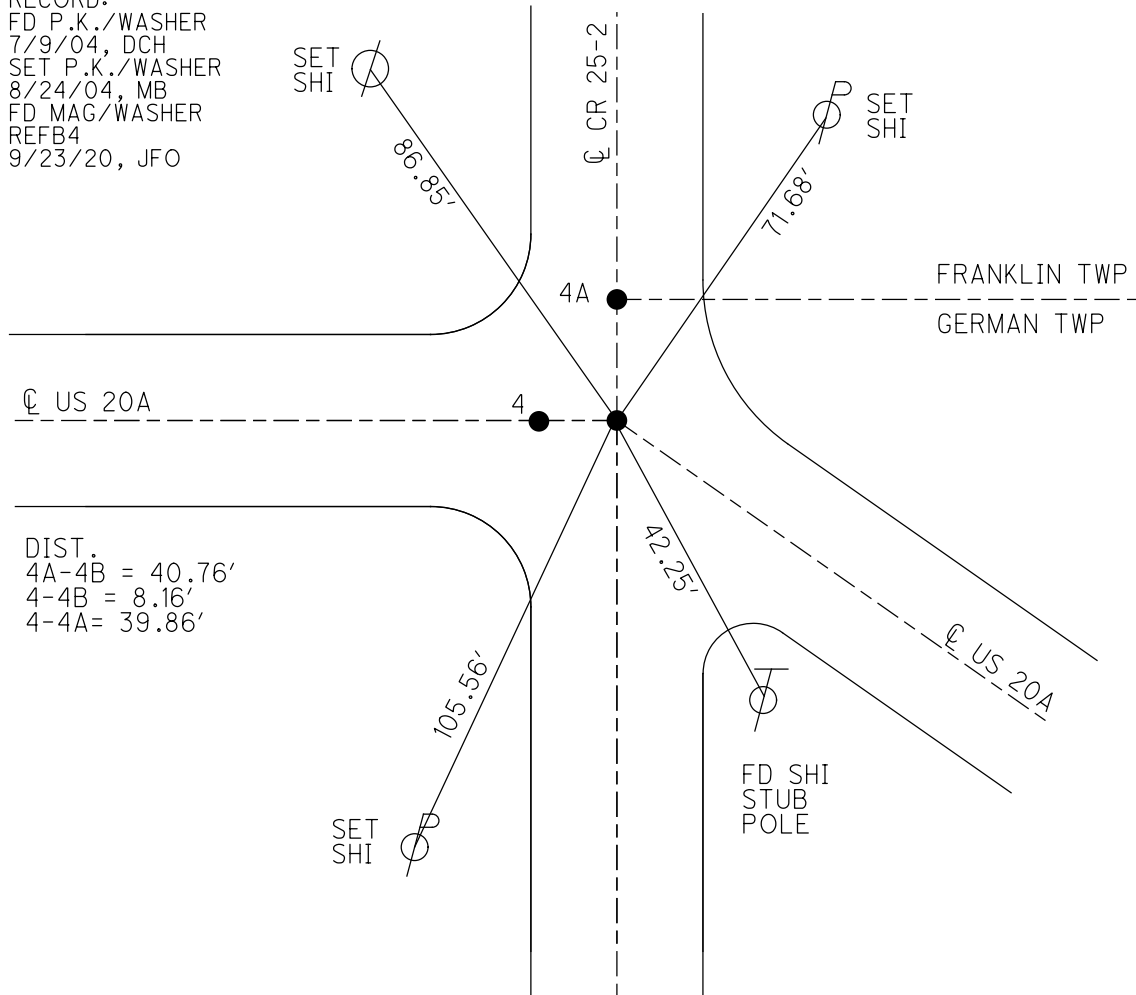


DIST.
 4A-4B = 40.76'
 4-4B = 8.16'
 4-4A = 39.86'

O.D.O.T. DISTRICT 2 SURVEY OFFICE (USE ONLY)


PERSONNEL _____ REFERENCE NO. 4 B SHEET 6 OF 61
 NOTES HUSS DATE 7/9/04 ROUTE US 20A
 H.C. HUSS WEATHER SUNNY COUNTY FULTON
 R.C. NUHFER TEMP. 75° TOWNSHIP GERMAN
 SECTION 12
 T 7 N R 4 E

TYPE MONUMENT P.K./WASHER
 ON SURFACE - ~~BELOW~~ ON _____
~~LEFT-C~~ PAV'T-RIGHT 1.1'
 - TO - EDGE PAVEMENT
 S.L.M. 79+15
 GRID: NORTHING: _____ EASTING: _____

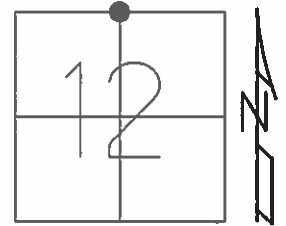

RECORD: 2004
 P.K. ON N-S SECTION LINE

SET P.K./WASHER
 8/24/04, MB

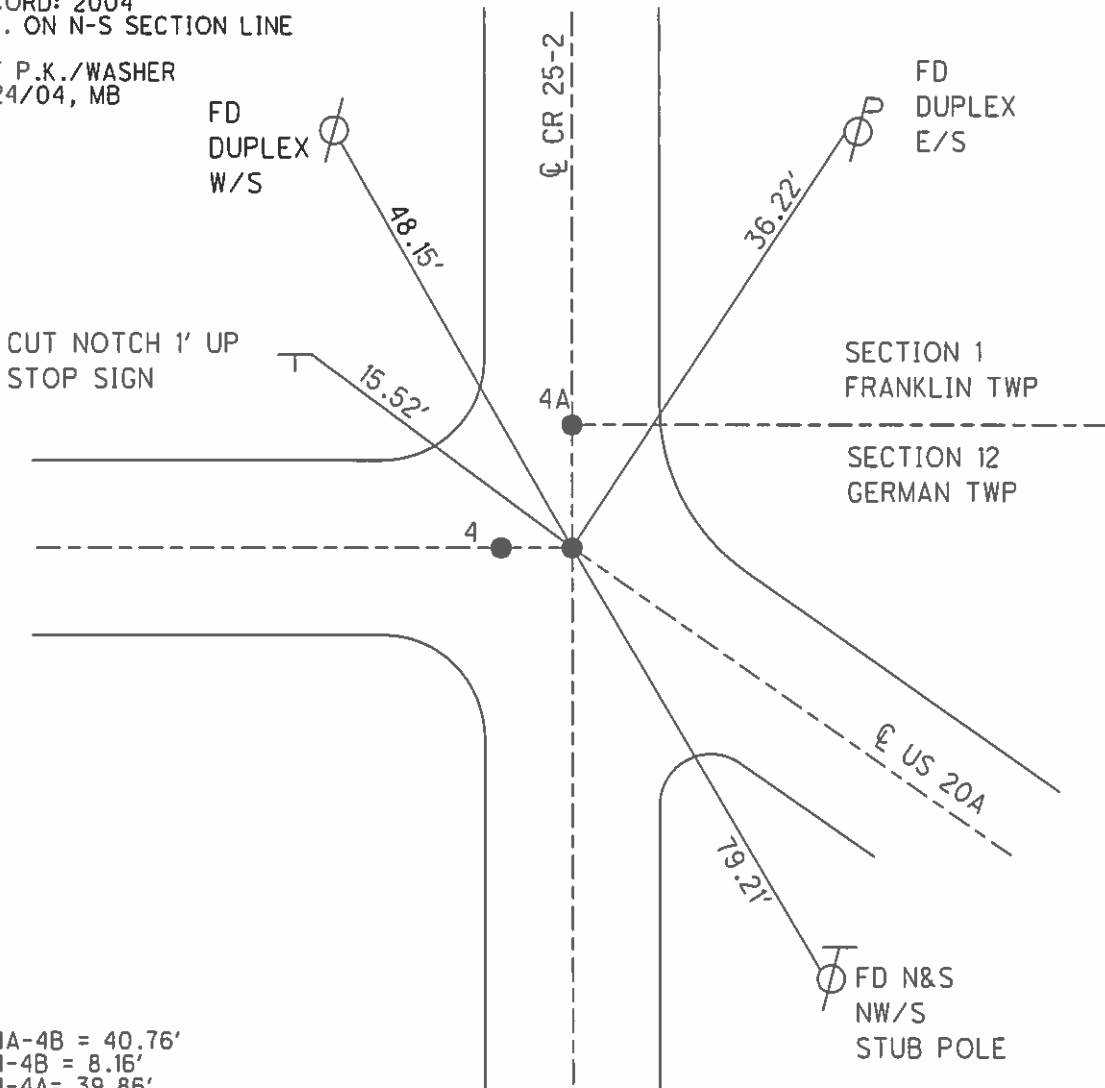

4A-4B = 40.76'
 4-4B = 8.16'
 4-4A = 39.86'