

O.D.O.T. DISTRICT 2 SURVEY OFFICE (USE ONLY)

PERSONNEL

REFERENCE NO. 6 BBB

SHEET 13 OF 63

NOTES NIESE

DATE 2/26/21

ROUTE US 20A

H.C. RHOADES

WEATHER CLOUDY

COUNTY FULTON

R.C. _____

TEMP. 31°

TOWNSHIP GERMAN

DWG BY NIESE

PID PAVETRAIN

SECTION 7

T 7 N R 5 E

TYPE MONUMENT P.K./WASHER

ON SURFACE - ~~BELOW~~ ON

OFFSET ☉ PAVEMENT ON LT : RT

9.0' TO LT EDGE PAVEMENT


STATION: 132+17

HORZ.DATUM: NAD83 2011


GEOID: NAVD88 2012A

GRID: NORTHING: _____

EASTING: _____

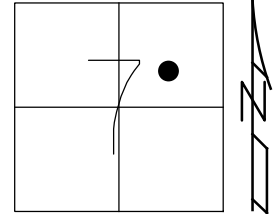

RECORD: P.C.
FD P.K./WASHER
3/3/83, IRS
SET P.K./WASHER
8/9/83, SWH
SET P.K.NAIL
STA. 156+89.37
3/3/85, IRS
D.N.F.
7/12/04, MB
9/24/20, JFO
2/26/21, JMR

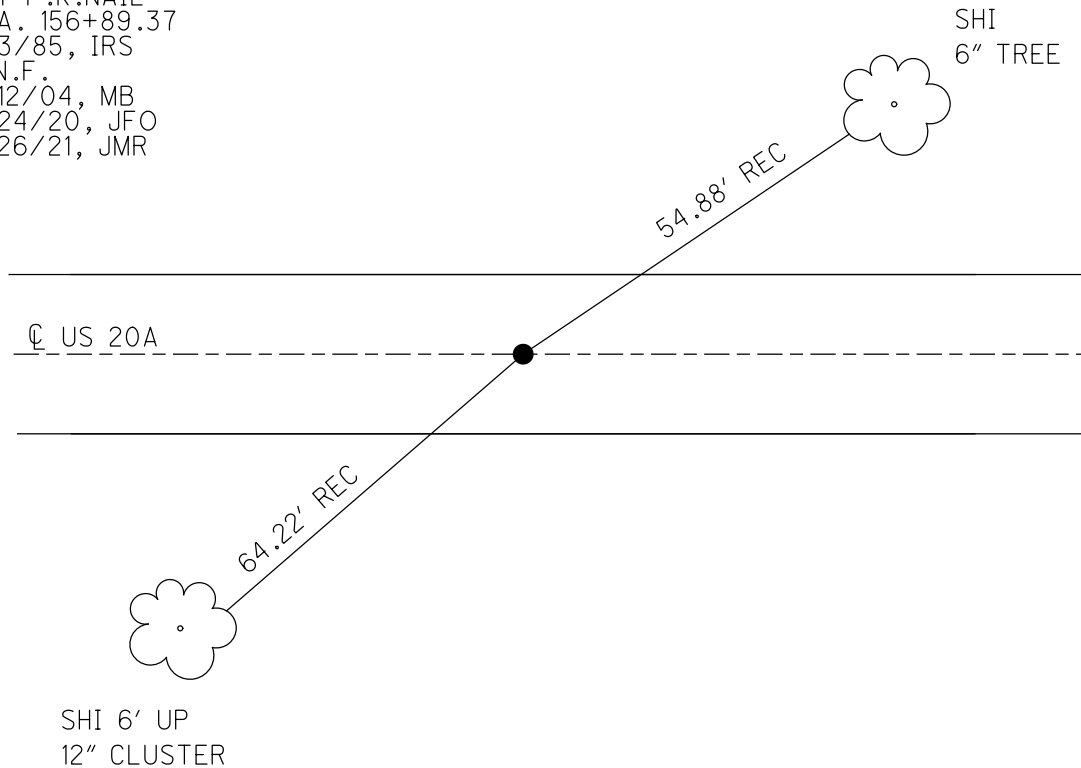

O.D.O.T. DISTRICT 2 SURVEY OFFICE (USE ONLY)

PERSONNEL

REFERENCE NO. 6 BBB

SHEET 13 OF 63

NOTES RHOADES

DATE 9/24/20

ROUTE US 20A

H.C. O'DONNELL

WEATHER SUNNY

COUNTY FULTON

R.C. AUBLE

TEMP. 56°

TOWNSHIP GERMAN

SECTION 7

DWG BY RHOADES

PID PAVETRAIN

T 7 N R 5 E

TYPE MONUMENT P.K./WASHER

ON SURFACE - ~~BELOW~~ ON

OFFSET 0 PAVEMENT ON LT : RT

9.0' TO LT EDGE PAVEMENT


STATION: 132+17

HORZ.DATUM: NAD83 2011

GEOID: NAVD88 2012A


GRID: NORTHING: _____

EASTING: _____

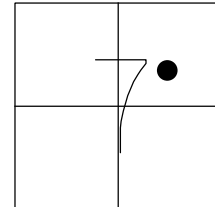

RECORD: P.C.
FD P.K./WASHER
3/3/83, IRS
SET P.K./WASHER
8/9/83, SWH
SET P.K.NAIL
STA. 156+89.37
3/3/85, IRS
D.N.F.
7/12/04, MB
9/24/20, JFO


SHI
6" TREE

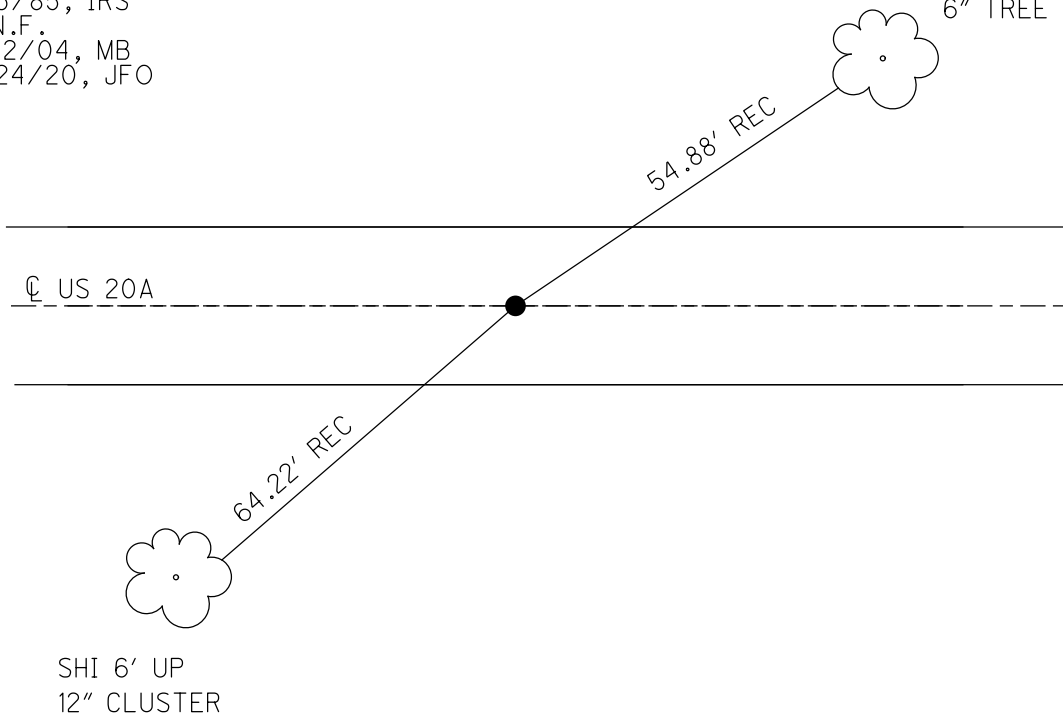

O.D.O.T. DISTRICT 2 SURVEY OFFICE (USE ONLY)

PERSONNEL _____ REFERENCE NO. 6 BBB SHEET 13 OF 61
 NOTES STONE DATE 3/3/83 ROUTE US 20A
 H.C. CURTIS WEATHER FAIR COUNTY FULTON
 R.C. MICHALOK TEMP. 59° TOWNSHIP GERMAN
NEUSER SECTION 7
T 7 N R 5 E

TYPE MONUMENT P.K./WASHER
 ON SURFACE - BELOW ON
 LEFT-☉ PAV'T-RIGHT ON
9.0' TO LT EDGE PAVEMENT
 S.L.M. 132+17

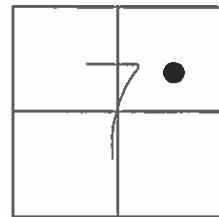


GRID: NORTHING: _____ EASTING: _____

RECORD:
 SET P.K./WASHER
 8-9-83 S.W.H.

SET P.K.NAIL
 P.C. STA. 156+89.37
 3/3/85, I.STONE

DNF, 7/12/04

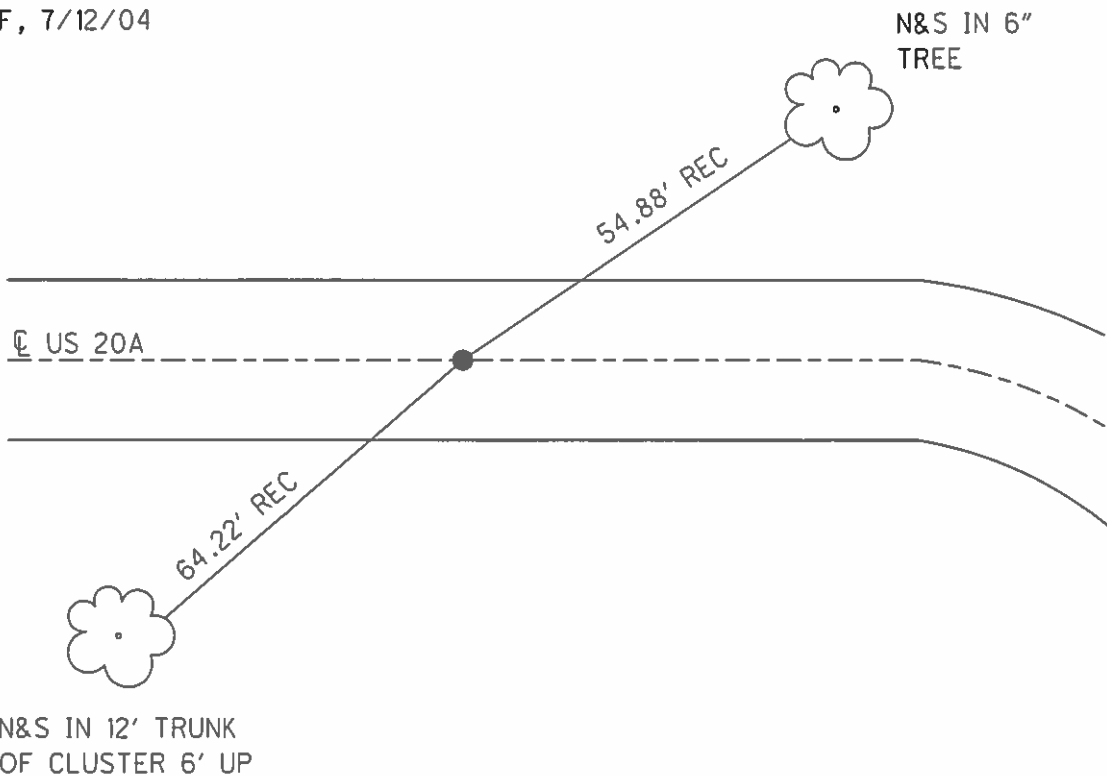

O.D.O.T. DISTRICT 2 SURVEY OFFICE

PERSONNEL

REFERENCE NO. 6-BBB

SHEET 11 OF 15

NOTES I. STONE

DATE 3-3-83

ROUTE U.S. -20A

H.C. D. CURTIS

WEATHER FAIR

COUNTY FULTON

R.C. R. MICHALOK

TEMP. +59°

TOWNSHIP GERMAN

P. NEUSER

SECTION 7

T 7 N R 5 E


TYPE MONUMENT _____

ON SURFACE - BELOW _____

LEFT-Q PAV'T-RIGHT _____

_____ TO _____ EDGE PAVEMENT


S.L.M. 137+17

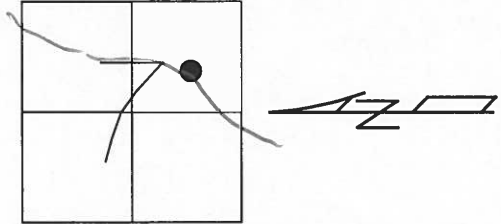

DID NOT FIND
WILL NEED OLD
PLAN INFO/CURVE
7-12-04

Record: 3-3-83
by I. STONE
set PK nail as per
curve data.
P. C. curve sta. 136+89.37
9.0' to N. Edge Point
10.8' to S. Edge Point

SET P.K./WASHER
8-9-83 S.W.H.

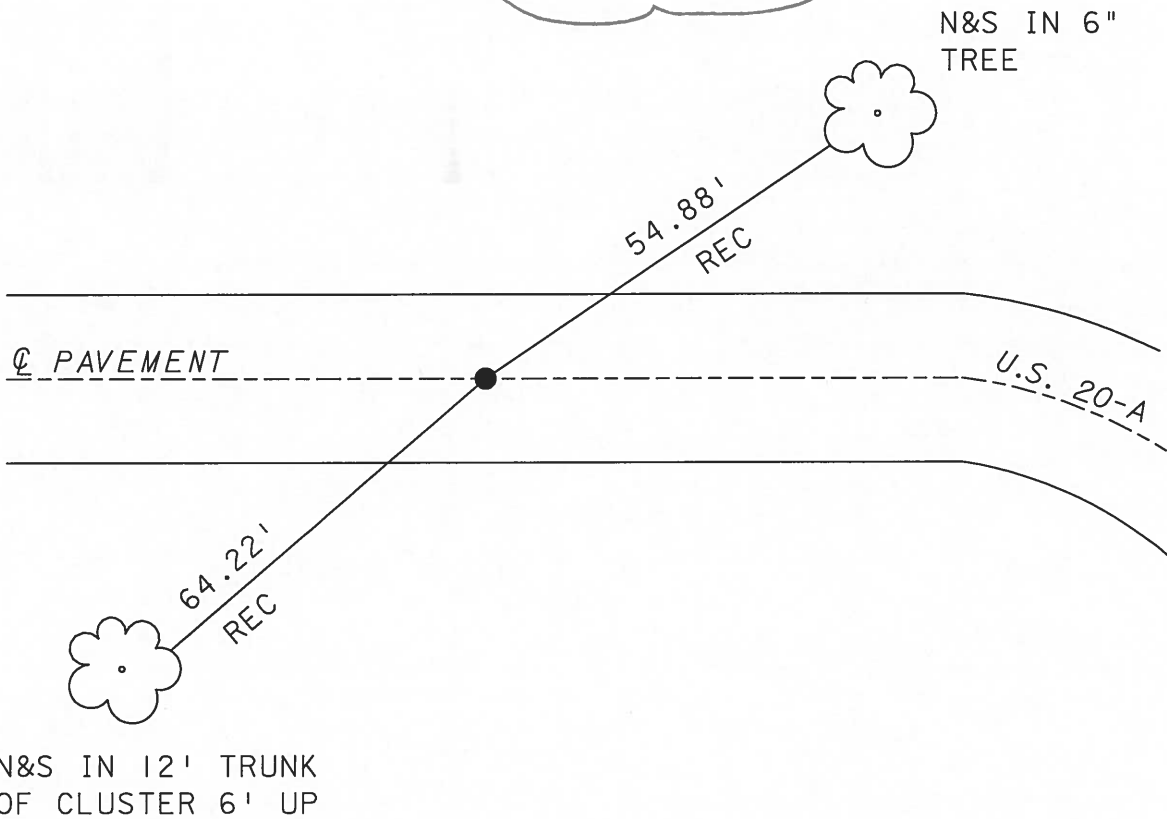

N&S IN 12' TRUNK
OF CLUSTER 6' UP

County Fulton S.R. US#20A

Date 3 March 83

Township German

Weather Fair

Section 7

Temp. 59°


T_N, R_E

Personnel 1. Stone Notes

D. Curtis H.C.

R. Michalak R.C.

P. Neuser

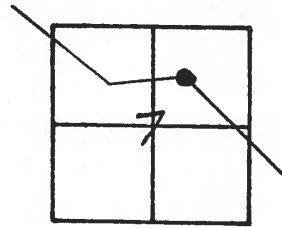

REF. NO. 6-888

