


O.D.O.T. DISTRICT 2 SURVEY OFFICE (USE ONLY)


PERSONNEL _____ REFERENCE NO. 9 A SHEET 20 OF 62
 NOTES LEU DATE 7/12/18 ROUTE US 20A
 H.C. LEU WEATHER SUNNY COUNTY FULTON
 R.C. HAGEMEYER TEMP. 83° TOWNSHIP GERMAN
 DWG BY NASON PID 101232 SECTION 9
 T 7 N R 5 E

TYPE MONUMENT P.K.SHANK
 ON ~~SURFACE~~ - BELOW 3"
 OFFSET Q PAVEMENT 0.4' ~~LT~~ : RT
10.1' TO RT EDGE PAVEMENT
 STATION: 231+22.76

HORZ.DATUM: NAD83(2011) GEOID: 2012A
 GRID: NORTHING: 699384.147 EASTING: 1475452.847

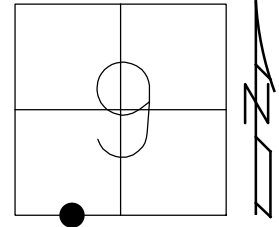


RECORD:
 FD P.K./WASHER
 6/6/02, TMR
 SET MAG/WASHER
 4/22/03, DCH
 FD P.K.SHANK
 3" DOWN
 REFA9
 9/24/14, EBW
 SET MAG/WASHER
 10/15/19, JFO

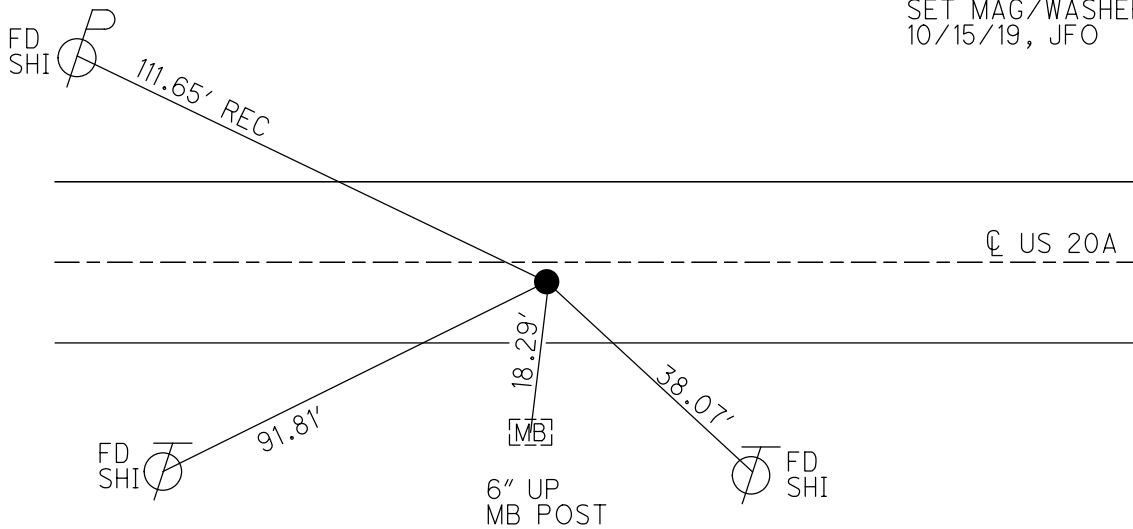

O.D.O.T. DISTRICT 2 SURVEY OFFICE (USE ONLY)


PERSONNEL _____ REFERENCE NO. 9 A SHEET 19 OF 61
 NOTES MICHALAK DATE 6/6/02 ROUTE US 20A
 H.C. ROUSOS WEATHER RAIN COUNTY FULTON
 R.C. MALINSKY TEMP. 65° TOWNSHIP GERMAN
 SECTION 9
 T 7 N R 5 E

TYPE MONUMENT P.K./WASHER
 ON SURFACE - ~~BELOW~~ ON _____
~~LEFT~~ - Q PAV'T - RIGHT 0.4'
10.1' TO RT EDGE PAVEMENT
 S.L.M. 231+25

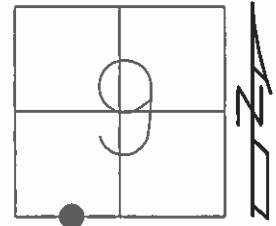

GRID: NORTHING: _____ EASTING: _____

SET MAG/WASHER
 4/22/03, DCH

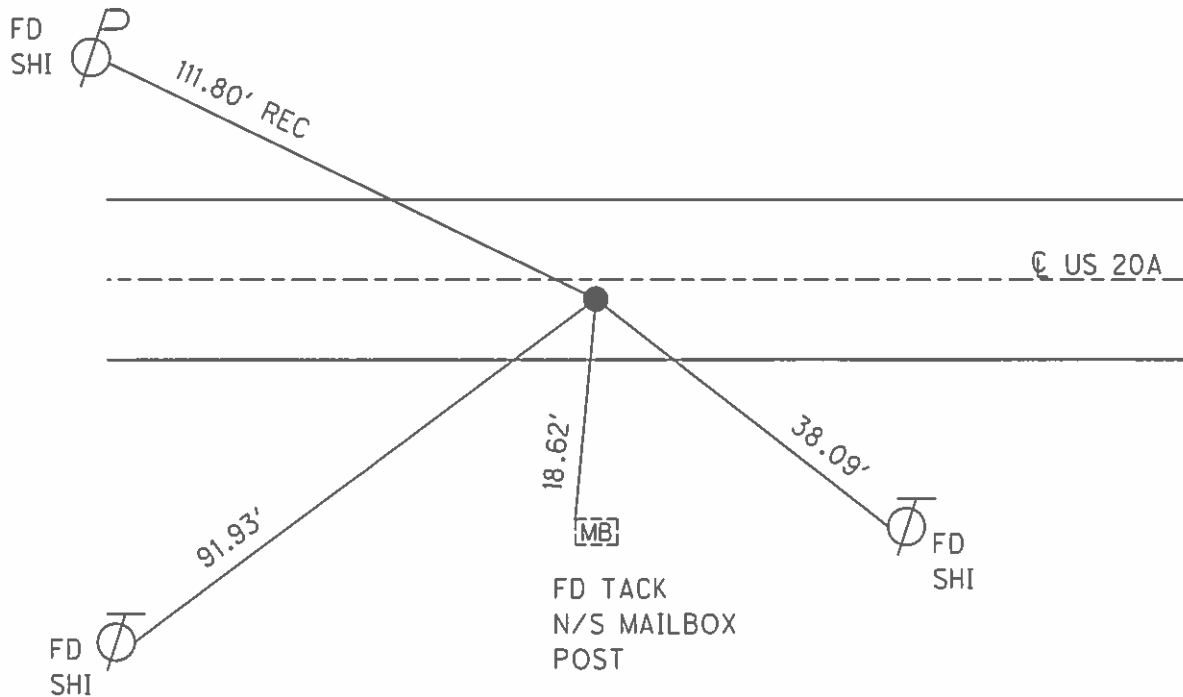

O.D.O.T. DISTRICT 2 SURVEY OFFICE

PERSONNEL

REFERENCE NO. 9-A

SHEET 2 OF 30

NOTES MICHALAK

DATE 6-6-02

ROUTE U.S. 20-A

H.C. ROUSOS

WEATHER RAIN

COUNTY FULTON

R.C. MALINSKY

TEMP. 65°

TOWNSHIP GERMAN

SECTION 9

T 7 N R 5 E


TYPE MONUMENT PK NAIL & WASHER

ON SURFACE - ~~BELOW~~ YES

~~LEFT~~ - Q PAV'T - RIGHT 0.4'






10.1 TO RT EDGE PAVEMENT

S.L.M. 231+25

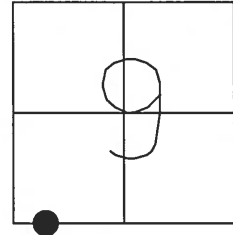

SET MAG NAIL
& WASHER
4-22-03
DCH

FD
N&S
SE/S

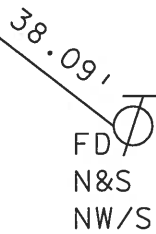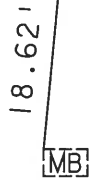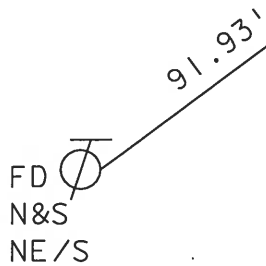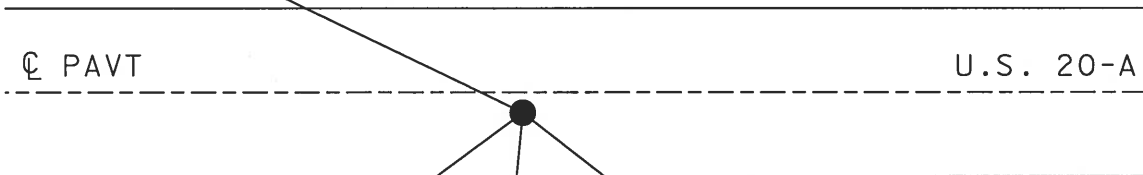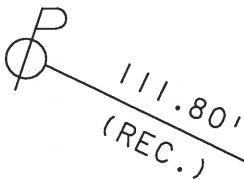

O.D.O.T. DISTRICT 2 SURVEY OFFICE

PERSONNEL _____

REFERENCE NO. 9-A

SHEET 2 OF 26

NOTES HOFFMAN

H.C. LOSHKIE

R.C. _____

DATE 8-8-89

WEATHER CLEAR

TEMP. 80°

ROUTE US 20-A

COUNTY FULTON

TOWNSHIP GERMAN

SECTION 9

T7 NR S E

TYPE MONUMENT P.K. NAIL



*Set PK/WASHER
8-28-89 SWA*

ON SURFACE - ~~BELOW~~ YES

~~LEFT & PAV'T.~~ - RIGHT 0.4

10.1 TO RT. EDGE PAVEMENT

S.L.M. 231 + 07

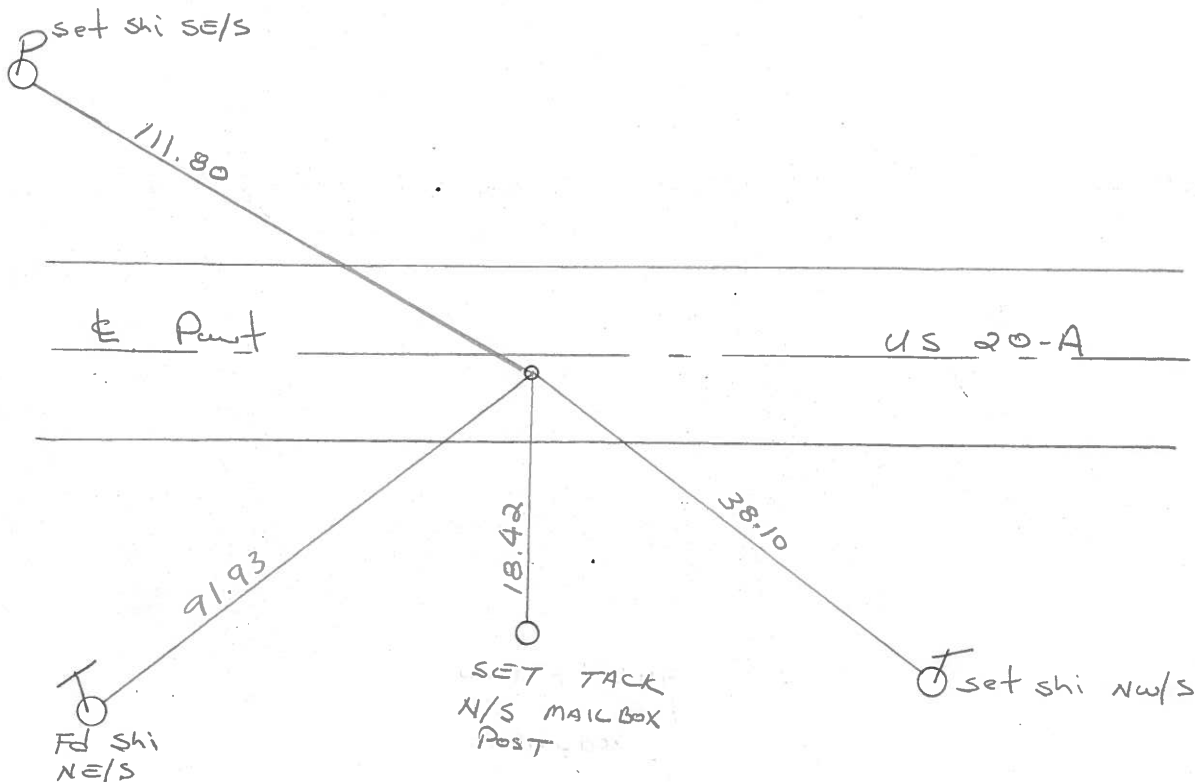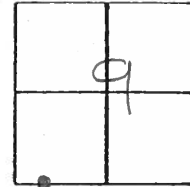

County Fulton US 20-A

Date 27 June 79

Township German


Weather Warm

Section 9

Temp. 79°


T N, R E

Personnel I. Stone
R. Michalak
P. Neuse
D. Curtis
D. Granda

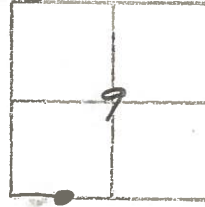

REF. NO. 9A

SLM BLKTOP STA. 231 + 07

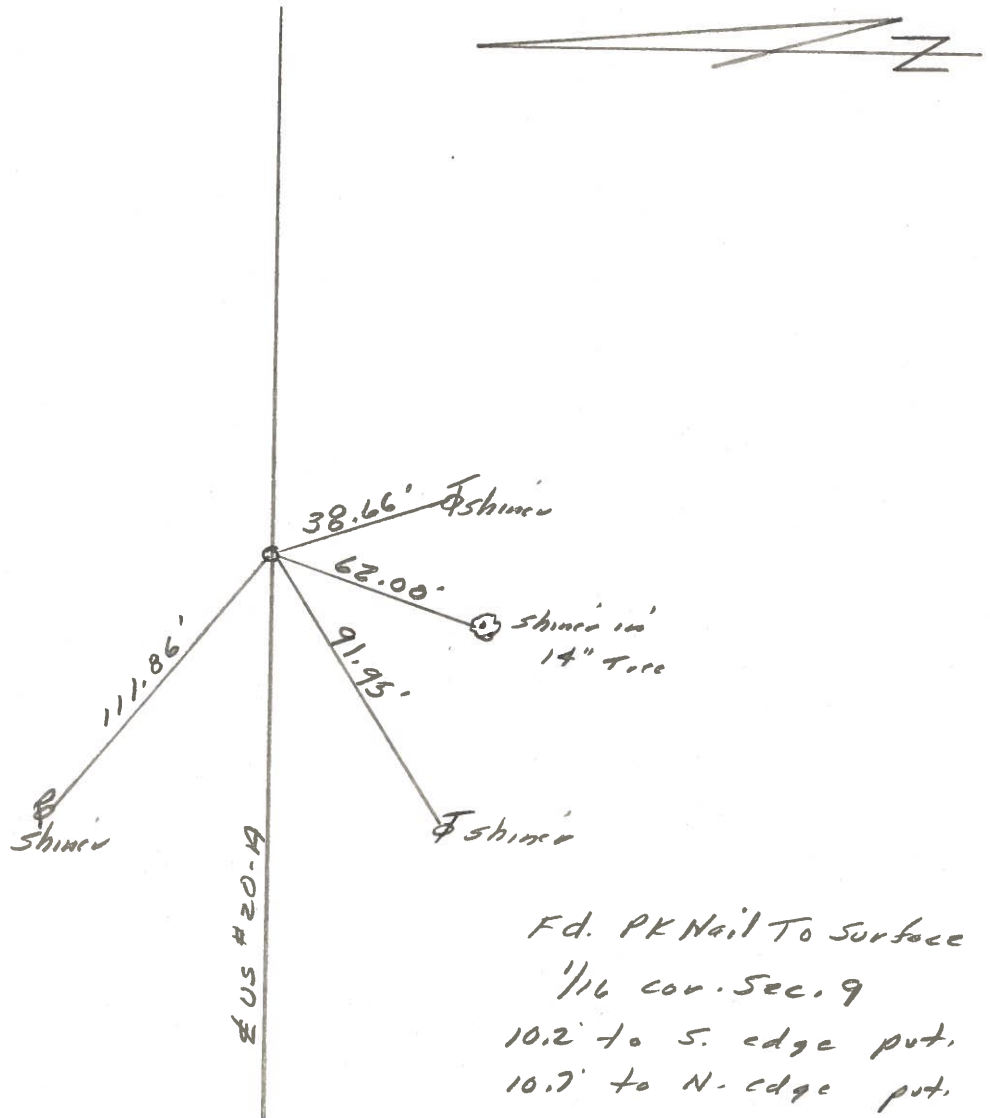

PERSONNEL	TITLE	PERSONNEL	TITLE	COUNTY	DATE	WEATHER	TEMP.	JOB NO.
Tompic				Fulton	FEB 12, 1973			
Neasur				S. R. G.S. 20A				
Vanyo				SEC. Burlington to Delta				
Granata				German TWP.				

