

O.D.O.T. DISTRICT 2 SURVEY OFFICE (USE ONLY)

PERSONNEL

REFERENCE NO. 10

SHEET 21 OF 62

NOTES LEU

DATE 7/12/18

ROUTE US 20A

H.C. LEU

WEATHER SUNNY

COUNTY FULTON

R.C. HAGEMeyer

TEMP. 83°

TOWNSHIP GERMAN

SECTION 9

DWG BY NASON PID 101232

T 7 N R 5 E

TYPE MONUMENT P.K.NAIL

~~ON SURFACE~~ - BELOW 1"

OFFSET Q PAVEMENT 1.1' ~~±~~ : RT

9.9' TO RT EDGE PAVEMENT


STATION: 244+40.76

HORZ.DATUM: NAD83(2011)


GEOID: 2012A

GRID: NORTHING: 699360.948

EASTING: 1476770.643

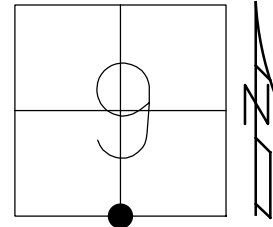



RECORD:
 FD P.K./WASHER
 6/6/02, TMR
 SET MAG/WASHER
 4/22/03, DCH
 FD MAG/WASHER
 REF10
 9/24/14, EBW
 SET MAG/WASHER
 10/15/19, JFO

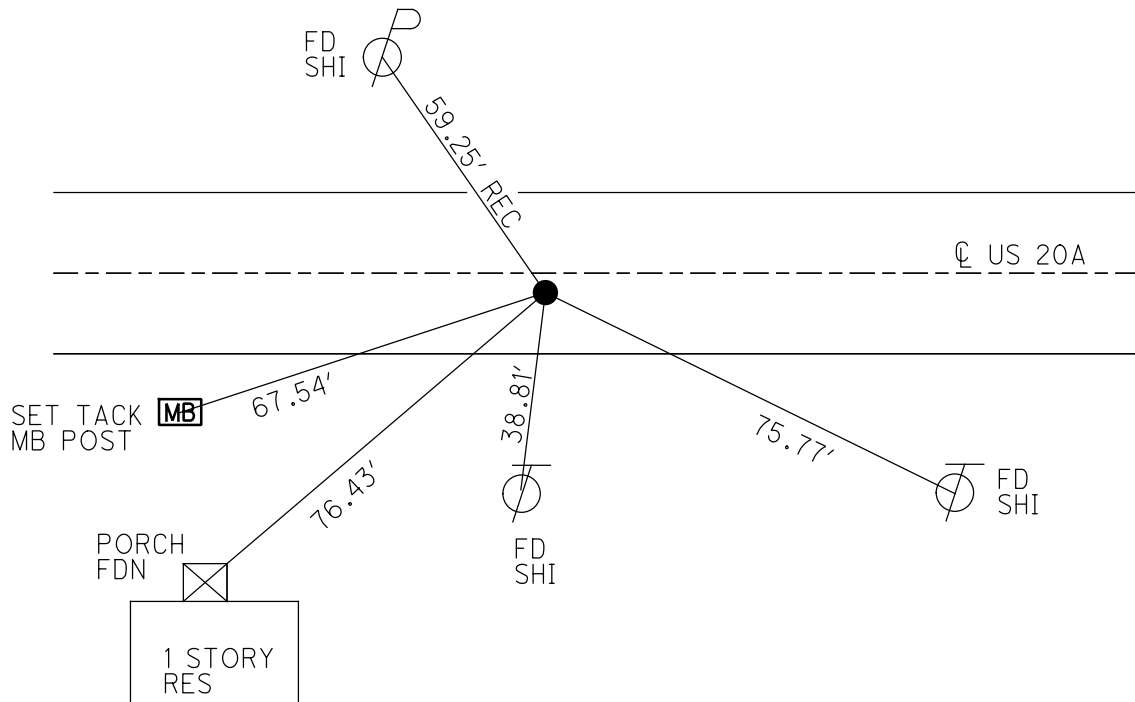

O.D.O.T. DISTRICT 2 SURVEY OFFICE (USE ONLY)

PERSONNEL _____ REFERENCE NO. 10 SHEET 20 OF 61
 NOTES MICHALAK DATE 6/6/02 ROUTE US 20A
 H.C. ROUSOS WEATHER RAIN COUNTY FULTON
 R.C. MALINSKY TEMP. 70° TOWNSHIP GERMAN
 SECTION 9
 T 7 N R 5 E

TYPE MONUMENT P.K./WASHER
 ON SURFACE - ~~BELOW~~ ON _____
~~LEFT~~ - ☉ PAV'T - RIGHT 0.4'
9.9' TO RT EDGE PAVEMENT
 S.L.M. 244+43
 GRID: NORTHING: _____ EASTING: _____

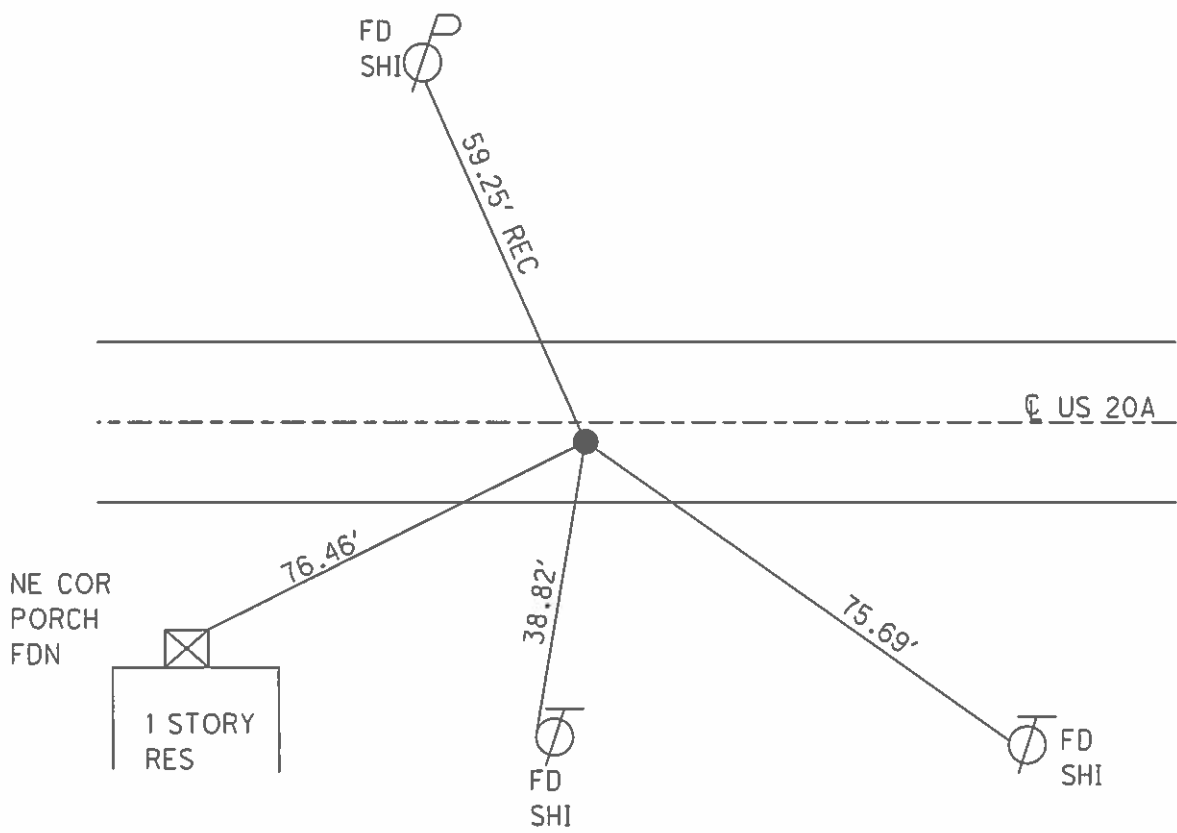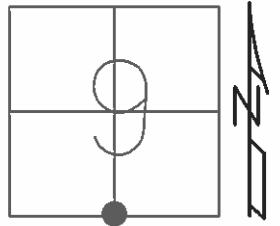

O.D.O.T. DISTRICT 2 SURVEY OFFICE

PERSONNEL

REFERENCE NO. 10

SHEET 3 OF 30

NOTES MICHALAK

DATE 6-6-02

ROUTE U.S. 20-A

H.C. ROUSOS

WEATHER RAIN

COUNTY FULTON

R.C. MALINSKY

TEMP. 70°

TOWNSHIP GERMAN

SECTION 9

T 7 N R 5 E


TYPE MONUMENT PK NAIL & WASHER

ON SURFACE - ~~BELOW~~ YES


~~LEFT~~ - Q PAV'T - RIGHT 0.4'

9.9 TO RT EDGE PAVEMENT

S.L.M. 244+43

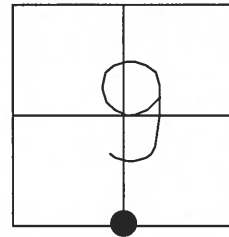

SET MAG NAIL
& WASHER
4-22-03
DCH

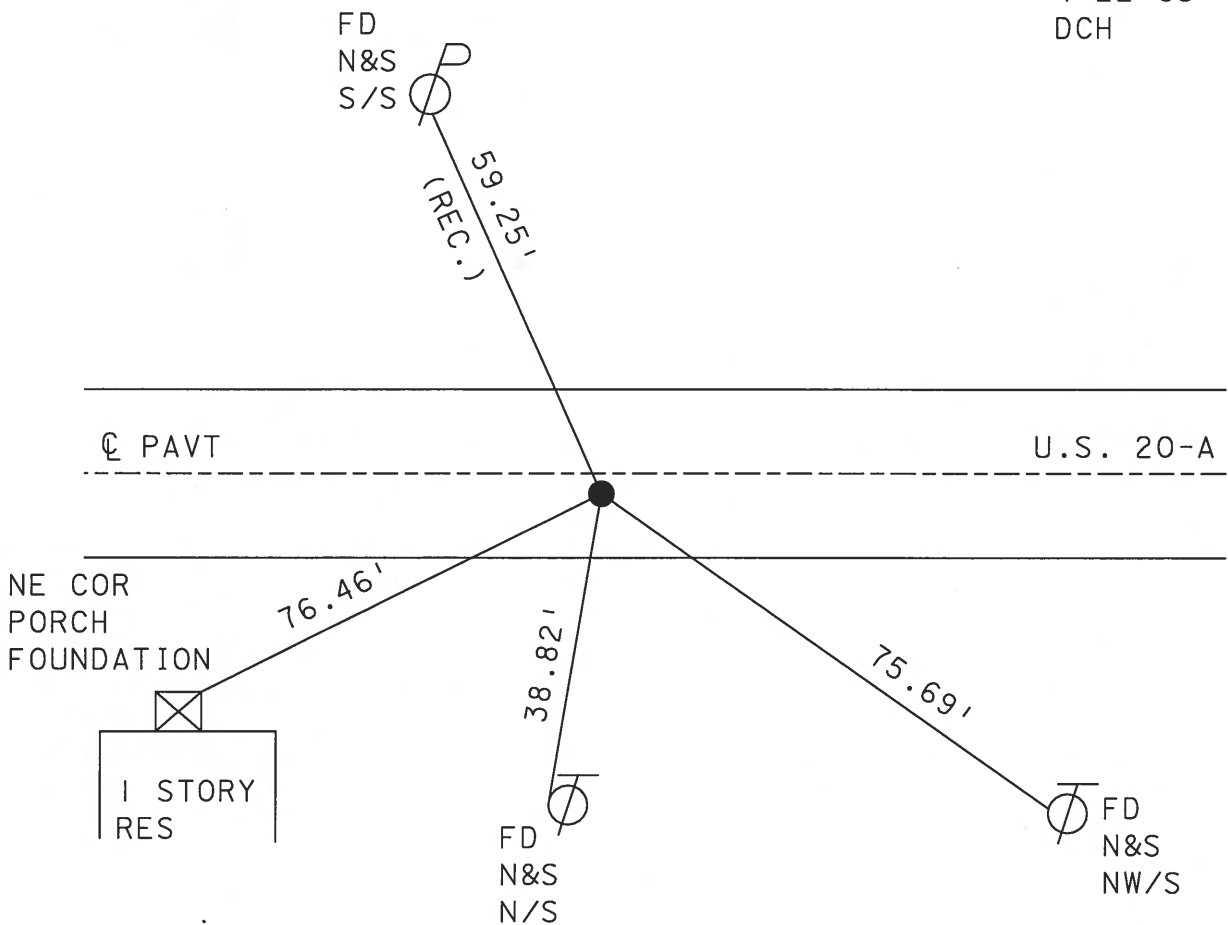

O.D.O.T. DISTRICT 2 SURVEY OFFICE

PERSONNEL _____

REFERENCE NO. 10

SHEET 3 OF 24

NOTES HOFFMAN

H.C. LOENRKE

R.C. _____

DATE 8-8-89

WEATHER CLEAR

TEMP. 80°

ROUTE US 20-A

COUNTY FULTON

TOWNSHIP GERMAN

SECTION 9

T 7 N R 5 E

TYPE MONUMENT P.K. NAIL



ON SURFACE - ~~BELOW~~ YES

~~LEFT-C~~ PAV'T. - RIGHT 0.4

9.9 TO RT. EDGE PAVEMENT

S.L.M. 244 + 25

*Set P.K./WASHER
8-28-89 SWA*

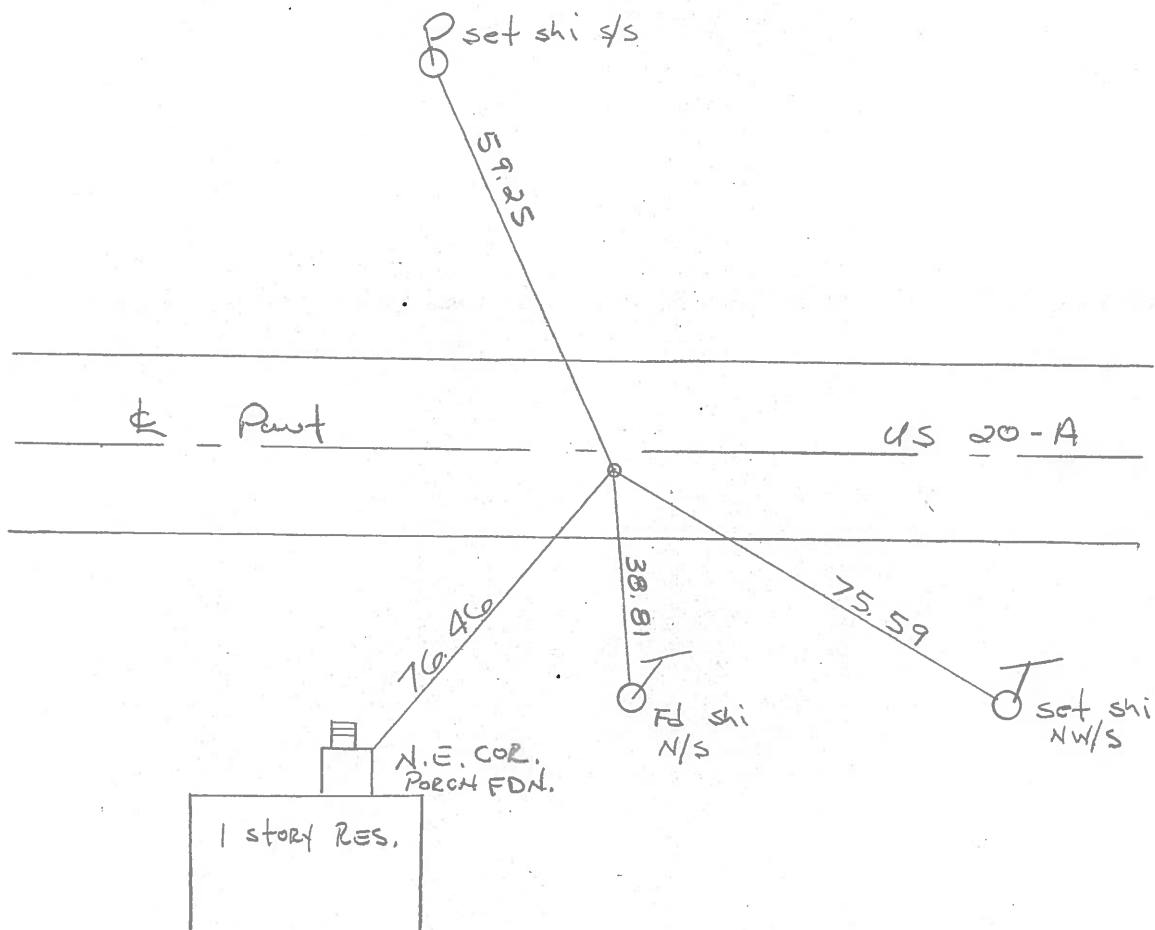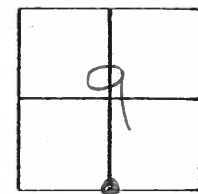

OD.OT. DISTRICT 2 SURVEY OFFICE

Sht. 3 of

County Fulton US-20-A

Date 27 June 79

Township German

Weather Woods

Section 9

Temp. 79°

T N, R E


Personnel

- 1. Stone
- R. Michalak
- P. Newaco,
- D. Curtis
- D. Grandy



REF. NO. 10

SLM BLKTOP STA. 244+25

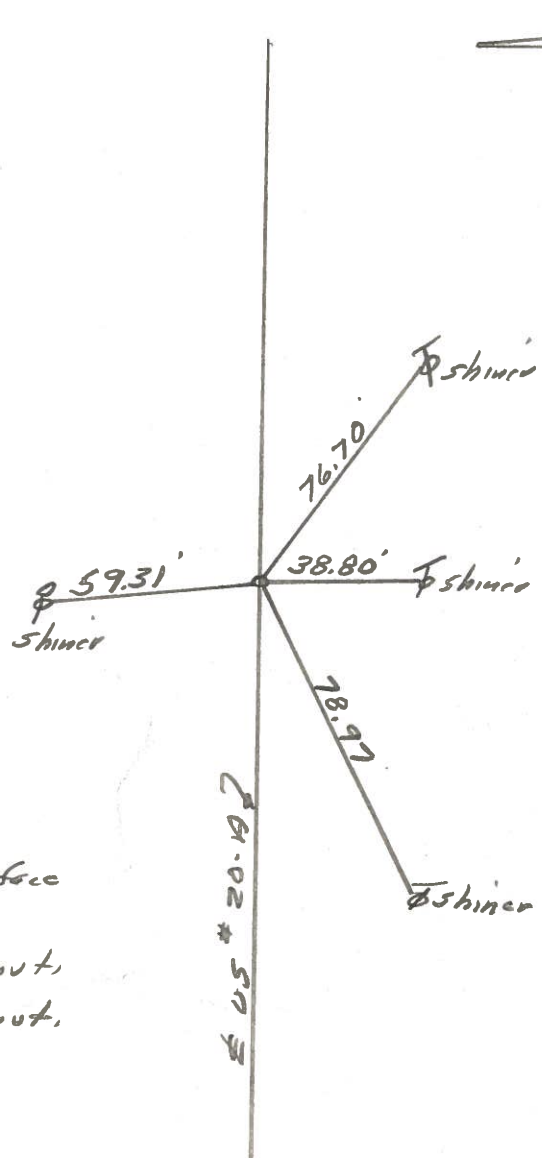

Fd. MoBo Ra To Surface
 5 1/4' Cor. Sec. 9
 11.4' to N. edge put,
 9.9' to S. edge put.

PERSONNEL	TITLE	PERSONNEL	TITLE	COUNTY	DATE	WEATHER
Tomsic				Fulton	FEB 12, 1973	
Neasur				S. R. G.S. 20A		
Nanyo						
Granata				SEC. Burlington to Delta German TWP.		

