


O.D.O.T. DISTRICT 2 SURVEY OFFICE (USE ONLY)


PERSONNEL	REFERENCE NO.	<u>16</u>	SHEET	<u>29</u>	OF	<u>61</u>
NOTES	DATE	<u>6/6/02</u>	ROUTE	<u>US 20A</u>		
H.C.	WEATHER	<u>RAIN</u>	COUNTY	<u>FULTON</u>		
R.C.	TEMP.	<u>65°</u>	TOWNSHIP	<u>GERMAN</u>		
			SECTION	<u>12</u>		
			<u>T 7 N R 5 E</u>			

TYPE MONUMENT P.K./WASHER
 ON SURFACE - ~~BELOW~~ ON
 LEFT - ☉ PAV'T - ~~RIGHT~~ 0.6'
9.8' TOLT EDGE PAVEMENT
 S.L.M. 402+73
 GRID: NORTHING: _____ EASTING: _____

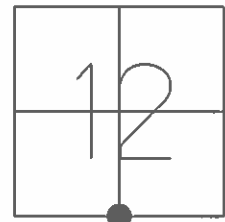

RECORD: OLD STA. 402+80.49

SET MAG/WASHER
 4/22/03, DCH

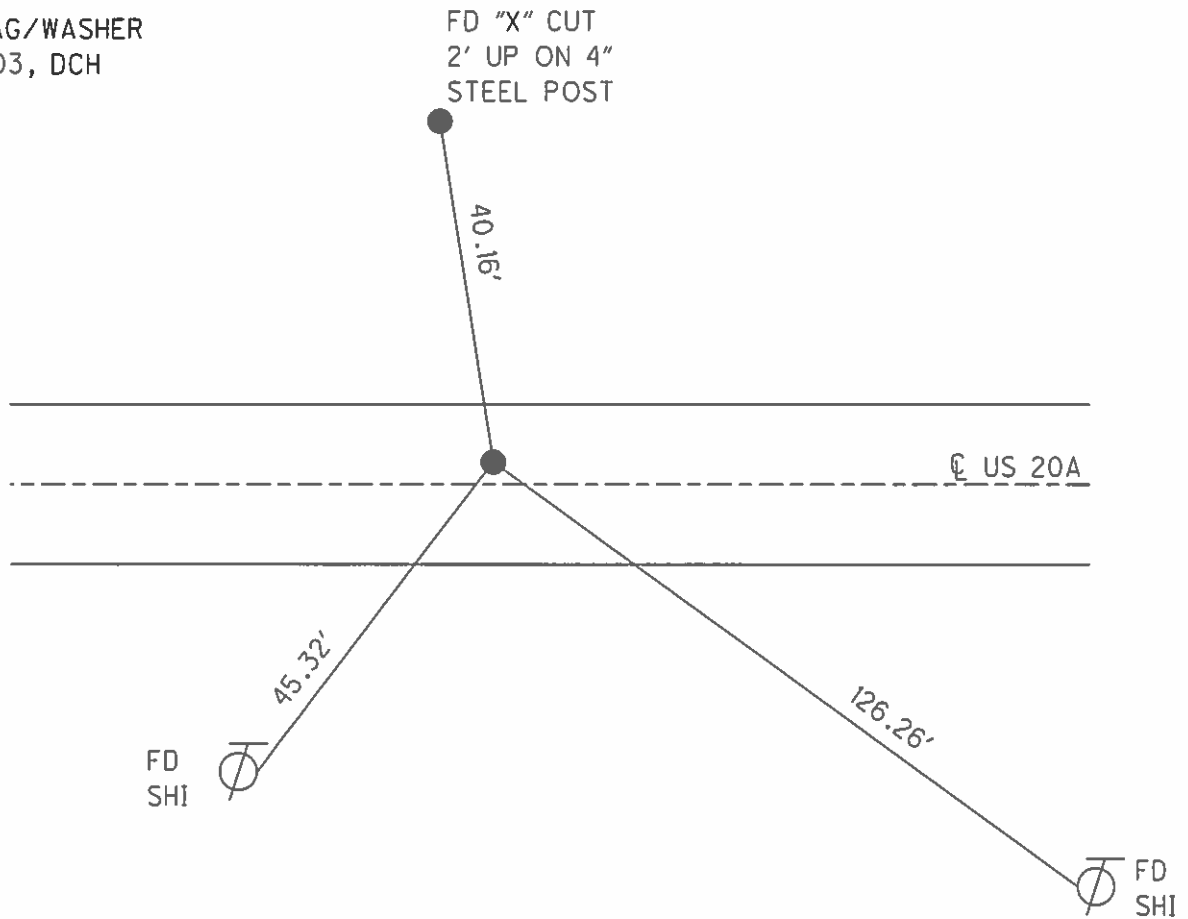

O.D.O.T. DISTRICT 2 SURVEY OFFICE

PERSONNEL

REFERENCE NO. 16

SHEET 12 OF 30

NOTES MICHALAK

DATE 6-6-02

ROUTE U.S. 20-A

H.C. HOMAN

WEATHER RAIN

COUNTY FULTON

R.C. MALINSKY

TEMP. 65°

TOWNSHIP GERMAN

SECTION 12

T 7 N R 5 E


TYPE MONUMENT PK NAIL & WASHER

ON SURFACE - ~~BELOW~~ YES

LEFT - Q PAV'T - ~~RIGHT~~ .6'


9.8' TO LT. EDGE PAVEMENT

S.L.M. 402+73

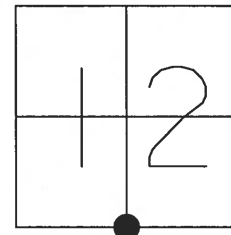

RECORD: OLD STA. 402+80.49

SET MAG NAIL
& WASHER
4-22-03
DCH

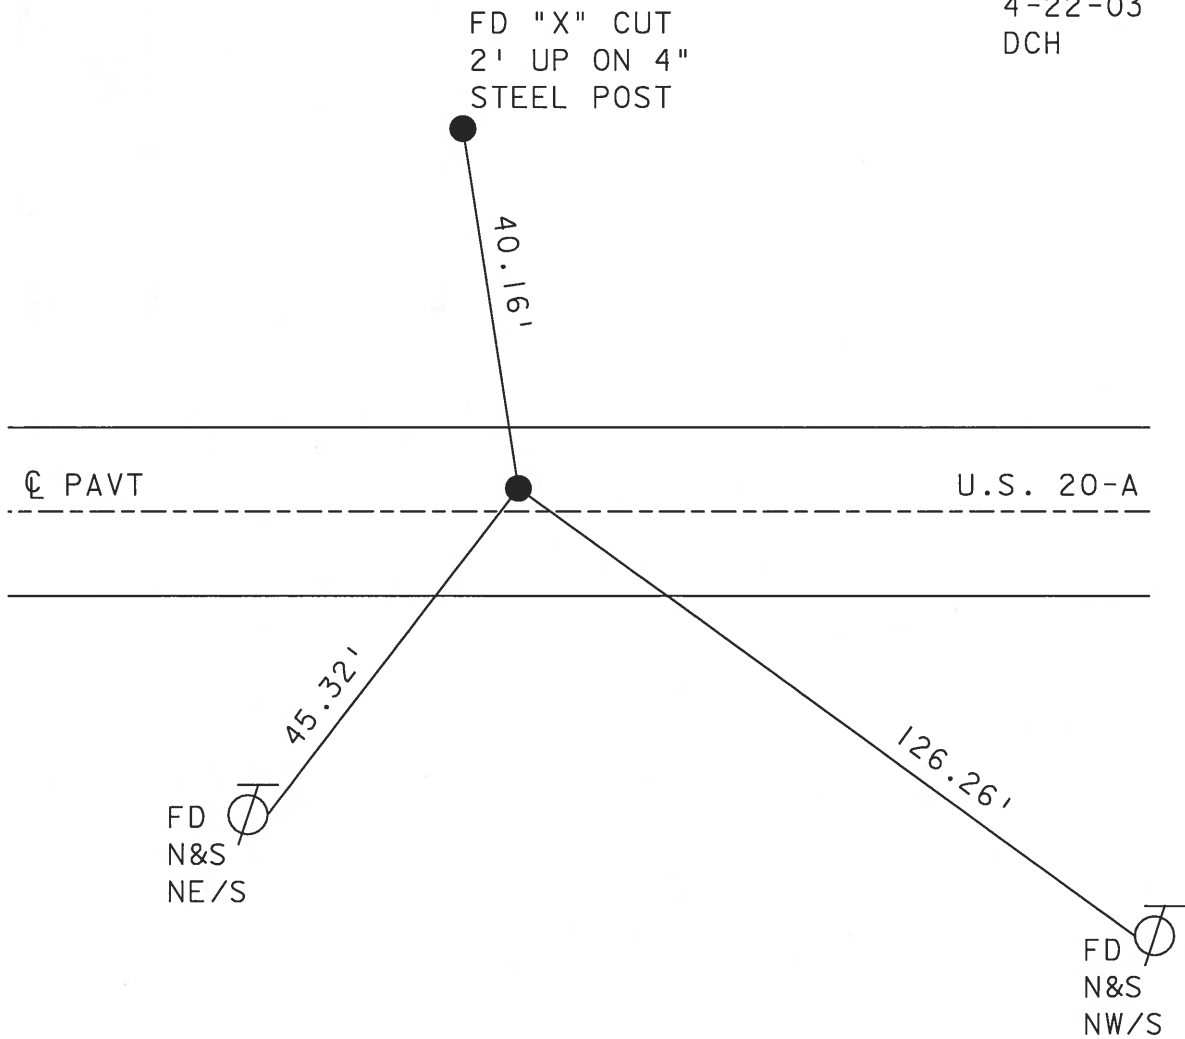

O.D.O.T. DISTRICT 2 SURVEY OFFICE

PERSONNEL _____

REFERENCE NO. 16

SHEET 12 OF 26

NOTES HOFFMAN

H.C. LOEHRKE

R.C. _____

DATE 8-9-89

WEATHER CLEAR

TEMP. 80°

ROUTE US 20-A

COUNTY FULTON

TOWNSHIP GERMAN

SECTION 12

T 7 N R 5 E

TYPE MONUMENT P.K. Nail



ON SURFACE - ~~BELOW~~ YES

LEFT-~~C~~ PAV'T. - ~~RIGHT~~ 0.6

9.8 TO LT EDGE PAVEMENT

S.L.M. 402 + 55

*Set P.K./WASHER
9-15-89 SWK*

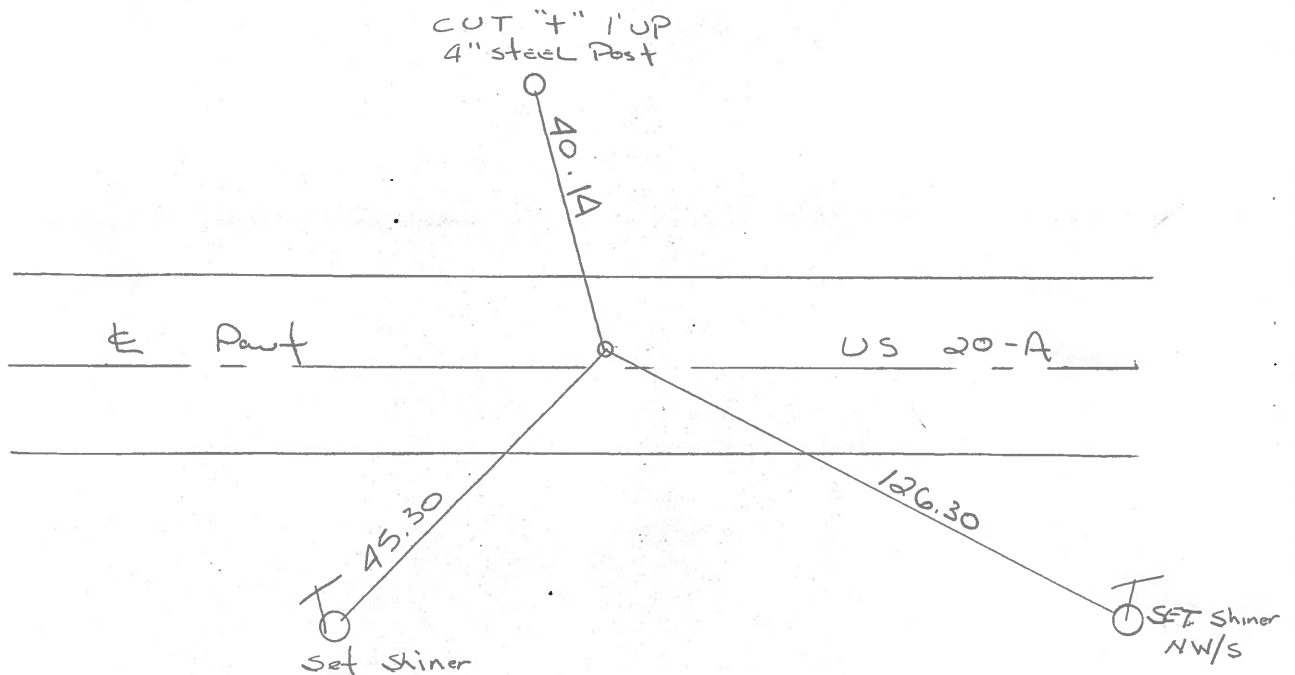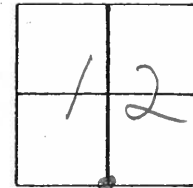

RECORDS: OLD Sta. 402 + 80.49

Q.D.O.T. DISTRICT 2 SURVEY OFFICE

Sht. 12 of

County Fulton S.R. 05-2014

Township German

Section 12


T N, R E

Personnel L. Stone
R. Michalak
P. Houser
D. Curtis
D. Granata

Date 27 June 79


Weather Warm

Temp. 81°

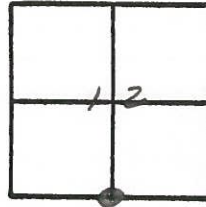


REF NO. 16

SLM BLKTOP STA. 402+65

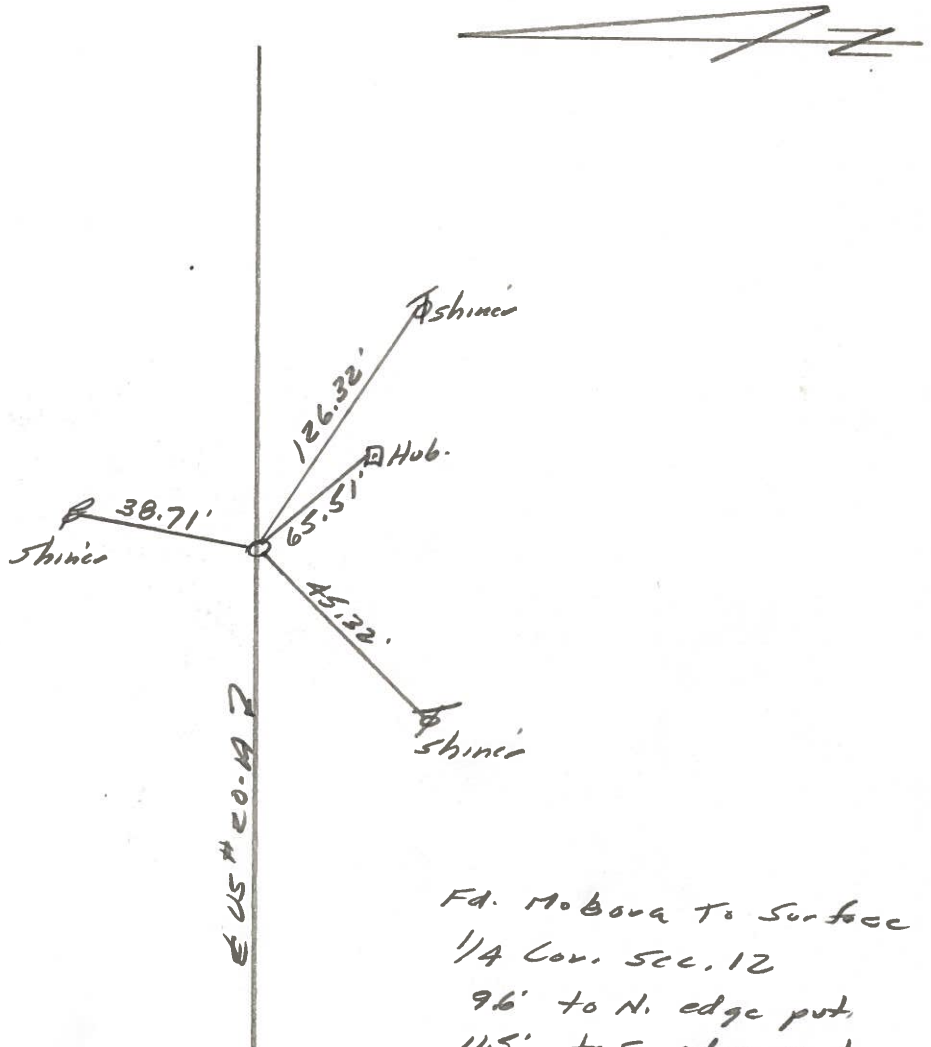

Fd. Mo Bova To Surface
1/4 Cor. Sec. 12
96' to N. edge put.
11.5' to S. edge put.
Old Sta. 402+80.49

PERSONNEL	TITLE	PERSONNEL	TITLE	COUNTY	<u>Fulton</u>	DATE	<u>MAR. 15, 1973</u>
<u>Tomsic</u>				S. R.	<u>U.S. 20A</u>	WEATHER	
<u>Neuser</u>				SEC.	<u>German</u>	TEMP.	
<u>Vanko</u>							
<u>Branata</u>							

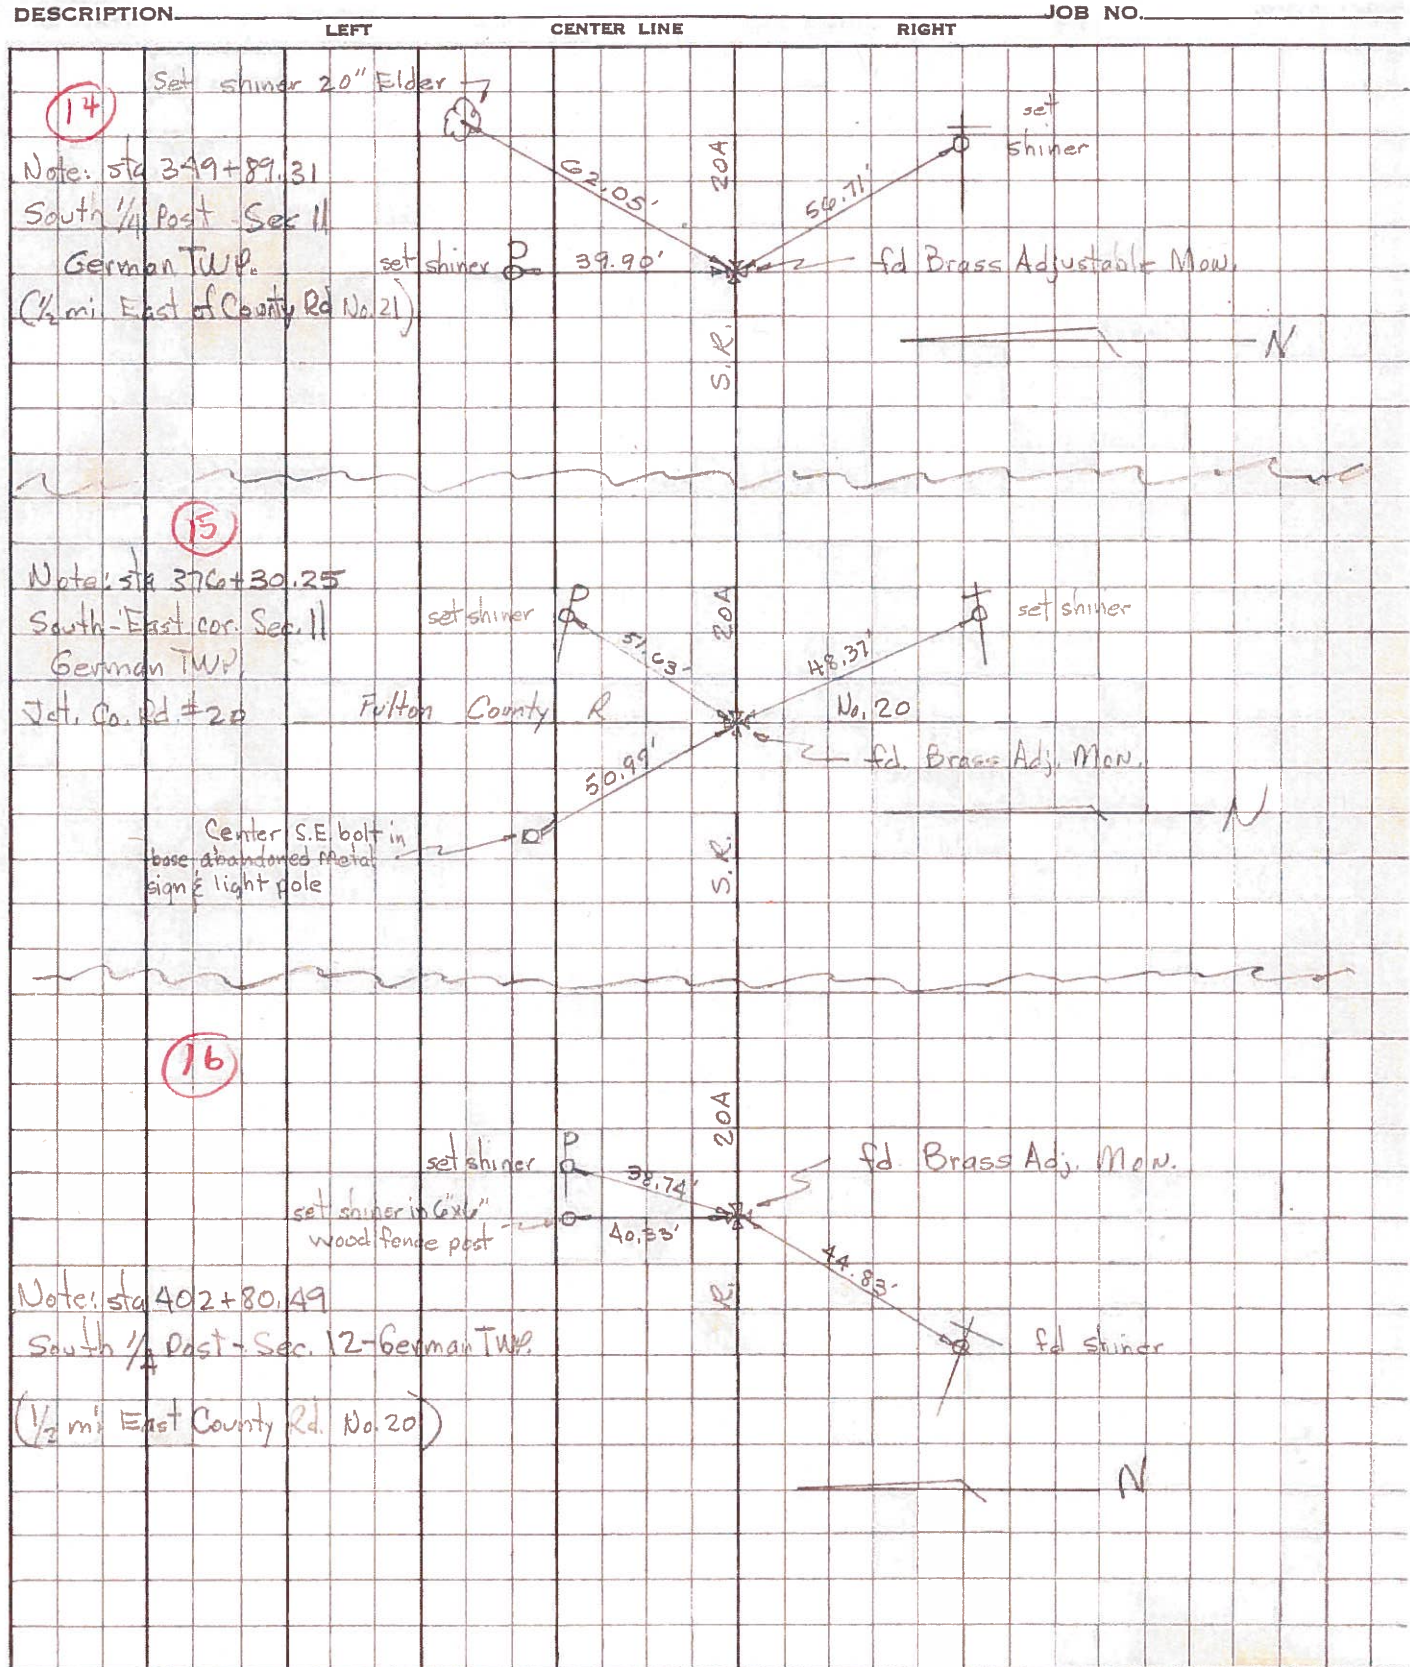

PERSONNEL	TITLE	PERSONNEL	TITLE
Beach			
Armbruster			
Knappe			

COUNTY Fulton DATE 11 July 58

S. R. US 20 A. WEATHER _____

SEC. 4.13 TEMP. _____

DESCRIPTION _____ LEFT _____ CENTER LINE _____ RIGHT _____ JOB NO. 02276

