

PERSONNEL TITLE PERSONNEL TITLE

COUNTY Fulton DATE 1-27-58


S. R. #20-1A1. WEATHER

SEC. TEMP.

DESCRIPTION LEFT CENTER LINE RIGHT JOB NO.

1 1/4" Gas pipe on E of
Sec. 1/4 cor.
(8 1/2 mi.)
Sta. 445+30.83
N 1/4 Sec. #14.

#129

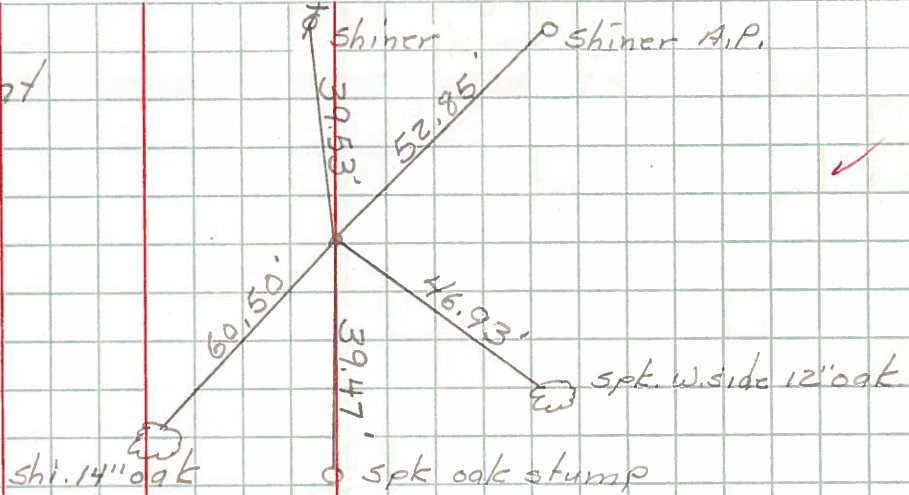

Stone - Mon.
Sec. Cor.
Sta. 471+71.96
(9 mi.)
NE. Cor Sec. #14

#130

