


O.D.O.T. DISTRICT 2 SURVEY OFFICE (USE ONLY)


PERSONNEL _____ REFERENCE NO. 39 C SHEET 3 OF 14
 NOTES NIESE DATE 4-23-21 ROUTE US 20 A
 H.C. AUBLE WEATHER CLOUDY COUNTY FULTON
 R.C. NIESE TEMP. 50° TOWNSHIP YORK
 DWG BY AUBLE PID 101295 SECTION 13
 T 7 N R 7 E

TYPE MONUMENT MAG SHANK
~~ON SURFACE~~ - BELOW 1"
 OFFSET \odot PAVEMENT 1.0' LT : ~~RT~~
 - TO - EDGE PAVEMENT
 STATION: 1032+49

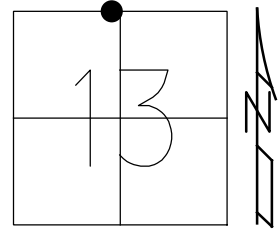

HORIZ. DATUM: NAD83(2011) GEOID: 12A
 GRID: NORTHING: 698395.671 EASTING: 155517.712

RECORD:
 SET MAG/WASHER
 12/29/03, RGN
 FD MAG SHANK
 REFC39
 1/9/20, JLL
 SET MAG/WASHER
 10-6-21, DSA

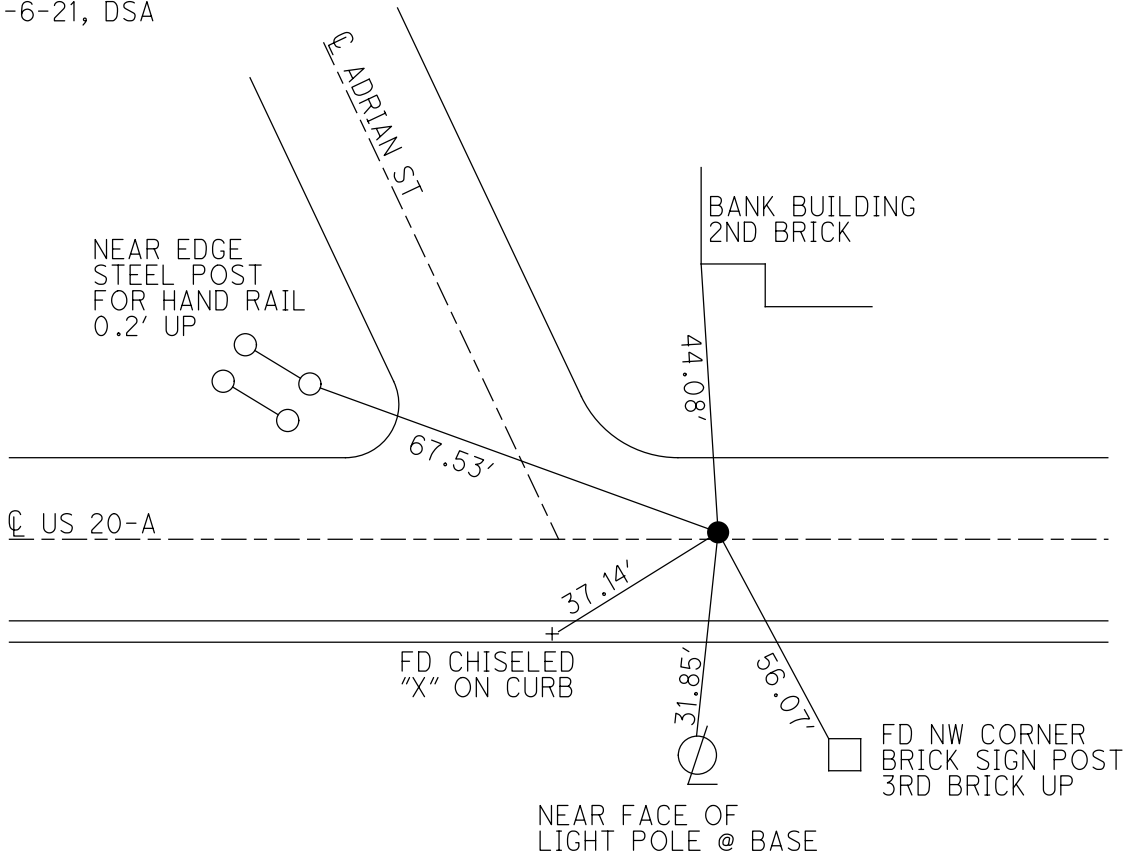

O.D.O.T. DISTRICT 2 SURVEY OFFICE (USE ONLY)

PERSONNEL _____

REFERENCE NO. 39 C

SHEET 3 OF 14

NOTES CANTERBURY

DATE 8/14/03

ROUTE US 20 A

H.C. NUHFER

WEATHER SUNNY

COUNTY FULTON

R.C. ZEBROWSKI

TEMP. 80°

TOWNSHIP YORK

SECTION 13

DWG BY NIESE

PID _____

T 7 N R 7 E

TYPE MONUMENT P.K. SHANK

ON SURFACE - ~~BELOW~~ ON

OFFSET CL PAVEMENT 1.0' LT : ~~RT~~

- TO - EDGE PAVEMENT


STATION: 1032+49

HORZ. DATUM: -


GEOID: -

GRID: NORTHING: -

EASTING: -

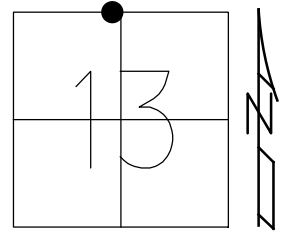

RECORD:
SET MAG/WASHER
12/29/03, RGN

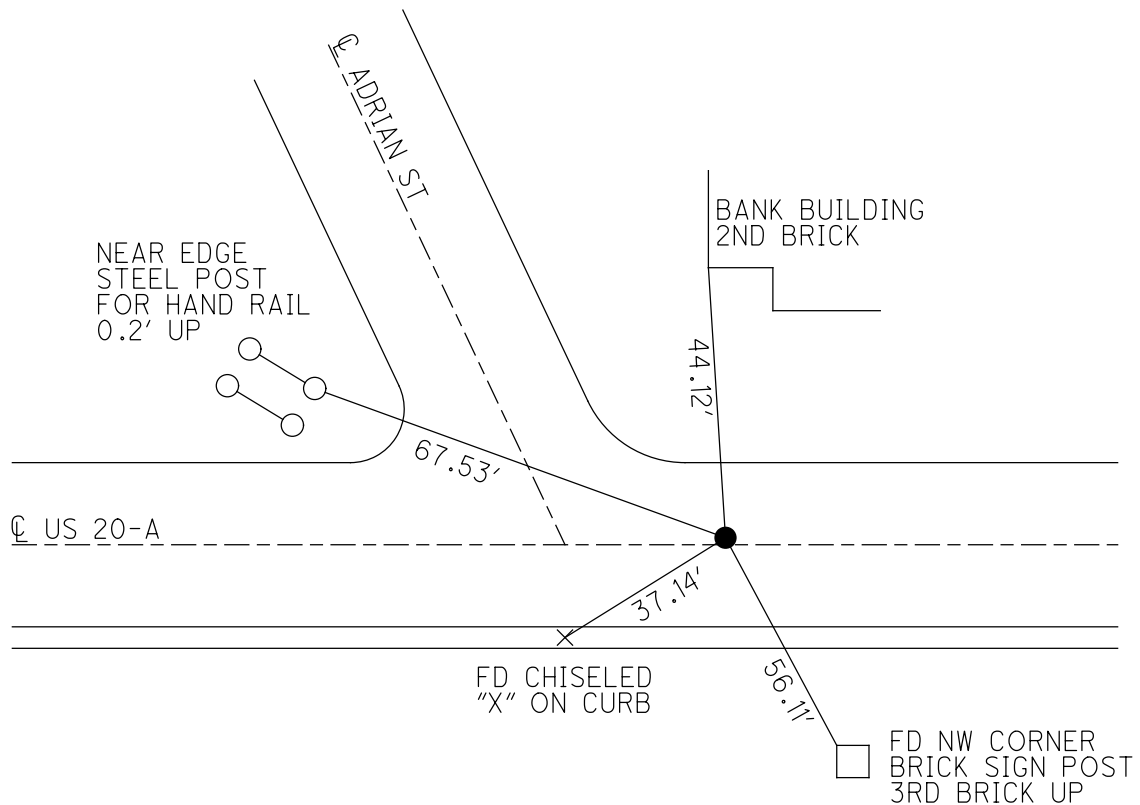

O.D.O.T. DISTRICT 2 SURVEY OFFICE

PERSONNEL _____

REFERENCE NO. 39-C

SHEET 4 OF 11

NOTES CANTERBURY

H.C. NUMBER

R.C. DEBOWSKY

DATE 8-14-03

WEATHER SUNNY

TEMP. +80°

ROUTE U.S. 20-A

COUNTY Fulton

TOWNSHIP York

SECTION 13

T. 7 N. R. 7 E.


TYPE MONUMENT P.K. SHANK

ON SURFACE - BELOW SURFACE


LEFT - ~~E~~ PAV'T. - RIGHT 1.0' &

15' TO E EDGE PAVEMENT OF & ADRIAN

S.L.M. 1032 + 49

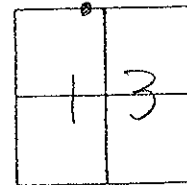

SET MAGNAIL / WASHER
12-29-03 RGM

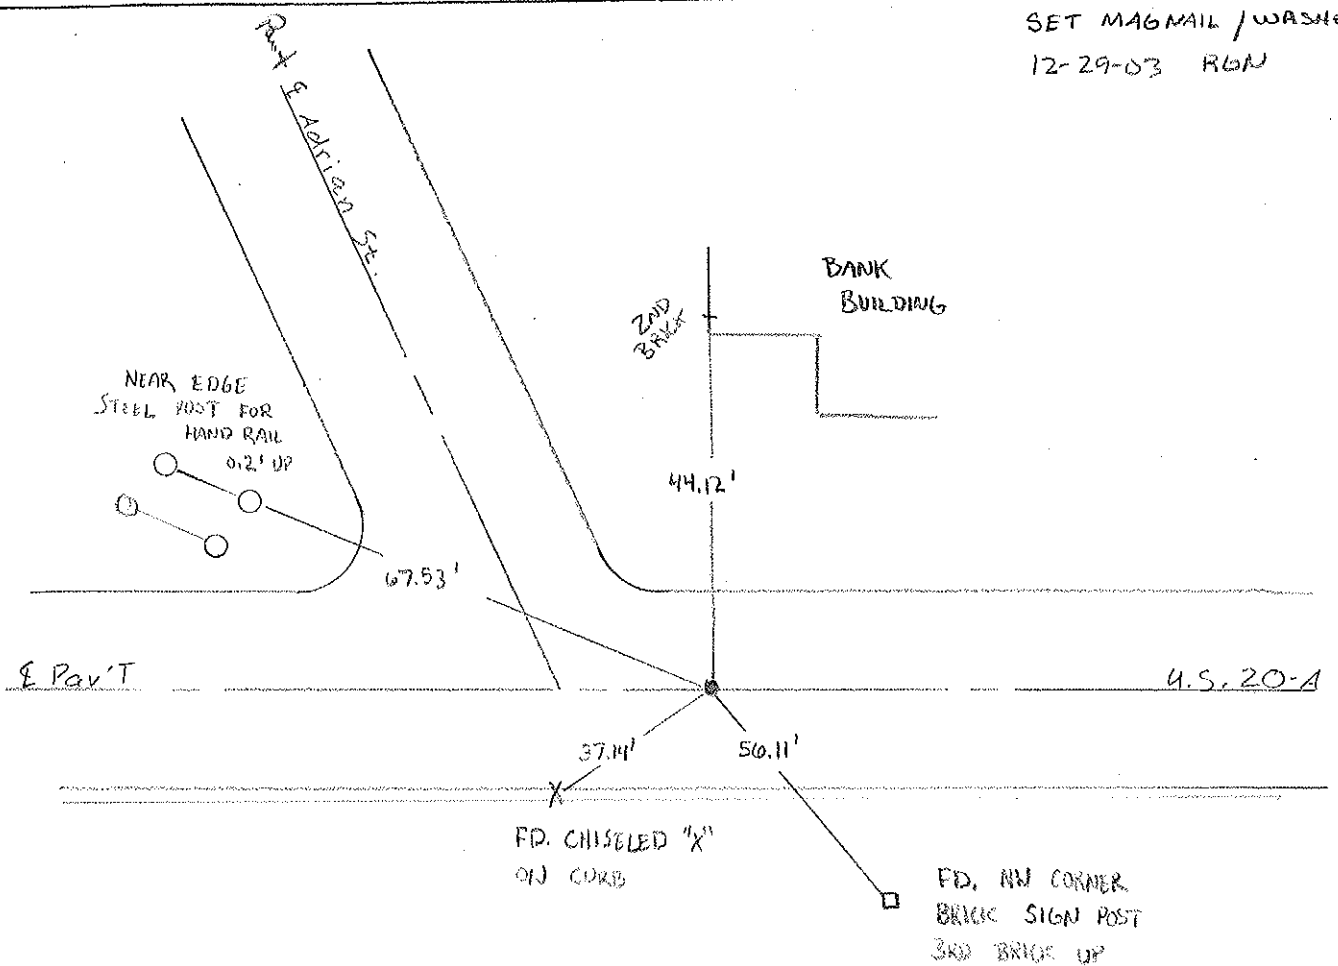

O.D.O.T. DISTRICT 2 SURVEY OFFICE

PERSONNEL _____

REFERENCE NO. 39-C

SHEET 18 OF 24

NOTES 1.5 Stone

H.C. D. Curtis

DATE 17 Sept. 86

ROUTE US #20-A

R.C. J. Householder

WEATHER Cool

COUNTY Fulton

TEMP. 60°

TOWNSHIP York

SECTION 13

T _____ R _____


TYPE MONUMENT PK Nail

ON SURFACE - BELOW Surface


LEFT- & PAV'T. - RIGHT _____

TO _____ EDGE PAVEMENT

S.L.M. 1032+49

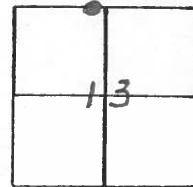

SET P.K. NAIL TO SURFACE
5-13-88

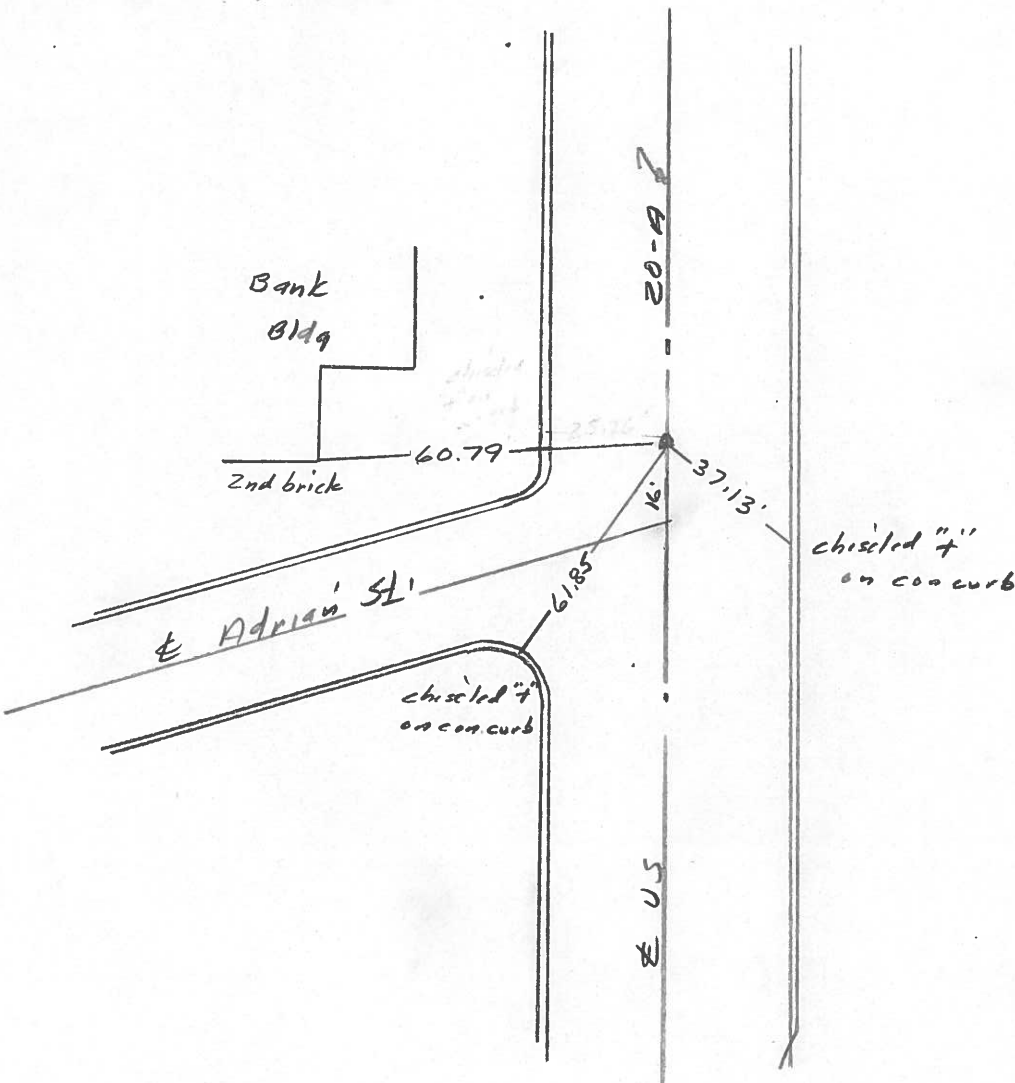

PERSONNEL	TITLE	PERSONNEL	TITLE
W. Denno		D. GRANATA	
D. Curtis		P. NEUSER	
J. Miller		A. VANYO	

COUNTY Fulton DATE June 9, 1971
 S. R. 20-A WEATHER Sunny, Mild
 SEC. _____ TEMP. 75°

DESCRIPTION References to control points JOB NO. _____

