

O.D.O.T. DISTRICT 2 SURVEY OFFICE (USE ONLY)

PERSONNEL _____

REFERENCE NO. 39 G

SHEET 7 OF 14

NOTES NIESE DATE 4-27-21

ROUTE US 20 A

H.C. AUBLE WEATHER CLOUDY

COUNTY FULTON

R.C. NIESE TEMP. 60°

TOWNSHIP YORK

SECTION 13

DWG BY AUBLE PID 101295

T 7 N R 7 E

TYPE MONUMENT MAG/WASHER

ON SURFACE - ~~BELOW~~ ON


OFFSET ☉ PAVEMENT 4.1' ~~LT~~ : RT

- TO - EDGE PAVEMENT


STATION: _____

HORIZ.DATUM: NAD83(2011) GEOID: 12A

GRID: NORTHING: 698414.869 EASTING: 1557582.477

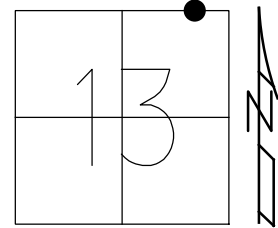

RECORD:
 SET P.K. NAIL
 5/13/88
 SET MAG/WASHER
 1/12/04, RGN
 FD MAG/WASHER
 REFG39
 1/27/20, JLL
 SET MAG/WASHER
 10/7/21, DSA

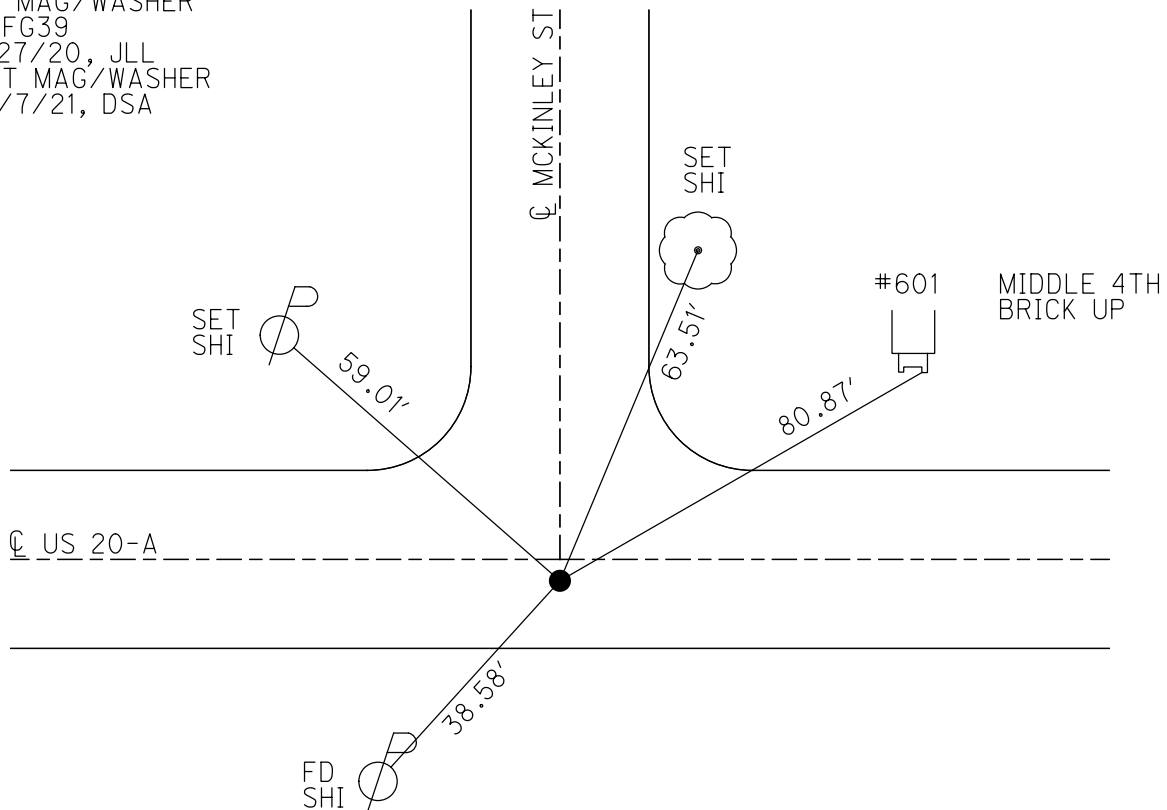

O.D.O.T. DISTRICT 2 SURVEY OFFICE (USE ONLY)

PERSONNEL _____

REFERENCE NO. 39 G

SHEET 7 OF 14

NOTES CANTERBURY

DATE 8/14/03

ROUTE US 20 A

H.C. NUHFER

WEATHER SUNNY

COUNTY FULTON

R.C. ZEBROWSKI

TEMP. 80°

TOWNSHIP YORK

SECTION 13

DWG BY NIESE

PID _____

T 7 N R 7 E

TYPE MONUMENT P.K. SHANK

ON SURFACE - ~~BELOW~~ ON

OFFSET ϕ PAVEMENT 4.1' ~~LT~~ : RT

- TO - EDGE PAVEMENT


STATION: -

HORZ.DATUM: -


GEOID: -

GRID: NORTHING: -

EASTING: -

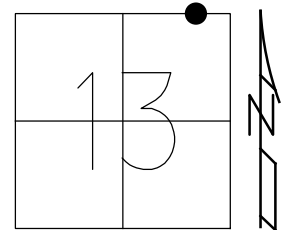

RECORD:
 SET P.K. NAIL
 5/13/88
 SET MAG/WASHER
 1/12/04, RGN

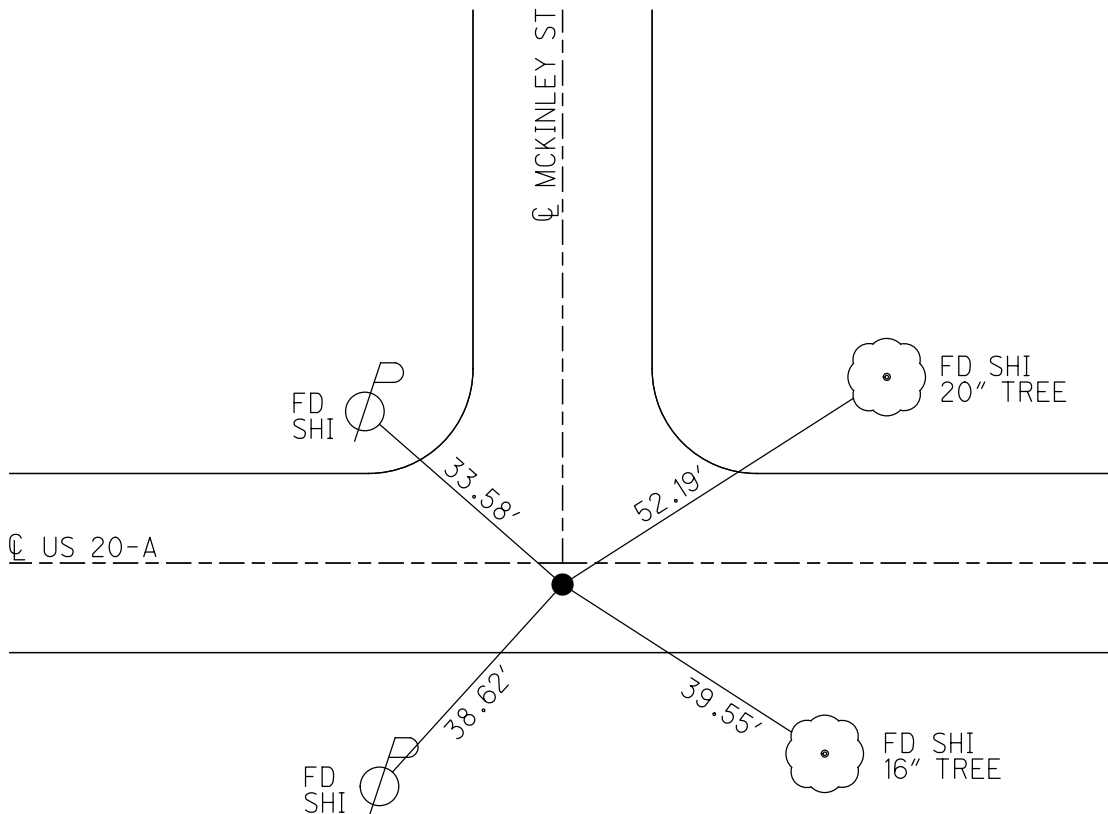

O.D.O.T. DISTRICT 2 SURVEY OFFICE

PERSONNEL

REFERENCE NO. 39-6

SHEET 22 OF 24

NOTES 1. Stone

H.C. D. Curtis

R.G. J. Householder

DATE 23 Sept. 86

WEATHER Cloudy

TEMP. 70°

ROUTE US#20-17

COUNTY Fulton

TOWNSHIP York

SECTION 13

T. R.


TYPE MONUMENT PK Nail

ON SURFACE - BELOW Surface


LEFT- & PAV'T. - RIGHT

TO EDGE PAVEMENT

S.L.M. 1053 + 14

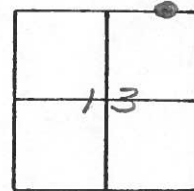

SET P.K. NAIL TO SURFACE
5-13-88

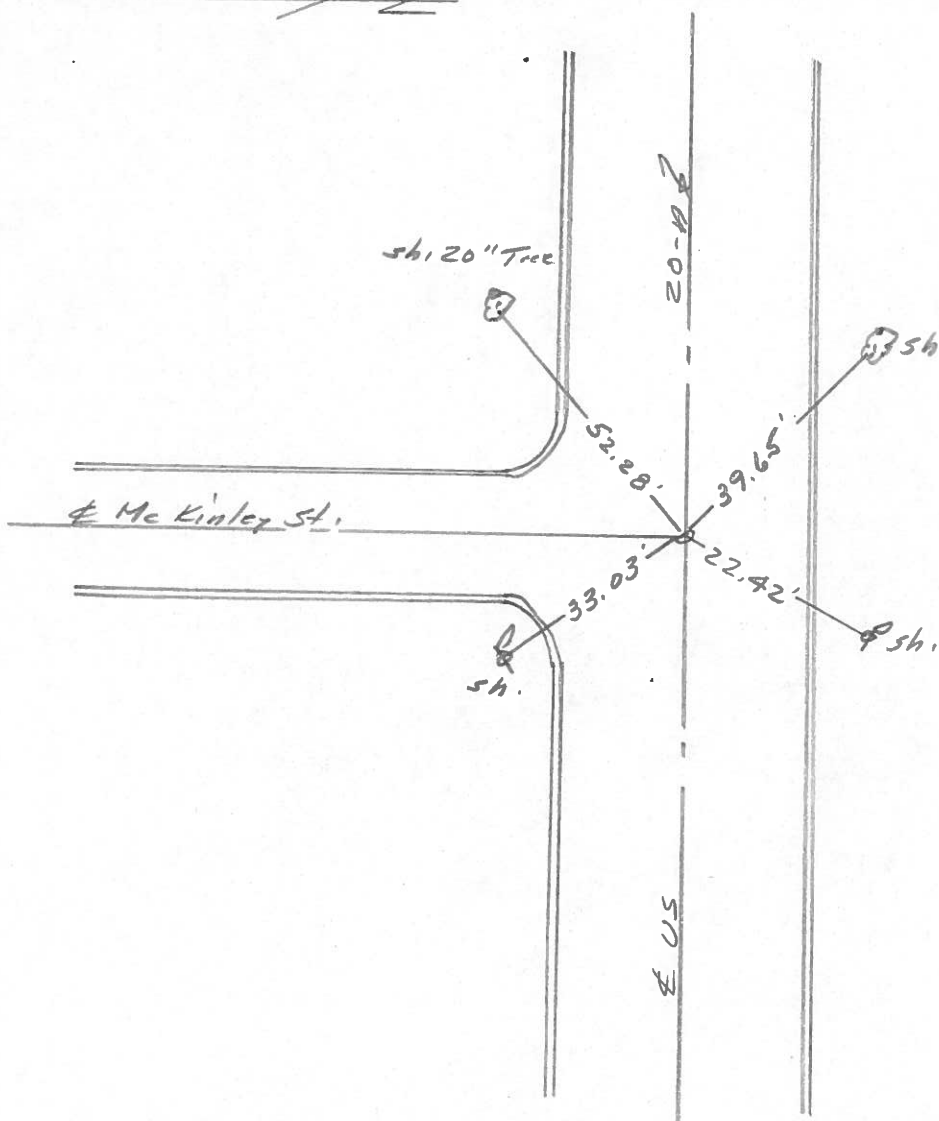

| PERSONNEL | TITLE | PERSONNEL | TITLE |
|-----------|-------|------------|-------|
| W. Derno | | D. Gramata | |
| D. Curtis | | P. Neuser | |
| | | A. Vanya | |

COUNTY Fulton DATE June 9, 1971

S. R. 20-A WEATHER Sunny-mild

SEC. _____ TEMP. 75°F

DESCRIPTION References To Control Points JOB NO. _____

