

O.D.O.T. DISTRICT 2 SURVEY OFFICE (USE ONLY)

PERSONNEL

REFERENCE NO. 39 HH

SHEET 10 OF 14

NOTES LEU DATE 1-27-20

ROUTE US 20 A

H.C. LEU WEATHER CLOUDY

COUNTY FULTON

R.C. BALBAUGH TEMP. 33°

TOWNSHIP SWAN CREEK

DWG BY AUBLE PID 101295

SECTION 18

T 7 N R 8 E

TYPE MONUMENT 1 1/2" IPIPE

~~ON SURFACE~~ - BELOW 9"


OFFSET  $\odot$  PAVEMENT 27.8' ~~LT~~ : RT

12.4' TO RT EDGE PAVEMENT


STATION: 1087+02

HORIZ.DATUM: NAD83(2011) GEOID: 12A

GRID: NORTHING: 698378.778 EASTING: 1560968.280

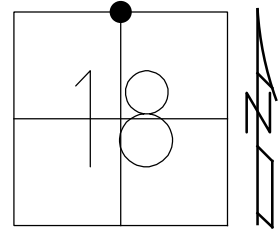

RECORD:  
 FD 1 1/2" IPIPE  
 4" DOWN  
 3/21/01, DCH  
 9" DOWN  
 REFHH39  
 11-1-21, DSA

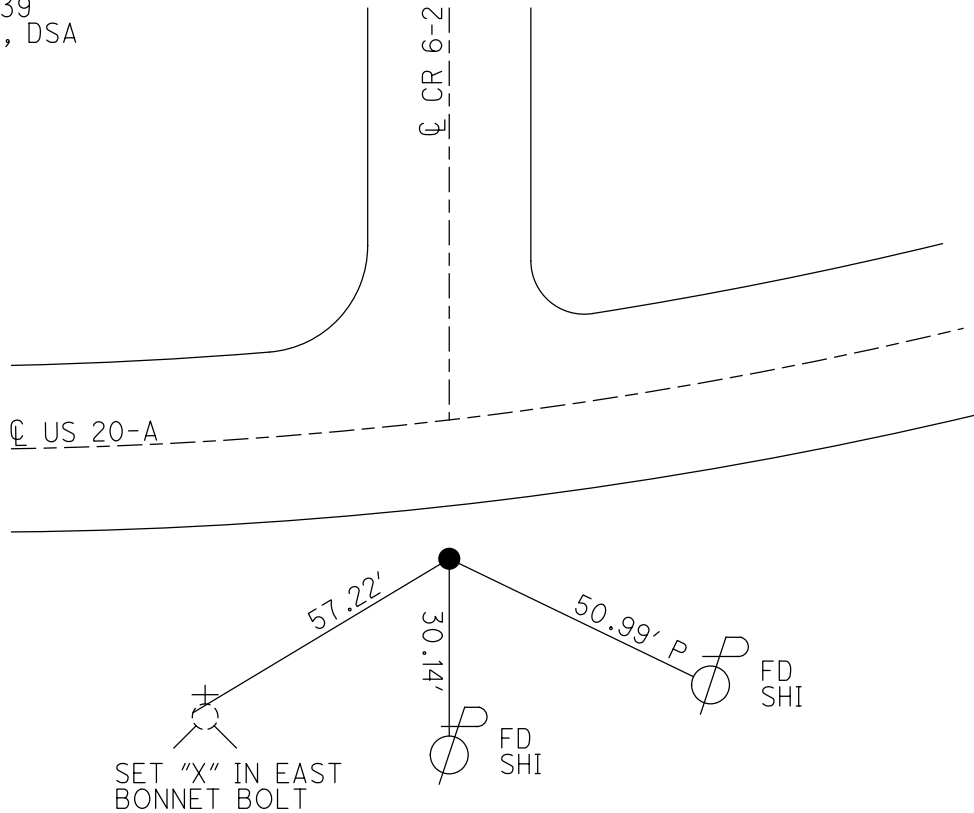

O.D.O.T. DISTRICT 2 SURVEY OFFICE (USE ONLY)

PERSONNEL \_\_\_\_\_

REFERENCE NO. 39 HH

SHEET 10 OF 14

NOTES CORDES

DATE 3/21/01

ROUTE US 20 A

H.C. HOMAN

WEATHER SUNNY

COUNTY FULTON

R.C. SMITH

TEMP. 52°

TOWNSHIP SWAN CREEK

DWG BY NIESE

PID \_\_\_\_\_

SECTION 18

T 7 N R 8 E

TYPE MONUMENT 1 1/2" IPIPE

~~ON SURFACE~~ - BELOW 4"

OFFSET  $\odot$  PAVEMENT 27.6' ~~RT~~ : RT

12.4' TO RT EDGE PAVEMENT



STATION: -

HORIZ.DATUM: -

GEOID: -

GRID: NORTHING: -

EASTING: -

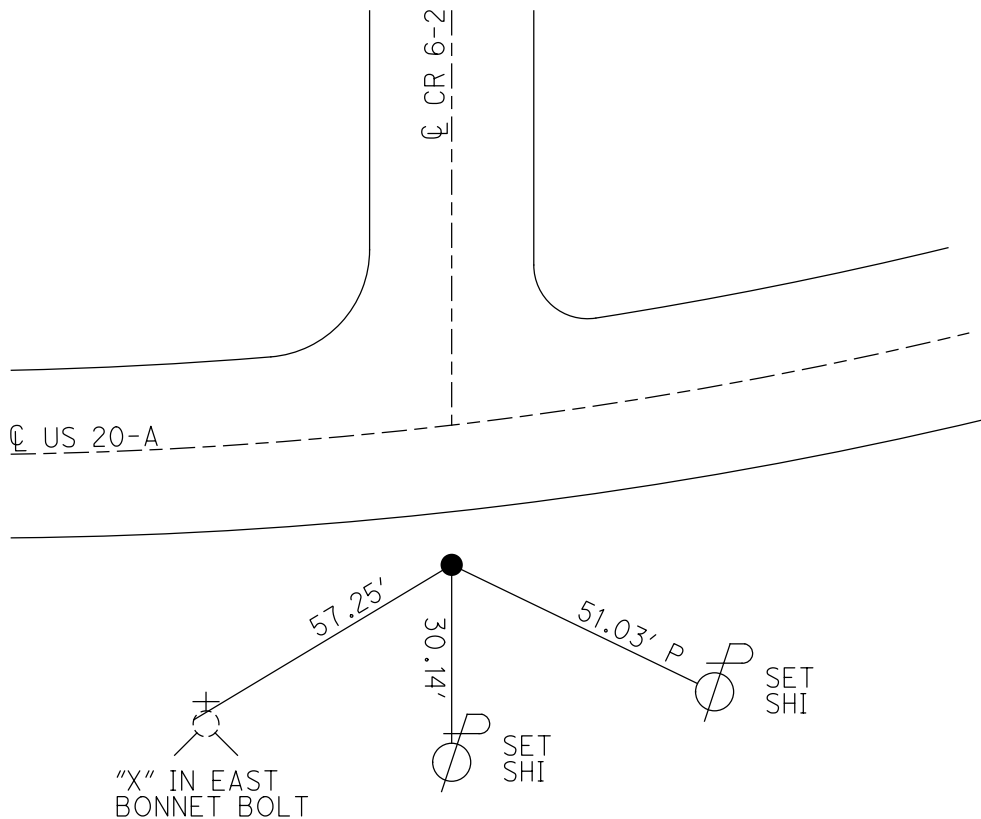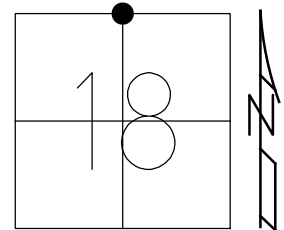

O.D.O.T. DISTRICT 2 SURVEY OFFICE

PERSONNEL

REFERENCE NO. 39HH

SHEET 10 OF 11

NOTES CORDES

H.C. HOMAN

R.C. SMITH

DATE 3/21/01

WEATHER SUN

TEMP. 52°

ROUTE 20 A

COUNTY FULTON

TOWNSHIP SWAN CREEK

SECTION 7

T.N. 6 R 8 E


TYPE MONUMENT I-PIPE 1 1/2"

~~4"~~ - BELOW 4"

~~27.6'~~ & PAV'T. - RIGHT 27.6'

12.4 TO RT EDGE PAVEMENT

S.L.M. \_\_\_\_\_

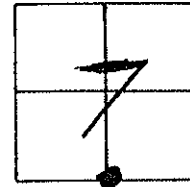

& PAV'T. CO RD 6-2

& PAV'T

SR 20A

