

PERSONNEL TITLE PERSONNEL TITLE

COUNTY Fulton

DATE 1-28-58

S. R. 2 & 20 A14

WEATHER

SEC.

TEMP.

DESCRIPTION


LEFT

CENTER LINE


RIGHT

JOB NO.

C.S. Sta. 1137+90.72

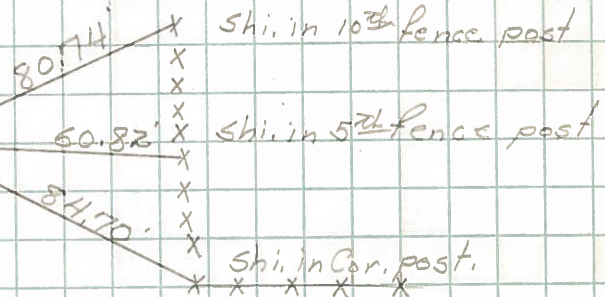

S.T. Sta. 1141+40.72  
P.K. nail

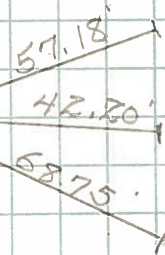

Chisel mark in top of sign post stakes 6" above ground

N.E. Cor C.B.

S.E. cor. curb br. abut.

$\Delta = 1^{\circ} - 22' - 45''$  Pk.

