


O.D.O.T. DISTRICT 2 SURVEY OFFICE (USE ONLY)


PERSONNEL _____ REFERENCE NO. 42 A SHEET 14 OF 14
 NOTES LEU DATE 1-23-20 ROUTE US 20 A
 H.C. LEU WEATHER CLOUDY COUNTY FULTON
 R.C. BALBAUGH TEMP. 33° TOWNSHIP SWAN CREEK
 DWG BY AUBLE PID 101295 SECTION 16
 T 7 N R 8 E

TYPE MONUMENT P.K.NAIL
~~ON SURFACE~~ - BELOW 2.5"
 OFFSET ☐ PAVEMENT ON LT : RT
- TO - EDGE PAVEMENT
 STATION: 1199+42

HORIZ.DATUM: NAD83(2011) GEOID: 12A
 GRID: NORTHING: 698215.824 EASTING: 1571645.929

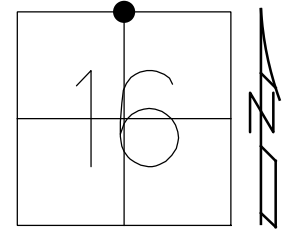

RECORD:
 SET P.K. NAIL
 9/15/86, IRS
 FD P.K.NAIL
 REFA42
 1-23-20, JLL
 SET MAG/WASHER
 11-1-21, DSA

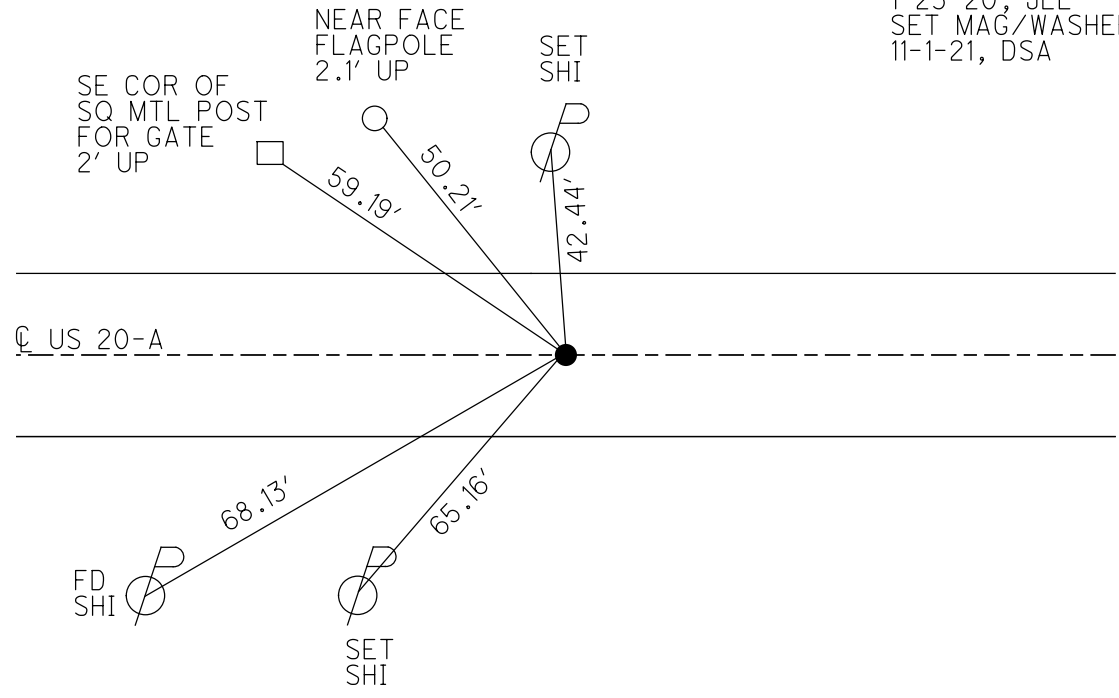

O.D.O.T. DISTRICT 2 SURVEY OFFICE (USE ONLY)

PERSONNEL

REFERENCE NO. 42 A

SHEET 14 OF 14

NOTES STONE

DATE 3/4/86

ROUTE US 20 A

H.C. CURTIS

WEATHER COOL

COUNTY FULTON

R.C. HOUSEHOLDER

TEMP. 35°

TOWNSHIP SWAN CREEK

MICHALAK

SECTION 16

DWG BY NIESE PID _____

T 7 N R 8 E

TYPE MONUMENT P.K. NAIL

ON SURFACE - ~~BELOW~~ ON


OFFSET \varnothing PAVEMENT ON LT : RT

- TO - EDGE PAVEMENT


STATION: 1199+42

HORZ.DATUM: - GEOID: -

GRID: NORTHING: - EASTING: -

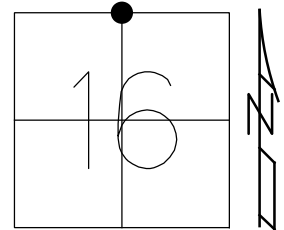

RECORD:
SET P.K. NAIL
9/15/86, IRS

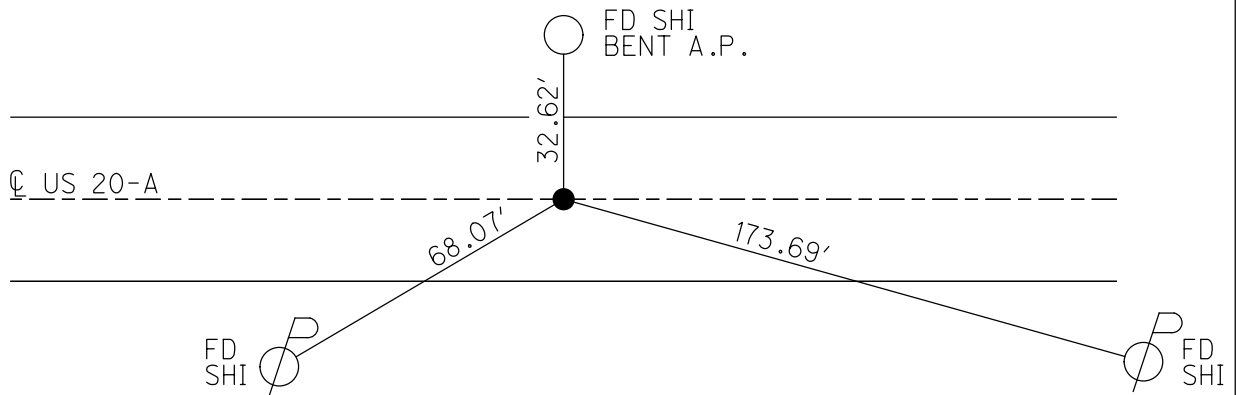

O.D.O.T. DISTRICT 2 SURVEY OFFICE


PERSONNEL _____ REFERENCE NO. 42-A SHEET 9 OF _____

NOTES 1 Stone
 H.C. D. Curtis
 R.C. J. Haushalter
R. Michalak

DATE 4 March 86
 WEATHER Cool
 TEMP. 35°


ROUTE US # 20-A
 COUNTY Fulton
 TOWNSHIP Swain Corak
 SECTION 9
 T _____ R _____

TYPE MONUMENT PK Nail
 ON SURFACE - BELOW Surface
 LEFT - @ PAV'T. - RIGHT _____
 TO _____ EDGE PAVEMENT
 S.L.M. 1199+42

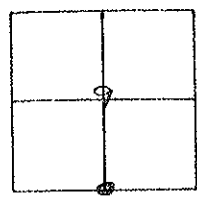

Set PK Nail 9/15/86 IRS

7

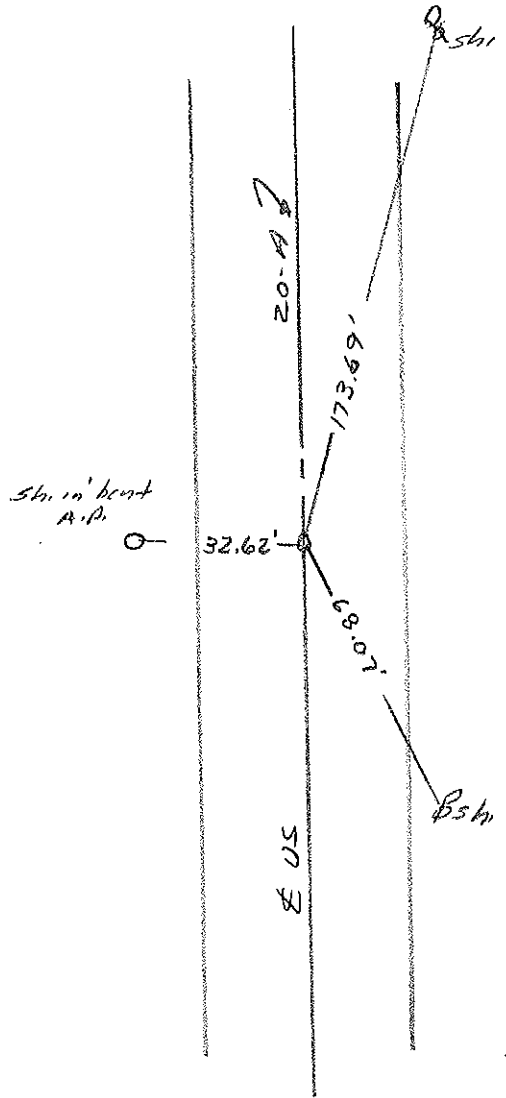

County FULTON ^{U.S.} ~~S.R.~~ 20-A

Date 4-28-82

Township SWAN CREEK

Weather _____

Section 9

Temp. +60°



T 7 N, R E

Personnel HOFFMAN

HOUSEHOLDER

LOEHRKE

42-A

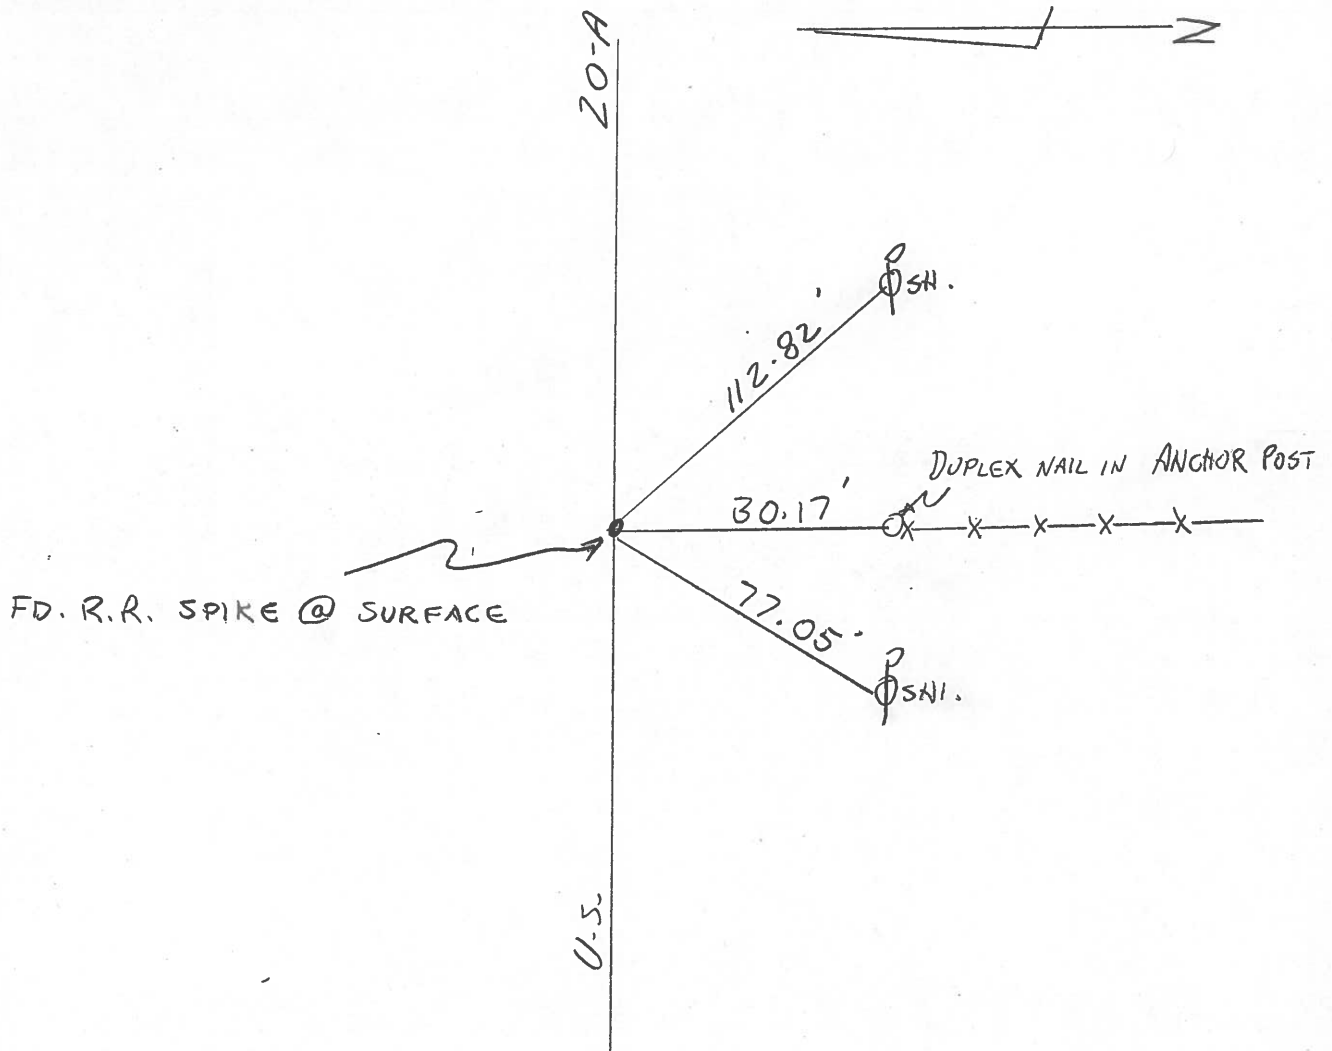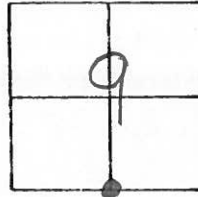

PERSONNEL TITLE PERSONNEL TITLE

COUNTY Fulton DATE Jan 1960

PERSONNEL TITLE PERSONNEL TITLE

S. R. US 20-A WEATHER

PERSONNEL TITLE PERSONNEL TITLE

SEC Delta. - Swanton TEMP

DESCRIPTION

CONTROL POINTS

JOB NO. 11-1-61

LEFT CENTER LINE RIGHT

