



O.D.O.T. DISTRICT 2 SURVEY OFFICE (USE ONLY)

|           |               |         |         |          |            |    |
|-----------|---------------|---------|---------|----------|------------|----|
| PERSONNEL | REFERENCE NO. | 46      | SHEET   | 6        | OF         | 10 |
| NOTES     | RHOADES       | DATE    | 7/27/16 | ROUTE    | US 20-A    |    |
| H.C.      | O'DONNELL     | WEATHER | SUNNY   | COUNTY   | FULTON     |    |
| R.C.      | KEFFER        | TEMP.   | 74°     | TOWNSHIP | SWAN CREEK |    |
|           |               |         |         | SECTION  | 11         |    |
|           |               |         |         | T        | 7          | N  |
|           |               |         |         | R        | 8          | E  |

TYPE MONUMENT R.R.SPIKE  
~~ON SURFACE~~ - BELOW 6"  
 LEFT - ☉ PAV'T - RIGHT -  
0.4' TO LT EDGE PAVEMENT  
 S.L.M. 1315+82.89  
 Grid: Northing: 699879.082 Easting: 1582905.733

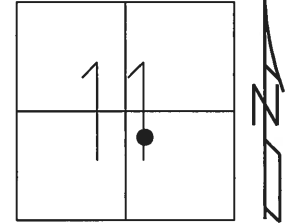

RECORD:  
 SET LG.R.R.SPIKE  
 9/15/86, IRS  
 FD BOLT  
 W/PUNCH HOLE  
 REF46  
 7/31/12, SDC  
 SET MAG/WASHER  
 NEWREF46  
 11/18/16, JFO

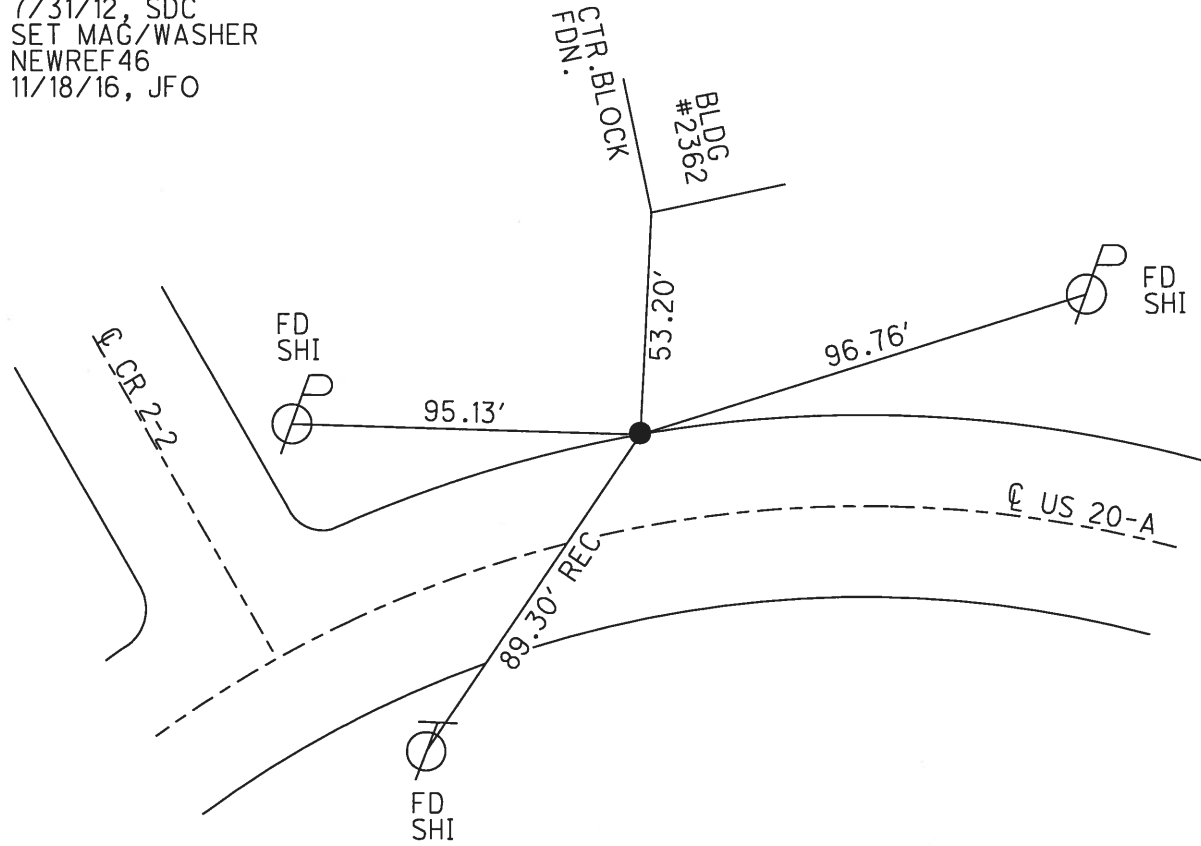

# O.D.O.T. DISTRICT 2 SURVEY OFFICE

PERSONNEL \_\_\_\_\_

REFERENCE NO. 46

SHEET 10 OF \_\_\_\_\_

NOTES 1. Stone

H.C. D. Curtis

R.C. T. Householder

R. Michalak

DATE 5 March 86

WEATHER Cloudy

TEMP. 33°

ROUTE US #20-A

COUNTY Fulton

TOWNSHIP Swan Creek

SECTION 11

T \_\_\_\_\_ R \_\_\_\_\_


TYPE MONUMENT ck Spk.

ON SURFACE - BELOW 6" deep


LEFT- & PAV'T. - RIGHT \_\_\_\_\_

TO \_\_\_\_\_ EDGE PAVEMENT

S.L.M. 1315+81

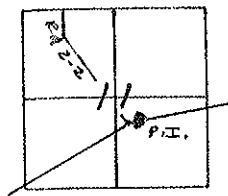

Set Large spk. 9/15/86 IRS

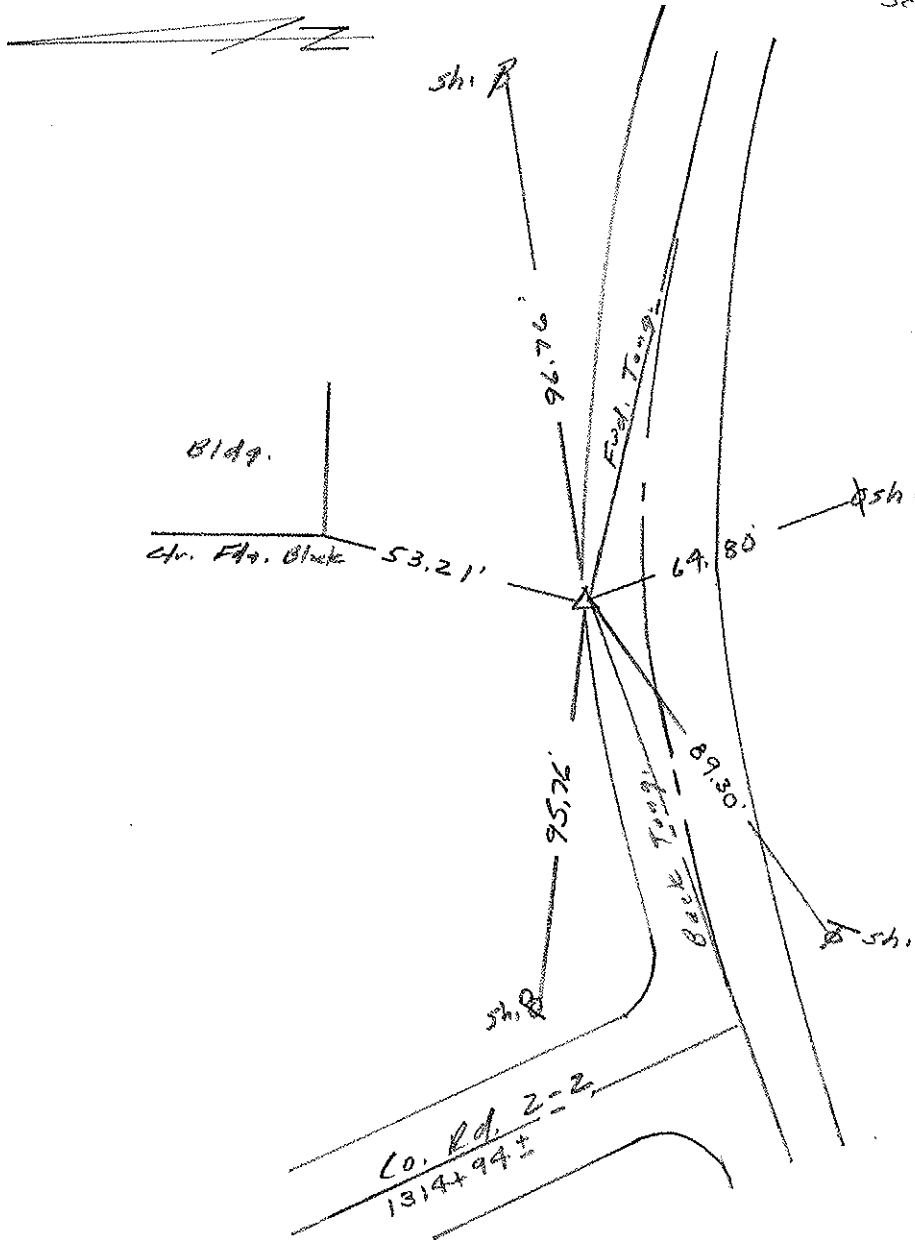

County FULTON <sup>U.S.</sup> ~~S.R.~~ 20-A

Date 5-11-73

Township SWAN CREEK


Weather \_\_\_\_\_

Section 11

Temp. 65°


T N, R E

Personnel TOM SIC

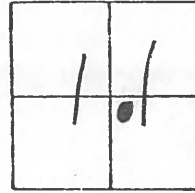

# 46

NEUSER  
GRANATA  
VANYO

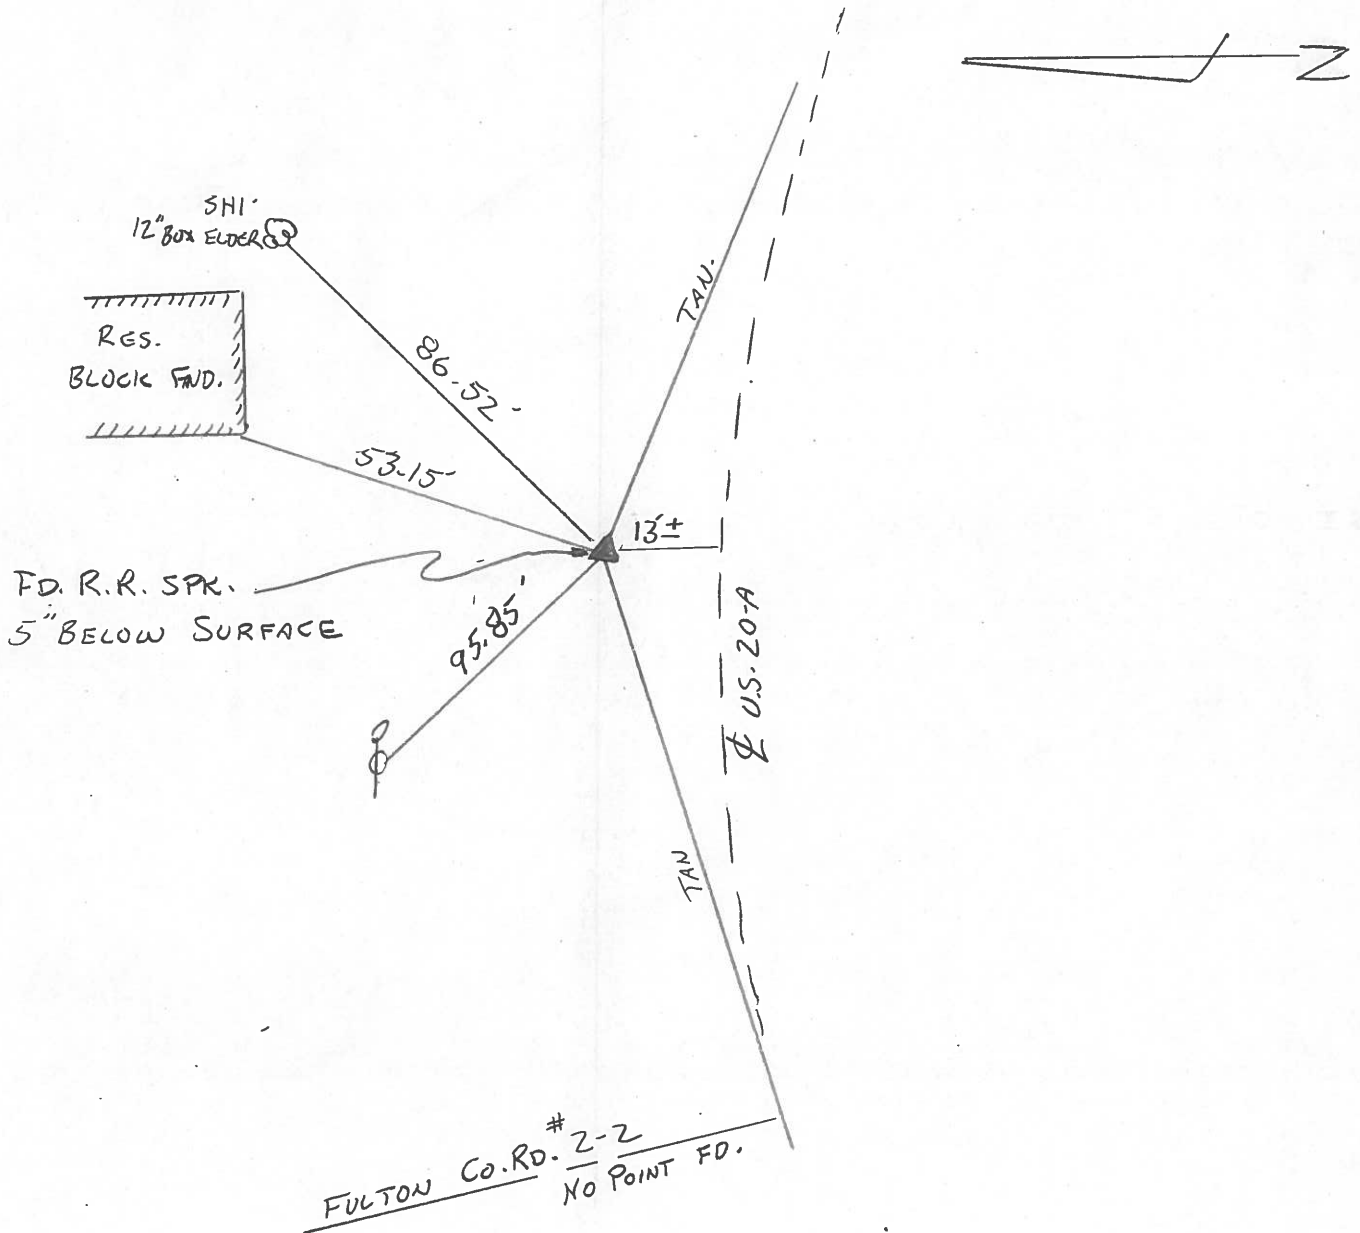

PERSONNEL TITLE PERSONNEL TITLE

COUNTY Fulton DATE 7 Jan. '60

Beach  
Knape  
Hoff  
Gunter

S. R. US 20-A WEATHER \_\_\_\_\_

SEC. Delta - Swanton TEMP. \_\_\_\_\_

DESCRIPTION CONTROL POINTS JOB NO. \_\_\_\_\_

LEFT CENTER LINE RIGHT

