

O.D.O.T. DISTRICT 2 SURVEY OFFICE (USE ONLY)

PERSONNEL _____

REFERENCE NO. 4

SHEET 5 OF 7

NOTES CORDES

DATE 4/14/97

ROUTE US 6

H.C. LOEHRKE

WEATHER SUN

COUNTY HENRY

R.C. MOSER
HUSS

TEMP. 32°

TOWNSHIP RIDGEVILLE

DWG BY NIESE PID _____

SECTION 32

T 6 N R 5 E

TYPE MONUMENT SM.R.R.SPIKE

ON SURFACE - ~~BELOW~~ ON

OFFSET ☉ PAVEMENT ON LT : RT

12.3' TO RT EDGE PAVEMENT


STATION: 72+67

HORZ.DATUM: _____

GEOID: _____


GRID: NORTHING: _____

EASTING: _____

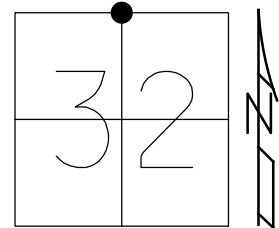

RECORD: P.I.
STA 72+63.84
FD SM R.R. SPIKE
4/14/97, BWC
SET P.K./WASHER
6/26/97, BWC

☉ US 6

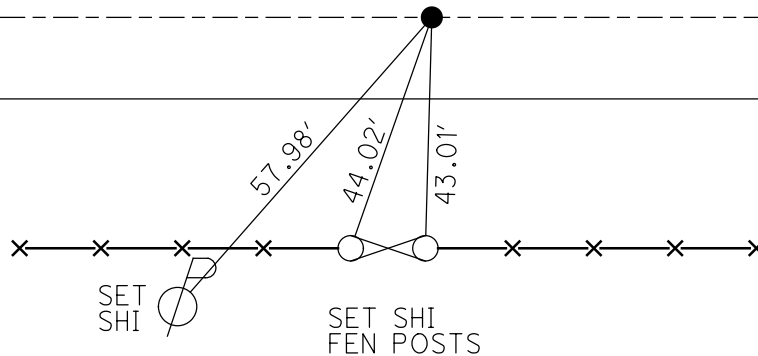

O.D.O.T. DISTRICT 2 SURVEY OFFICE

PERSONNEL

REFERENCE NO. 4

SHEET 4 OF 7

NOTES COPEES

H.C. LOENKE

R.C. MOSEK

A HUSS

DATE 4-14-97

WEATHER SUN

TEMP. +4°C

ROUTE 6

COUNTY HENRY

TOWNSHIP RIDGEMINE

SECTION 29

T. 6 N. 5 E.


TYPE MONUMENT 5m IR SPIKE

ON SURFACE - ~~BEHIND~~ YES

~~BEHIND~~ PAV'T. - ~~RIGHT~~ YES


3.75m TO RT EDGE PAVEMENT

S.L.M. 2+215

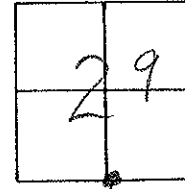

REC PI
STA: 72+63.84

SET PK &
WASHER
6-26-97
BWC

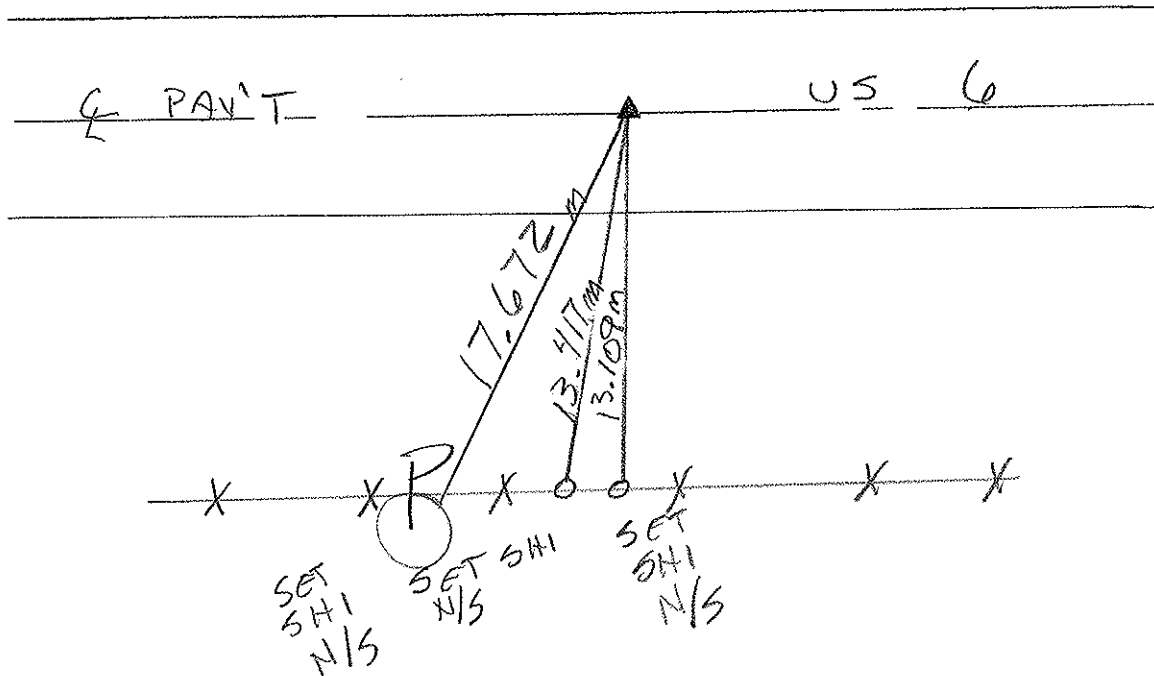

O.D.O.T. DISTRICT 2 SURVEY OFFICE

PERSONNEL

REFERENCE NO. 4

SHEET OF

NOTES HOFFMAN

H.C. LOEHRKE

R.C. BARWISSEL

DATE 5-17-85

WEATHER Cloudy

TEMP. 60°

ROUTE U.S. 6

COUNTY HENRY

TOWNSHIP RIDGEVILLE

SECTION 29

T 6 N R 5 E


TYPE MONUMENT R.R. SPIKE Set Small RR. SPIKE

~~ON SURFACE~~ - BELOW 1 1/2" 6-13-85 SURV


LEFT- & PAV'T. - RIGHT ON R

12.0 TO RT EDGE PAVEMENT



S.L.M. 72+63

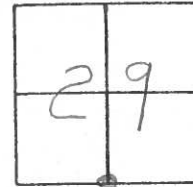

P.I. STA 72+63.84

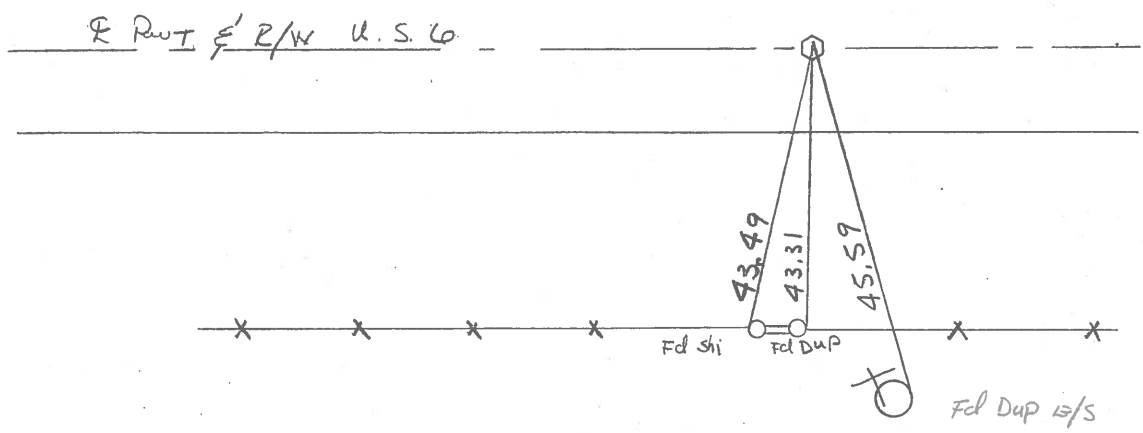

PERSONNEL	TITLE	PERSONNEL	TITLE	COUNTY	DATE
Red Beach				HENRY	8 July 74
W. Knappe				S. R.	US 6
D. Boyle				SEC.	Ridgeville Twp.
J. Bagdonas				TEMP.	
DESCRIPTION				CONTROL POINTS	JOB NO.

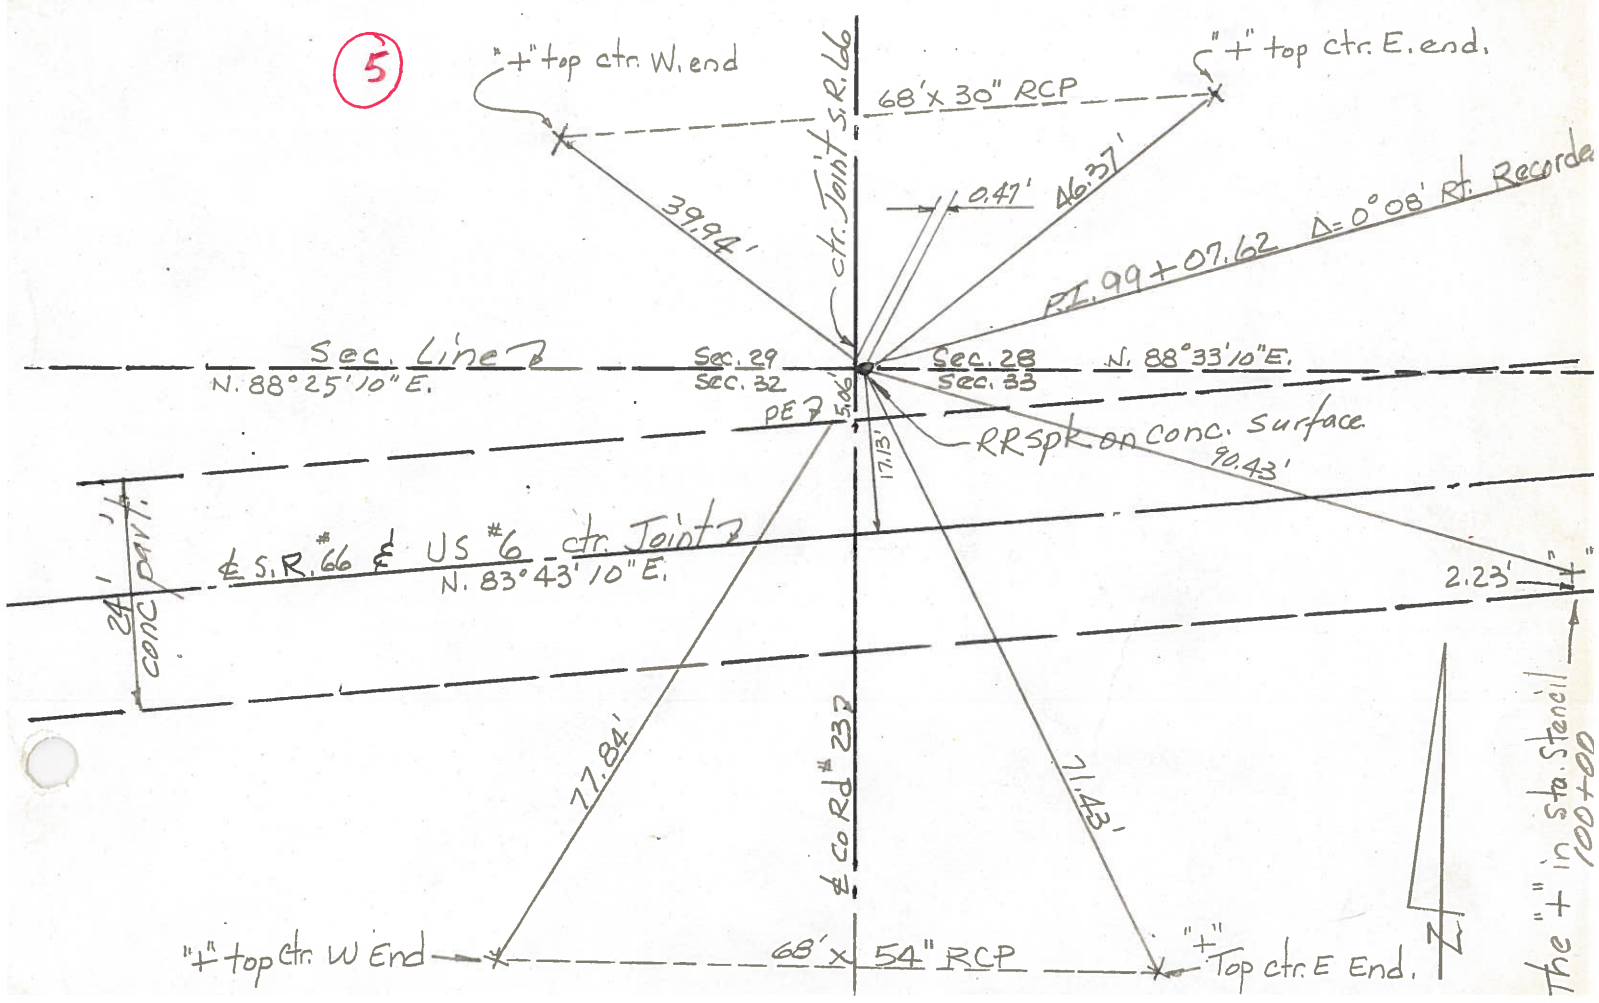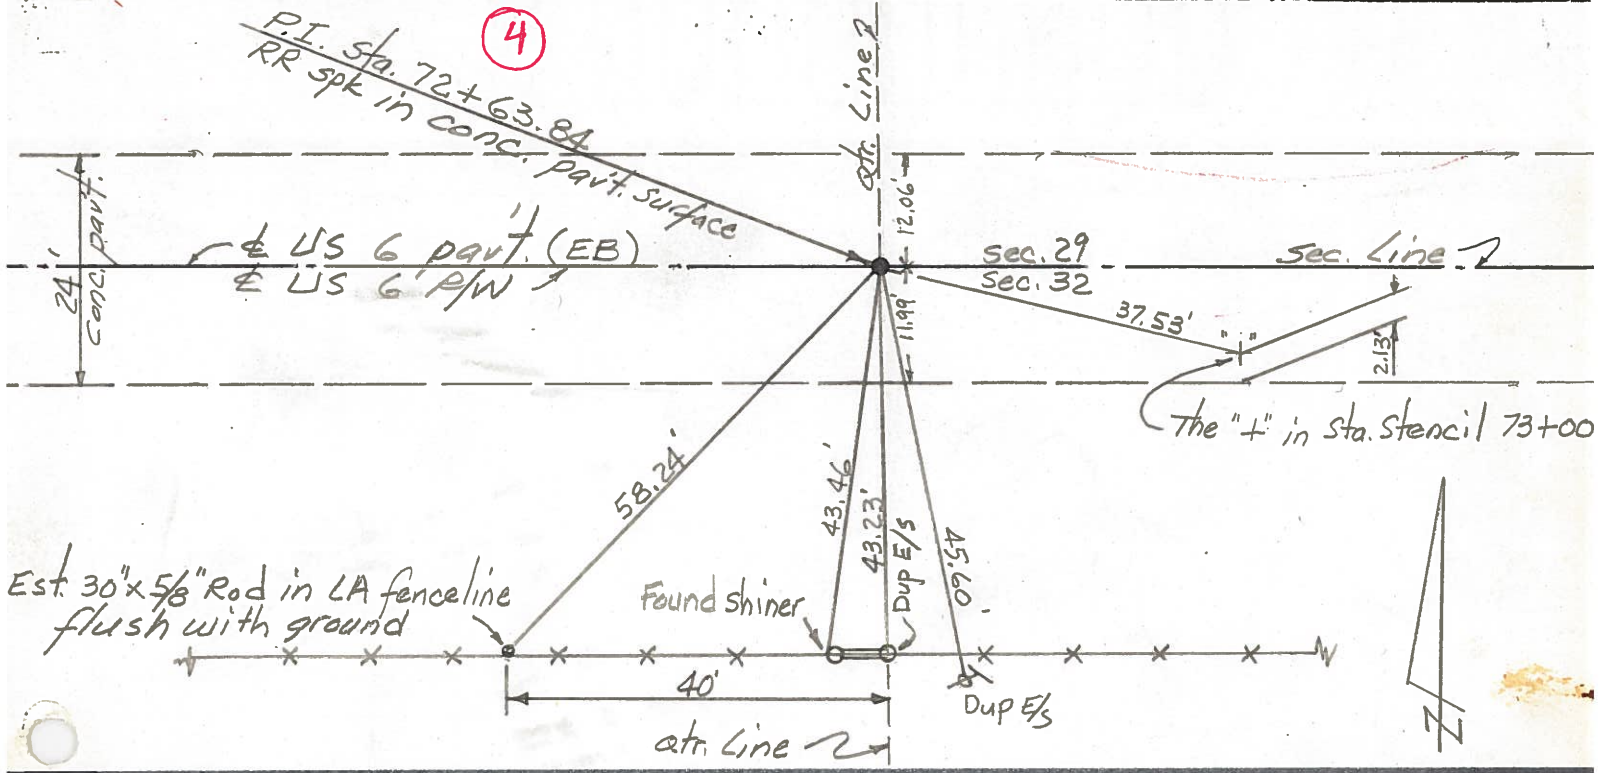

PERSONNEL TITLE PERSONNEL TITLE

COUNTY Henry

DATE 12-13-60

Hoover _____

S. R. 6

WEATHER Cloudy

Ruffer _____

Delventhal _____


SEC. _____

TEMP. 15°

Young _____

Mohler _____

JOB NO. _____

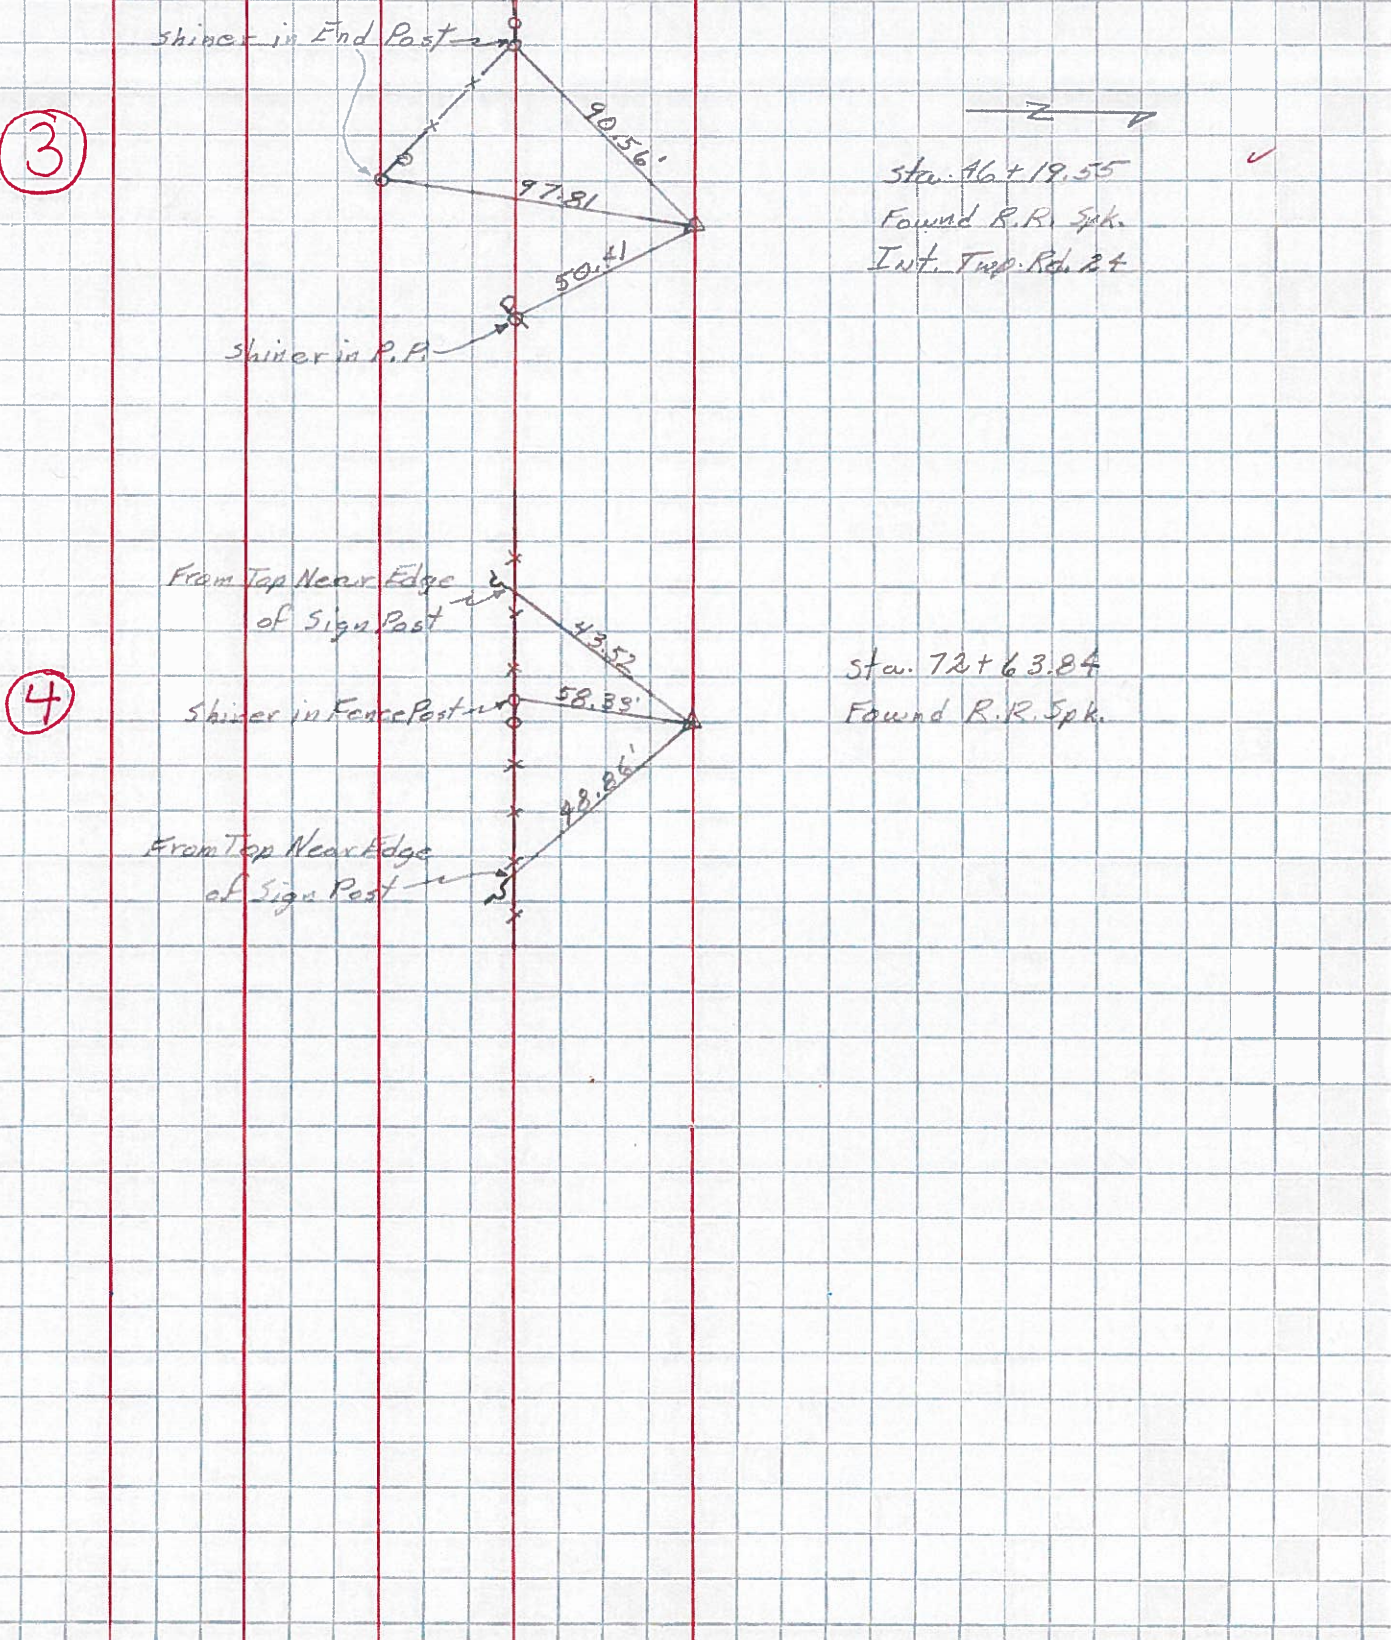

PERSONNEL TITLE PERSONNEL TITLE

COUNTY Henry

DATE Jan 1951

S. R. #384

WEATHER _____

SEC. _____

TEMP. _____

DESCRIPTION _____


JOB NO. _____

LEFT CENTER LINE RIGHT

10/9/56

WILLIAMS-HENRY Co Line


Sta 70+20.00 = Sta. 0+00
 Found Stone Sta 70+20.00
 Established Tacked Hub 20.94 North

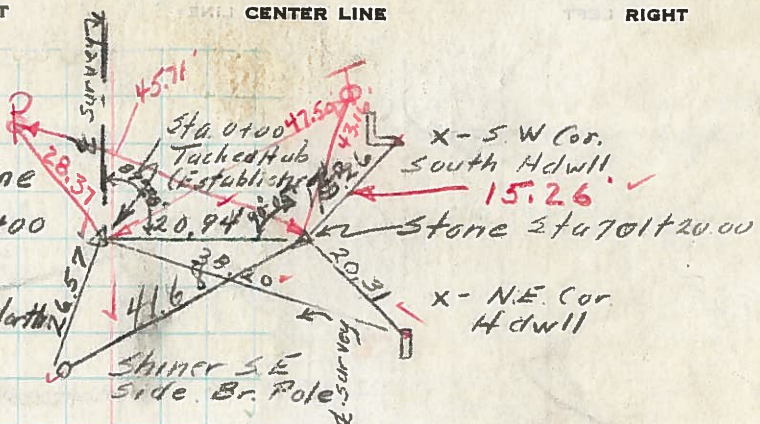

Recorded in
 Map book
 H.C.


10/9/56

Sta. 19+87.65
 L = 0° 00'
 Found Stone

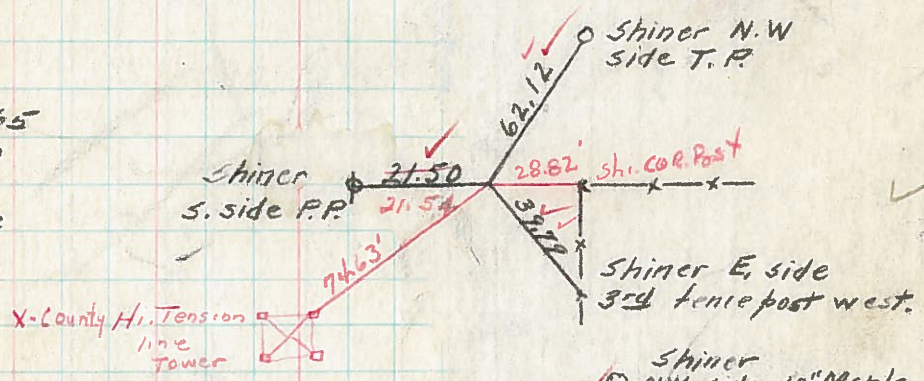


10/9/54

Sta. 46+19.55
 L = 0° 10' Lt.
 Found I. P. over Stone
 S.R. #384 & Twp. Rd #24

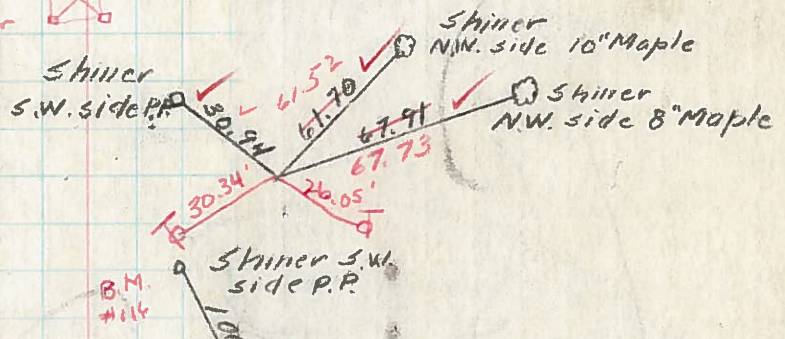

10/9/54

Sta. 72+63.84
 L = 0° 08' Lt.
 Found Stone
 Set R.R. Spk.

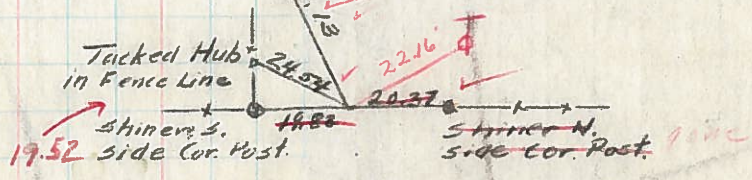

10/9/56

Sta. 99+17.62
 L = 0° 8' Rt.
 Established Tacked Hub.
 Set R.R. Spk
 S.R. #384 & S.R. #66

