

O.D.O.T. DISTRICT 2 SURVEY OFFICE (USE ONLY)

PERSONNEL

REFERENCE NO. A8

SHEET OF

NOTES NIESE

DATE 12/12/22

ROUTE US 6

H.C. NIESE

WEATHER FAIR

COUNTY HENRY

R.C. NIESE

TEMP. 77°

TOWNSHIP RIDGEVILLE

SECTION 34

DWG BY BARRIERE

PID 101274

T 6 N R 5 E

TYPE MONUMENT MONBOX W/ 1" IPIN

ON SURFACE - BELOW ON

OFFSET $\text{\textcircled{C}}$ PAVEMENT ON LT : RT

 TO EDGE PAVEMENT

STATION: 180+59.34

HORZ. DATUM: NAD83 2011


GEOID: 18

GRID: NORTHING: 651844.644

EASTING: 1481623.278

LDP: NORTHING:

EASTING:

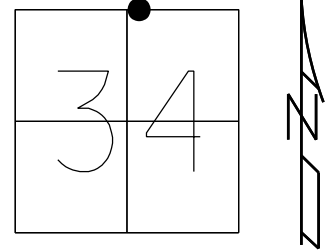

RECORD: P.C.
STA. 180+59.34
PER HEN-6-0.00 (2021)
PID 101274 PLANS

FD MAG NAIL
REF A8
7/7/21, DSA
FD MONBOX W/ 1" IPIN
NEW REF A8
12/12/22, TDN

