

O.D.O.T. DISTRICT 2 SURVEY OFFICE (USE ONLY)

PERSONNEL _____ REFERENCE NO. 26 A SHEET 18 OF 37

NOTES O'DONNELL DATE 10/2/17 ROUTE US 6
 H.C. LEU WEATHER SUNNY COUNTY HENRY
 R.C. FARKAS TEMP. 56° TOWNSHIP FREEDOM
 _____ SECTION 32
 _____ T 6 N R 6 E

TYPE MONUMENT MAG/WASHER


ON SURFACE - ~~BELOW~~ ON _____

~~LEFT~~ - CL PAV'T - RIGHT 0.6'


12.6' TO LT EDGE PAVEMENT

S.L.M. 371+01.33

Grid: Northing: 647036.269 Easting: 1499979.830

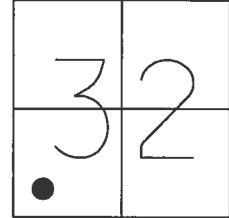

RECORD: P.O.T.
 STA. 370+81.14
 FD LG.R.R.SPIKE
 4" DOWN
 9/5/00, MB
 SET P.K./WASHER
 11/03/00, MDB
 FD LG.R.R.SPIKE
 6" DOWN
 SR6-REFA26
 3/8/16, JFO
 SET MAG/WASHER
 10/2/17, JFO

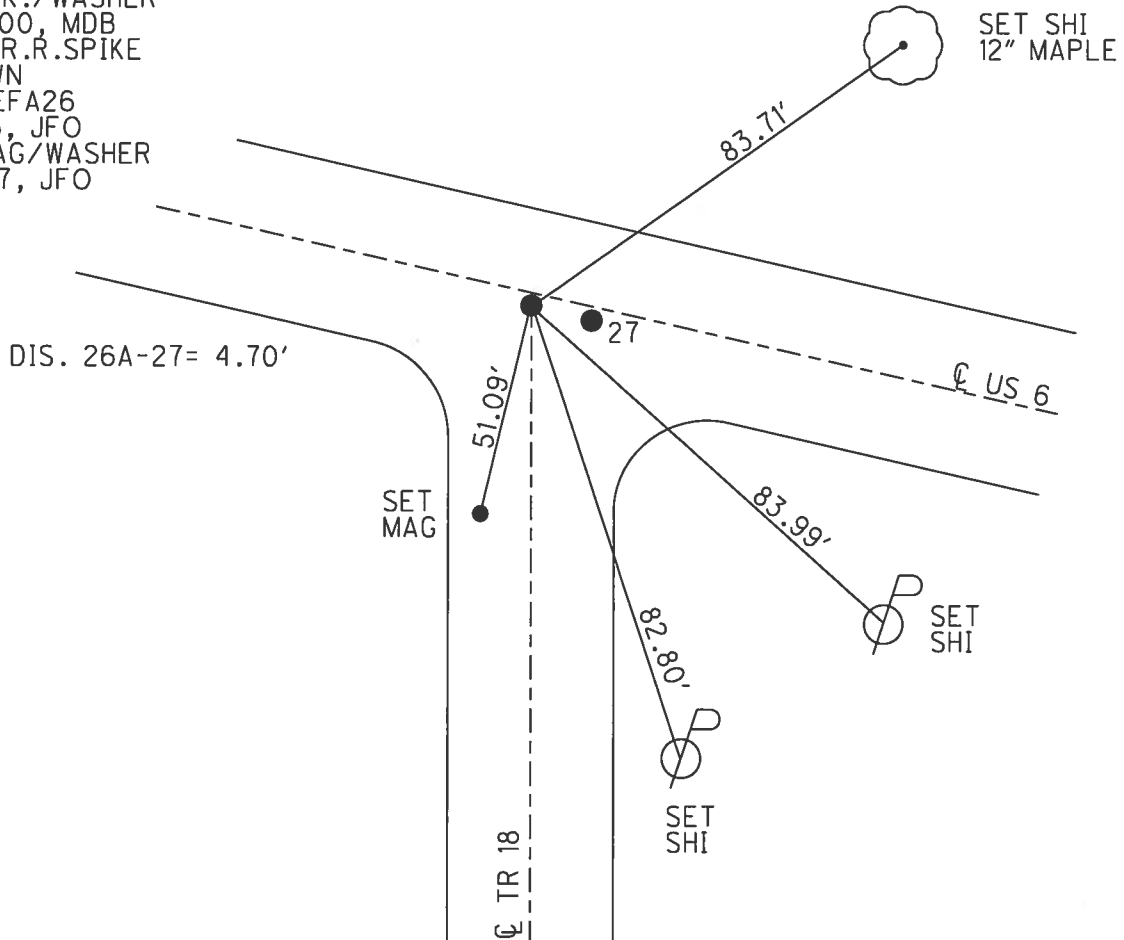

O.D.O.T. DISTRICT 2 SURVEY OFFICE

PERSONNEL

REFERENCE NO. 27

SHEET 17 OF 35

NOTES BARNHISEL

H.C. MOSEK

R.C. CORDES

HUSS F

Rousos F

DATE 9-5-00

WEATHER cloudy

TEMP. +65°

ROUTE US 6

COUNTY HENRY

TOWNSHIP FREEDOM

SECTION 32

T 6 N R 6 E


TYPE MONUMENT BOTH Lg RR Spk's

~~ON SURFACE~~ - BELOW BOTH 4"

~~LEFT - & PAV'T.~~ - RIGHT BOTH 0.5'


BOTH 12.6' TO LT EDGE PAVEMENT

S.L.M. 369+93 369+98

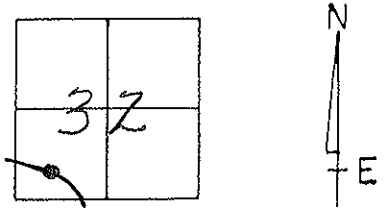

Record: POT = Sta. 370+81.14
 PT "A" Record: PI = Sta. 370+85.82
 PT "B" Record: PI = Sta. 370+85.82
 Δ = 0°-03'-45" RT

Reset PK's/Washers
 11-03-00
 MDB

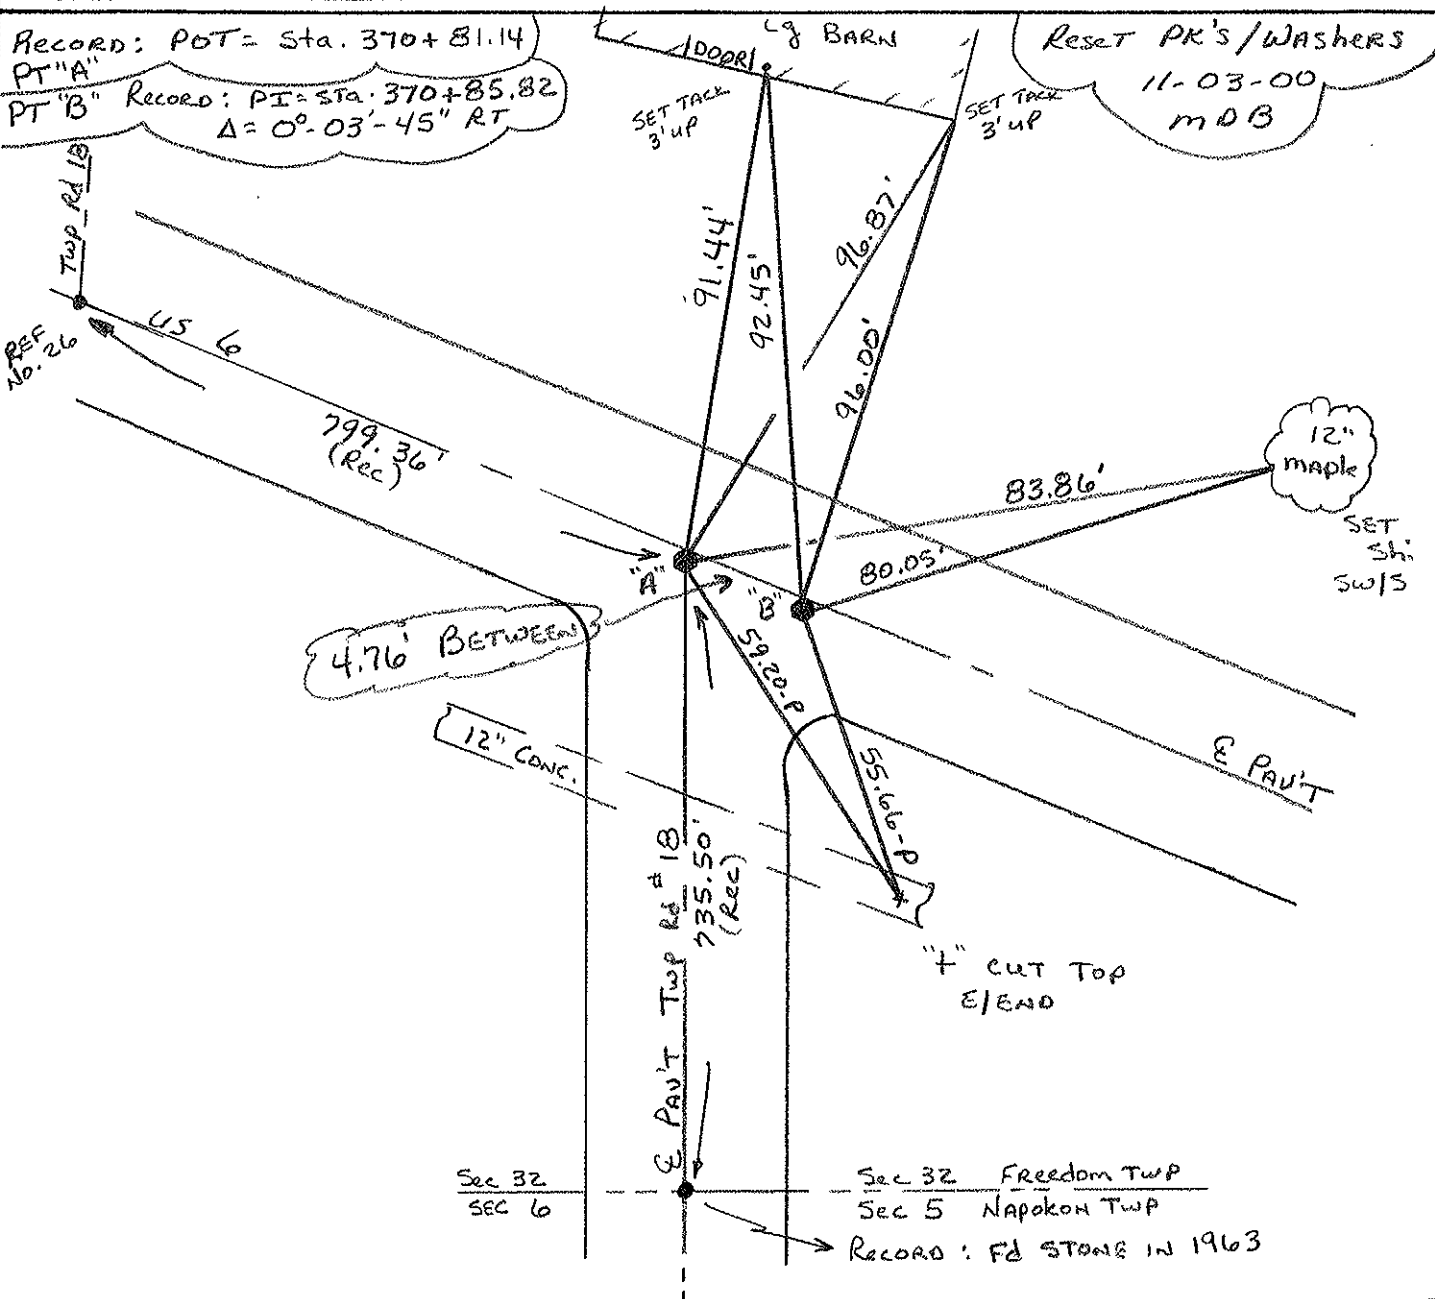

Sec 32
 SEC 6

Sec 32 Freedom TWP
 Sec 5 NAPOKON TWP

Record: Fd STONE IN 1963

PERSONNEL TITLE PERSONNEL TITLE

Red Beach
W. Krape

COUNTY HENRY

DATE 12/15 Apr '77

S. R. US 6


WEATHER

SEC. 32 Freedom Twp. TEMP

DESCRIPTION

CONTROL POINTS

JOB NO.

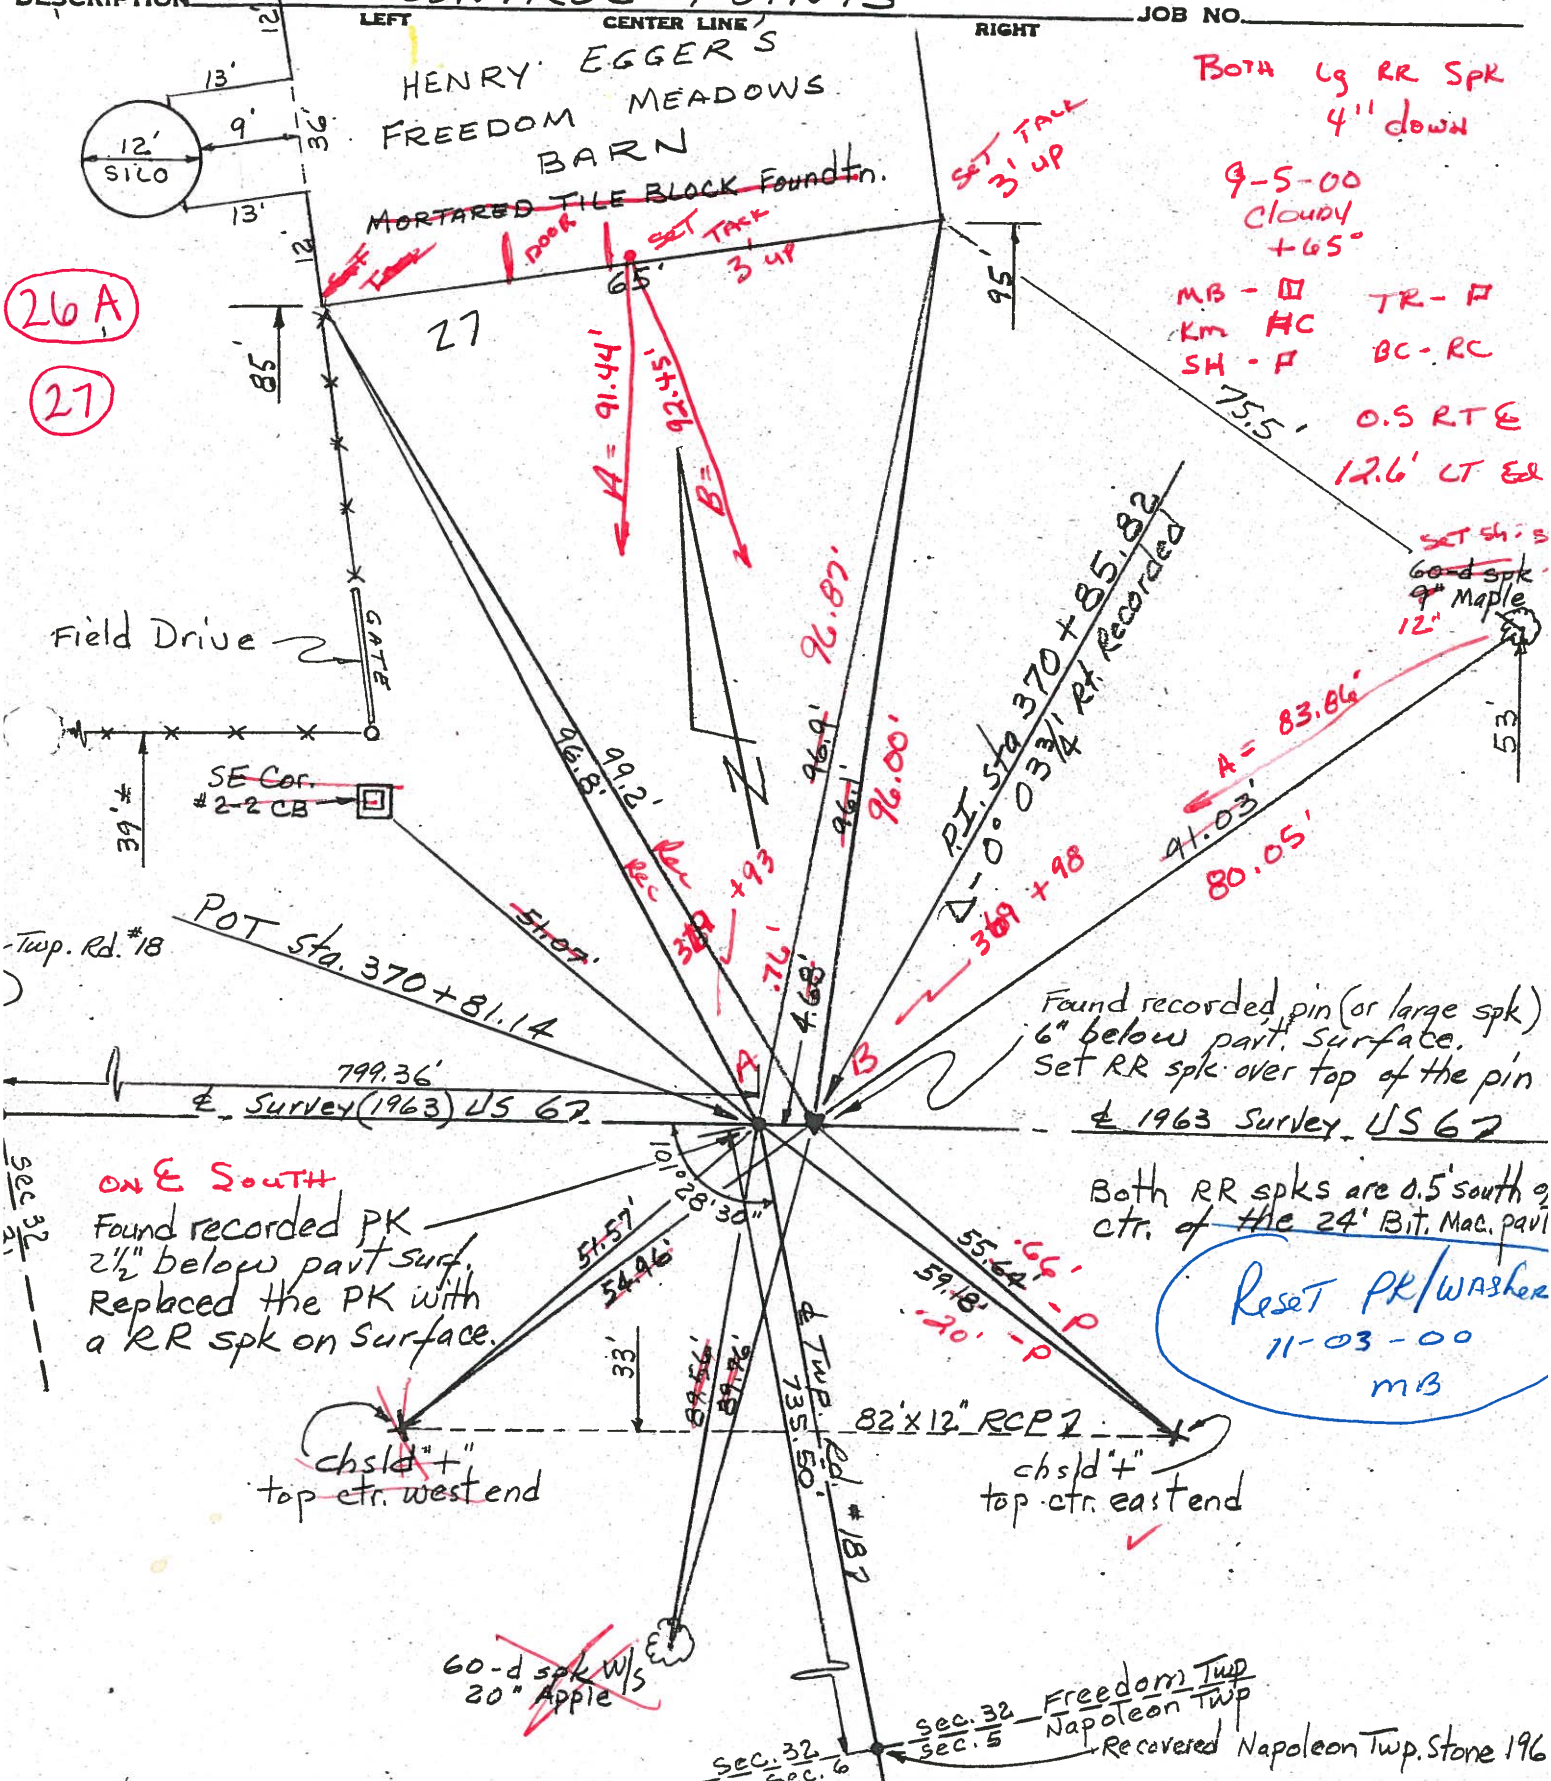

26 A
27

Both lg RR Spk
4" down
9-5-00
cloudy
+65°
MB - □ TR - □
KM HC BC - RC
SH - □
O.S RTE
12.6' LT Ed

SET sh. S
60-d spk
9" Maple
12"
53'

Found recorded pin (or large spk)
6" below part. surface.
Set RR spk over top of the pin
1963 Survey US 67

Both RR spks are 0.5' south of
ctr. of the 24' Bit. Mac. pavi
Reset PR/Washer
11-03-00
MB

ON E SOUTH
Found recorded PK
2 1/2" below part surf.
Replaced the PK with
a RR spk on surface.

chsd "+"
top ctr. west end
82'x12" RCP 1
chsd "+"
top ctr. east end

60-d spk w/ 20" Apple

sec. 32 Freedom Twp
sec. 5 Napoleon Twp
Recovered Napoleon Twp. Stone 196