

O.D.O.T. DISTRICT 2 SURVEY OFFICE (USE ONLY)

PERSONNEL

REFERENCE NO. 37

SHEET 40 OF 47

NOTES BARNHISEL

DATE 9/8/00

ROUTE US 6

H.C. MOSER

WEATHER SUNNY

COUNTY HENRY

R.C. CANTERBURY  
HUSS

TEMP. 75°

TOWNSHIP NAPOLEON

DWG BY NIESE PID \_\_\_\_\_

SECTION 14

T 5 N R 6 E

TYPE MONUMENT MONBOX W/ 1" IPIN

ON SURFACE - ~~BELOW~~ ON

OFFSET 14.0' LT : ~~RT~~

15.4' TO LT EDGE PAVEMENT OF RAMP



STATION: 575+94

HORZ.DATUM: \_\_\_\_\_

GEOID: \_\_\_\_\_

GRID: NORTHING: \_\_\_\_\_

EASTING: \_\_\_\_\_

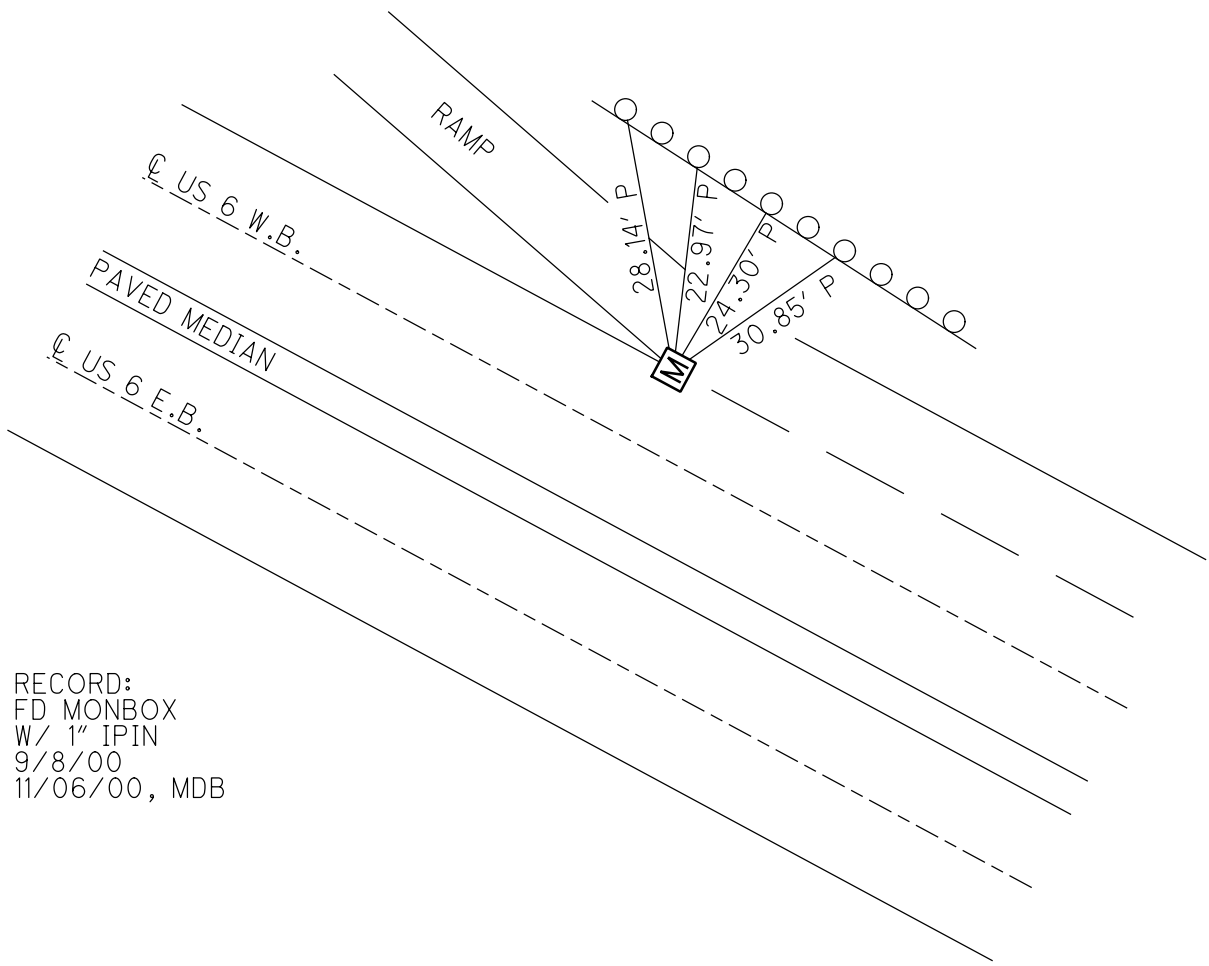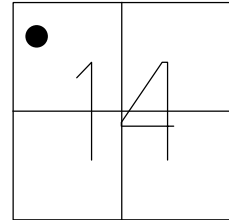

RECORD:  
FD MONBOX  
W/ 1" IPIN  
9/8/00  
11/06/00, MDB

# O.D.O.T. DISTRICT 2 SURVEY OFFICE

PERSONNEL \_\_\_\_\_

REFERENCE NO. 37

SHEET 35 OF 35

NOTES BARNHISEL

H.C. MOSEL

R.C. CANTERBURY

HUSS P

DATE 9-8-00

WEATHER SUNNY

TEMP. +75°

ROUTE US 6


COUNTY HENRY

TOWNSHIP NAPOLEON


SECTION 14

T 5 N R 6 E

TYPE MONUMENT 1" I. PIN IN MON. BOX  
 ON SURFACE - ~~BELOW~~ yes  
 LEFT- & PAV'T. - ~~RIGHT~~ 14' LT OF E W-B LANES  
15.4' TO LT EDGE PAVEMENT OF RAMP  
 S.L.M. 575+94

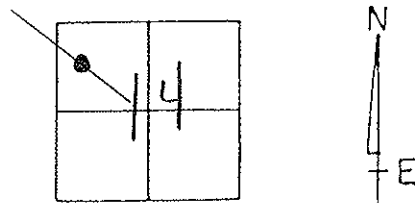

MON. BOX RAISED  
 11-06-00  
 MDB

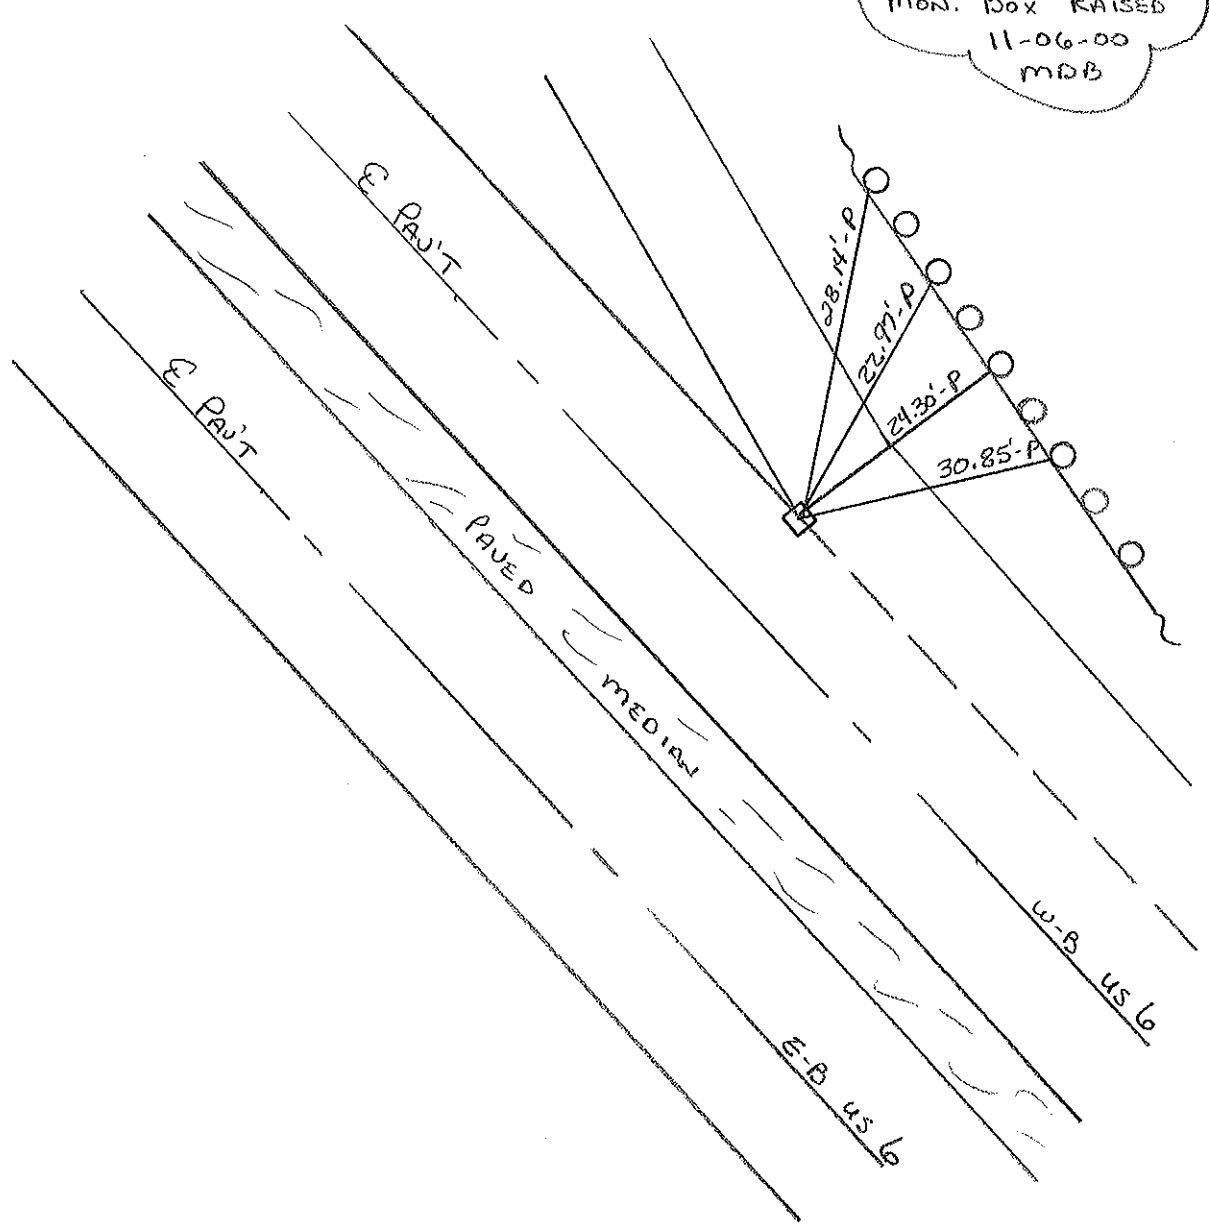

# O.D.O.T. DISTRICT 2 SURVEY OFFICE

PERSONNEL \_\_\_\_\_ REFERENCE NO. \_\_\_\_\_ SHEET \_\_\_\_\_ OF \_\_\_\_\_

NOTES HOFFMAN

H.C. LOENZKE DATE 9-8-00

R.C. BARNHILL WEATHER Clear

TEMP. 65°

ROUTE US 6

COUNTY Henry

TOWNSHIP Napoleon

SECTION 14

T S N R G E


TYPE MONUMENT 1" IRON Pin - Mon. Box

~~ON SURFACE - BELOW~~ 2" SURFACE


~~LEFT - & PAV'T. - RIGHT~~ ON EDGE 14' CTE

15.4' TO RT EDGE PAVEMENT (RAMP)

S.L.M. Plan Sta = 592+00 575+94

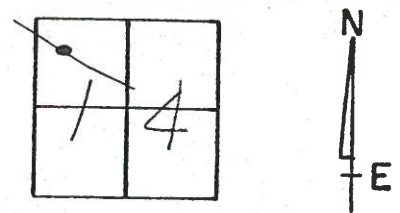

Box WAS Dug out & OPENED.

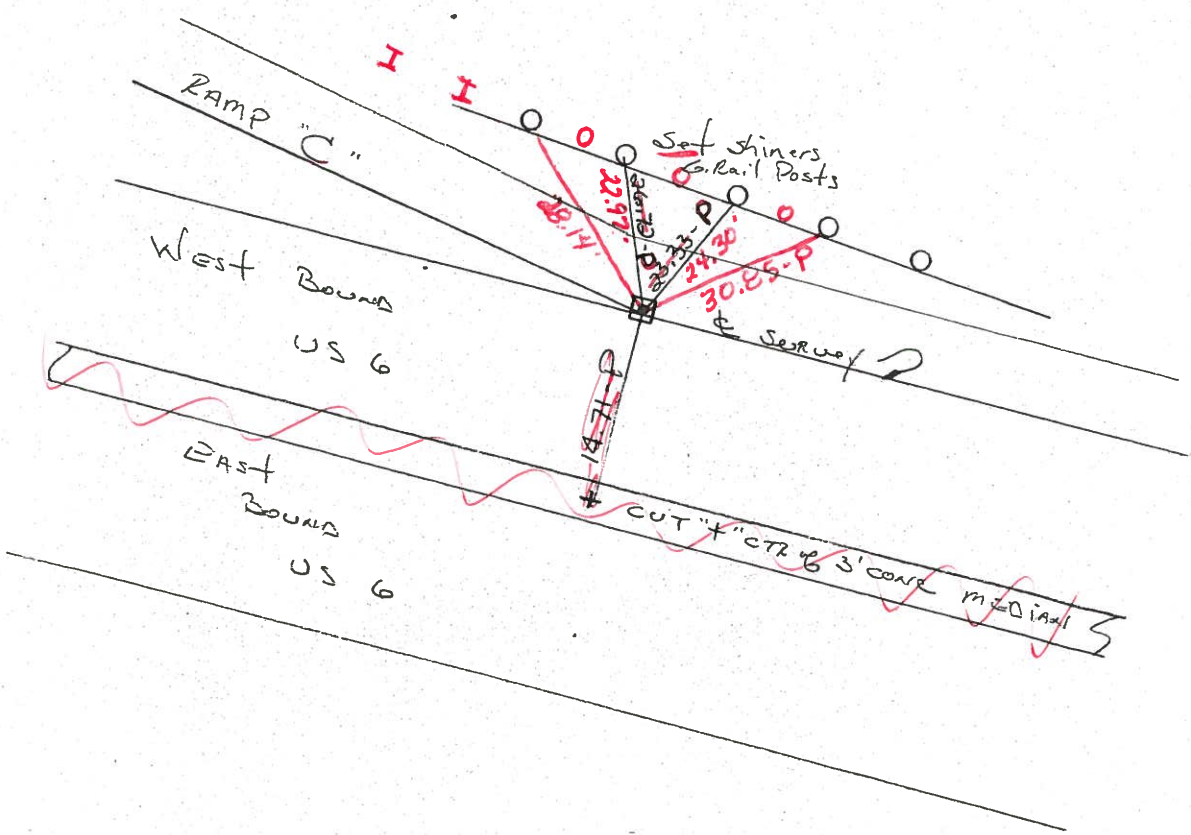

# O.D.O.T. DISTRICT 2 SURVEY OFFICE

PERSONNEL \_\_\_\_\_

REFERENCE NO. \_\_\_\_\_

SHEET \_\_\_\_\_ OF \_\_\_\_\_

NOTES HOFFMAN

H.C. LOSHKOE

R.C. BARNHISEL

DATE 4-26-88

WEATHER CLEAR

TEMP. 65°

ROUTE US 6

COUNTY Henry

TOWNSHIP Napoleon

SECTION 14

T 5 N R 6 E

TYPE MONUMENT IRON Pin - Mon. Box


~~ON SURFACE~~ - BELOW 2"

~~LEFT - & PAV'T.~~ - RIGHT ON EDGE

TO EDGE PAVEMENT

S.L.M. PLAN Sta = 592+00

37

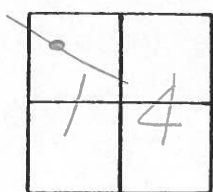

Box WAS Dug out & OPENED.

