


| PERSONNEL | TITLE | PERSONNEL | TITLE |
|-----------|-------|-----------|-------|
| Tomsic    |       |           |       |
| Neuser    |       |           |       |
| Granata   |       |           |       |

COUNTY HEN. DATE Dec. 10, 1975

S. R. U.S. 24 WEATHER P. Cloudy

SEC. \_\_\_\_\_ TEMP. 38°

DESCRIPTION \_\_\_\_\_ LEFT \_\_\_\_\_ CENTER LINE \_\_\_\_\_ RIGHT \_\_\_\_\_ JOB NO. \_\_\_\_\_

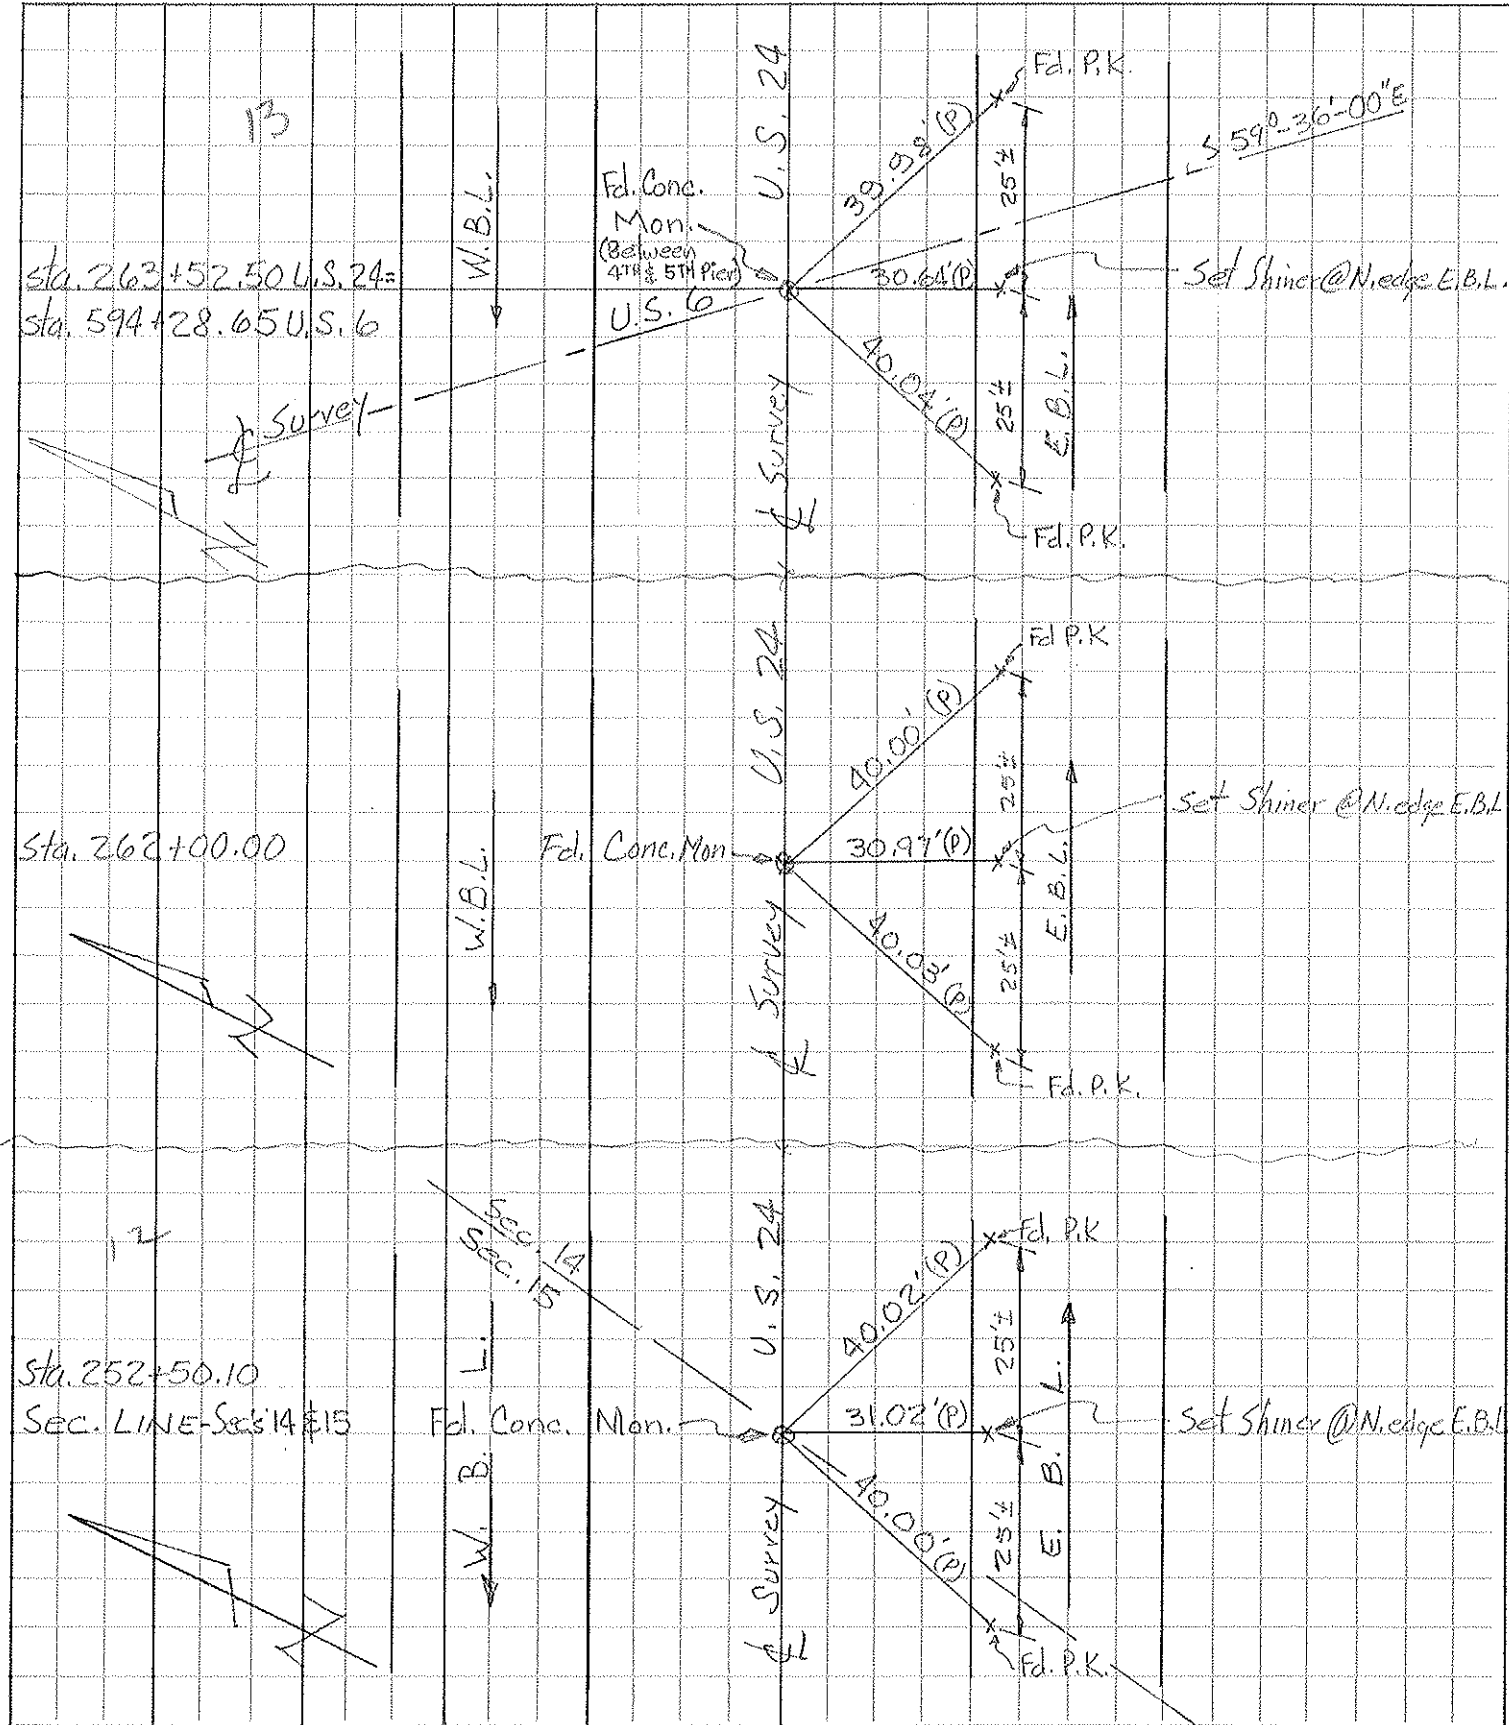

PERSONNEL TITLE PERSONNEL TITLE

Red Beach  
Armbruster  
Knappe  
Mohler

COUNTY Henry

DATE 16 June 64

S. R. US #6

WEATHER

SEC.

TEMP.

DESCRIPTION

JOB NO.

LEFT

CENTER LINE

RIGHT

- Found Recorded Iron Rods
- Found Recorded Iron Pipes
- x Recorded Points Gone

