

PERSONNEL TITLE PERSONNEL TITLE

Bruster
Beacher
Moehler
Knapper

COUNTY Henry DATE Dec. 1964

S. R. US # 424 Bypass WEATHER





SEC. Zahrend's Interchq TEMP.

DESCRIPTION CONTROL POINTS JOB NO.

LEFT

CENTER LINE

RIGHT

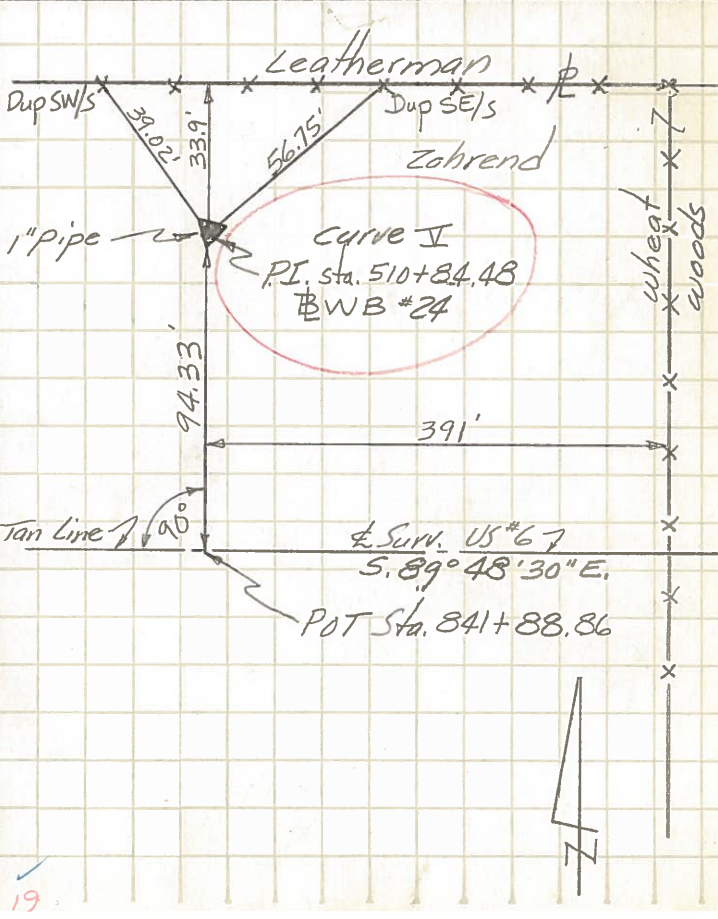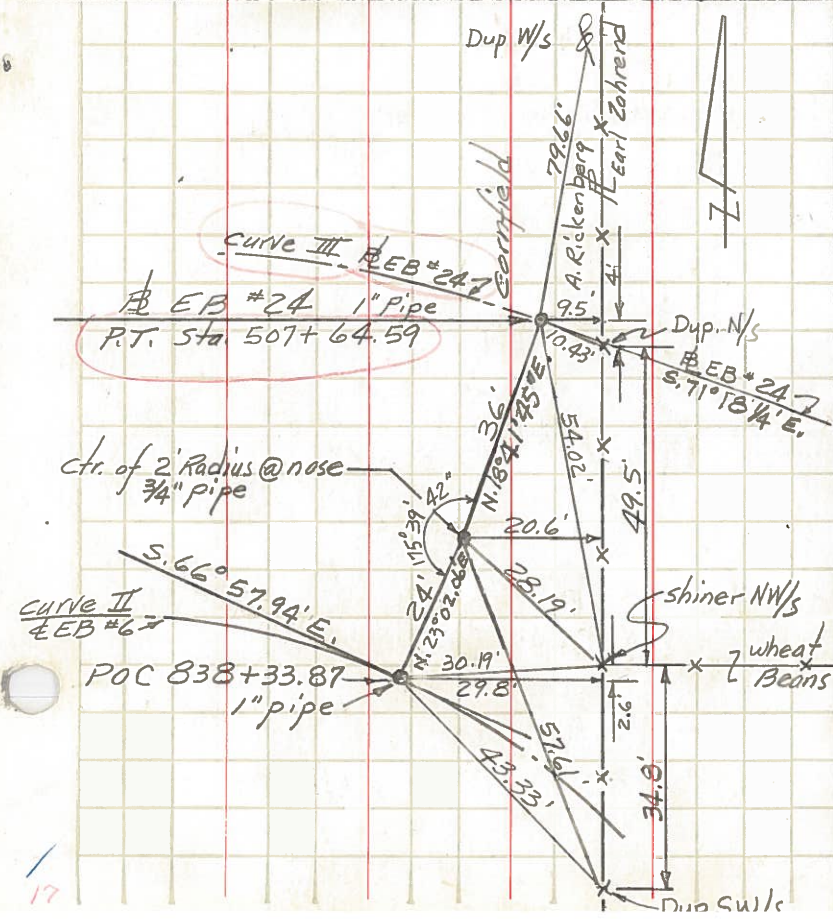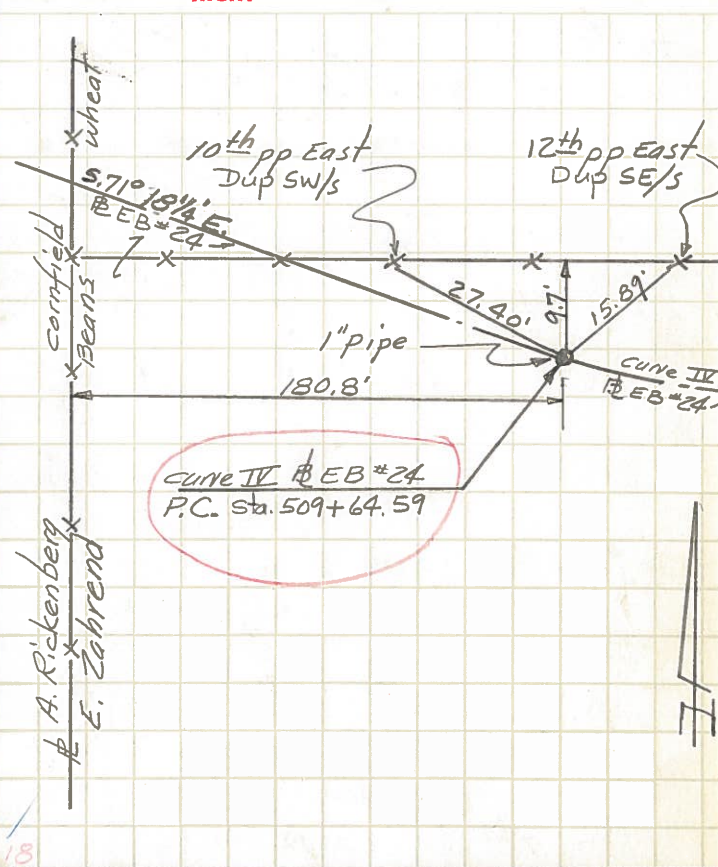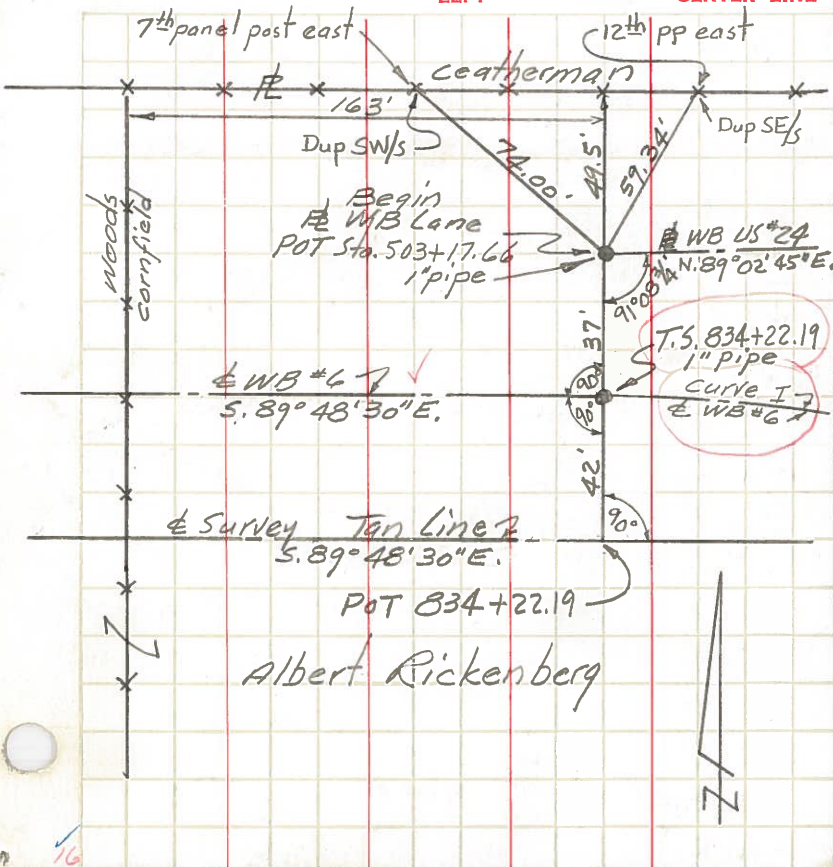

PERSONNEL TITLE PERSONNEL TITLE COUNTY HENRY DATE Jan 1965
 S. R. US # 424 Bypass WEATHER
 SEC. Zahrend's Interchg. TEMP.
 CONTROL POINTS JOB NO.

Bruster
 Beacher
 Moehler
 Knapper
 Trotter

