
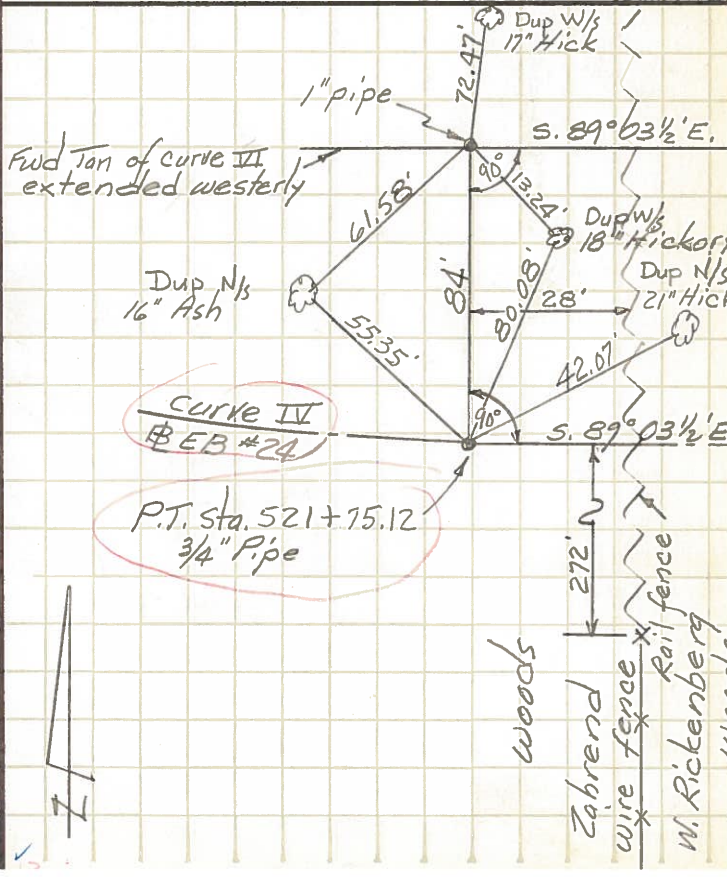
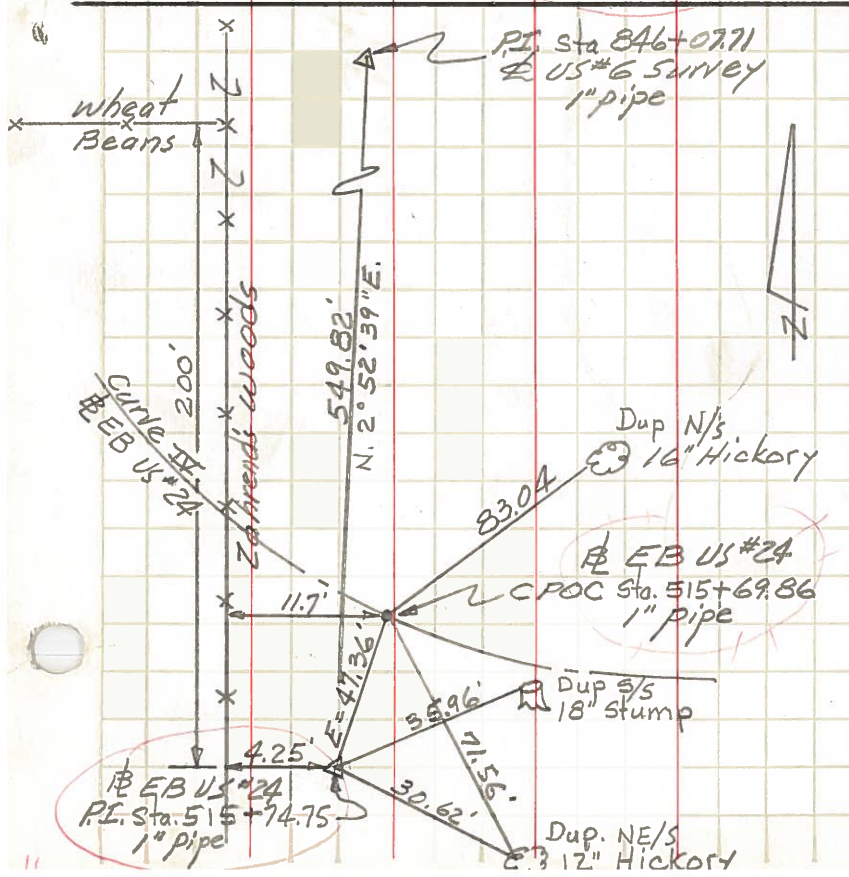
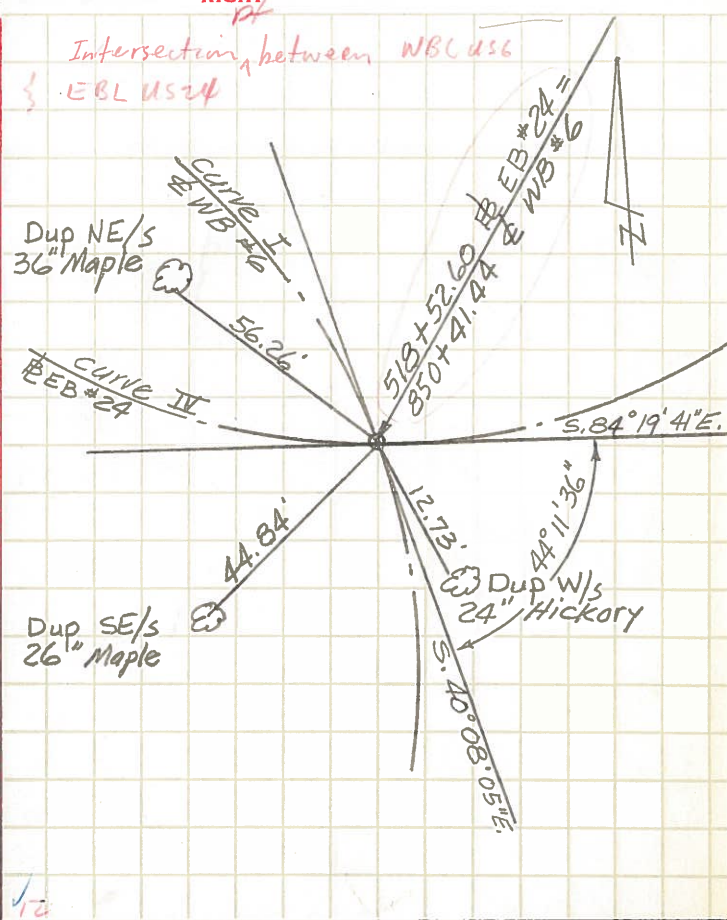


PERSONNEL Bruster TITLE _____ PERSONNEL Beacher TITLE _____ COUNTY HENRY DATE Dec. 1964
 PERSONNEL Moehler TITLE _____ S. R. US # 1/24 Bypass WEATHER _____
 PERSONNEL Knapper TITLE _____ SEC. Zahrend's Interchg TEMP. _____

DESCRIPTION _____ CONTROL POINTS _____ JOB NO. _____

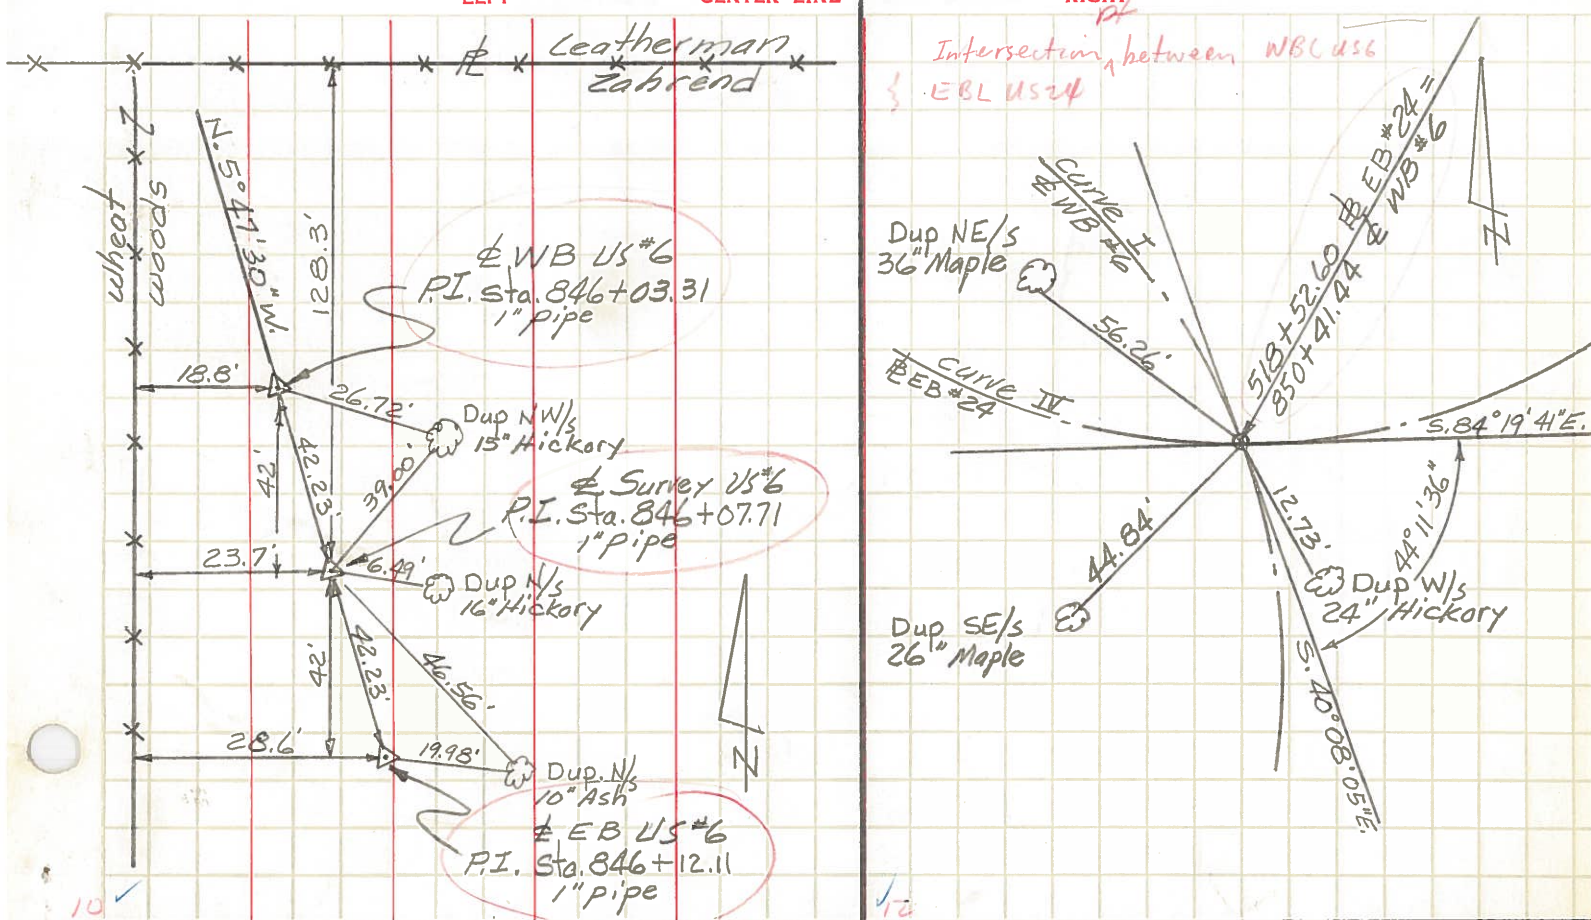

PERSONNEL TITLE PERSONNEL TITLE


Bruster
Beacher
Moehler
Knapper
Tretter

COUNTY HENRY DATE Jan 1965

S. R. US #424 Bypass WEATHER

SEC. Zahrend's Interchg TEMP.

DESCRIPTION CONTROL POINTS JOB NO.

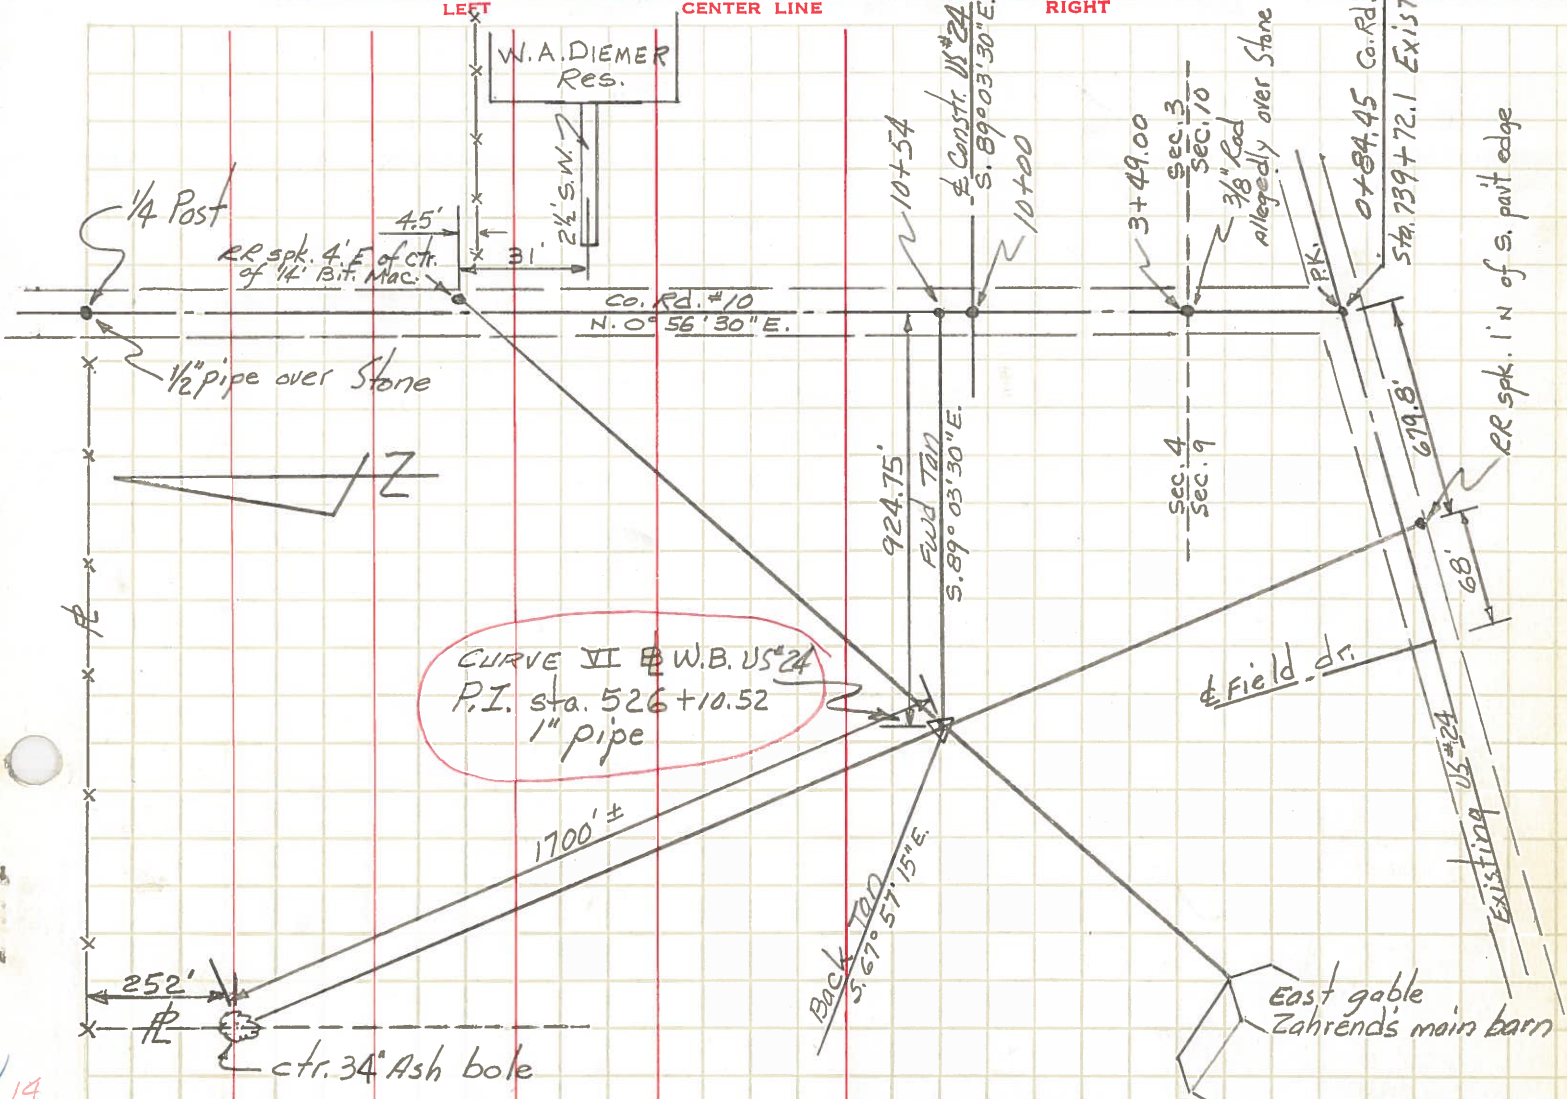

Witnesses for bridge coring crew

