


PERSONNEL	TITLE	PERSONNEL	TITLE
BURNSIDE		BAGDONAS	
SMITH			
BOWERS			
KNOWSKI			

COUNTY HENRY DATE 6-21-73
 S. R. U.S. 6 WEATHER CLEAR
 SEC. _____ TEMP. +80

DESCRIPTION 5/4 Post Sec. 22 HARRISON Twp JOB NO. _____
 LEFT CENTER LINE RIGHT

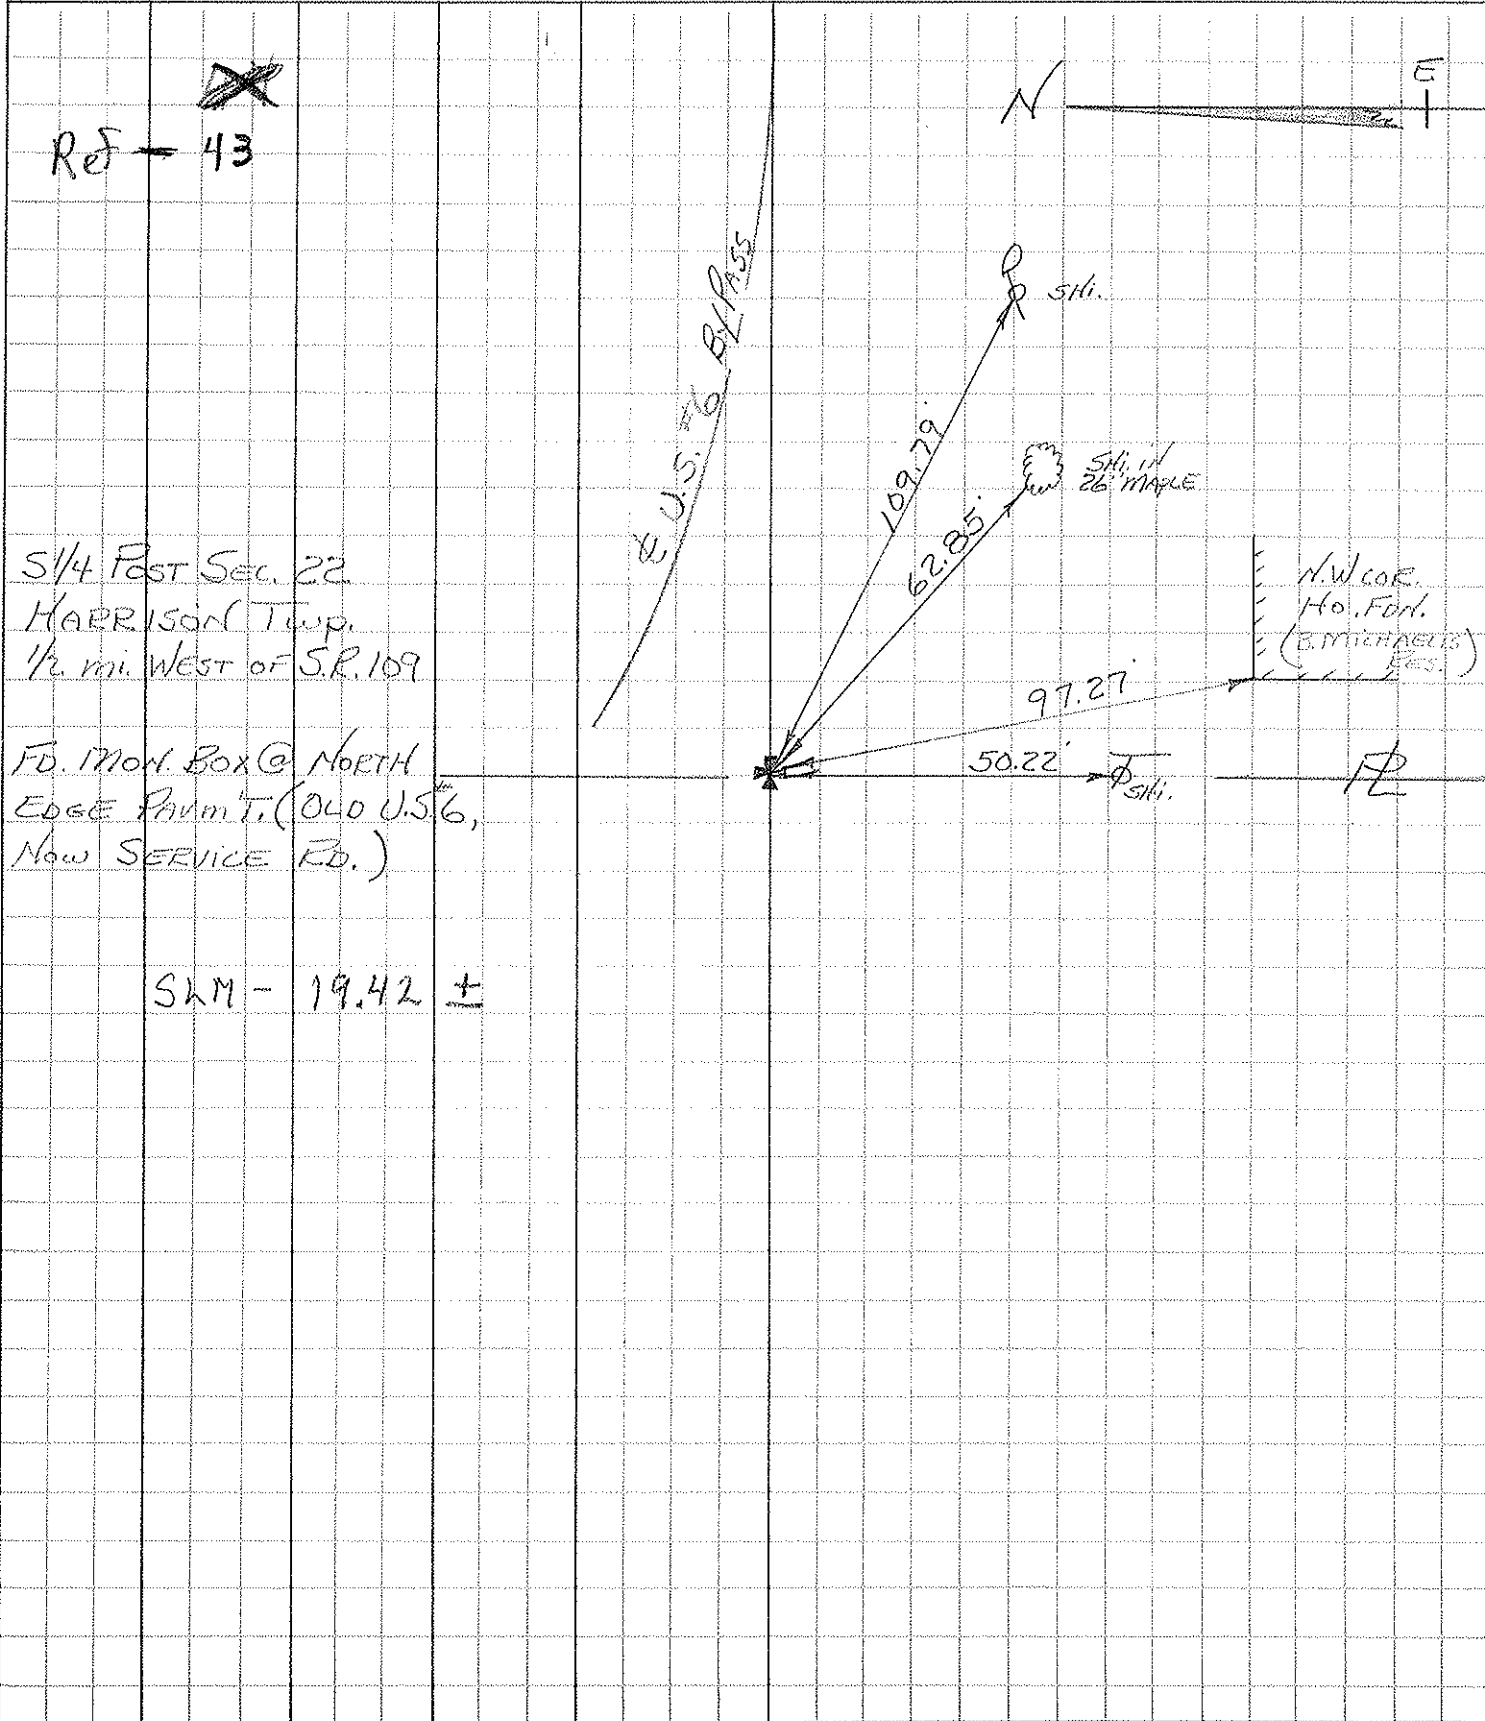






PERSONNEL TITLE PERSONNEL TITLE
Beach

COUNTY Henry DATE 2 Oct 1961

S. R. US#6 WEATHER _____

SEC. Harrison Twp TEMP. _____

DESCRIPTION CONTROL POINTS US#6 RW JOB NO. _____

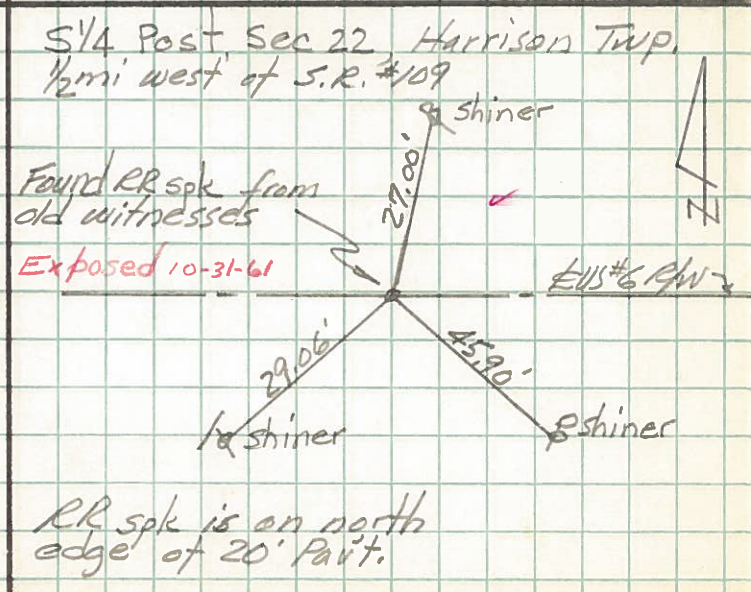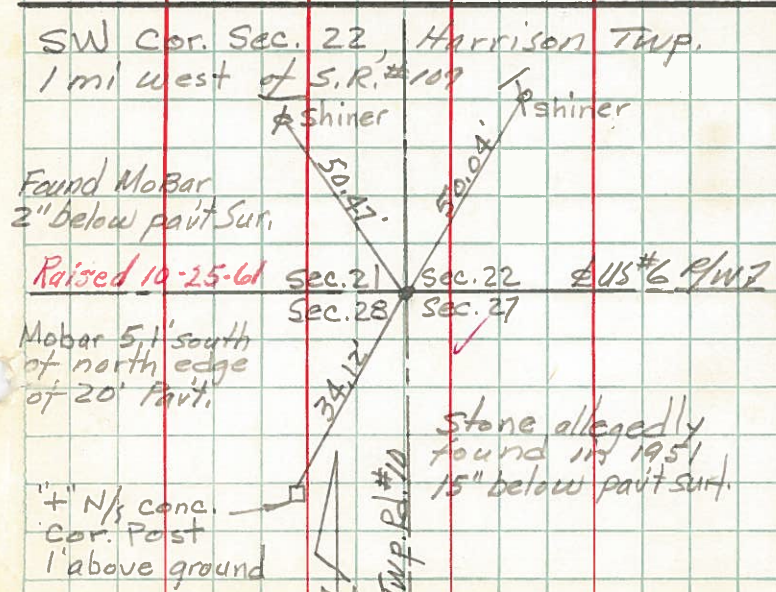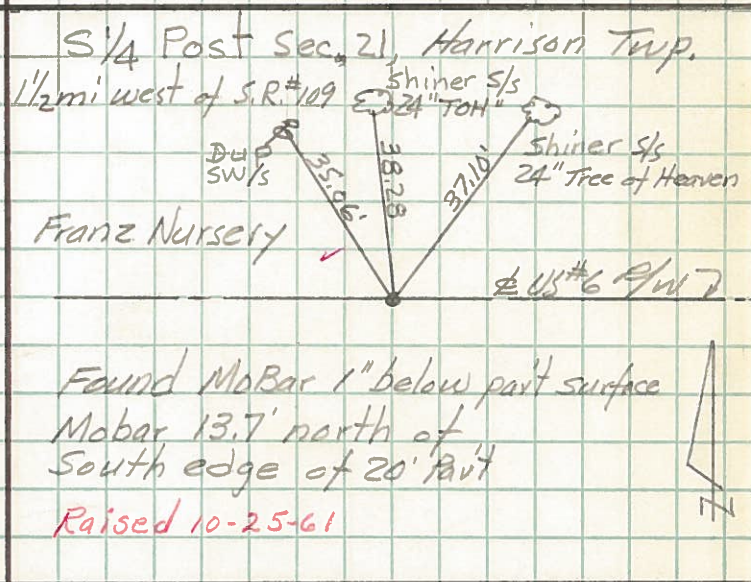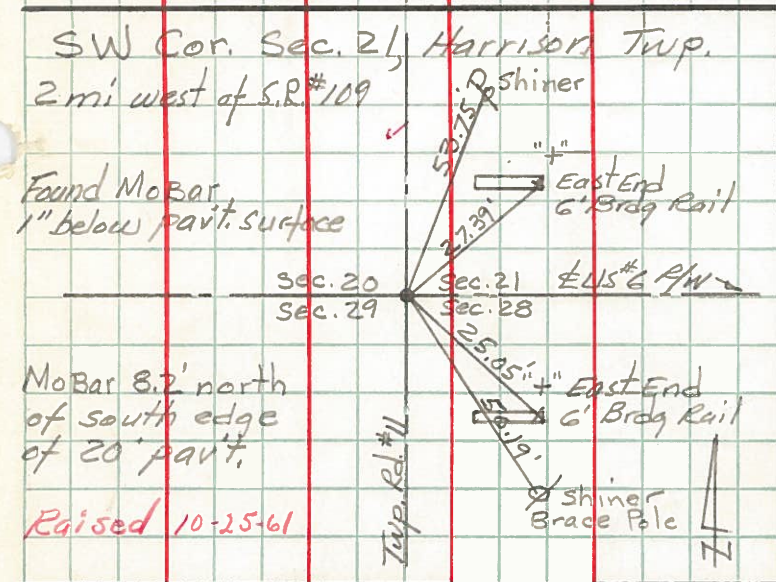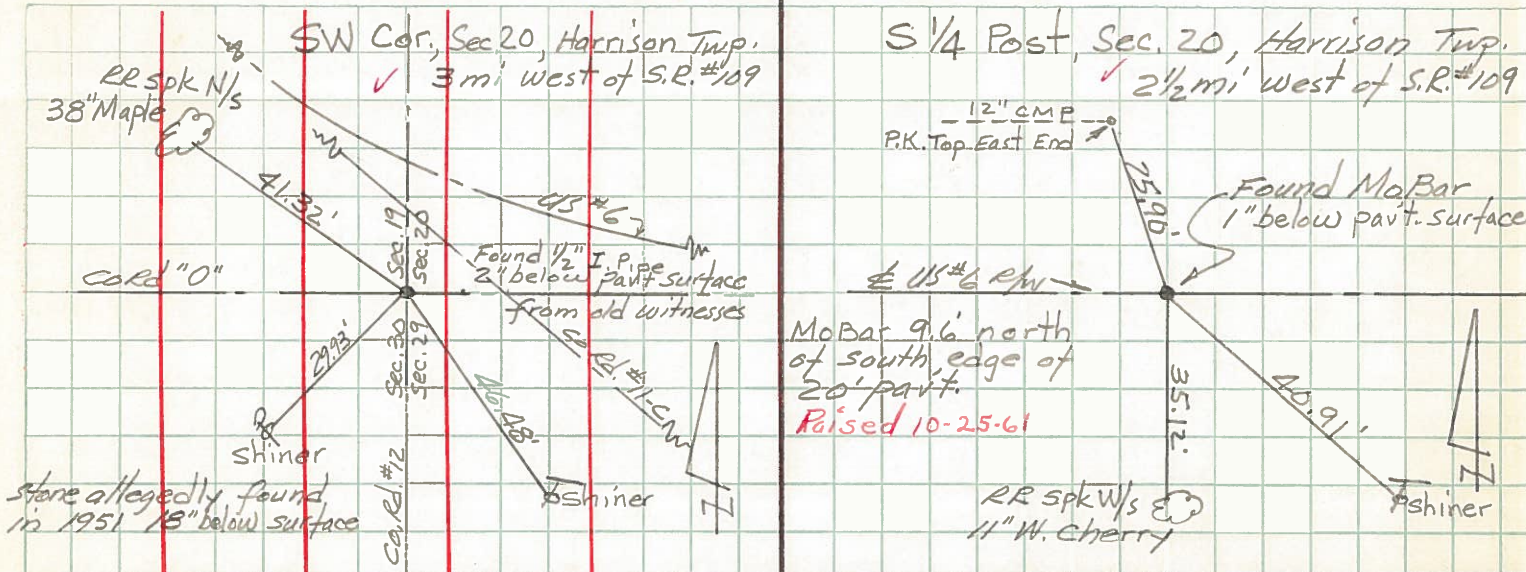


PERSONNEL TITLE PERSONNEL TITLE

COUNTY Henry DATE Jan-Feb 1961

Beach
Ambrister
Knappe
Gunter
Mohler

S. R. US#6 & #24 Bypass WEATHER
SEC. Liberty & Harrison Tups TEMP.

DESCRIPTION Survey proposed US#6 & #24 Bypass superimposed on section lines

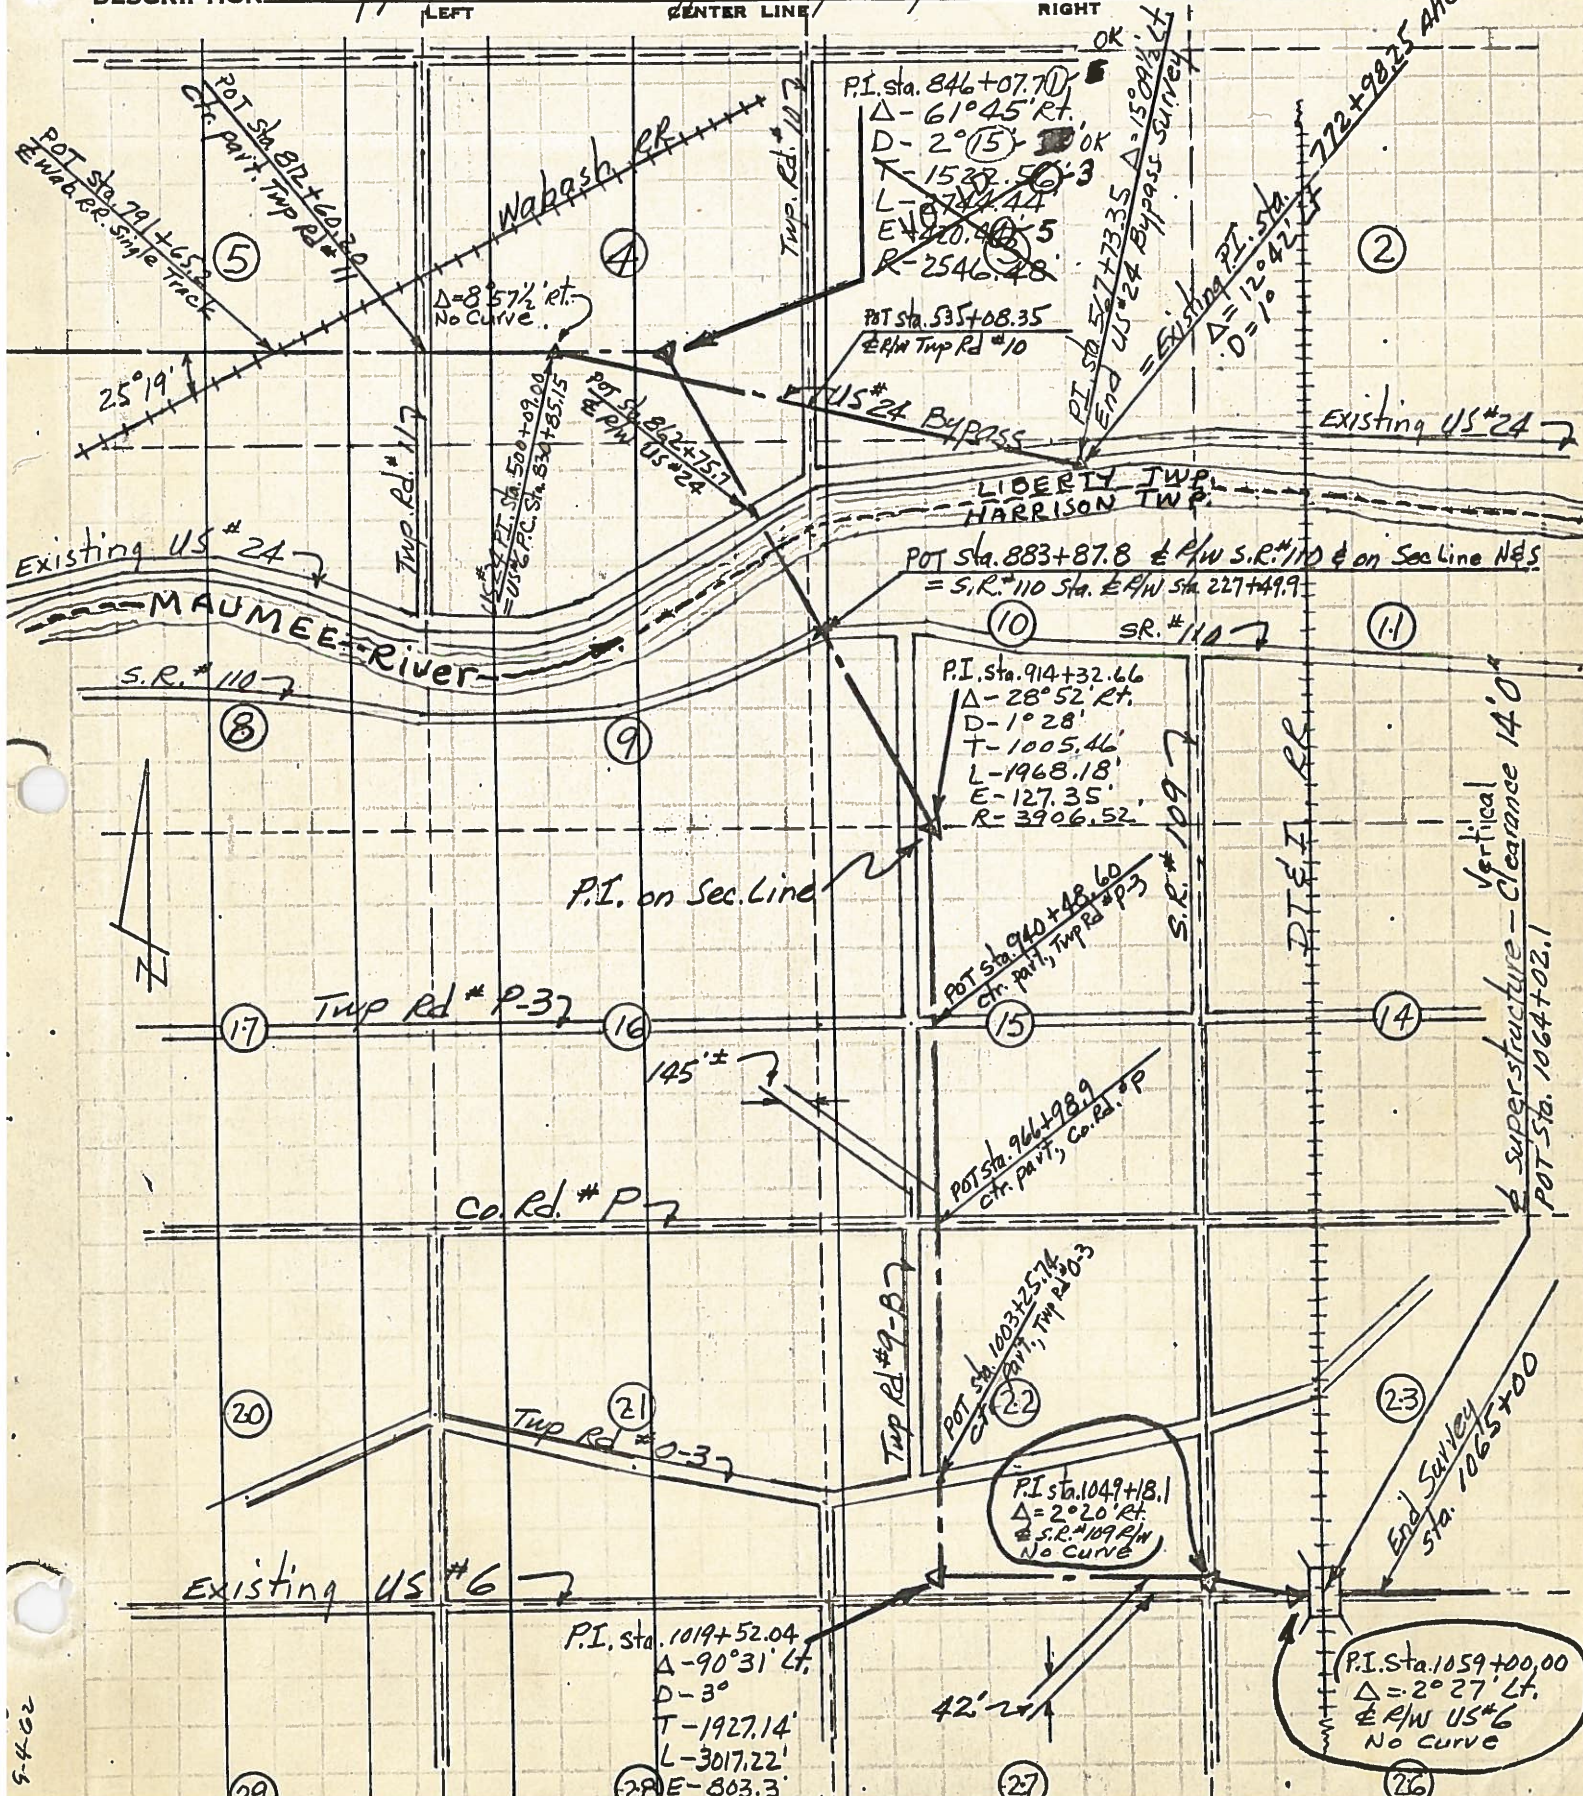

5-4-62