

O.D.O.T. DISTRICT 2 SURVEY OFFICE (USE ONLY)

PERSONNEL _____ REFERENCE NO. 49 SHEET 12 OF 24
 NOTES LEU DATE 4/20/17 ROUTE US 6
 H.C. LEU WEATHER WINDY COUNTY HENRY
 R.C. HELDMAN TEMP. 80° TOWNSHIP DAMASCUS
 SECTION 30
 T 5 N R 8 E

TYPE MONUMENT MAG/WASHER


ON SURFACE - ~~BELOW~~ ON

~~LEFT~~ - ☉ PAV'T - RIGHT 0.8', 3.8' W OF ☉ S


- TO - EDGE PAVEMENT

S.L.M. 1182+75.53

GRID: NORTHING: 624502.6765 EASTING: 1559607.544

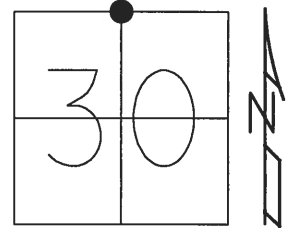


RECORD:
 SET MAG/WASHER
 4-21-03, DCH
 FD MAG NAIL
 REF49
 4-20-17, JLL
 SET MAG/WASHER
 10/26/17, JLL

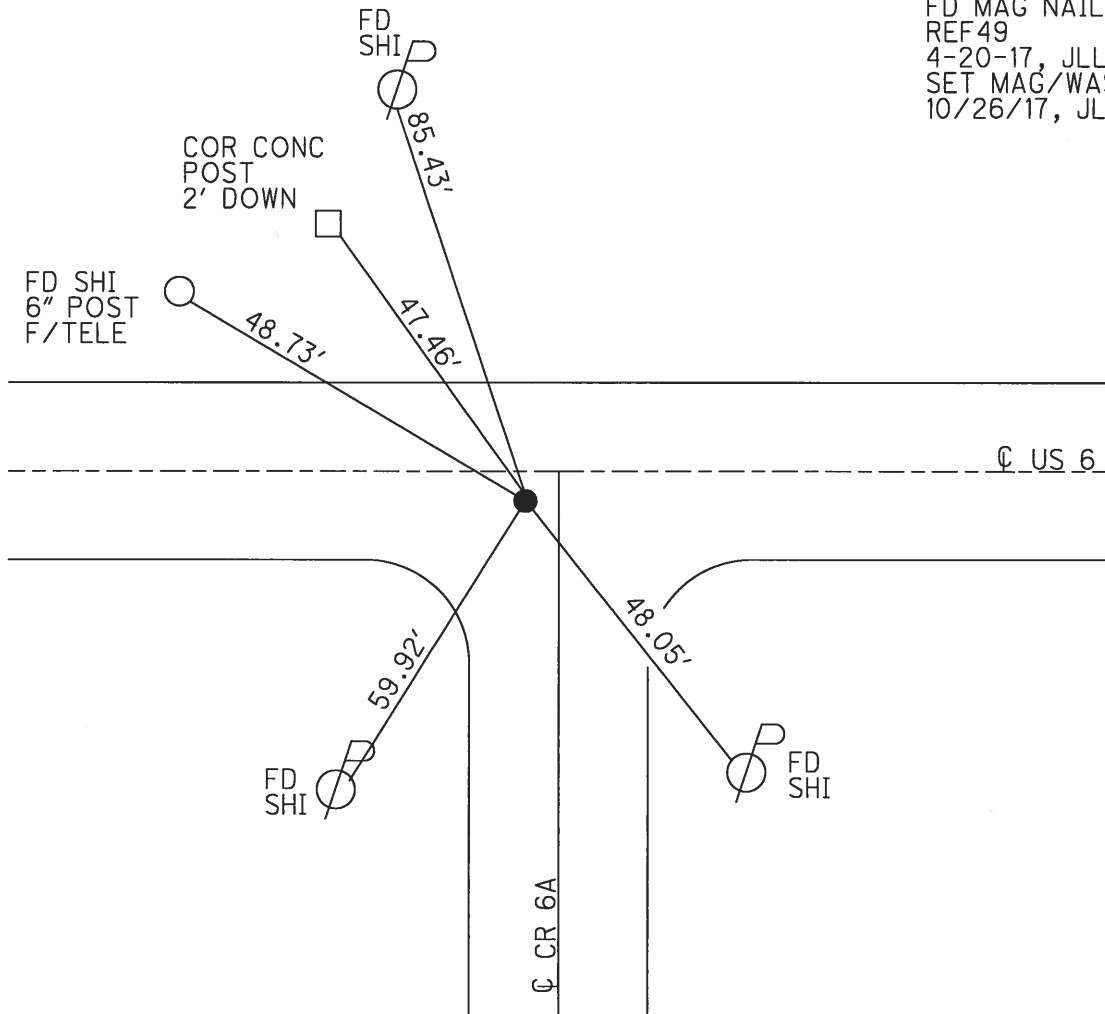

O.D.O.T. DISTRICT 2 SURVEY OFFICE (USE ONLY)


PERSONNEL	REFERENCE NO.	49	SHEET	6	OF	18
NOTES	HOMAN	DATE	7/18/02	ROUTE	US 6	
H.C.	ROUSOS	WEATHER	SUNNY	COUNTY	HENRY	
R.C.	BEAUMONT	TEMP.	80°	TOWNSHIP	DAMASCUS	
	CHLEBECK			SECTION	30	
				T	5	N
				R	8	E

TYPE MONUMENT SM.R.R.SPIKE
 ON SURFACE - ~~BELOW~~ ON _____
~~LEFT~~ - \odot PAV'T - RIGHT 0.5', 3.8' W OF \odot S
 - TO - EDGE PAVEMENT
 S.L.M. 1185+36

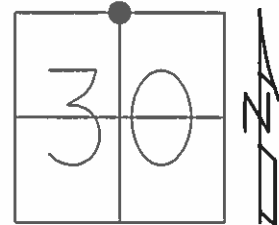

GRID: NORTHING: _____ EASTING: _____

SET MAG/ WASHER
4-21-03, DCH

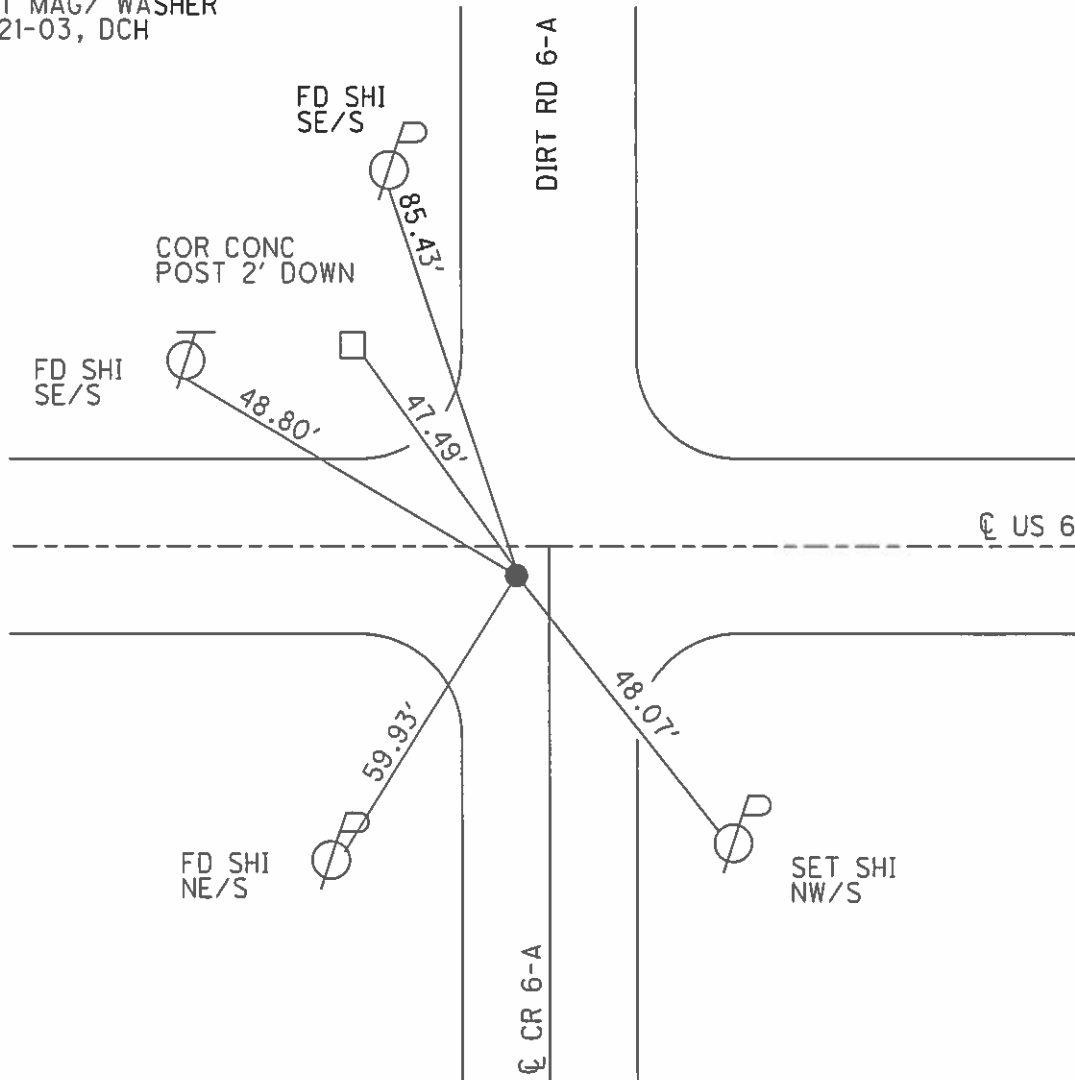

O.D.O.T. DISTRICT 2 SURVEY OFFICE

PERSONNEL

REFERENCE NO. 49

SHEET 6 OF

NOTES HOFFMAN

H.C. BARNHISEL

DATE 4-8-88

ROUTE US 6

R.C. LOSHRKE

WEATHER CLEAR

COUNTY HENRY

TEMP. 40°

TOWNSHIP DAMASCUS

SECTION 30

T.S. N R 8 E

TYPE MONUMENT P.K. Nail

*Set small RR spike
6-20-88 ESK*


ON SURFACE -BELOW YES

LEFT-☉ PAV'T. - RIGHT 0.5


 TO EDGE PAVEMENT 3.8' West of & Pavt

Co. Rd. G-A-5074

S.L.M. 1070+19

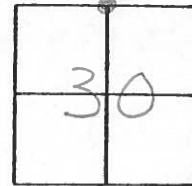

1184+77

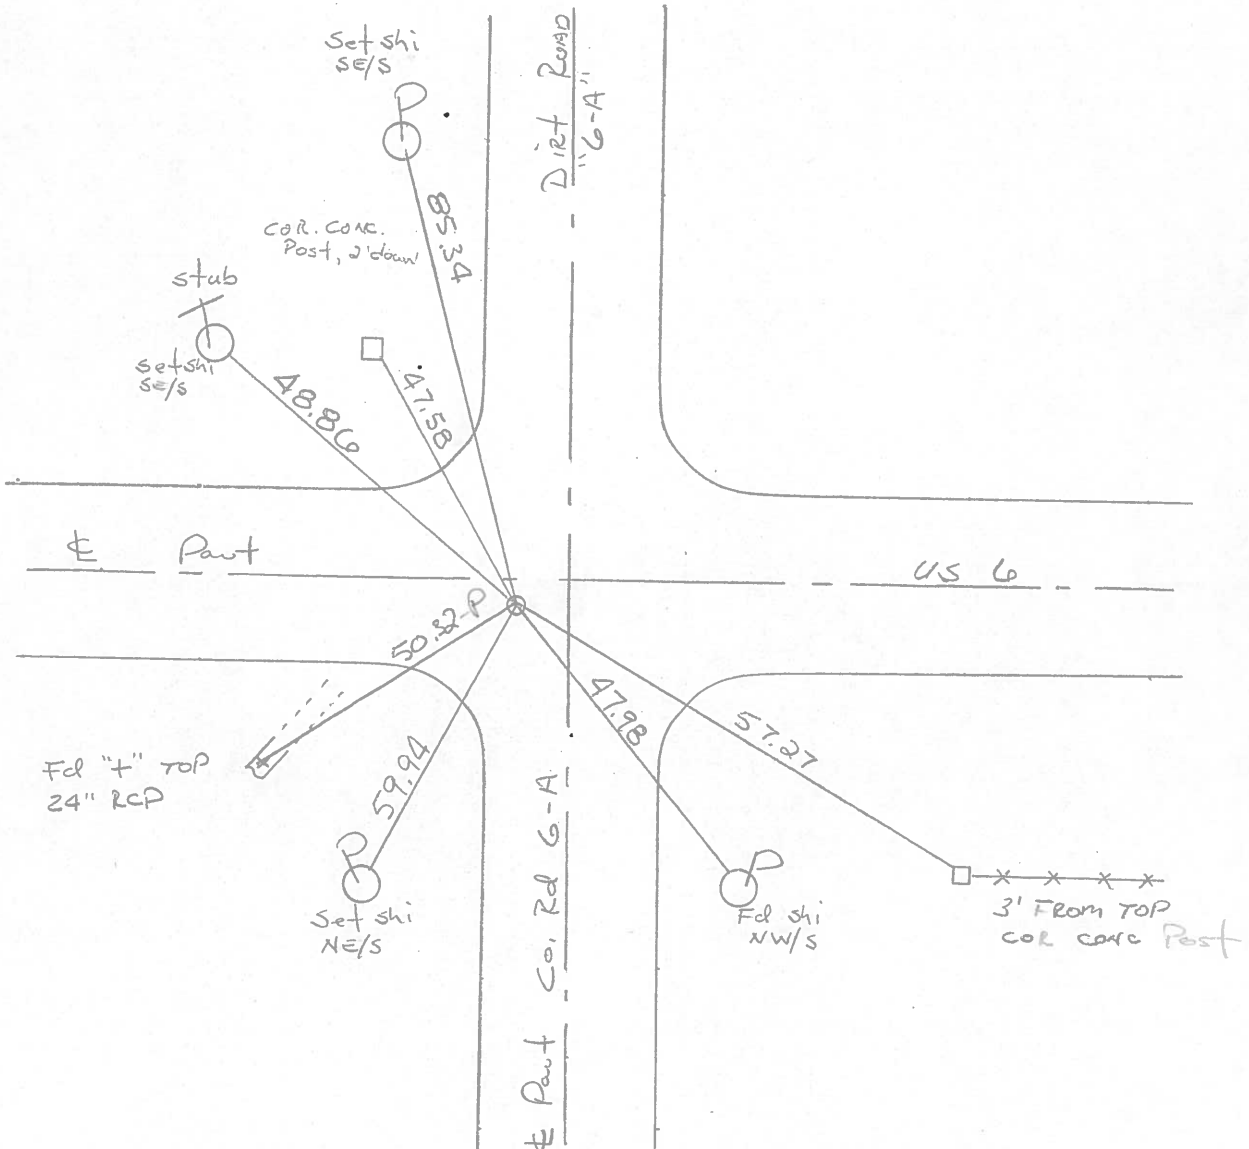


PERSONNEL	TITLE	PERSONNEL	TITLE
<u>BURNSIDE</u>			
<u>SMITH</u>			
<u>BOWERS</u>			
<u>HOLCOMBE</u>			

COUNTY HENRY DATE 5-26-71
 S. R. U.S. #6 WEATHER CLOUDY
 SEC. _____ TEMP. +47°

DESCRIPTION _____ LEFT _____ CENTER LINE _____ RIGHT _____ JOB NO. _____

49

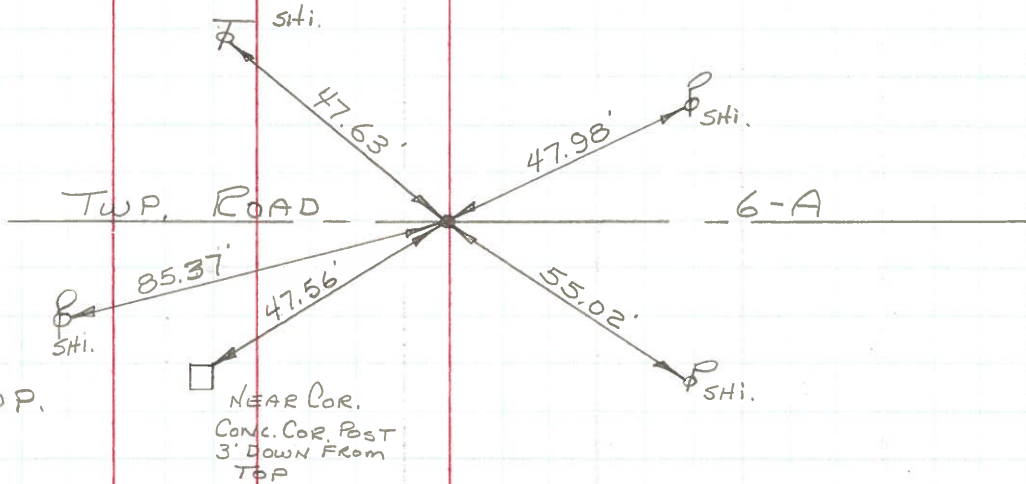

BRASS MON @
 SURFACE
 N. 1/4 COR. SEC. 30
 DAMASCUS TWP.

2K
5-10-72

NEAR COR.
 CONC. COR. POST
 3' DOWN FROM
 TOP

PERSONNEL	TITLE	PERSONNEL	TITLE
Jackson	notes		
Williams			
Metzger			
Robinson			


COUNTY Henry DATE 9-16-57
 S. R. V. S. 6 WEATHER Clear
 SEC. _____ TEMP. 70°

DESCRIPTION With 59 & 11 H. JOB NO. _____

LEFT CENTER LINE RIGHT

48

E. Road No

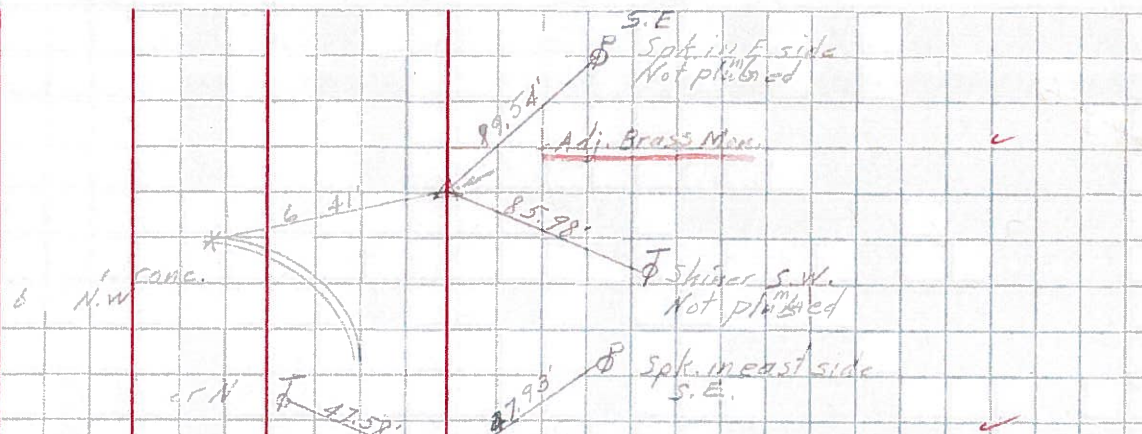


49

Twp. Rd 6d



50

Twp. Rd 6

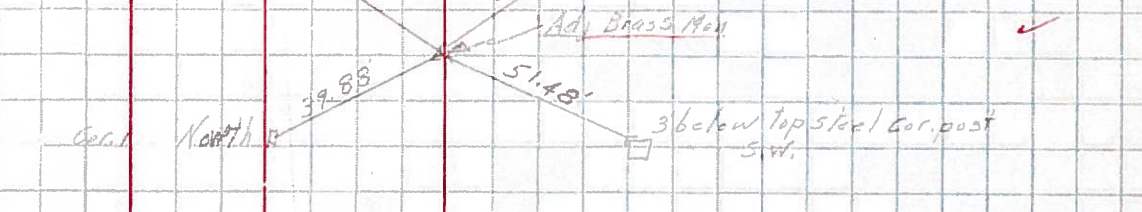

51

Co. Rd 5A



52

Co. Rd 5

