


O.D.O.T. DISTRICT 2 SURVEY OFFICE (USE ONLY)


PERSONNEL _____ REFERENCE NO. 52 SHEET 15 OF 24
 NOTES LEU DATE 4/20/17 ROUTE US 6
 H.C. LEU WEATHER PARTLY CLOUDY COUNTY HENRY
 R.C. HELDMAN TEMP. 79° TOWNSHIP DAMASCUS
 _____ SECTION 29
 _____ T 5 N R 8 E

TYPE MONUMENT _____ MAG/WASHER
 ON SURFACE - ~~BELOW~~ ON _____
~~LEFT~~ - ☉ PAV'T - ~~RIGHT~~ ON _____
11.6' TO LT EDGE PAVEMENT
 S.L.M. 1262+36.60

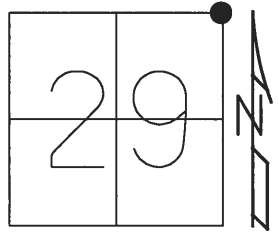

GRID: NORTHING: 624413.1485 EASTING: 1567568.058


RECORD:
 SET MAG/ WASHER
 4-21-03, DCH
 FD MAG NAIL
 REF52
 4/20/17, JLL
 SET MAG/WASHER
 10-26-17, JLL

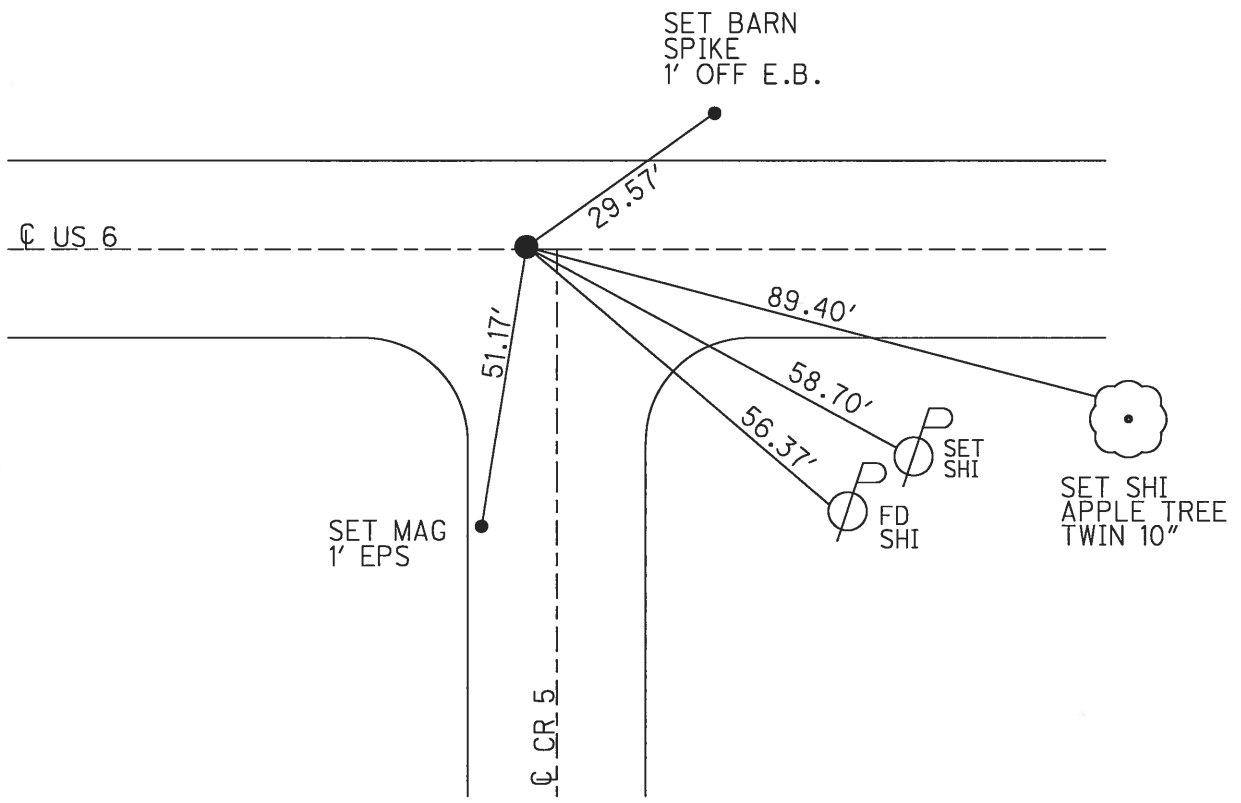

O.D.O.T. DISTRICT 2 SURVEY OFFICE (USE ONLY)


PERSONNEL	REFERENCE NO.	52	SHEET	9	OF	18
NOTES	HOMAN	DATE	7/18/02	ROUTE	US 6	
H.C.	ROUSOS	WEATHER	SUNNY	COUNTY	HENRY	
R.C.	BEAUMONT	TEMP.	80°	TOWNSHIP	DAMASCUS	
	CHLEBECK			SECTION	29	
				T	5	N
				R	8	E

TYPE MONUMENT SM.R.R.SPIKE
 ON SURFACE - ~~BELOW~~ ON _____
 LEFT - ☉ PAV'T - RIGHT ON _____
11.6' TOLT EDGE PAVEMENT
 S.L.M. 1265+08.8

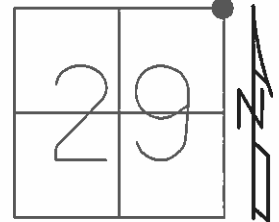

GRID: NORTHING: _____ EASTING: _____

SET MAG/ WASHER
 4-21-03, DCH

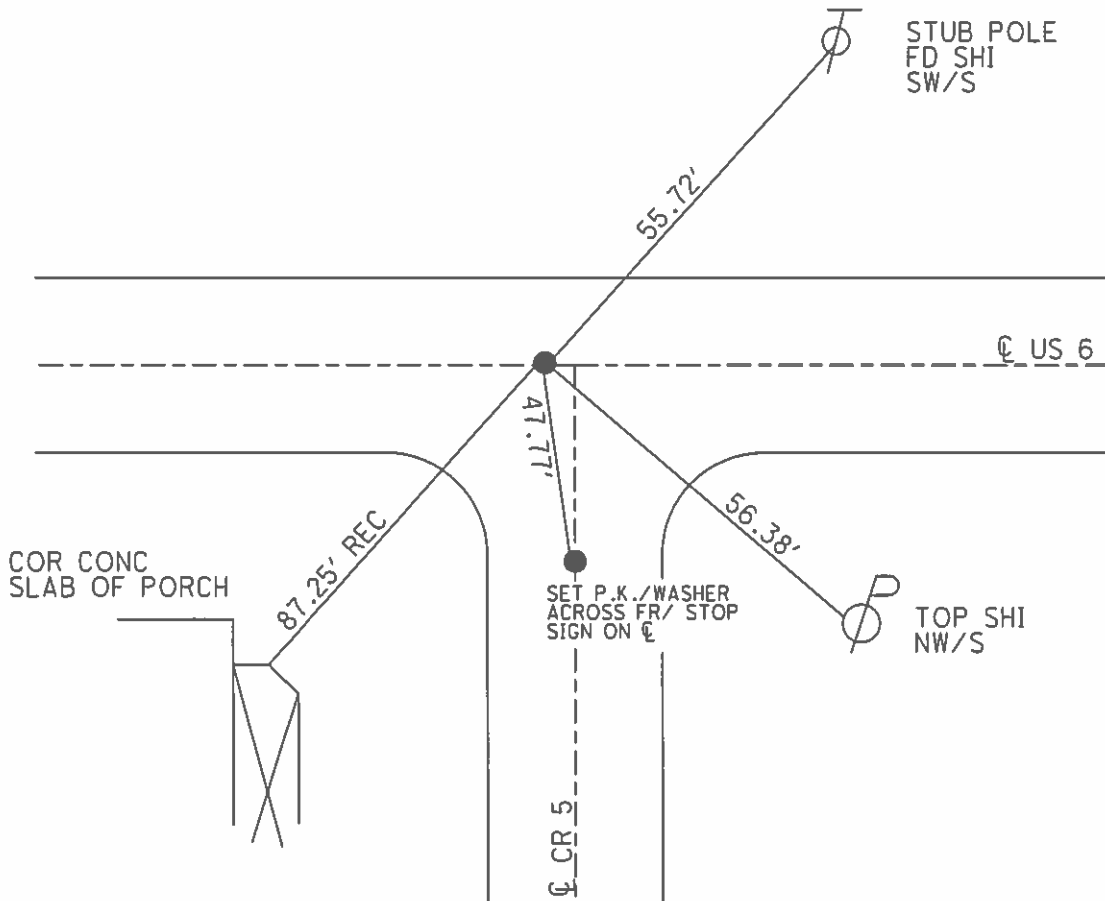

O.D.O.T. DISTRICT 2 SURVEY OFFICE

PERSONNEL

REFERENCE NO. 52

SHEET 9 OF

NOTES HOFFMAN

H.C. BARNHISEL

R.C. LOEBLICKS

DATE 4-8-88

WEATHER CLEAR

TEMP. 40°

ROUTE US 6

COUNTY HENRY

TOWNSHIP DAMASCUS

SECTION 29

T5 N R 8 E

TYPE MONUMENT P.K. Nail

ON SURFACE - ~~BELOW~~ YES

~~LEFT-C~~ PAV'T. - RIGHT YES

11.5 TO LT EDGE PAVEMENT


S.L.M. 1151+79 1149+79

Set small RR/ SPIKE
6-20-88 SWK

20	21
29	28



~~1266+37~~
1264+37 SWH

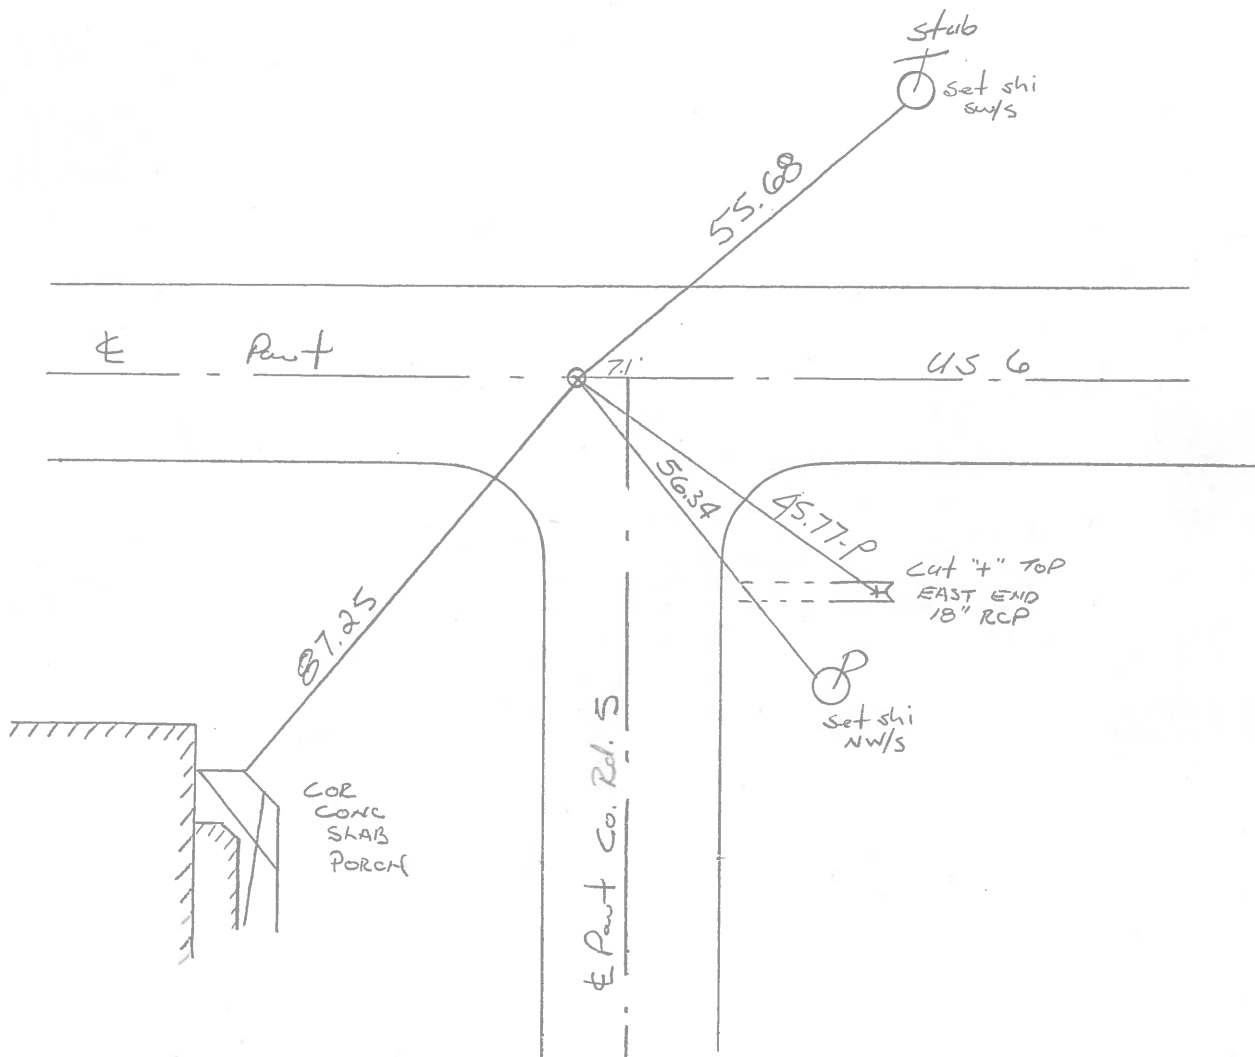

PERSONNEL	TITLE	PERSONNEL	TITLE
BURNSIDE			
SMITH			
BOWERS			
HOLCOMBE			


COUNTY HENRY DATE 5-26-71
 S. R. U.S. #6 WEATHER LT. RAIN
 SEC. _____ TEMP. +50°

DESCRIPTION _____ LEFT _____ CENTER LINE _____ RIGHT _____ JOB NO. _____

52



BRASS MON. @ SURFACE
 N.E. COR. SEC. 29
 DAMASCUS TWP.

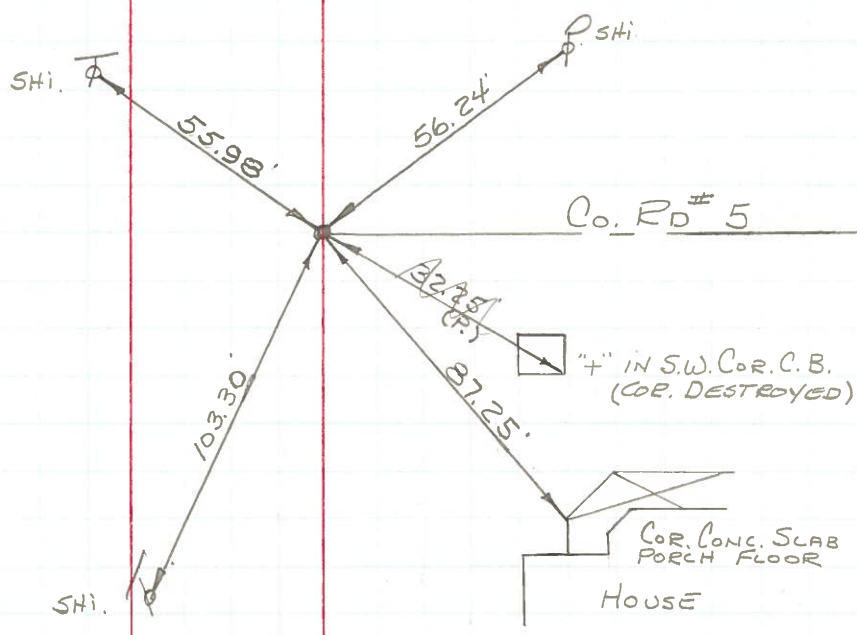

K
-1072

PERSONNEL	TITLE	PERSONNEL	TITLE
Jamison	notes		
Williams			
Matzger			
Robinson			


COUNTY Henry DATE 9-16-57
 S. R. V. 5 6 WEATHER Clear
 SEC. _____ TEMP. 70°

DESCRIPTION Witn 29 1 11 11 JOB NO. _____

LEFT CENTER LINE RIGHT


48

C. Road No

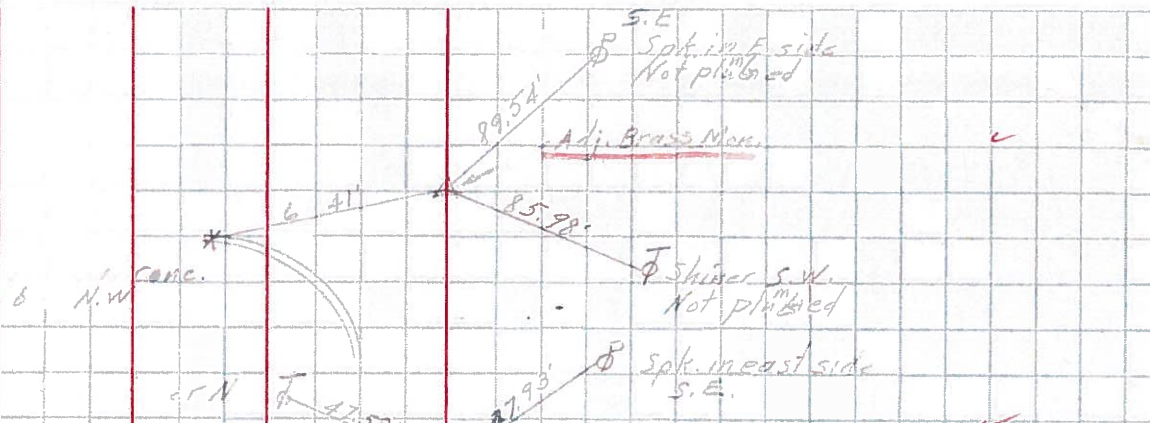


49

Twp. Rd 16d

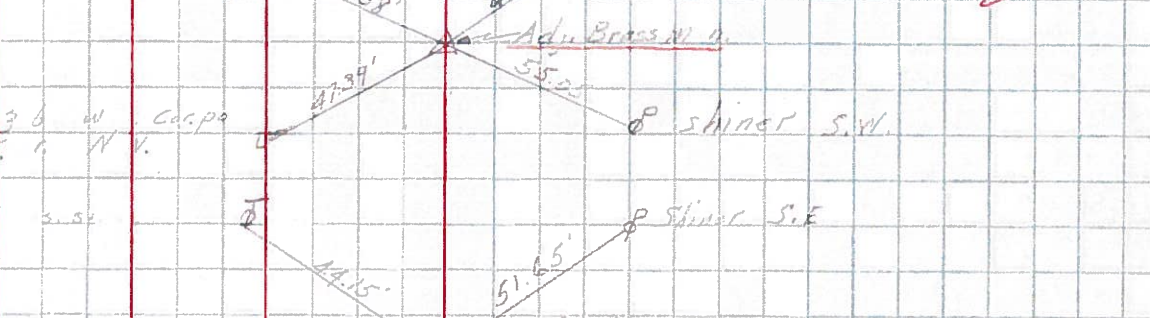


50

Twp. Rd 6

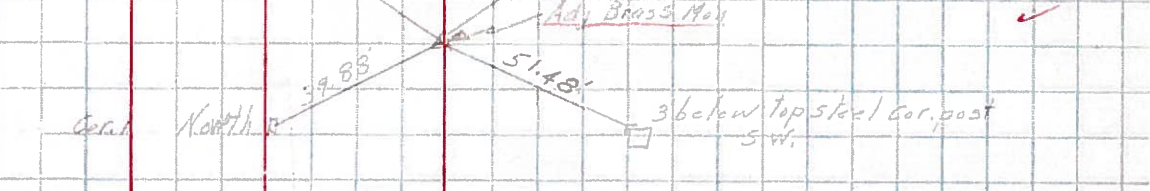

51

C. Rd # 5 A

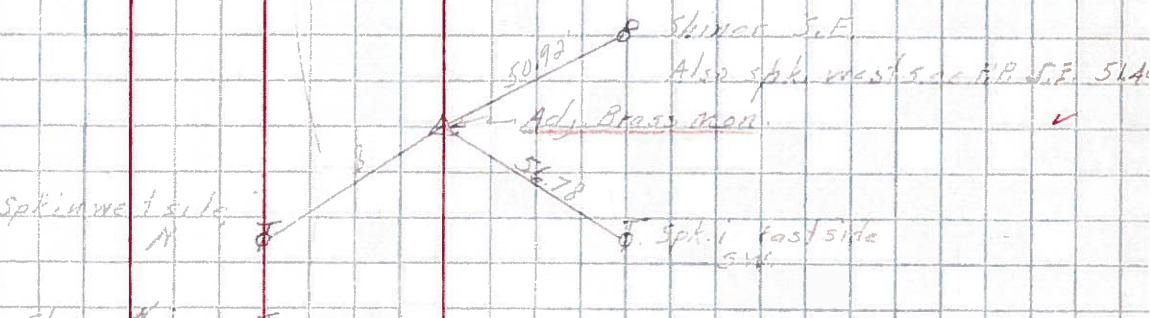

52

C. Rd # 5

