

ALSO SEE FILE "HEN 93"

ODOT (D-2)
Notes to:
J. Hoss
7-30-97

1998 TWO-LANE RESURFACING PROGRAM

DATE 6-4-97

PERSONNEL BARNHISEL

CANTERBURY

Rousos

PRIORITY NO. 4 PART 1 OF 3 SHEET 1 OF 6
COUNTY HENRY ROUTE SR 18 SECTION 16.029 SR
BEGIN LOG (SLM) 16.029 TERMINII SR 109 North
END LOG (SLM) 18.346 TERMINII SR 109 South
TOTAL LENGTH 2.317 km -MILES
MUNICIPALITY Hamlet BEGIN LOG (SLM) 18.024 END LOG (SLM)
MUNICIPALITY BEGIN LOG (SLM) END LOG (SLM)

PROPOSED WORK: Resurface existing pavement

PAVEMENT 0.051m of 446 SHOULDER Same - 6617
OTHER

STATION ESTABLISHED FROM:

REF. POINT STATIONING 16+023 / SR 18 West & Co. Rd "G"
ENDING POINT 18+375 SR 18 = SR 109 / 7+360
SEE DRAWING

STRUCTURES:

NUMBER	STATION	WIDTH	LENGTH	PROPOSED WORK
	- 0 -			

RAILROAD CROSSING:

(NO WORK)

NAME - 0 - STATION NO. TRACKS LENGTH ALONG C / FT

PAVEMENT DATA

SECTION 16.029 SUR

[illegible]

DATE 6-4-97

SHEET 3 OF 6

TWO-LANE RESURFACING PROGRAM
DEFECTIVE PAVEMENT AREAS

COUNTY HENRY

ROUTE 18

SECTION 16.029 SKK

[illegible]

COUNTY HENRY

ROUTE

18

SECTION

16.029 SKK

L - PROP PAVT DEPTH (INJ X IO; W - WIDTH @ MOUTH; W-I - WIDTH @ THROAT

[illegible]

DATE 6-4-97

SHEET 5 OF 6

**TWO-LANE RESURFACING PROGRAM
CENTERLINE PAVEMENT MARKINGS
INSIDE CITY LIMITS ONLY**

COUNTY HENRY

ROUTE 18

SECTION 16.029 SCK

[illegible]

608-60

Heath

SR 18 X-Sections

5th

$$16 + 050$$
$$16 + 850$$
$$17 + 650$$
$$100 + 300$$

ON SP 18

14,029

Left
Edge

5.20

5.10

5,24

5.15

Right
Edge

5,01

5.25

5.30

5.30

7

493

4.99

5.06

4.98

194SWH

OHIO DEPARTMENT OF TRANSPORTATION

SHEET NO. ~~5~~ 6

PERSONNEL	TITLE	PERSONNEL	TITLE
BARNHISEL		COUNTY	HENRY
CANTERBURY		S.R.	109 & 18
Rousos		WEATHER	PT. CLOUDY

DATE 6-3-97

TEMP. +70°


SEC. 4.56 (SLM)

DESCRIPTION S.R. 109 & 18 STA-ING N. OF HANLER

LEFT

CENTER LINE

RIGHT

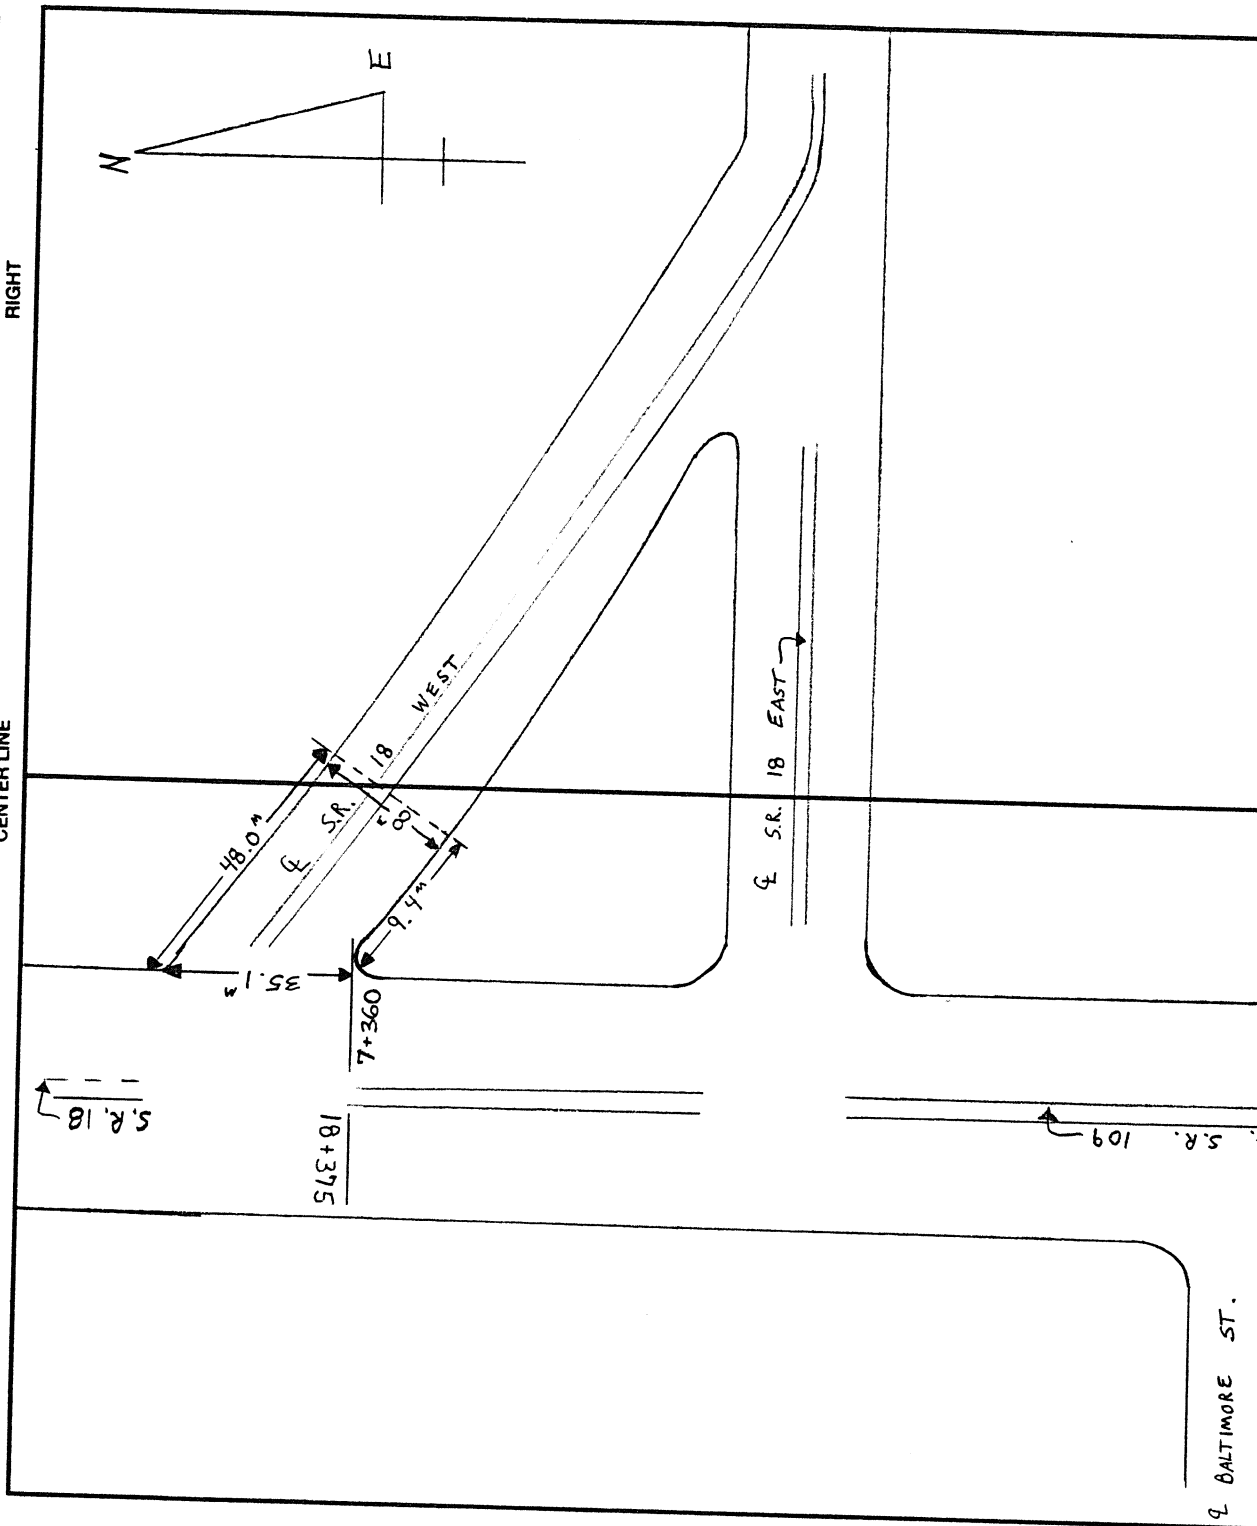

9 BALTIMORE ST.