

O.D.O.T. DISTRICT 2 SURVEY OFFICE (USE ONLY)

PERSONNEL

REFERENCE NO. 10 B

SHEET 20 OF 29

NOTES MOSER

DATE 9/10/09

ROUTE SR 18

H.C. GOLDBERG

WEATHER SUNNY

COUNTY HENRY

R.C. PIETKOWSKI

TEMP. 75°

TOWNSHIP PLEASANT

SECTION 2

DWG BY NIESE PID NO PID

T 3 N R 6 E

TYPE MONUMENT MAG/WASHER

~~ON SURFACE~~ - BELOW 1.5"

OFFSET CL PAVEMENT ON ~~RT~~ : ~~RT~~

10.0' TO RT EDGE PAVEMENT


STATION: 255+89

HORIZ. DATUM: NAD83(2011)


GEOID: 2012A

GRID: NORTHING: 582373.670

EASTING: 1519132.066

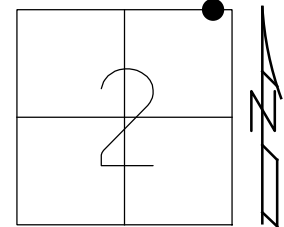


RECORD:
 FD MAG/WASHER
 9/10/09, KPM
 SET MAG/WASHER
 SV119
 10/20/09, KPM
 FD MAG/WASHER
 REFB10
 8/6/19, JFO

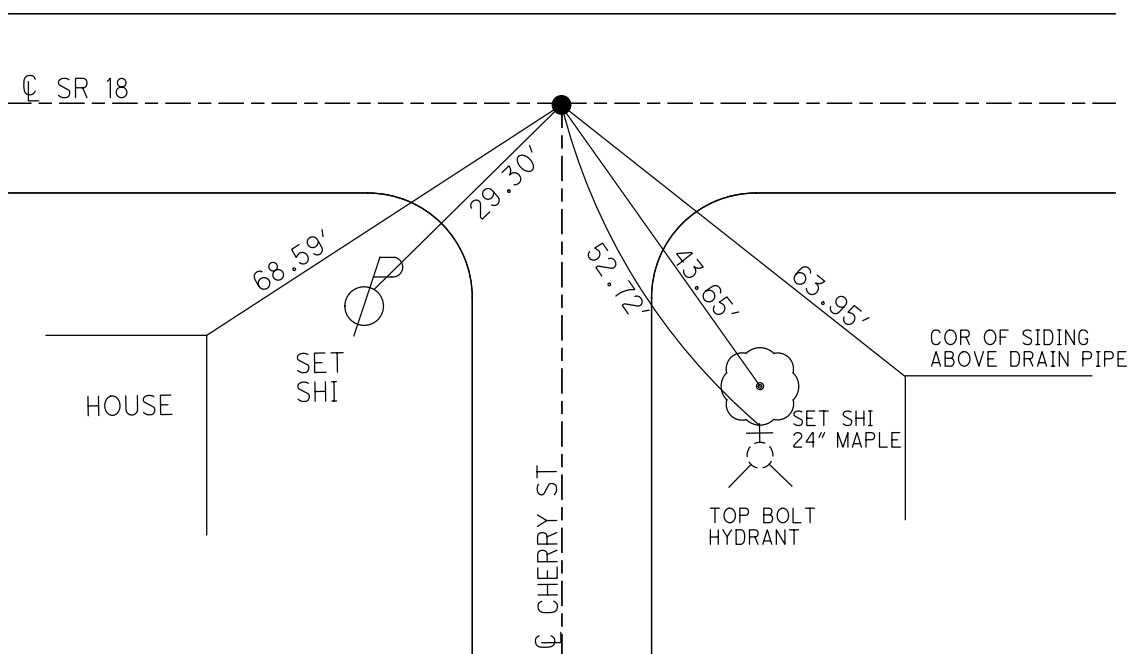

O.D.O.T. DISTRICT 2 SURVEY OFFICE (USE ONLY)


PERSONNEL	REFERENCE NO. <u>10B</u>	SHEET <u>20</u> OF <u>29</u>
NOTES <u>MOSER</u>	DATE <u>09-10-09</u>	ROUTE <u>SR 18</u>
H.C. <u>GOLDBERG</u>	WEATHER <u>SUNNY</u>	COUNTY <u>HENRY</u>
R.C. <u>PIETKOWSKI</u>	TEMP. <u>+75°</u>	TOWNSHIP <u>PLEASANT</u>
		SECTION _____
		T__N R__E

TYPE MONUMENT MAG/WASHER
~~ON SURFACE~~ - BELOW 1.5" DOWN
~~LEFT~~ - Q PAV'T - ~~RIGHT~~ ON CENTER
10' TO RT. EDGE PAVEMENT
 S.L.M. 255+89 (SV119)

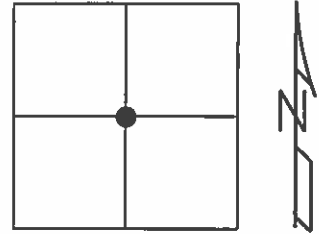

Grid: Northing: 582373.581 Easting: 1519132.082

SET MAG/WASHER
10-20-09 KPM

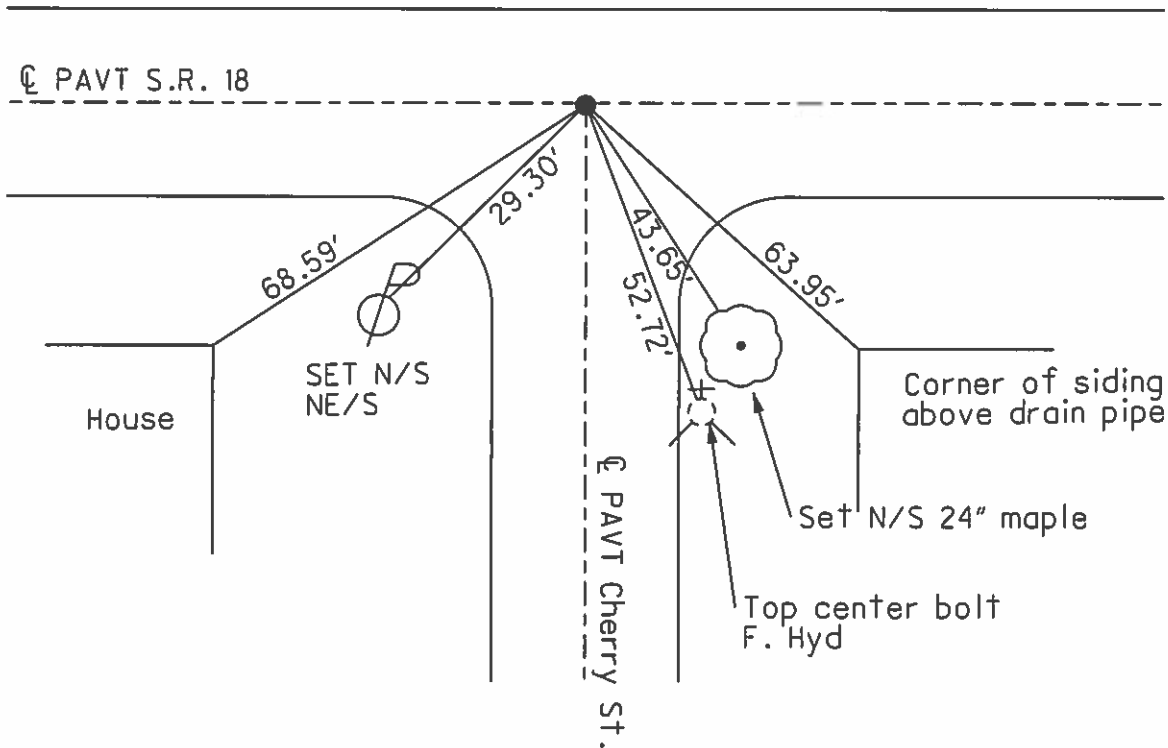

PERSONNEL TITLE PERSONNEL TITLE

COUNTY Henry

DATE 22 Oct. 74

Stone

S. R. #18

WEATHER Cold

Denno

Curtis

SEC. Holgate

TEMP. 35°

DESCRIPTION


LEFT

CENTER LINE

RIGHT

JOB NO.


Alignment

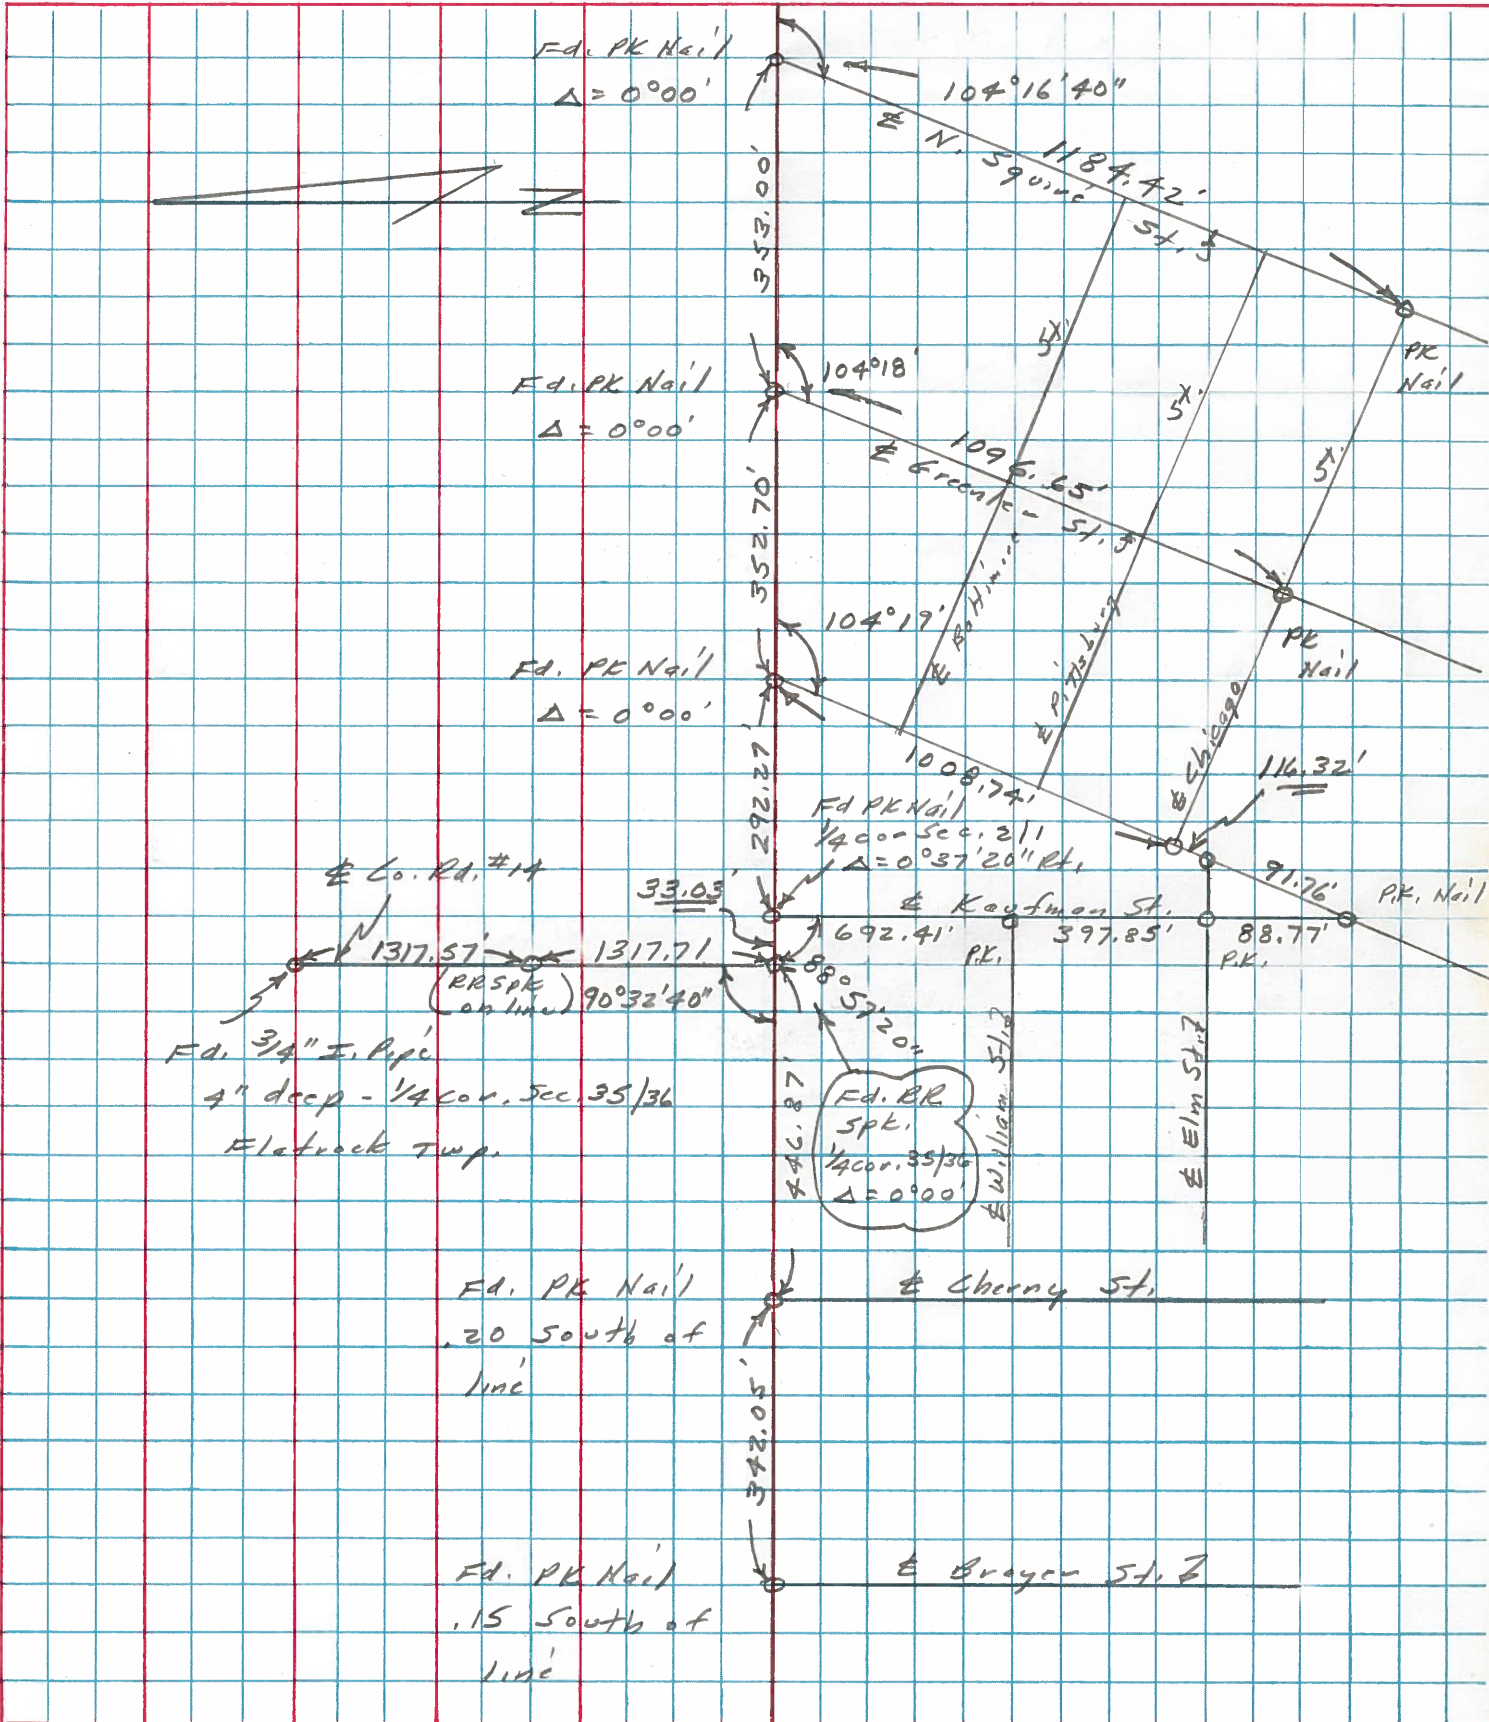

PERSONNEL TITLE PERSONNEL TITLE
 W. Denna _____
 R. Michalak _____
 D. Curtis _____

COUNTY Henry DATE Aug 19, '74
 S. R. 18 WEATHER Warm
 SEC. _____ TEMP. 85°

DESCRIPTION References To Control Points JOB NO. 02999(6)

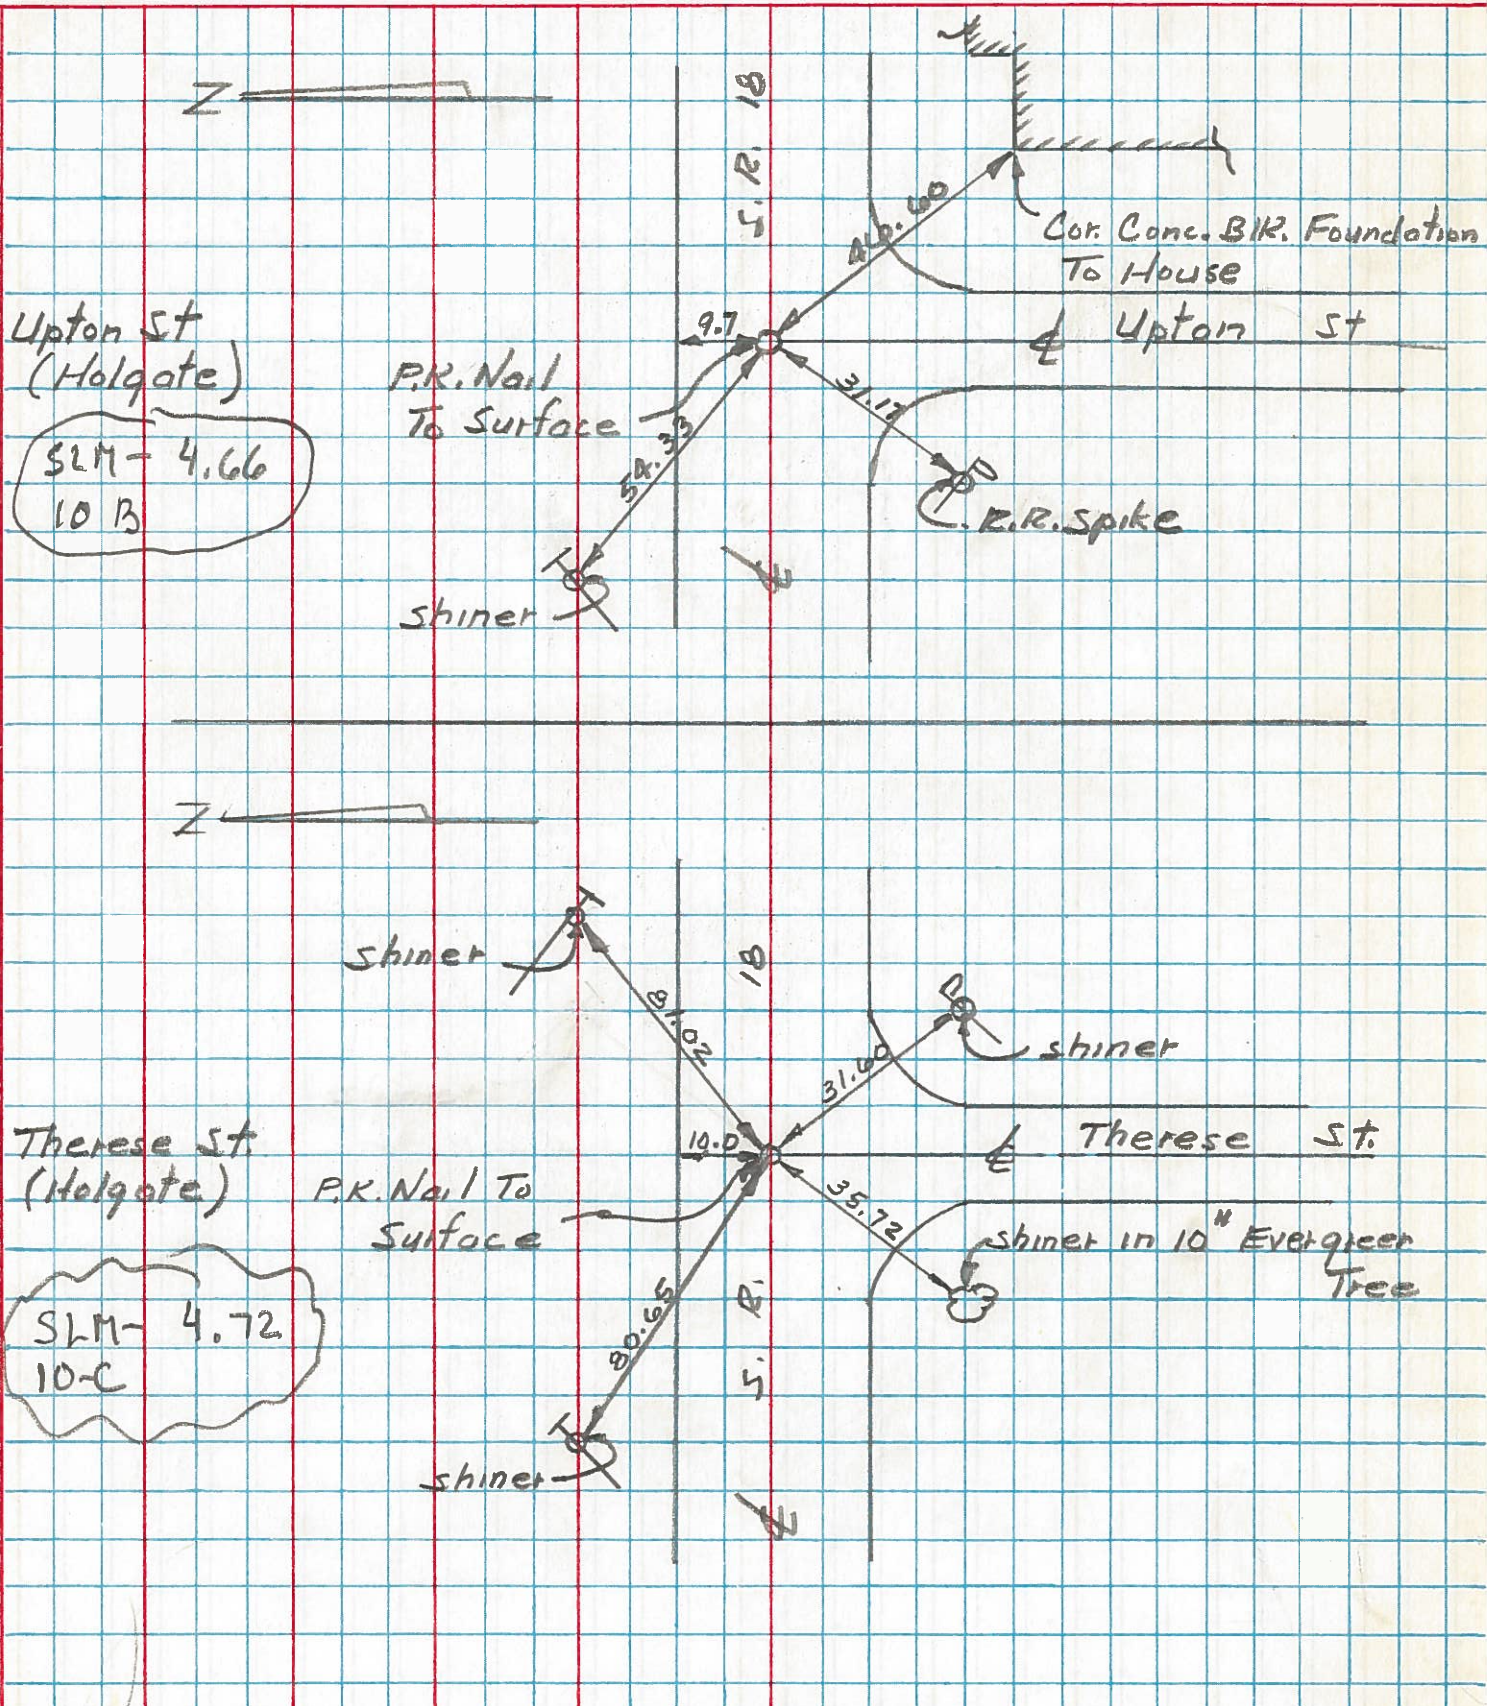

PERSONNEL TITLE PERSONNEL TITLE
 W. Denno _____
 R. Michalak _____
 D. Curtis _____

COUNTY Henry DATE Aug. 19, '74
 S. R. 18 WEATHER Warm
 SEC. _____ TEMP. 85°

DESCRIPTION References To Control Points LEFT CENTER LINE RIGHT JOB NO. 02999 (0)

