


O.D.O.T. DISTRICT 2 SURVEY OFFICE (USE ONLY)

PERSONNEL _____ REFERENCE NO. 11 B SHEET 23 OF 29
 NOTES HELDMAN DATE 4/26/17 ROUTE SR 18
 H.C. LEU WEATHER PTLY CLOUDY COUNTY HENRY
 R.C. HELDMAN TEMP. 65° TOWNSHIP PLEASANT
 DWG BY NIESE PID NO PID SECTION 1
 T 3 N R 6 E


TYPE MONUMENT MAG NAIL
 ON SURFACE - ~~BELOW~~ ON
 OFFSET ☉ PAVEMENT 4.4' LT : ~~RT~~
- TO - EDGE PAVEMENT 2.2' S OF ☉ W
 STATION: 264+21

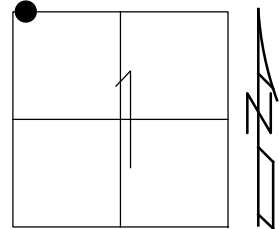

HORZ. DATUM: NAD83(2011) GEOID: 2012A
 GRID: NORTHING: 582369.208 EASTING: 1519904.016

RECORD:
 FD P.K./WASHER
 5/1/03, MB
 SET MAG/WASHER
 10/31/03, MB
 FD MAG/WASHER
 REF12
 2/4/16, JLL
 SET MAG/WASHER
 8/4/17, JLL
 D.N.F.
 8/6/19, JFO

NOTE: REF 14 ON SR 108

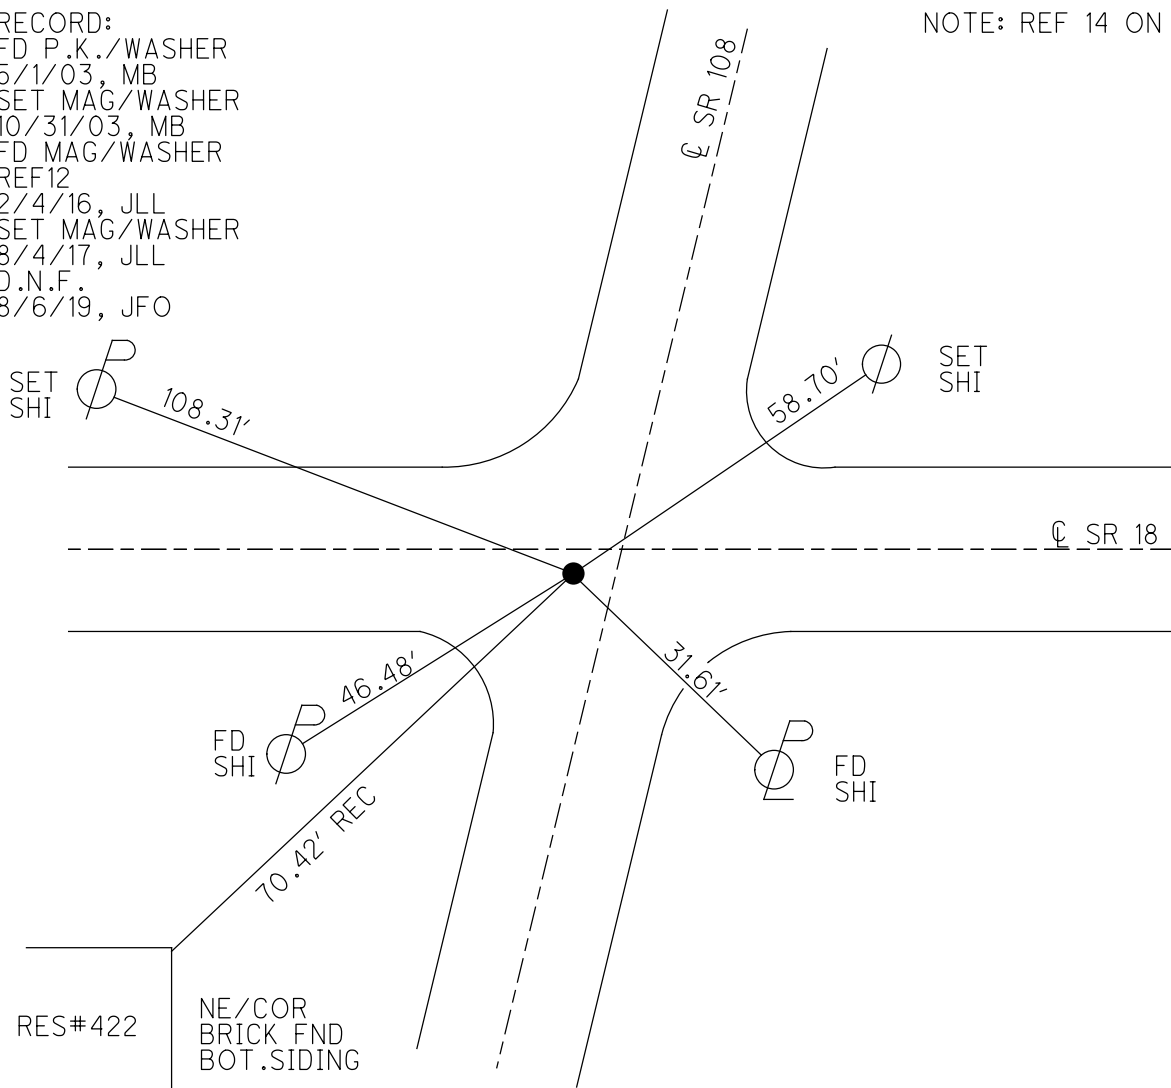

O.D.O.T. DISTRICT 2 SURVEY OFFICE (USE ONLY)

PERSONNEL _____

REFERENCE NO. 11B

SHEET 23 OF 29

NOTES MOSER

DATE 09-10-09

ROUTE SR 18

H.C. GOLDBERG

WEATHER SUNNY

COUNTY HENRY

R.C. PIETKOWSKI

TEMP. +75°

TOWNSHIP PLEASANT

SECTION 1

T 3 N R 6 E

TYPE MONUMENT PK/WASHER



~~ON SURFACE~~ - BELOW 2" BELOW

LEFT - ☉ PAV'T - RIGHT _____

_____ TO _____ EDGE PAVEMENT

S.L.M. (SV122)

Grid: Northing: 582369.126 Easting: 1519903.973

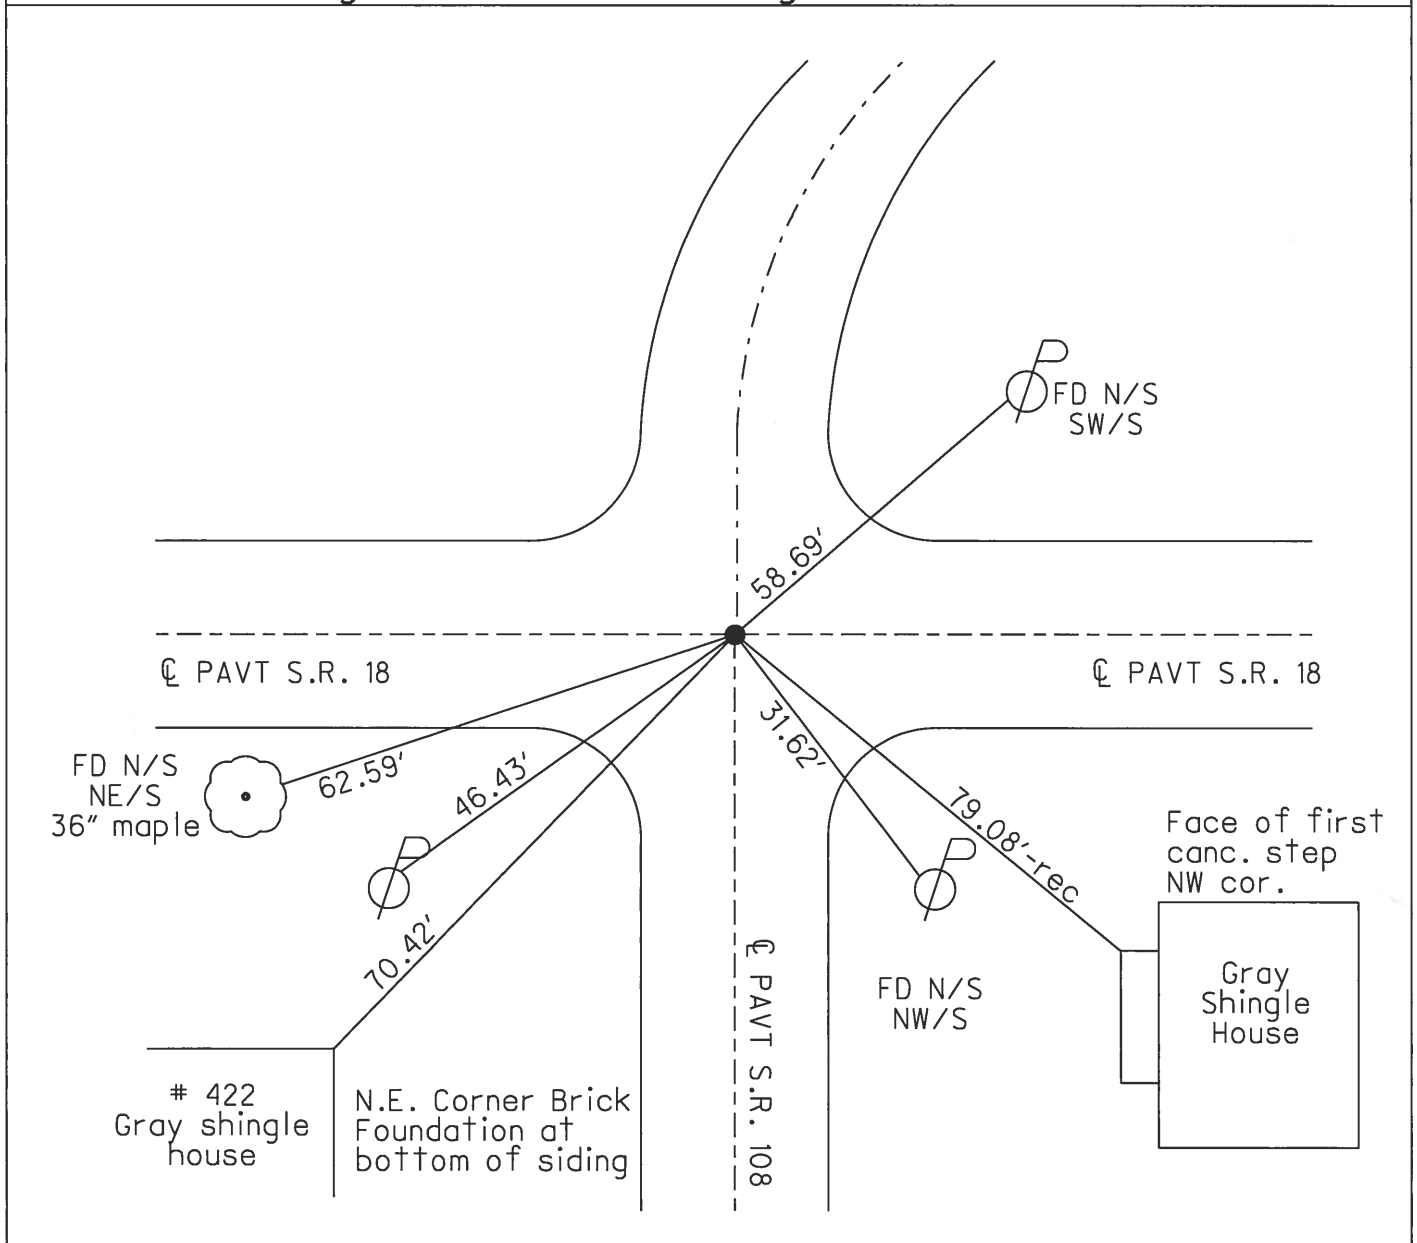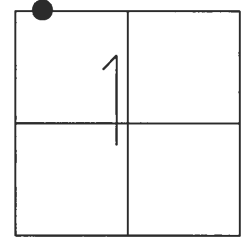

O.D.O.T. DISTRICT 2 SURVEY OFFICE

PERSONNEL

REFERENCE NO. 14 ^{ON SR 108} SHEET 19 OF
 # 11 ON SR 18

NOTES LOEHRKE
 H.C. CURTIS
 R.C. ROMETO
FALKOWSKI

DATE 8-14-92
 WEATHER CLOUDY
 TEMP. 768


SR-18
 ROUTE ~~SR 108~~
 COUNTY HENRY
 TOWNSHIP PLEASANT
 SECTION 1
 T 3 N R 6 E

RESET 9-29-92

TYPE MONUMENT PK / WASHER
 ON SURFACE - BELOW YES


LEFT- & PAV'T. - RIGHT 3.74 9 108

TO EDGE PAVEMENT SR-18
 S.L.M. 327 +26 SLM 5.00 264+00

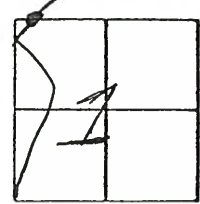

SR-108

11B

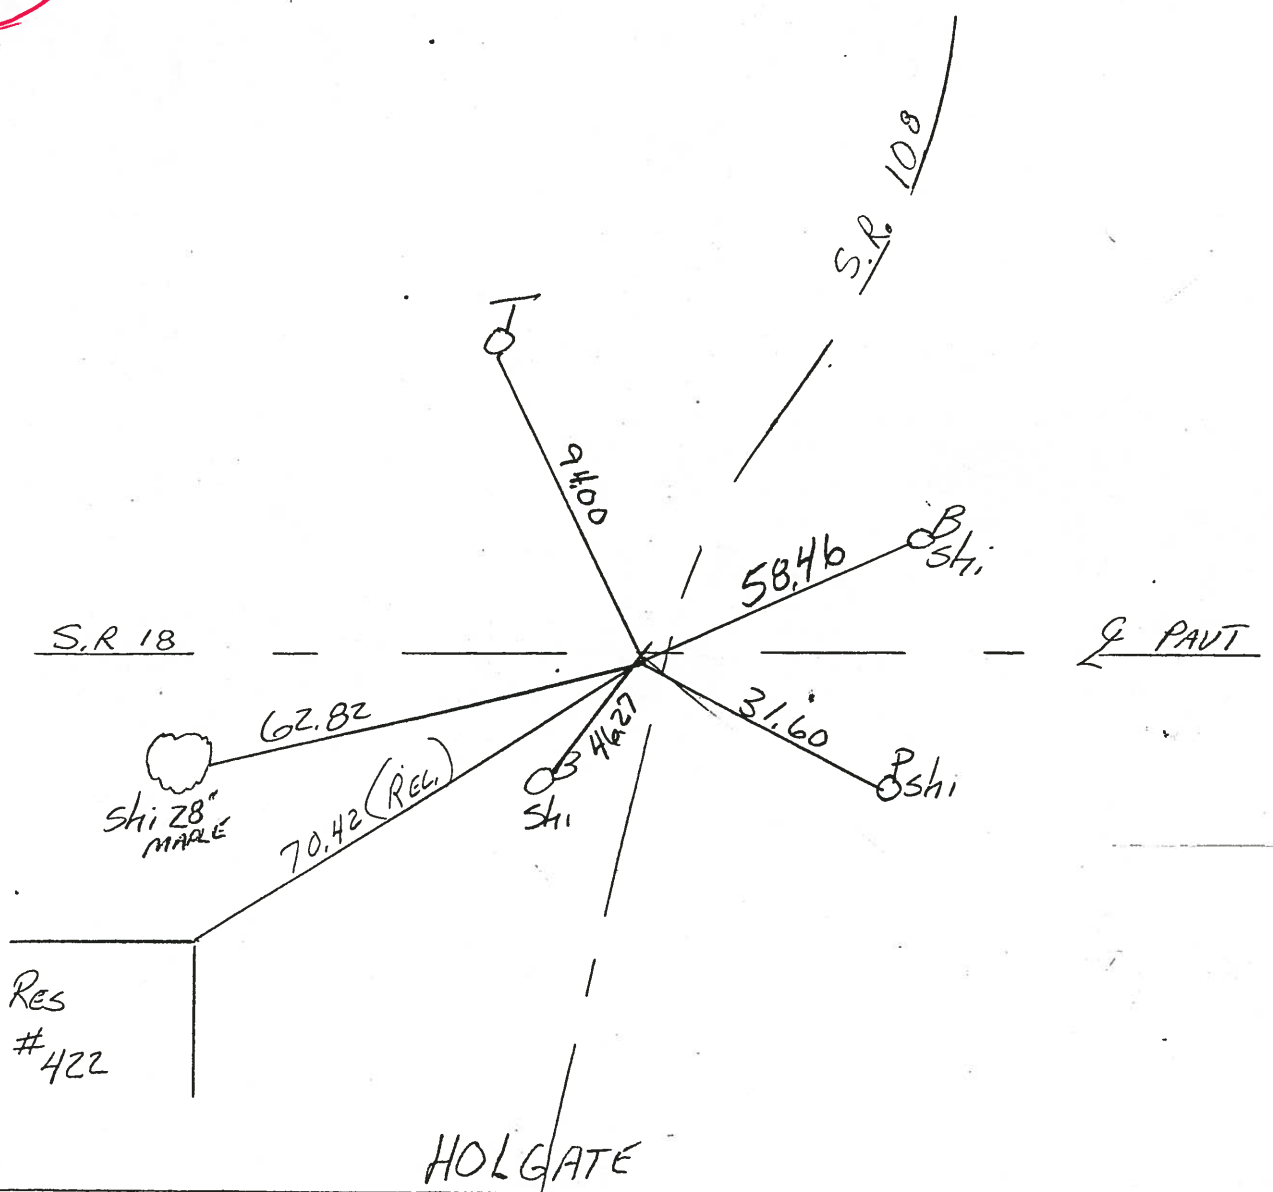

Res #422

HOLGATE

ODOT DISTRICT 2 SURVEY OFFICE

SHEET 1 OF

County HENRY S.R. 18

Date 5-28-81

Township PLEASANT-IN HOLGATE

Weather PART. CLOUDY

Section 1 Village

Temp. +60°


T3N, R6E

Personnel S. Hoffmann

C. Loehrke

d. Householder


11

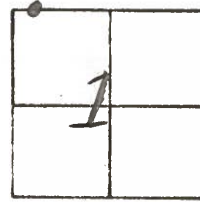

11-B

Fd. P.K. 2" Below SURFACE

SET 2" SPK. 10-26-81 SWH.

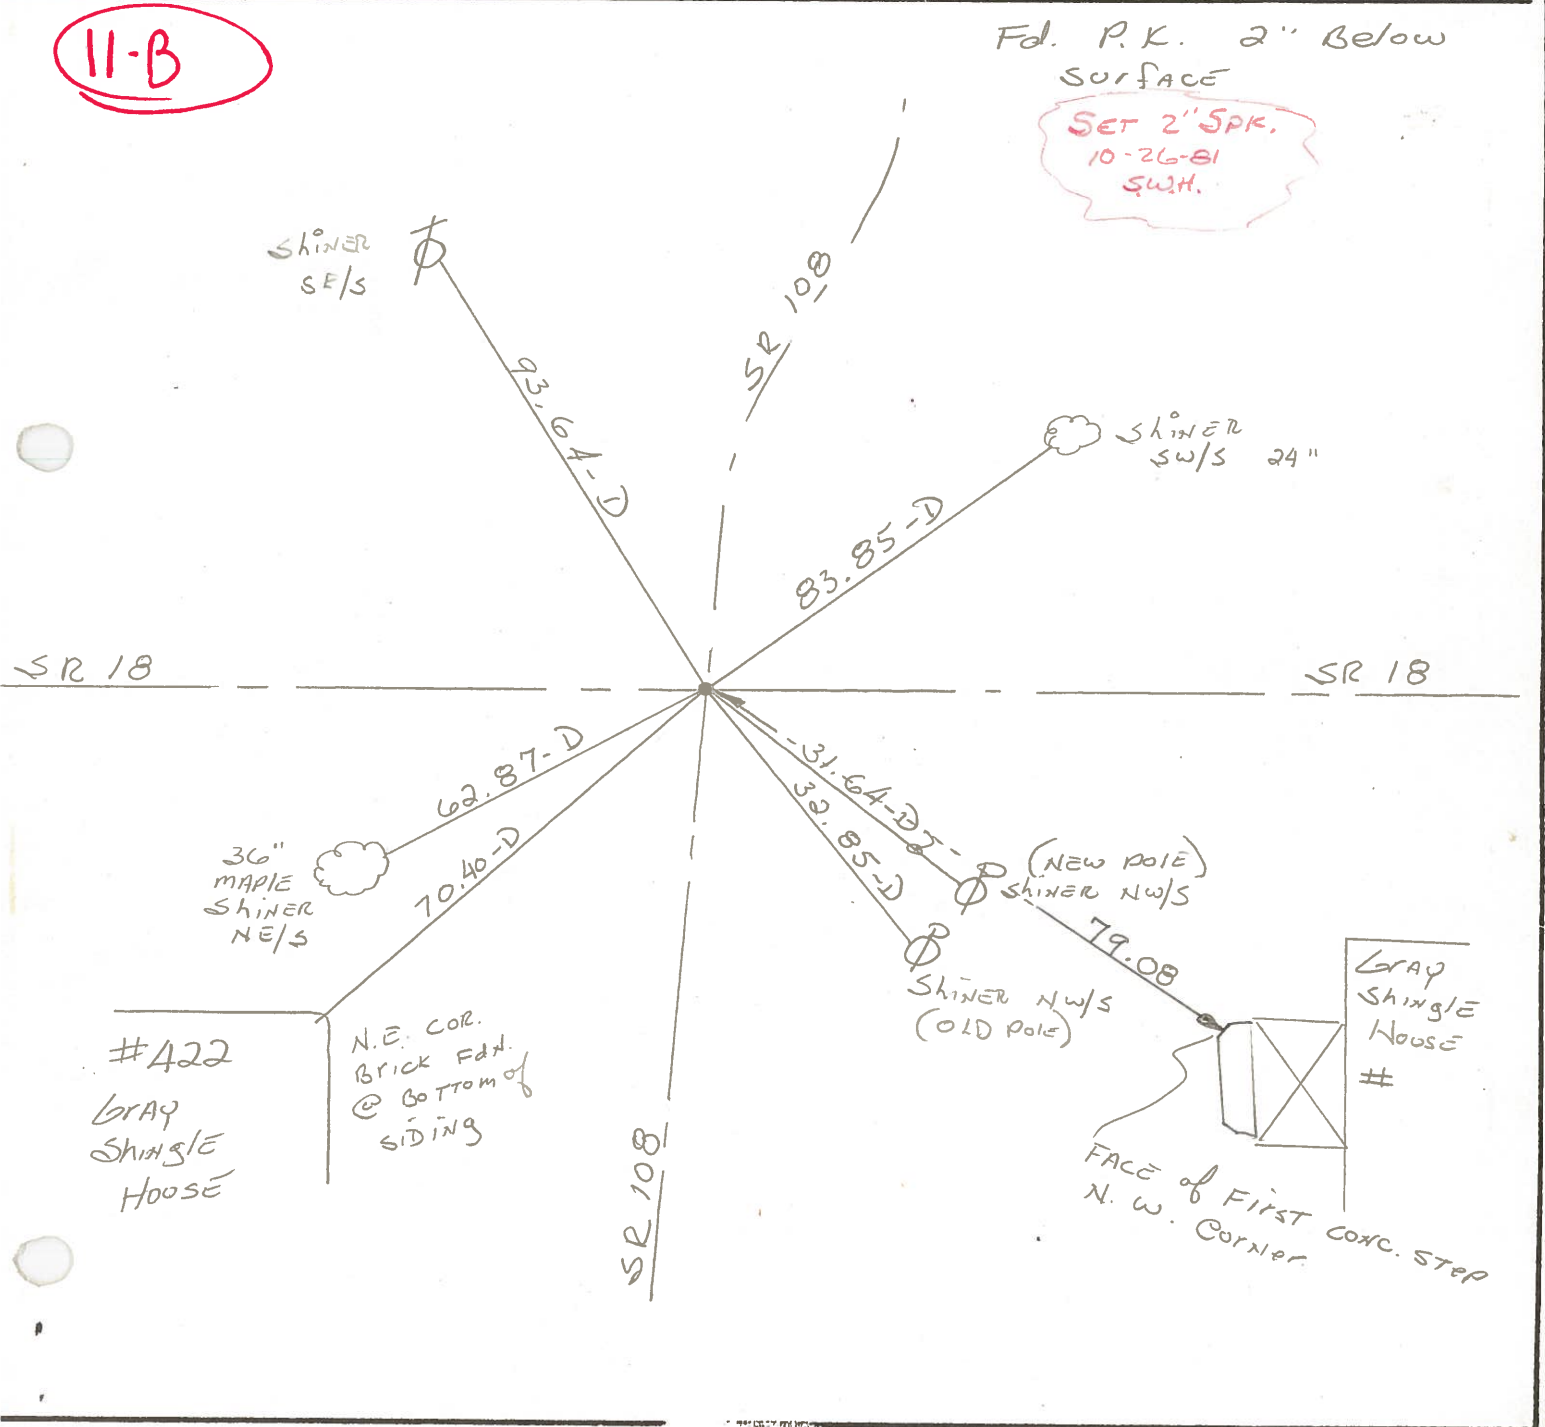

PERSONNEL TITLE PERSONNEL TITLE

COUNTY Henry

DATE 22 Oct. 74

Stone

S. R. #18

WEATHER Cold

Denno

Curtis

SEC. Holgate

TEMP. 35°

DESCRIPTION


LEFT

CENTER LINE

RIGHT

JOB NO.

Alignment

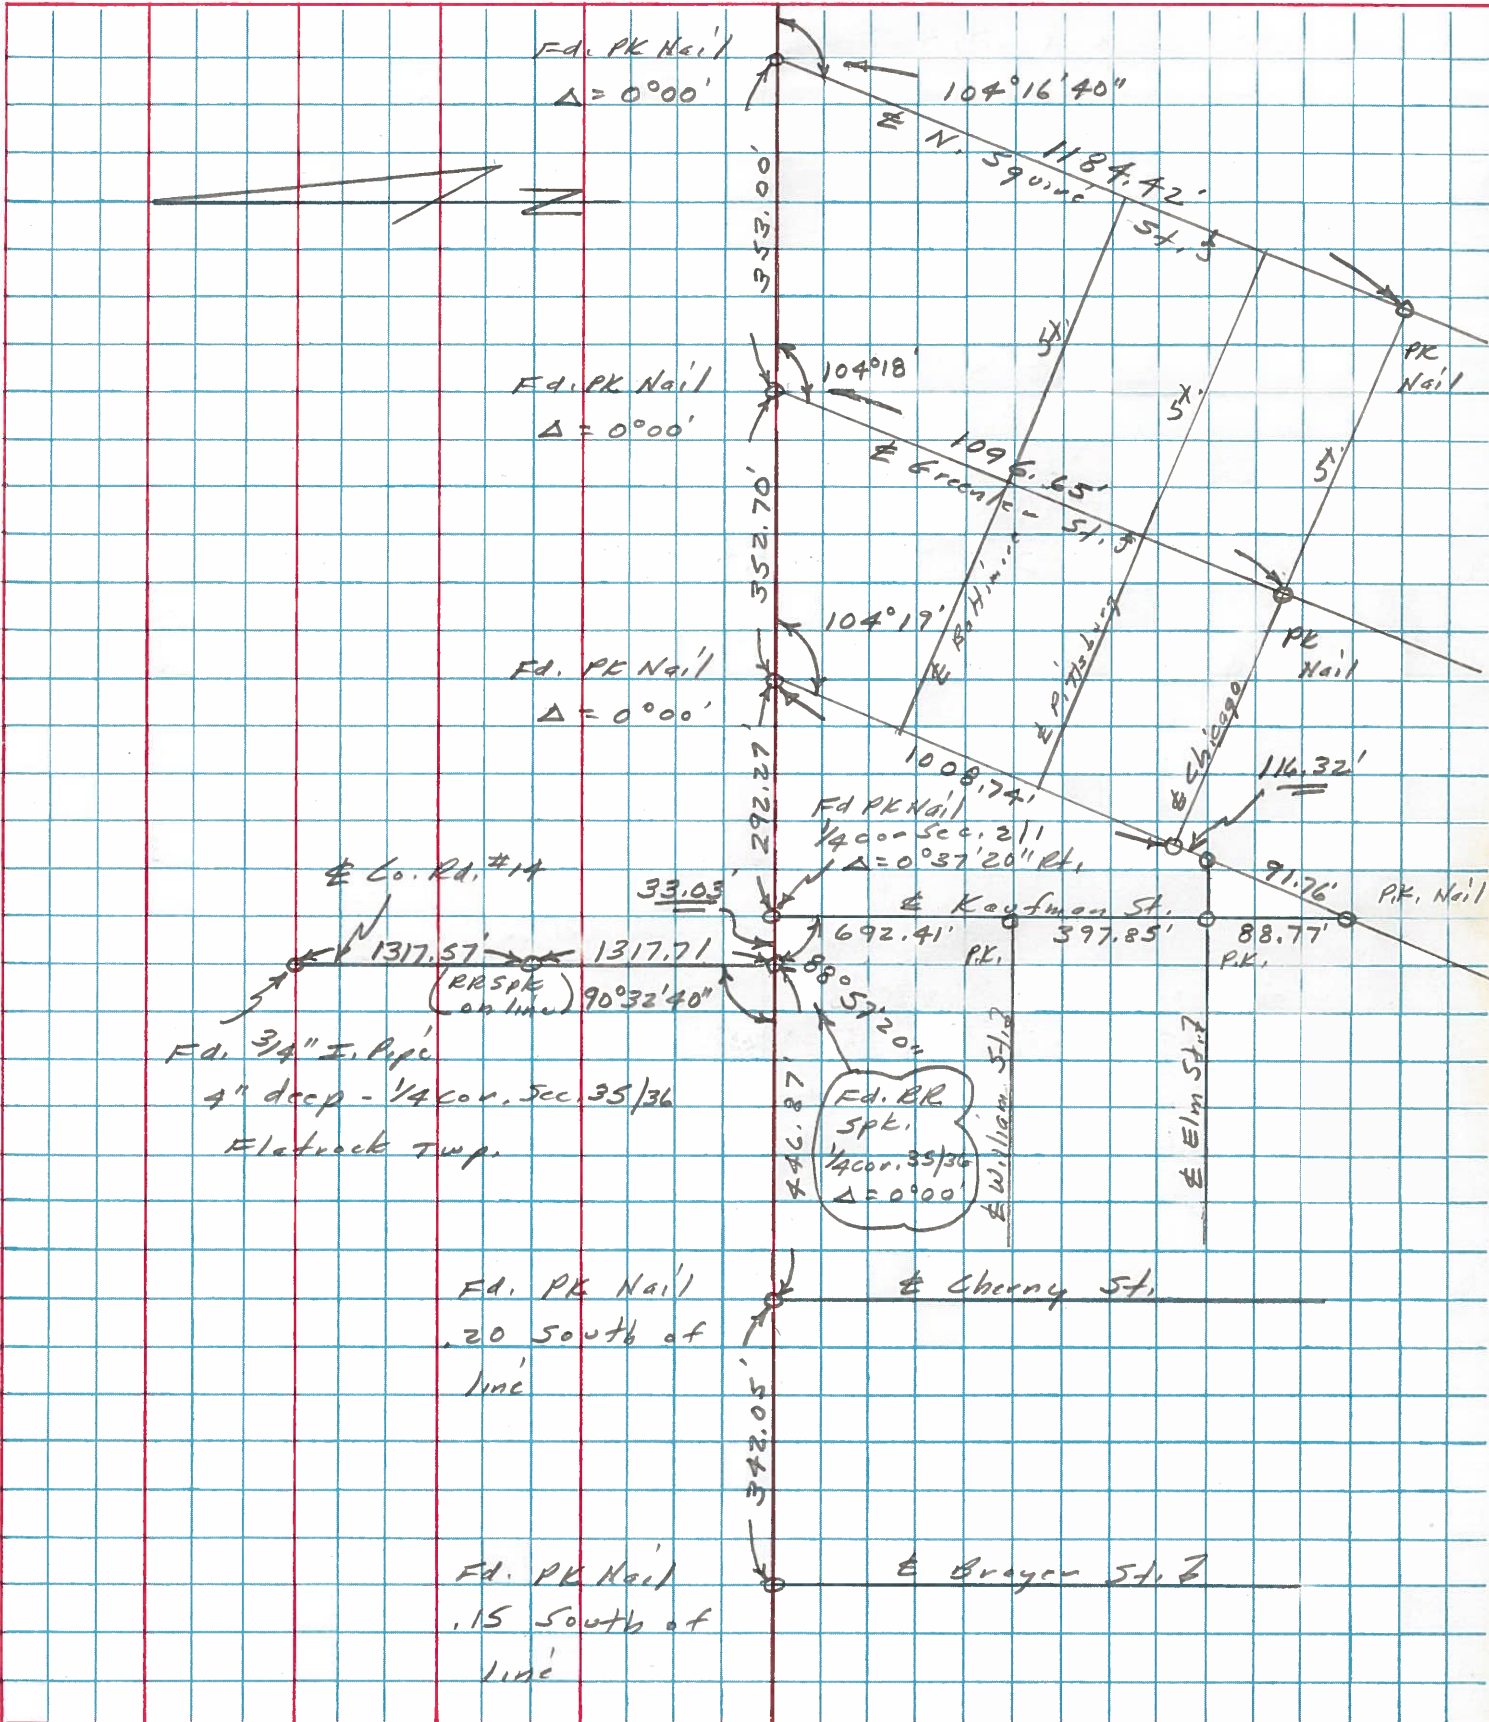

PERSONNEL	TITLE	PERSONNEL	TITLE
W. Denno			
R. Micholok			
D. Curtis			

COUNTY Henry DATE Aug 20, '7

S. R. 18 WEATHER Warm

SEC. _____ TEMP. 90°

DESCRIPTION References To Control Points JOB NO. 02999(0)

