


O.D.O.T. DISTRICT 2 SURVEY OFFICE (USE ONLY)


PERSONNEL _____ REFERENCE NO. 11 E SHEET 26 OF 29
 NOTES MOSER DATE 9/10/09 ROUTE SR 18
 H.C. GOLDBERG WEATHER SUNNY COUNTY HENRY
 R.C. PIETKOWSKI TEMP. 75° TOWNSHIP PLEASANT
 DWG BY NIESE PID NO PID SECTION 1
 T 3 N R 6 E

TYPE MONUMENT SMALL NAIL
 ON SURFACE - ~~BELOW~~ ON
 OFFSET CL PAVEMENT 4.9' ~~±~~ : RT
15.2' TO LT EDGE PAVEMENT
 STATION: 274+66

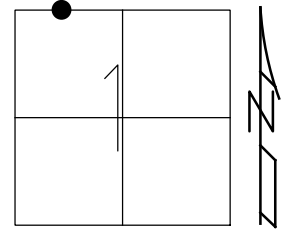

HORZ.DATUM: NAD83(2011) GEOID: 2012A
 GRID: NORTHING: 582355.888 EASTING: 1520979.321


RECORD:
 FD SMALL NAIL
 SV125
 9/10/09, KPM
 SET MAG/WASHER
 10/20/09, KPM
 FD MAG/WASHER
 REFE11
 8/6/19, JFO

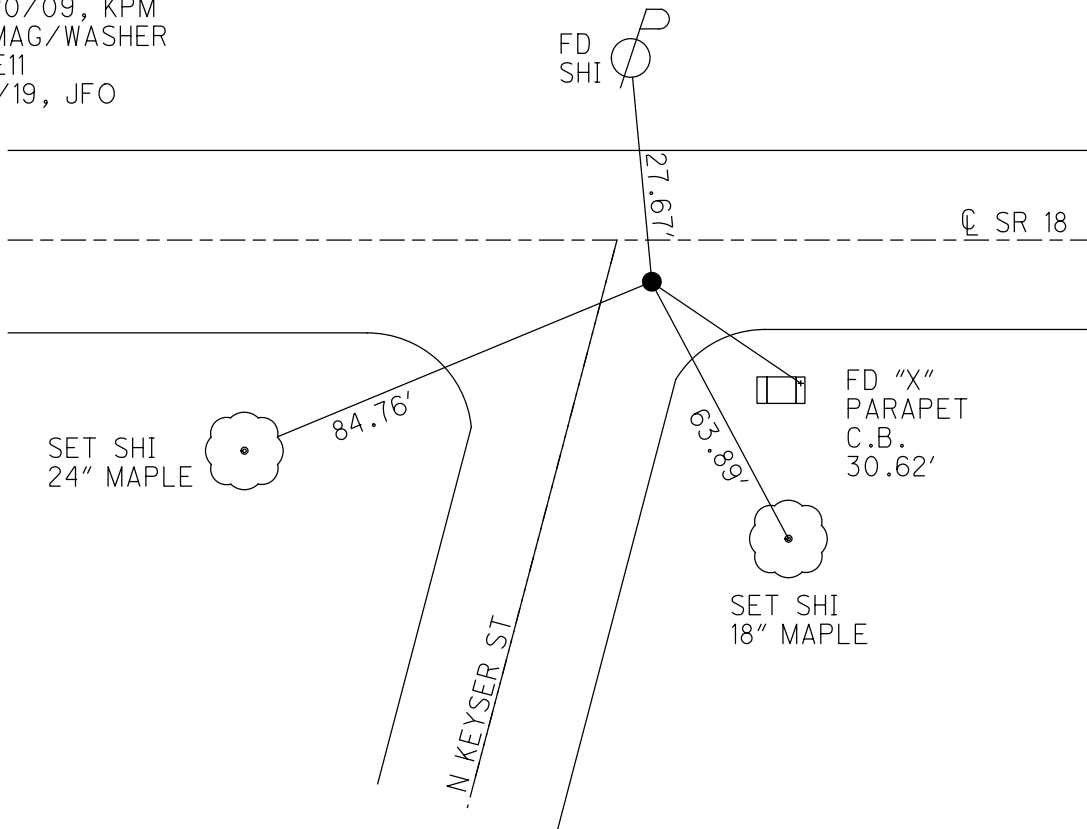

O.D.O.T. DISTRICT 2 SURVEY OFFICE (USE ONLY)


PERSONNEL	REFERENCE NO. <u>11E</u>	SHEET <u>26</u> OF <u>29</u>
NOTES <u>MOSER</u>	DATE <u>09-10-09</u>	ROUTE <u>SR 18</u>
H.C. <u>GOLDBERG</u>	WEATHER <u>SUNNY</u>	COUNTY <u>HENRY</u>
R.C. <u>PIETKOWSKI</u>	TEMP. <u>+75°</u>	TOWNSHIP <u>PLEASANT</u>
		SECTION <u>1</u>
		T <u>3</u> N R <u>6</u> E

TYPE MONUMENT SMALL NAIL
 ON SURFACE - ~~BELOW~~ ON SURFACE
~~LEFT - C PAV'T~~ - RIGHT 4.9'
15.2' TO LT EDGE PAVEMENT
 S.L.M. 274+66 (SV125)

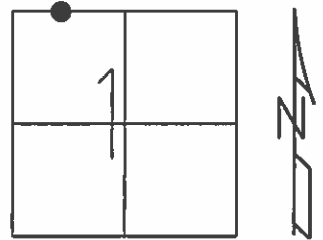

Grid: Northing: 582355.877 Easting: 1520979.286

SET MAG/WASHER
10-20-09 KPM

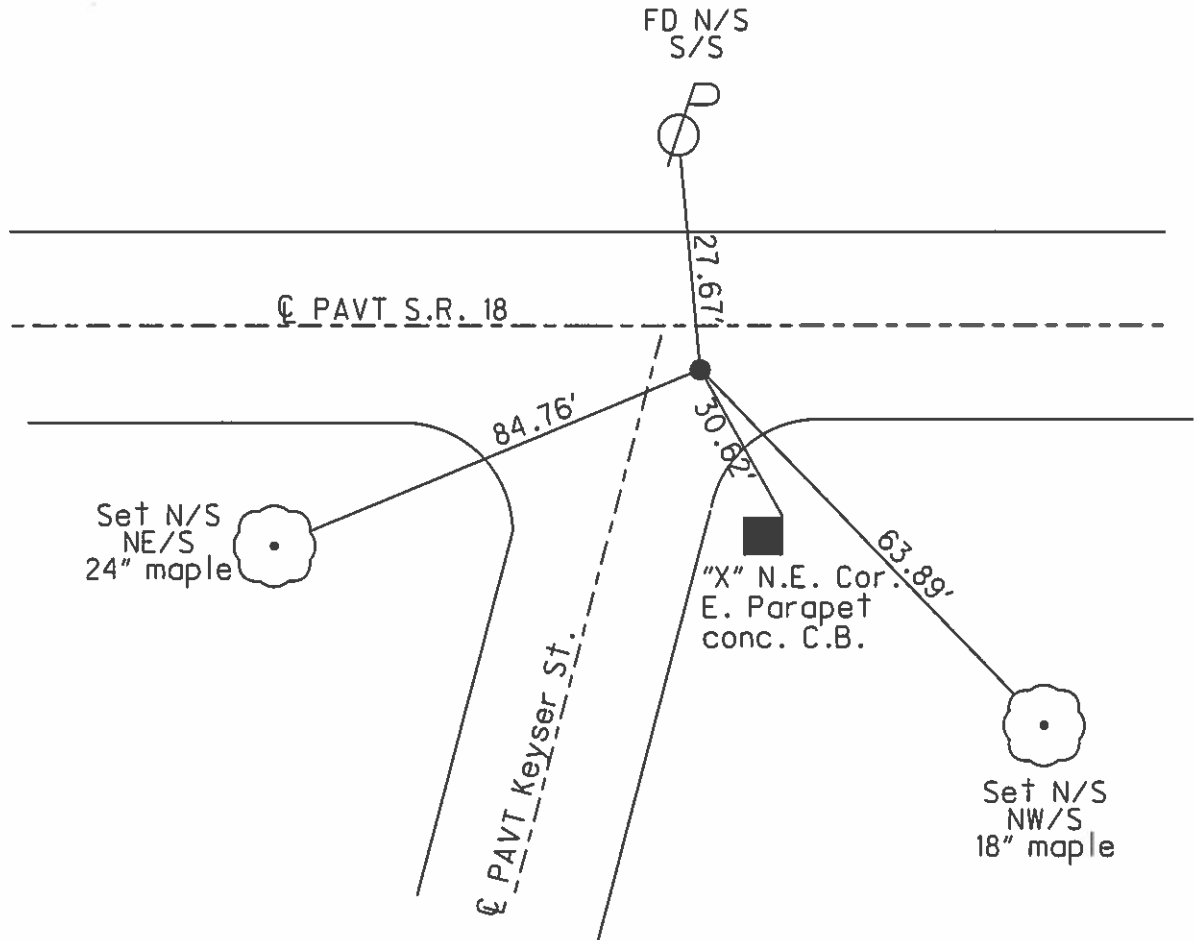

O.D.O.T. DISTRICT 2 SURVEY OFFICE

PERSONNEL

REFERENCE NO. 11-C

SHEET OF

NOTES SOCKMAN

H.C. BARNHISEL

R.C. LOEHRKE

DATE 8-12-87

WEATHER CLEAR

TEMP. + 72

ROUTE SR 18

COUNTY HENRY

TOWNSHIP PLEASANT

SECTION 1

T. 3 N. R. 6 E.

TYPE MONUMENT SMALL NAIL


ON SURFACE - BELOW YES

~~LEFT - C~~ PAVT. - RIGHT 4.2


13.6 TO LT EDGE PAVEMENT

S.L.M. 274+66 5.20

*Set small RR spike
8-20-87
SWH*

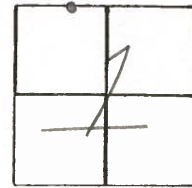

11E

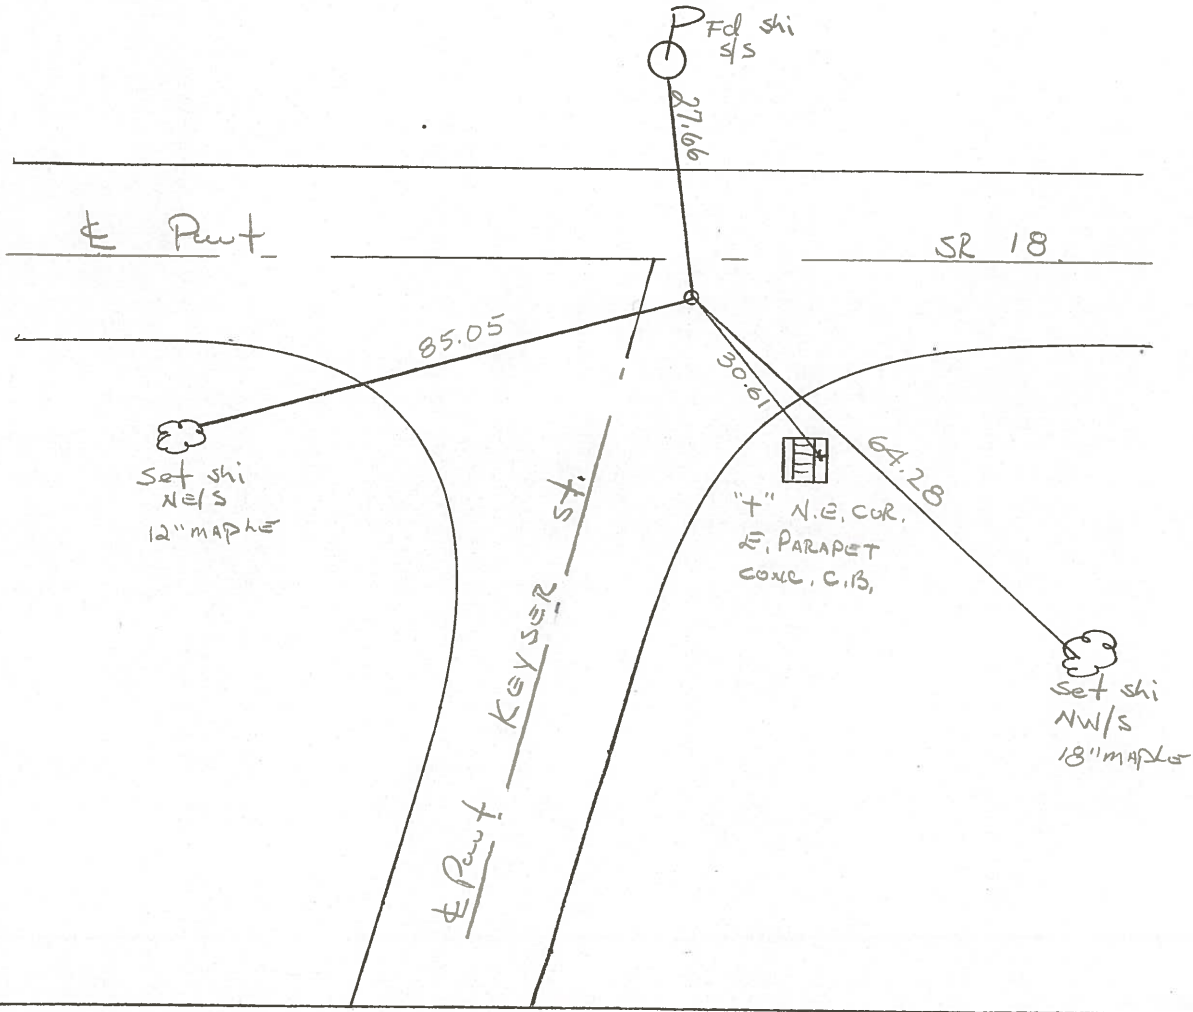

County HENRY S.R. 18

Date 5-28-81 8-20-81

Township PLEASANT - IN HOLGATE
Village

Weather PART. CLOUDY clear

Section 1

Temp. +60° +80°


T3N, R6E

Personnel S. Hoffmann

C. Loehrke

L. Householder

(11E)

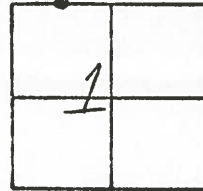

- SOURCE UNKNOWN -

PROJECT STA. ± 274+84


Fd. SMALL NAIL 1" Below surface

Set ~~AK~~ SMALL BLACK CONC. NAIL

17.2
14.1 TO N. Edge PAUT.
4.8' S. of ± PAUT


Note: we get a solid reading with the Schonsted locator 0.18' E. of nail, DID NOT Dig up New Road

SR 18

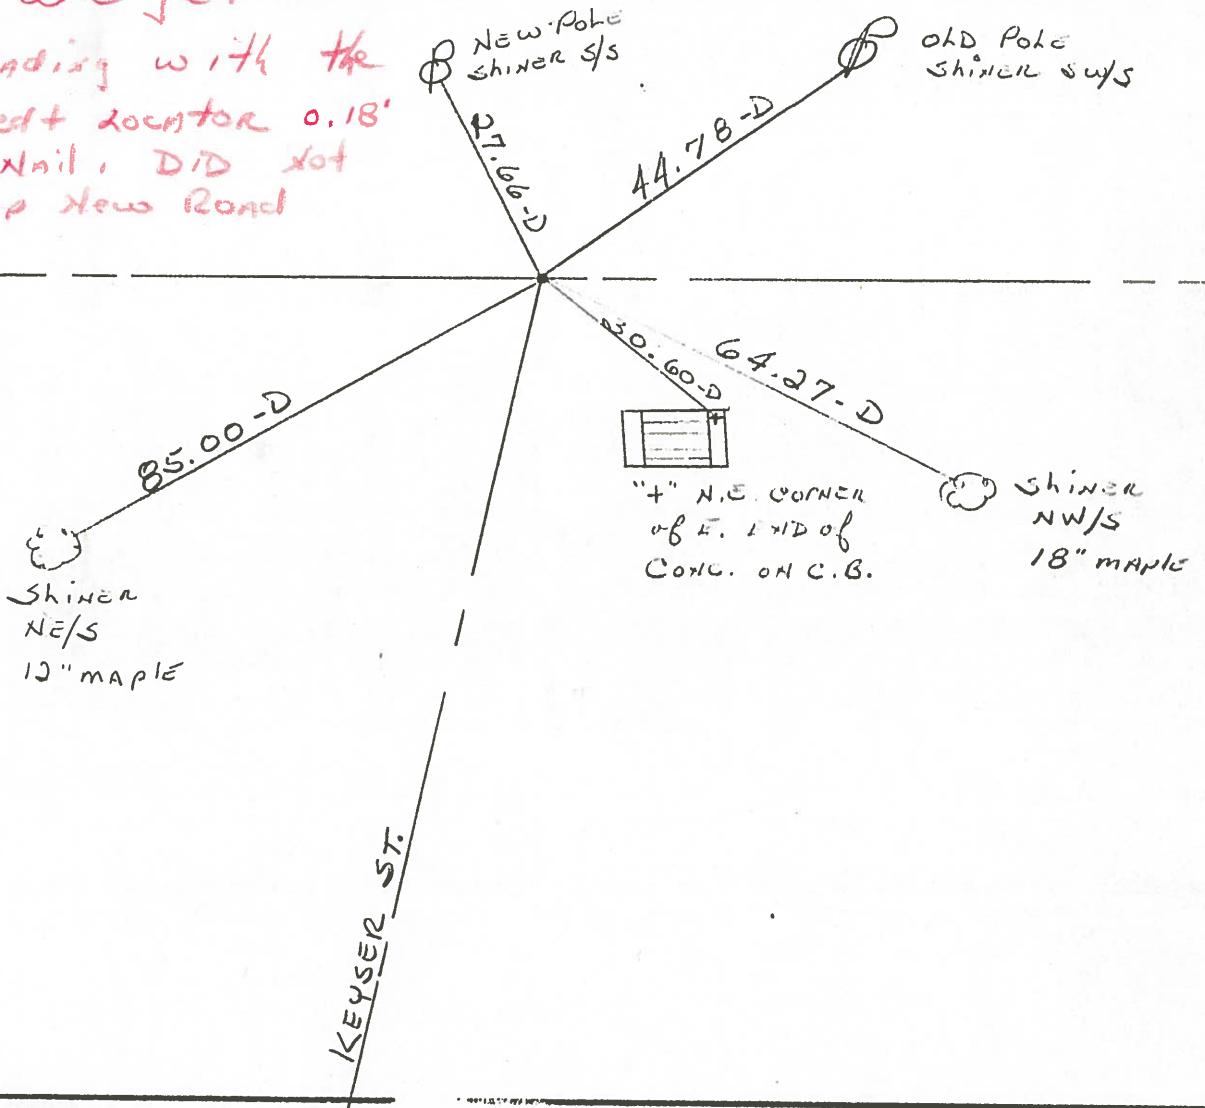

PERSONNEL	TITLE	PERSONNEL	TITLE	COUNTY	DATE
Stone				Henry	22 Oct. 74
Michalak				S. R. #18	WEATHER Cold
Deano				SEC. Holgate	TEMP. 50°
Curtis					

DESCRIPTION _____ Alignment _____ JOB NO. _____
 LEFT CENTER LINE RIGHT

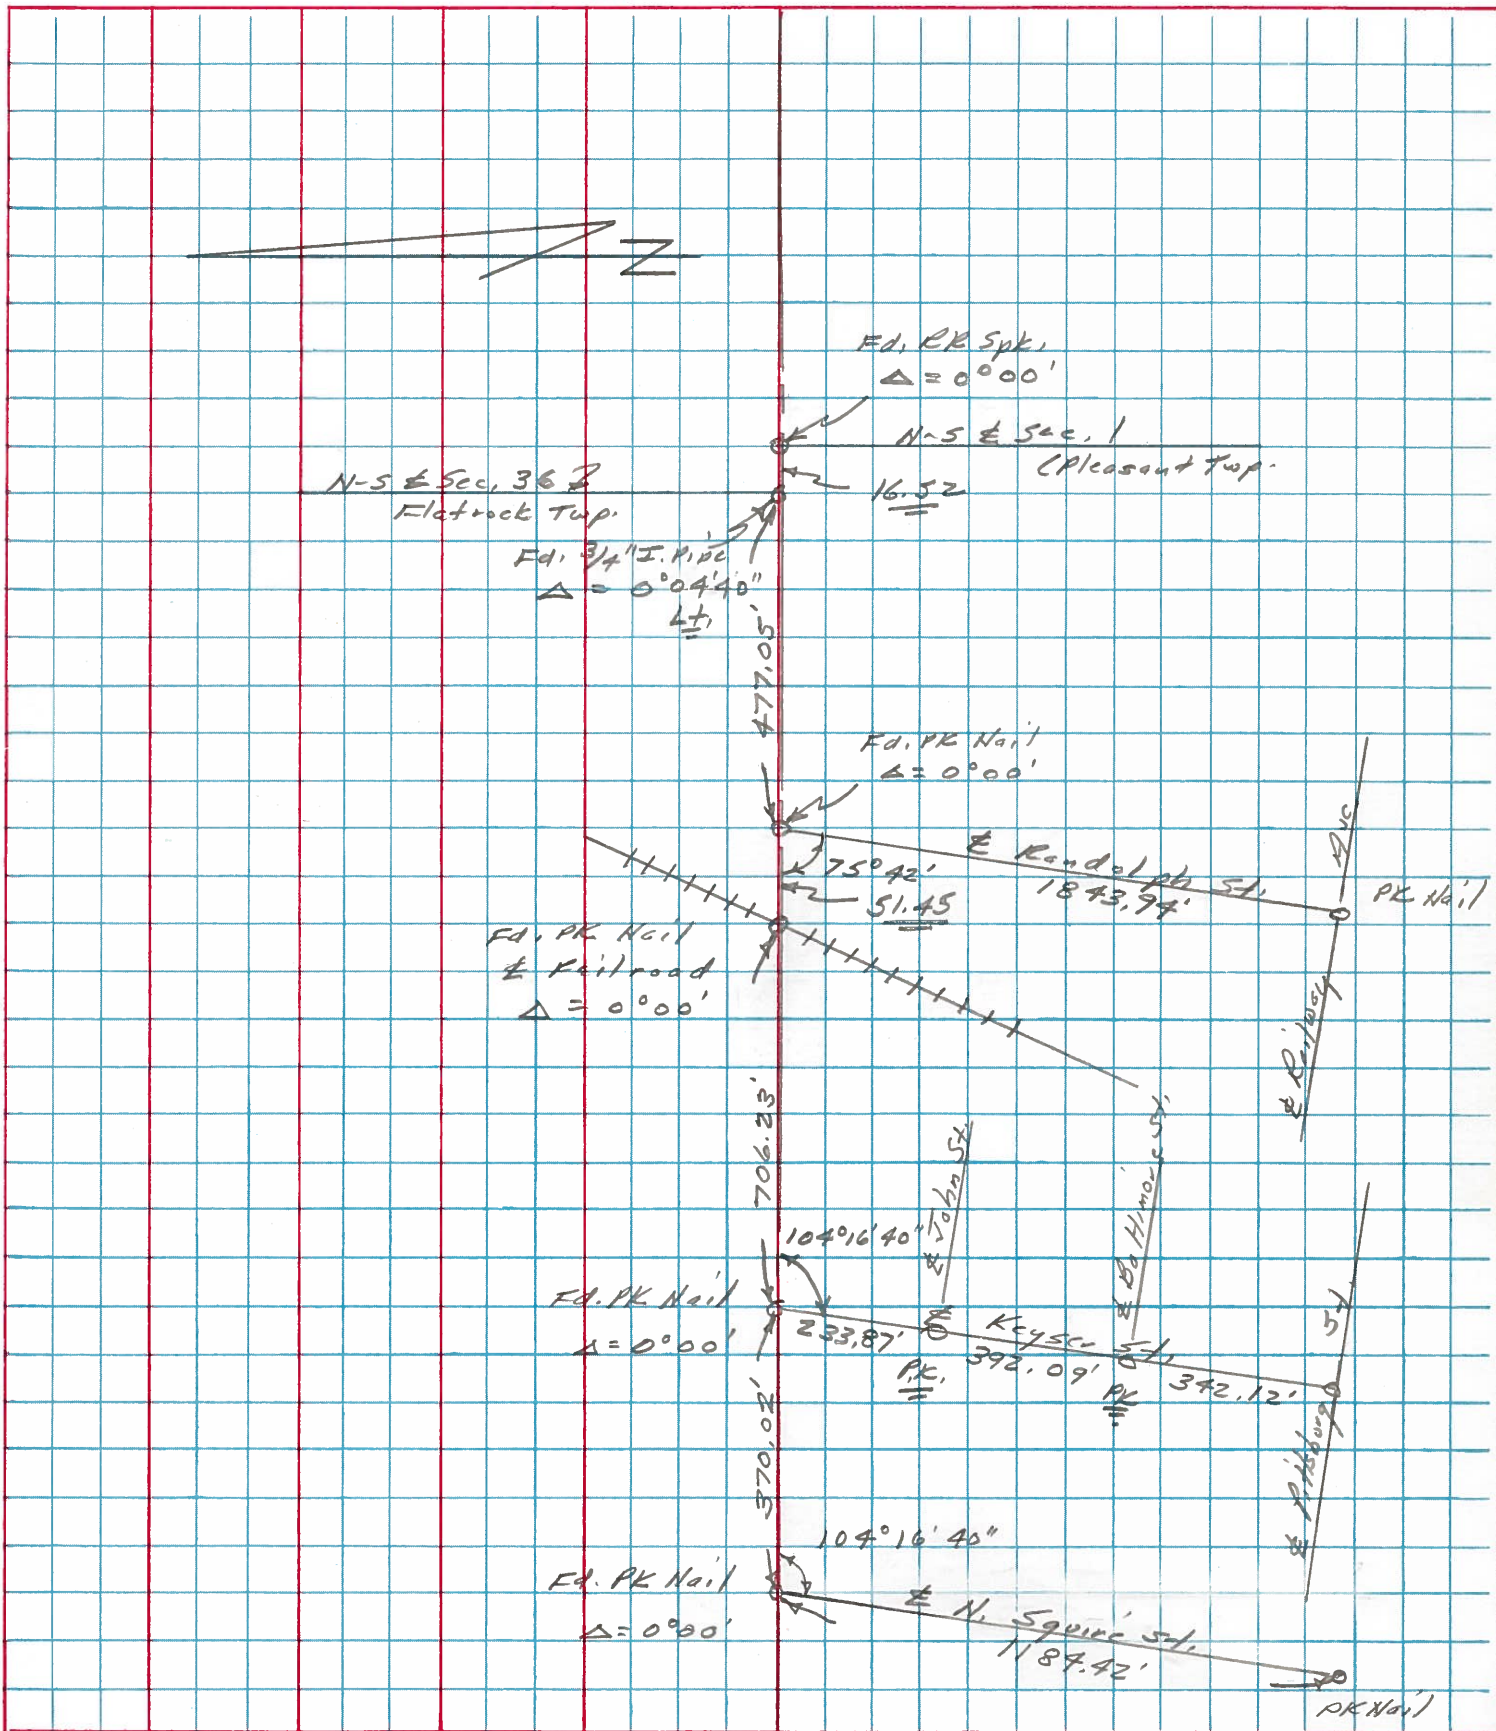

PERSONNEL	TITLE	PERSONNEL	TITLE	COUNTY	DATE	WEATHER
W. Denno				Henry	Aug. 20, '7	Warm
R. Michalak						
D. Curtis						

DESCRIPTION References To Control Points TEMP. 90°
 LEFT CENTER LINE RIGHT JOB NO. 02999(0)

