


O.D.O.T. DISTRICT 2 SURVEY OFFICE (USE ONLY)


PERSONNEL	REFERENCE NO.	15 A	SHEET	9	OF	31
NOTES	NUHFER	DATE	6/26/08	ROUTE	SR 18	
H.C.	MOSER	WEATHER	CLEAR	COUNTY	HENRY	
R.C.	NUHFER	TEMP.	85°	TOWNSHIP	MARION	
				SECTION	6	
				T	3 N R 7 E	

TYPE MONUMENT SM.R.R.SPIKE  
 ON SURFACE - ~~BELOW~~ ON \_\_\_\_\_  
~~LEFT~~ - CL PAV'T - RIGHT 1.7'  
7.7' TO RT EDGE PAVEMENT  
 S.L.M. 367+27

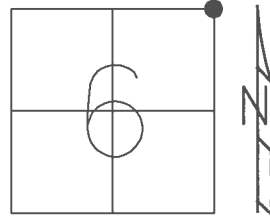

GRID: NORTHING: 582234.958 EASTING: 1530242.715

RECORD:  
 SET SM.R.R.SPIKE  
 6/13/89, MDB  
 FD SM.R.R.SPIKE  
 1/10/07, SAH  
 REFA15  
 6/27/08, KPM  
 SET MAG/WASHER  
 5/21/09, SAH  
 FD MAG/WASHER  
 REFA15  
 6/17/16, JMR

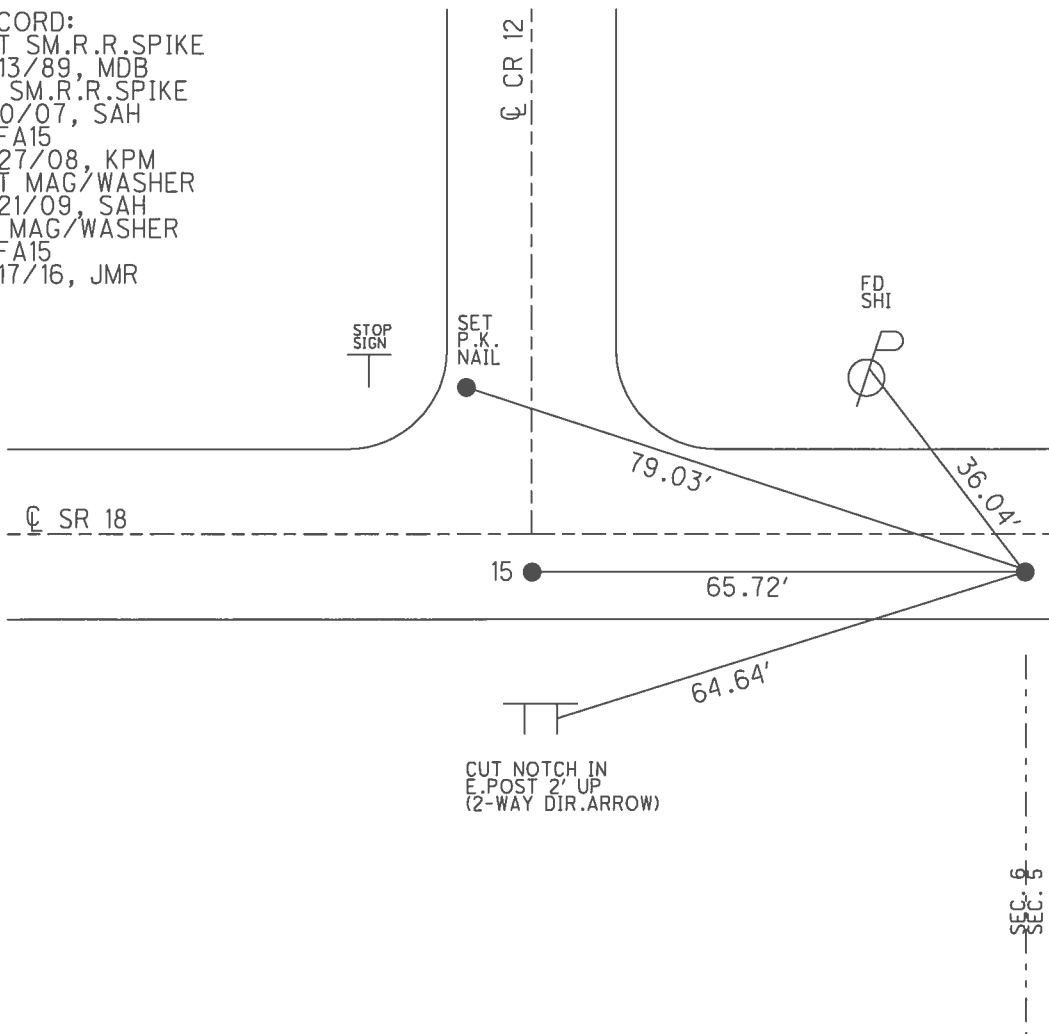

O.D.O.T. DISTRICT 2 SURVEY OFFICE (USE ONLY)

PERSONNEL

REFERENCE NO. 15 A

SHEET 9 OF 31

NOTES NUHFER

DATE 6/26/08

ROUTE SR 18

H.C. MOSER

WEATHER CLEAR

COUNTY HENRY

R.C. NUHFER

TEMP. 85°

TOWNSHIP MARION

SECTION 5,6

T 3 N R 7 E

TYPE MONUMENT SM.R.R.SPIKE


ON SURFACE - ~~BELOW~~ ON

~~LEFT~~ - Q PAV'T - RIGHT 1.7'

7.7' TO RT EDGE PAVEMENT

S.L.M. 367+27

Grid: Northing: 582234.972 Easting: 1530242.671

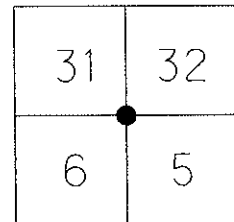


SET SM.R.R.SPIKE  
6/13/89, MDB

FD SM.R.R.SPIKE  
SAH, 1/10/07

GPS, REF A15  
KPM, 6/27/08

SET MAG/WASHER  
5/21/09, SAH

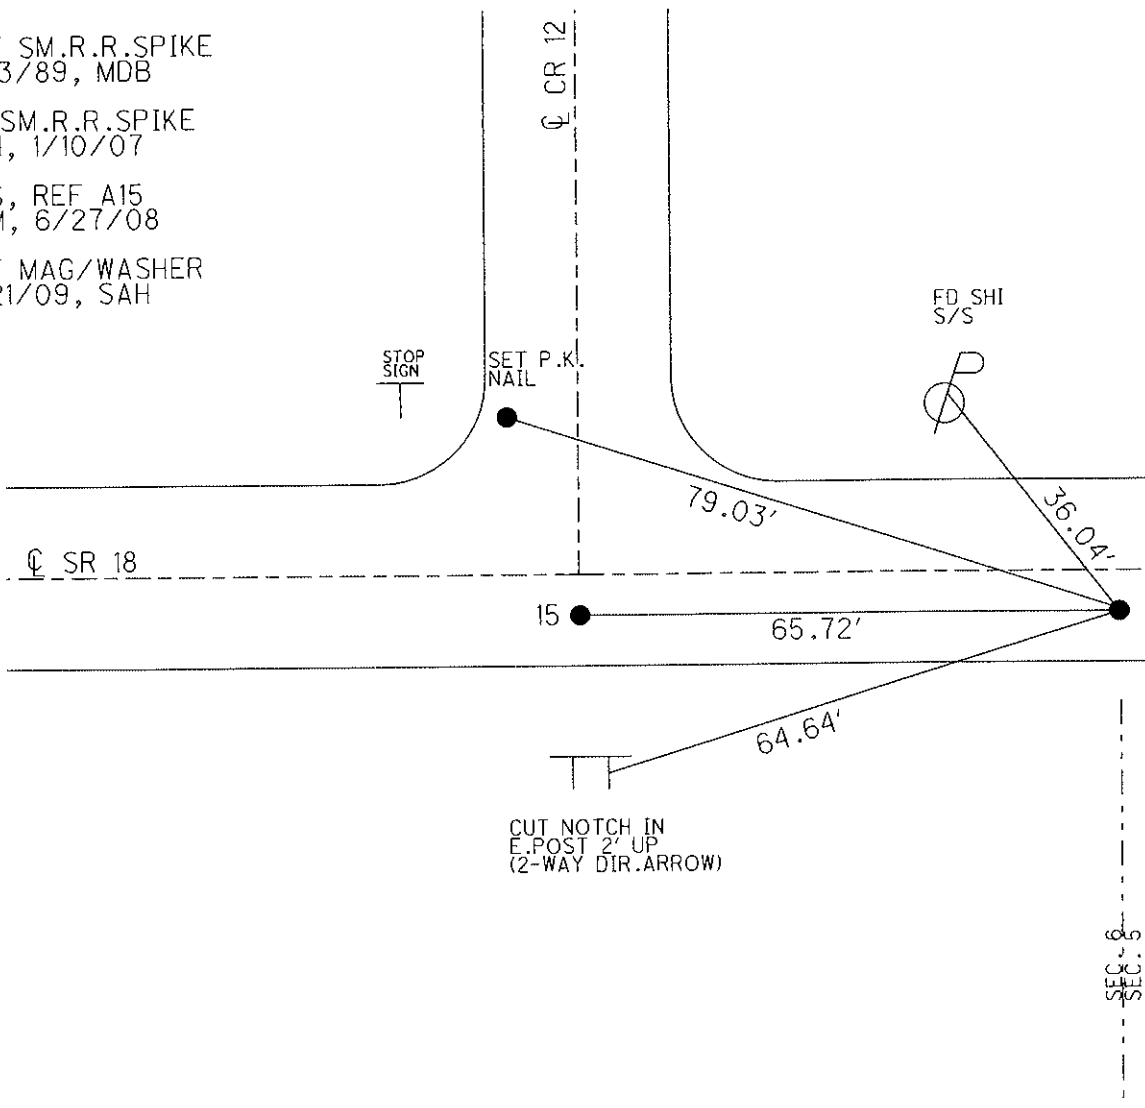

# O.D.O.T. DISTRICT 2 SURVEY OFFICE

PERSONNEL \_\_\_\_\_

REFERENCE NO. 15

SHEET 2 OF \_\_\_\_\_

NOTES BARNHISEL

H.C. " " "

R.C. Lochake

DATE 3-30-89

WEATHER cloudy - RAIN

TEMP. +40°

ROUTE SR 18

COUNTY HENRY

TOWNSHIP MARION

SECTION 5

T3 N R T E

TYPE MONUMENT \_\_\_\_\_

ON SURFACE - BELOW \_\_\_\_\_

LEFT - ~~C~~ PAV'T. - RIGHT 1.6' - 1.7'


8.1 TO RT EDGE PAVEMENT

S.L.M. 366+66 - 367+27

31	32
6	5



Set Sim RR Spt's  
 6-13-89  
 J.J.B.

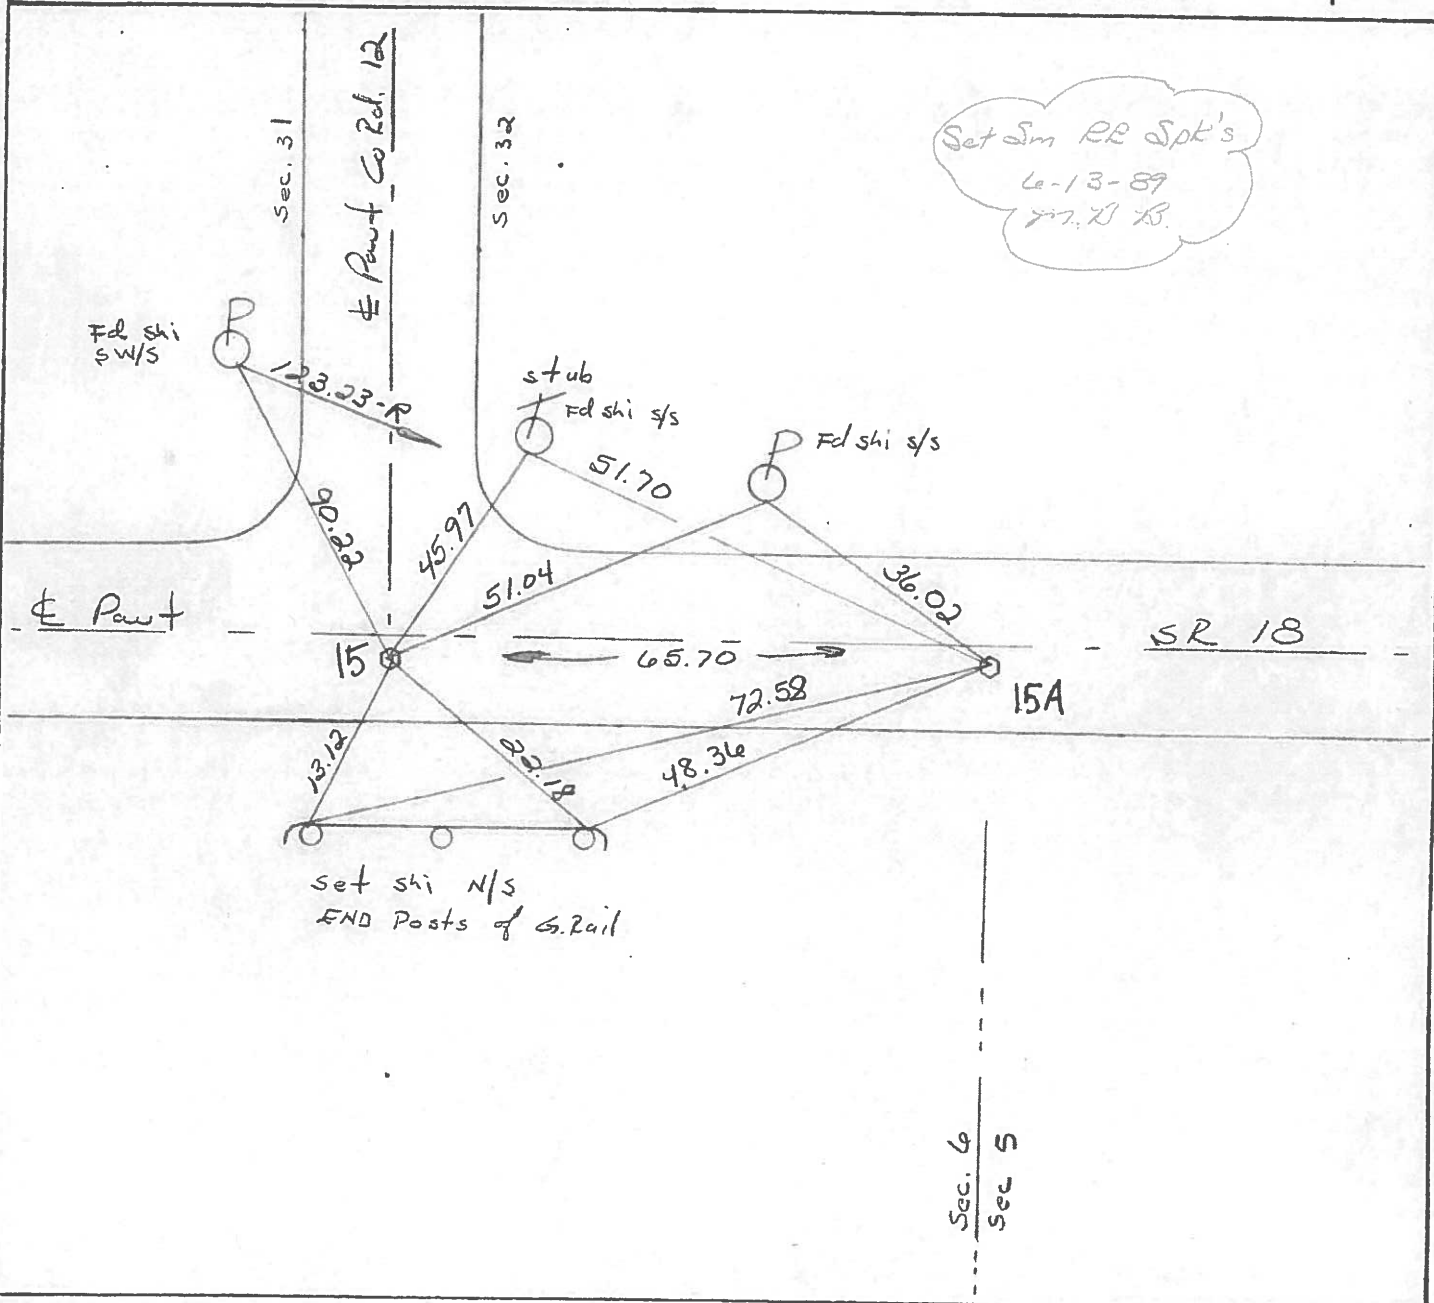

County HENRY S.R. 18

Date 5-28-81

Township MARION


Weather CLEAR

Section 5

Temp. +70°

T3N, R7E

Personnel S. Hoffman

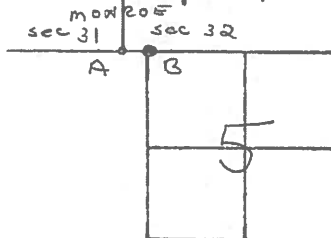


#15

C. Loehrke  
J. Householdor

PT. A. Fd. R.R. SPK @ SURFACE PROJECT STA ± 366 + 84  
SET P.K 7.8' S EDGE PAVT  
WASHER — N. EDGE PAVT

PT. B Fd. R.R. SPK @ SURFACE PROJECT STA ± 367 + 50  
11.6' N. EDGE PAVT  
8.1' S. EDGE PAVT  
SET SMALL R.R. SPK.

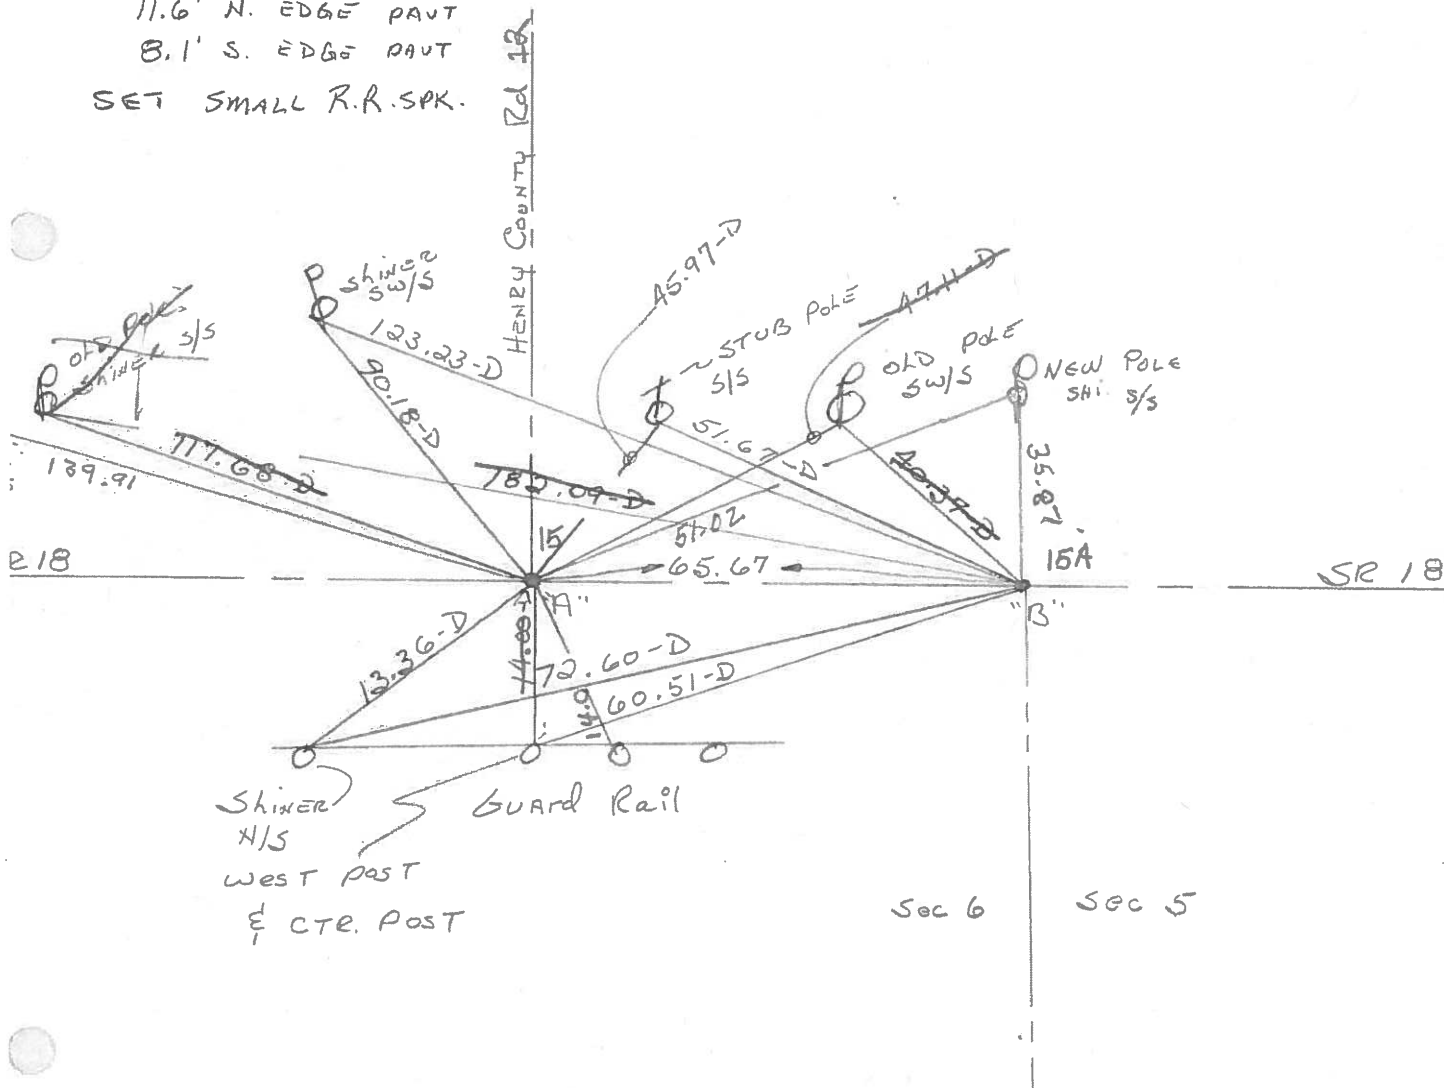

PERSONNEL TITLE PERSONNEL TITLE

Stone

COUNTY Henry

DATE 29 Oct. 74

Deno

S. R. #18

WEATHER Cloudy

Michalak

SEC. Monroe - Marion Twp. TEMP. 60°

Curtis

DESCRIPTION

Alignment

JOB NO.

LEFT

CENTER LINE

RIGHT

