


O.D.O.T. DISTRICT 2 SURVEY OFFICE (USE ONLY)

PERSONNEL _____ REFERENCE NO. 20 B SHEET 20 OF 31
 NOTES NIESE DATE 3/12/21 ROUTE SR 18
 H.C. RHOADES WEATHER SUNNY COUNTY HENRY
 R.C. _____ TEMP. 50° TOWNSHIP MARION
 DWG BY NIESE PID PAVE TRAIN SECTION 3
 T 3 N R 7 E


TYPE MONUMENT LG.R.R.SPIKE
~~ON SURFACE~~ - BELOW 1"
 OFFSET C PAVEMENT 20.5' LT : ~~RT~~
 - TO - EDGE PAVEMENT
 STATION: 525+47

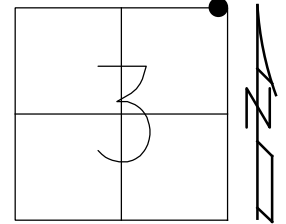

HORZ.DATUM: NAD83(2011) GEOID: NAVD88 2012A
 GRID: NORTHING: 582031.179 EASTING: 1546046.403

RECORD:
 FD SM.R.R.SPIKE AT
 SURFACE, 18.5' W.OF
 C OF SR 109
 5/18/98, MRC
 SET P.K./WASHER
 9/24/98, MDB
 FD P.K./WASHER
 1/10/07, SAH
 6/27/08, KPM
 FD SM.R.R.SPIKE
 1" DOWN
 REFB20
 6/20/16, JFO
 UNCOVERED
 11/13/17, JFO
 FD LG.R.R.SPIKE
 1" DOWN
 6/9/20, JFO
 3/12/21, JMR

NOTE: REF 14 SR 109
 DIST. 20B - 21 = 26.65'

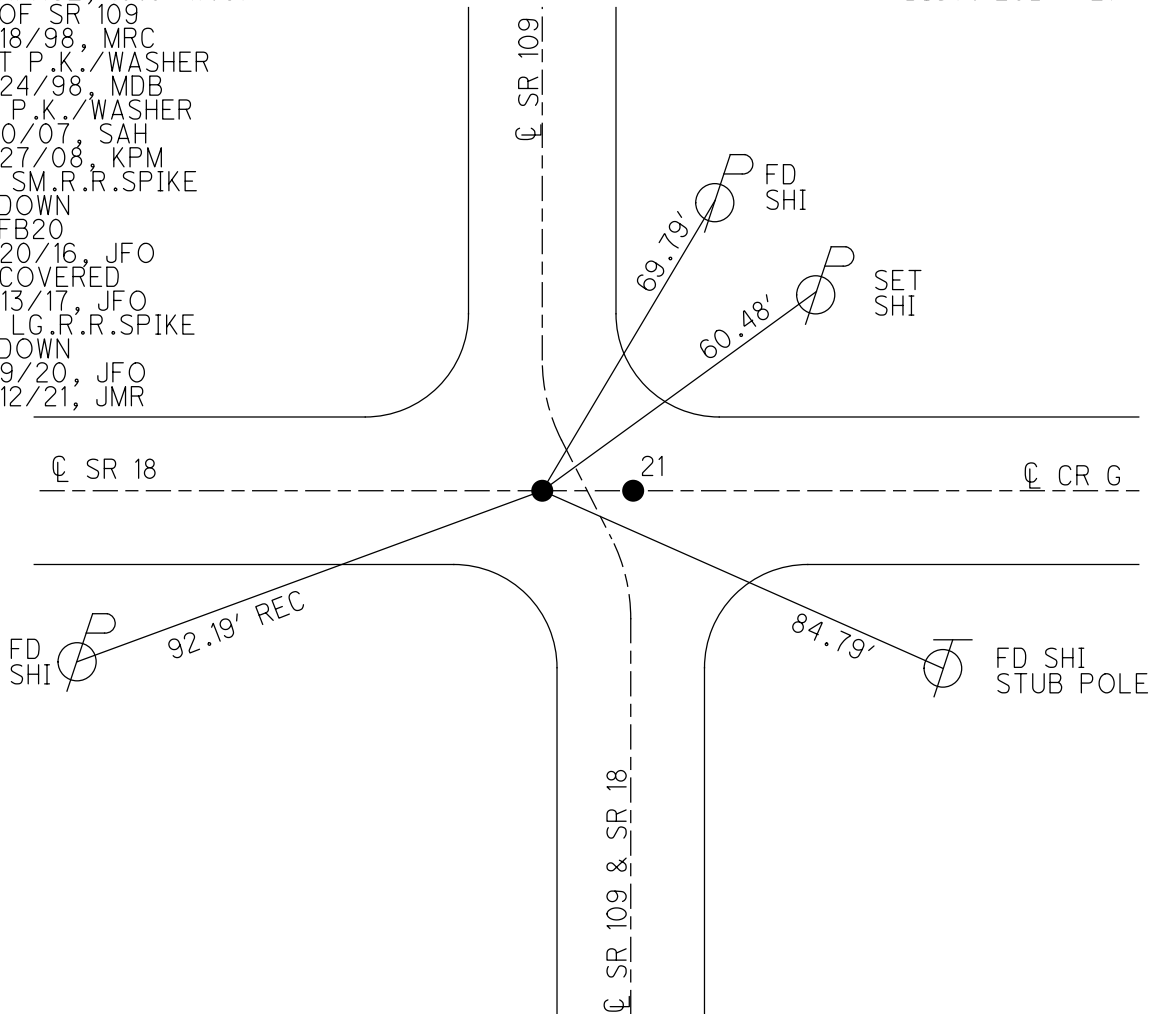

O.D.O.T. DISTRICT 2 SURVEY OFFICE (USE ONLY)

PERSONNEL	REFERENCE NO.	20 B	SHEET	20	OF	31
NOTES	NUHFER	DATE	6/26/08	ROUTE	SR 18	
H.C.	MOSER	WEATHER	SUNNY	COUNTY	HENRY	
R.C.	NUHFER	TEMP.	85°	TOWNSHIP	MARION	
				SECTION	3	
				T	3	N
				R	7	E

TYPE MONUMENT MAG/WASHER


ON SURFACE - ~~BELOW~~ ON

~~LEFT~~ - PAV'T - RIGHT 2', 20.5' RT OF SR 109

 TO EDGE PAVEMENT


S.L.M. 525+47

GRID: NORTHING: 582031.148 EASTING: 1546046.448

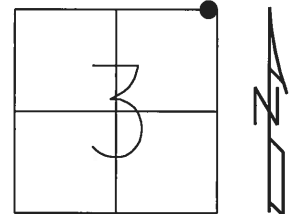

NOTE: MONROE TWP
SEC 34 SE/COR

RECORD:
FD SM.R.R.SPIKE AT
SURFACE, 18.5' W.OF
CL OF SR 109
5/18/98, MRC
SET P.K./WASHER
9/24/98, MDB
FD P.K./WASHER
1/10/07, SAH
REF21
6/27/08, KPM
FD SM.R.R.SPIKE
1" DOWN
REFB20
6/20/16, JFO
UNCOVERED
11/13/17, JFO

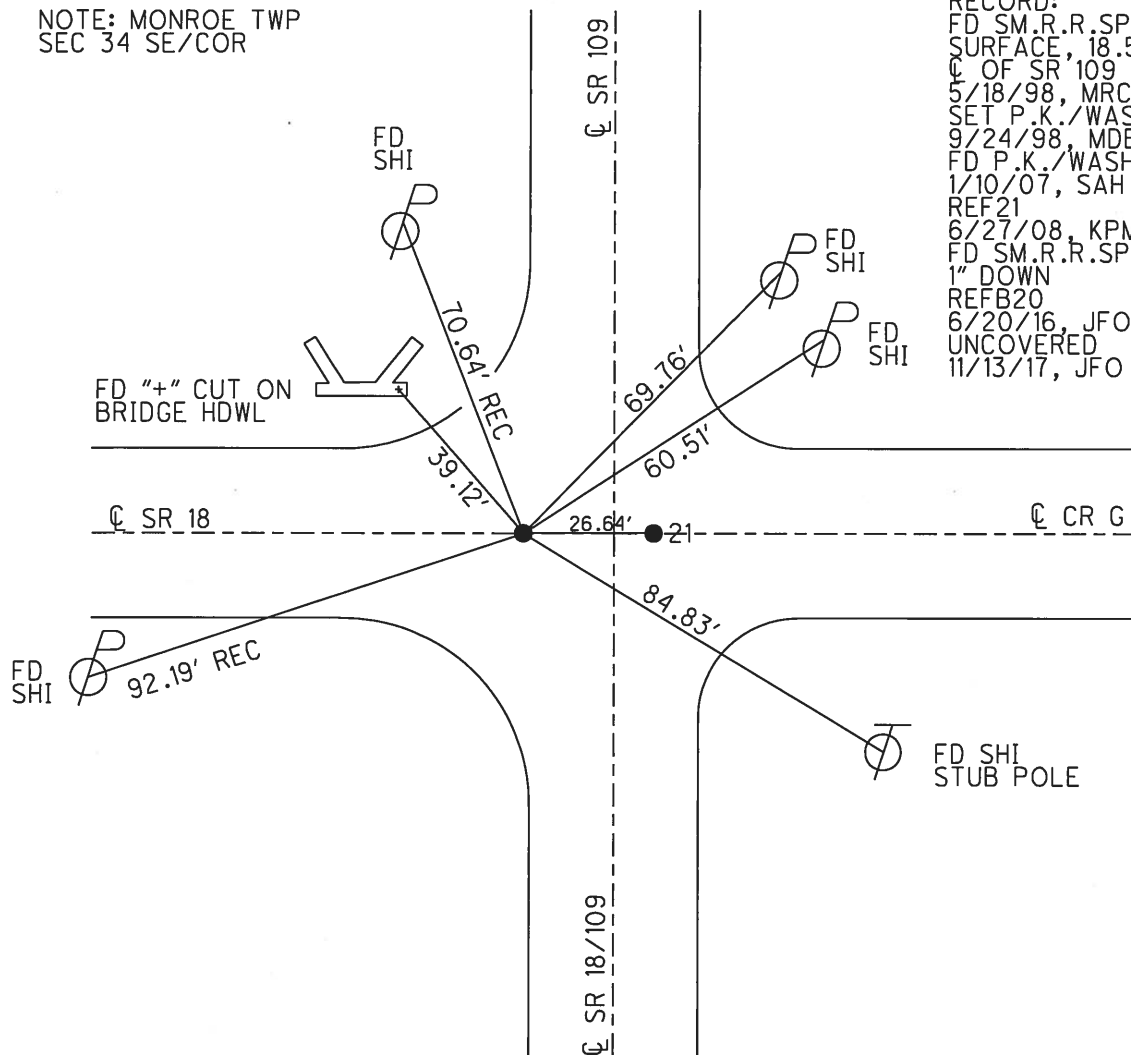

O.D.O.T. DISTRICT 2 SURVEY OFFICE (USE ONLY)

PERSONNEL

REFERENCE NO. 20 B

SHEET 20 OF 31

NOTES NUHFER

DATE 6/26/08

ROUTE SR 18

H.C. MOSER

WEATHER SUNNY

COUNTY HENRY

R.C. NUHFER

TEMP. 85°

TOWNSHIP MARION

SECTION 2

T 3 N R 7 E


TYPE MONUMENT MAG/WASHER

ON SURFACE - ~~BELOW~~ ON

LEFT - CL PAV'T - ~~RIGHT~~ 20.5' of CL SR 109


TO EDGE PAVEMENT

S.L.M. 525+47

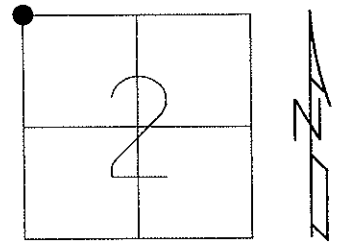

Grid: Northing: 582031.344

Easting: 1546046.346

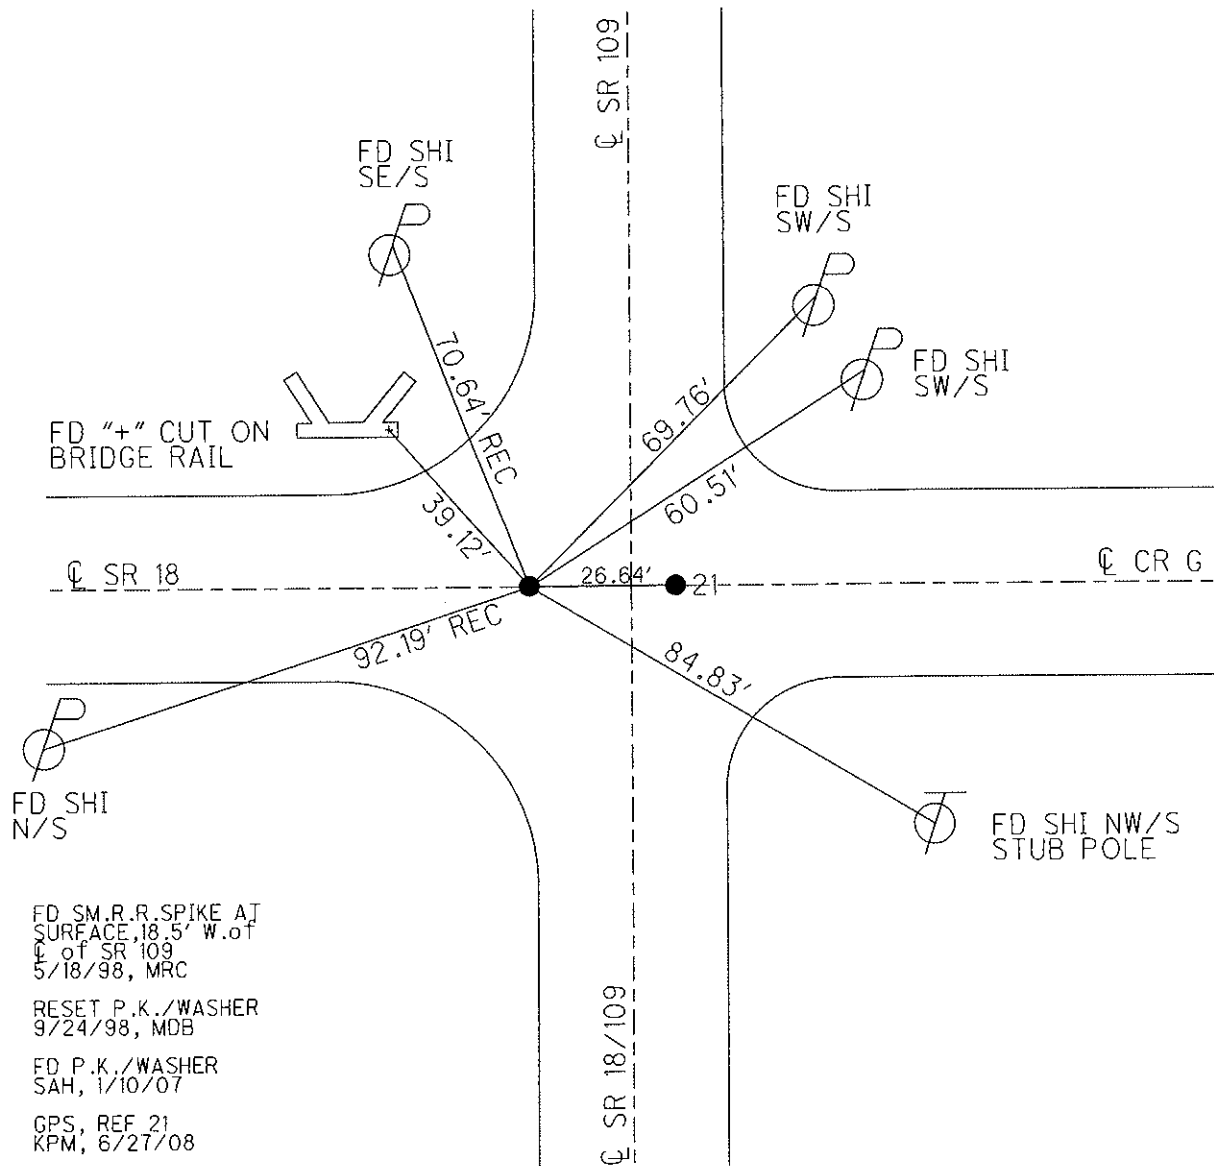

O.D.O.T. DISTRICT 2 SURVEY OFFICE

PERSONNEL _____

REFERENCE NO. 21

SHEET 8 OF _____

NOTES CANTERBURY

H.C. Rousos

R.C. Huss

DATE 5-18-98

WEATHER FAIR

TEMP. +80° F

ROUTE 18


COUNTY HENRY

TOWNSHIP MARION

SECTION 2

T 3 N R 7 E


TYPE MONUMENT	A - SM. R.R. SPR	B - R.R. SPR
ON SURFACE -	<u>BELOW</u> SURFACE	SURFACE
LEFT -	← PAV'T. -	RIGHT → PAV'T.
TO	EDGE PAVEMENT	
S.L.M. A =	525+47	B = 525+69

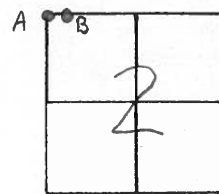

Pt 'A' Fd. SM. R.R. SPR. @ SURFACE
 20.1' W OF E PAVT S.R. 109
 @ S.E. CORNER OF SEC. 34 MONROE TWP.

Pt 'B' Fd. R.R. SPR. @ SURFACE
 SET BY COUNTY @ N.E. CORNER SEC. 3 MARION TWP
 6.5' E. OF E PAVT. S.R. 109

RESET P.N./WASHERS @ BOTH
 9-24-98
 M.R.C.

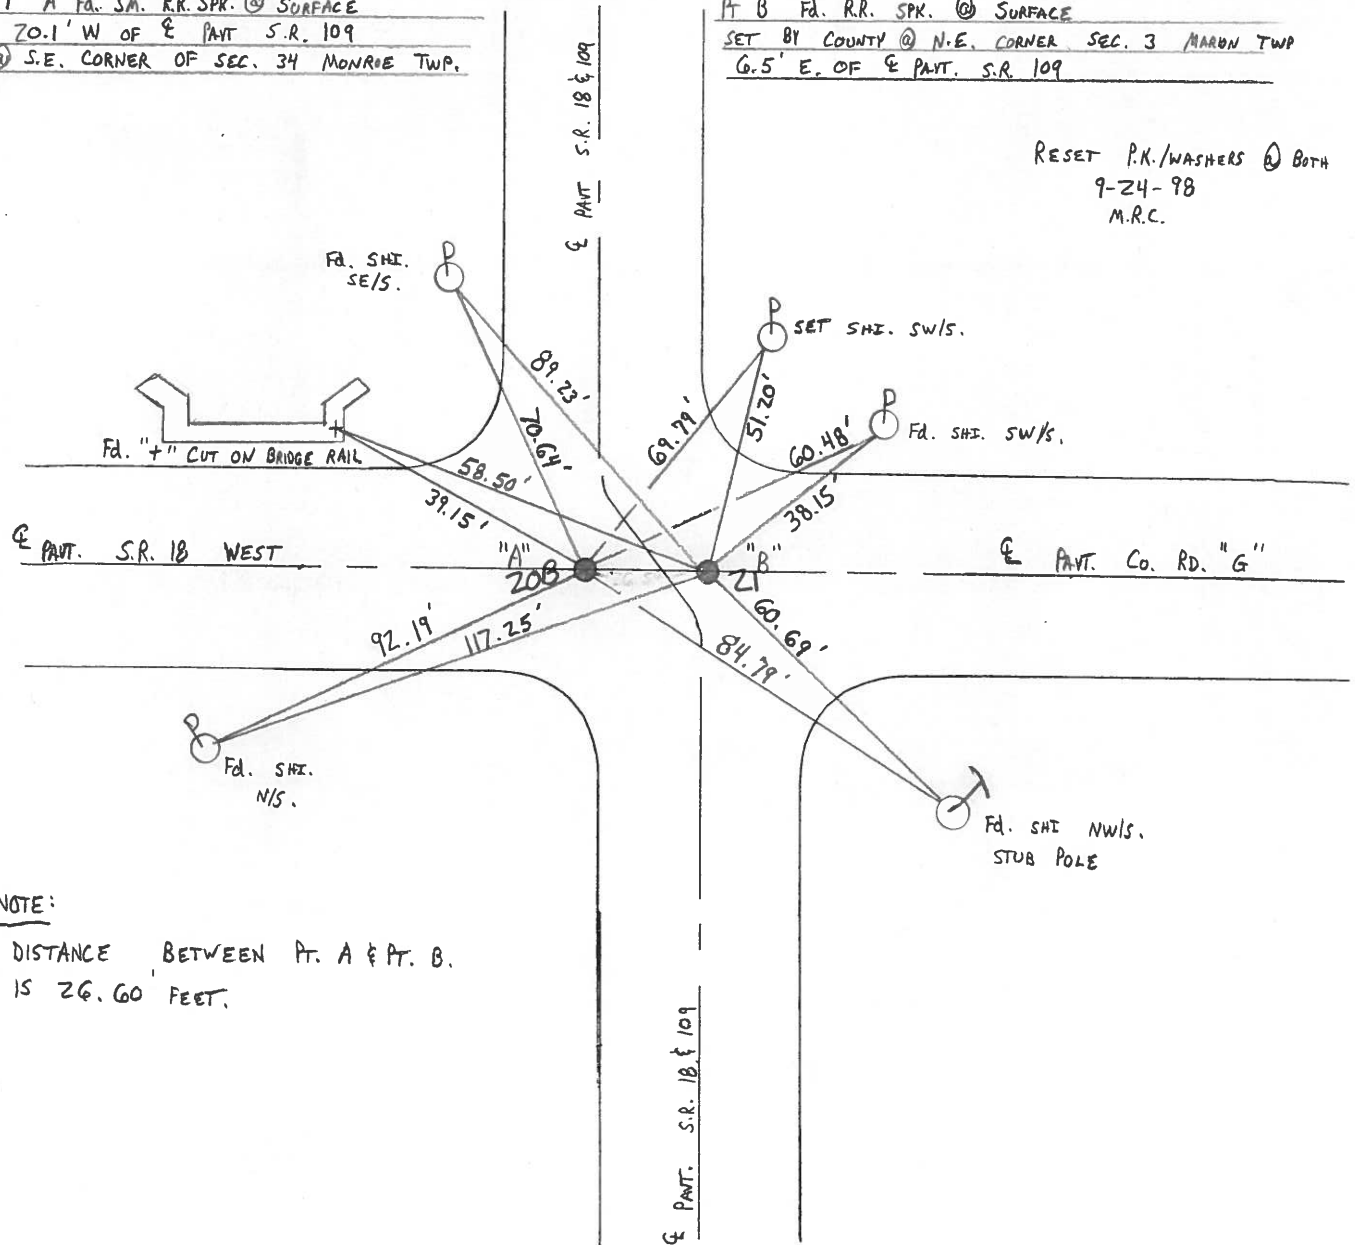

NOTE:
 DISTANCE BETWEEN Pt. A & Pt. B.
 IS 26.60 FEET.

O.D.O.T. DISTRICT 2 SURVEY OFFICE

PERSONNEL _____

REFERENCE NO. 21

SHEET 8 OF _____

NOTES BARNHISEL

H.C. _____

DATE 4-3-89

ROUTE 18

R.C. Loehrke

WEATHER cloudy

COUNTY HENRY

TEMP. +48°

TOWNSHIP MARION

SECTION 2

T 3 N R 7 E


TYPE MONUMENT PK&WASHER, PK&WASHER

ON SURFACE - ~~BELOW~~ YES, YES


LEFT- & PAV'T. - RIGHT 1.3 R.(A), (B) 6.5L

TO _____ EDGE PAVEMENT

S.L.M. "A" 525+47, "B" 525+69

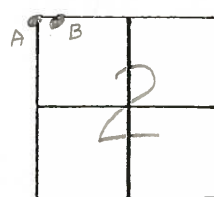

Set Sm RR Sprs
6-23-89
m D B

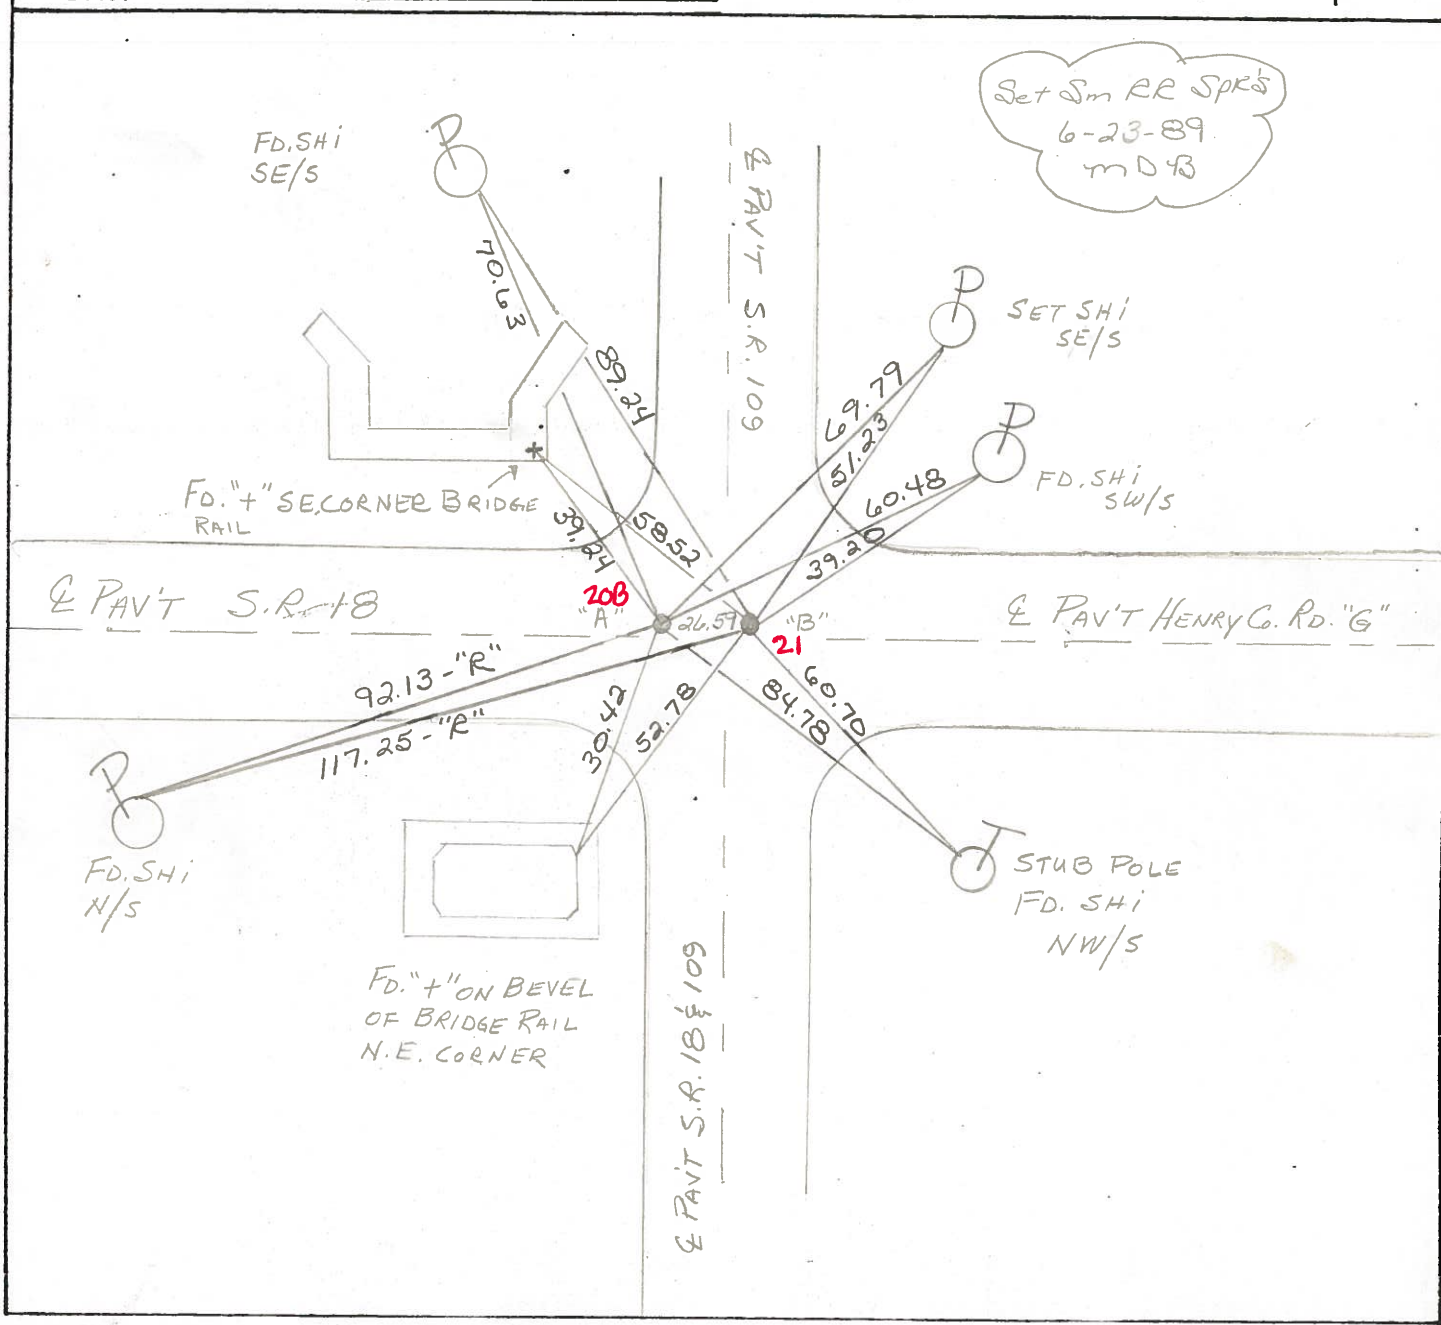

Q.D.O.T. DISTRICT 2 SURVEY OFFICE

SHEET _____ OF _____

County HENRY S.R. 109 & 18

Date April 26, 83

Township MONROE & MARION

Weather CLEAR

Section 34 & 3

Temp. +65°


T.N, R.E

Personnel HOFFMAN

LOHRKE

BARNHISEL

#21

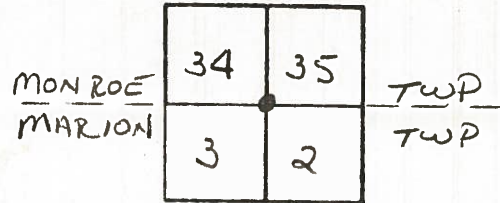


PT "A" Fd small RR SPK @ SURFACE
2011' West of & PAUT SR 109
@ S.E. CORNER SEC. 34, MONROE TWP

PT "B" Fd RR SPK @ SURFACE
Set BY COUNTY @ N.E. CORNER
SEC 3, MARION TWP.

6.5' EAST of & PAUT SR 109

SLM SR 109 = 316 + 81

SLM SR 18 = 525 + 51

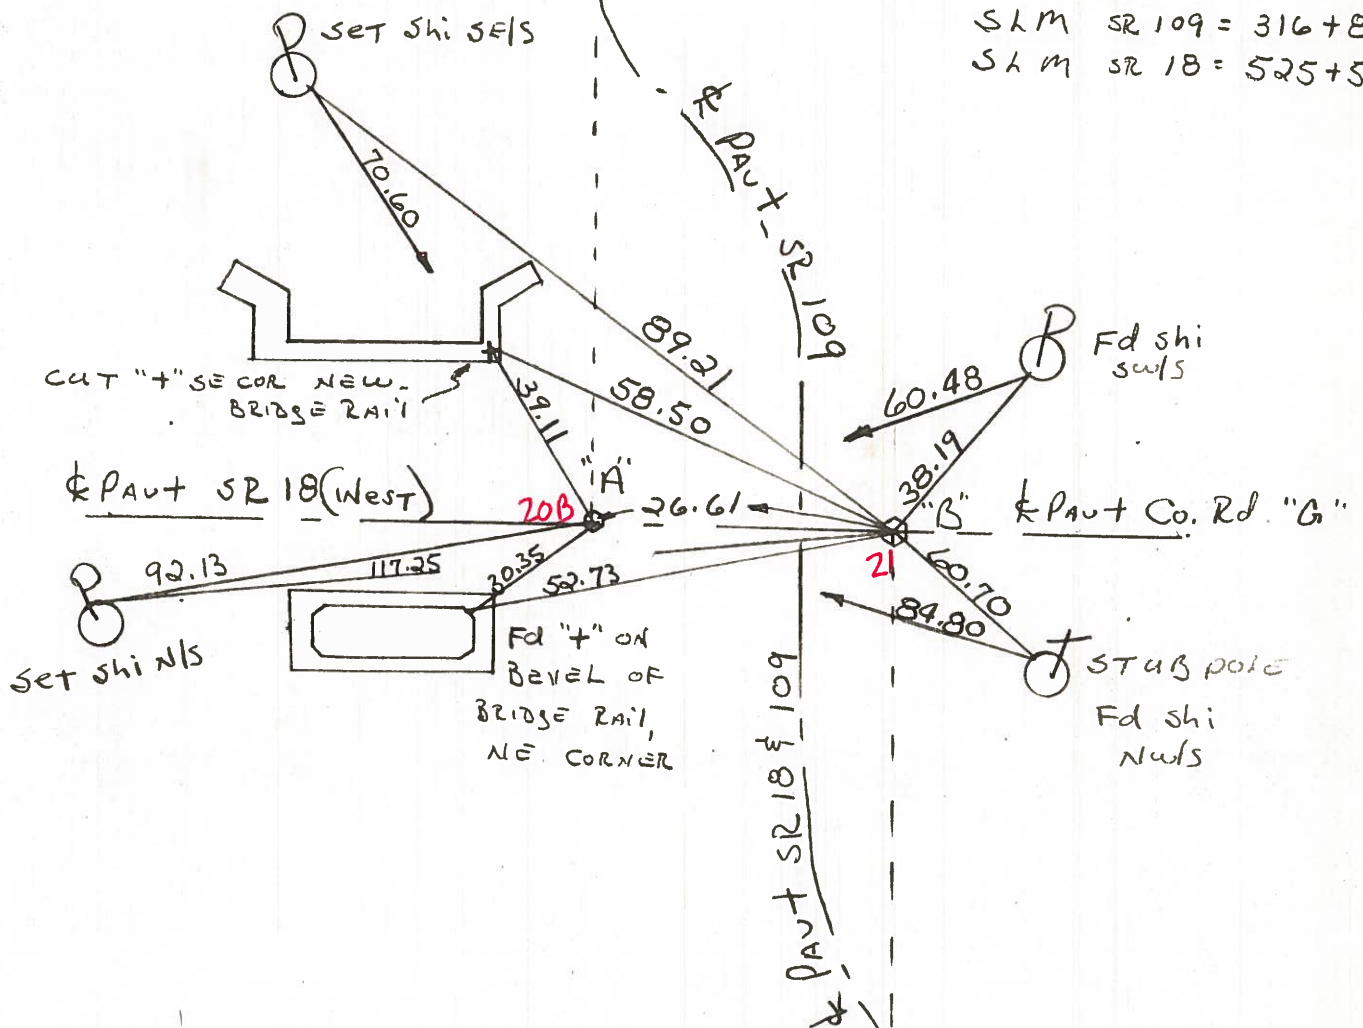

PERSONNEL TITLE PERSONNEL TITLE

Stone
Michaelak
Dunn
Curtis

COUNTY Henry DATE 9 Jan. 75

S. R. #18 WEATHER Cloudy

SEC. Monroec-Madison Twp. TEMP. 41°

DESCRIPTION Alignment LEFT CENTER LINE RIGHT JOB NO.

