

O.D.O.T. DISTRICT 2 SURVEY OFFICE (USE ONLY)

PERSONNEL _____

REFERENCE NO. 23

SHEET 25 OF 31

NOTES CANTERBURY

DATE 8/18/98

ROUTE SR 18,109

H.C. CANTERBURY

WEATHER PTLY CLDY

COUNTY HENRY

R.C. ROUSOS

TEMP. 80°

TOWNSHIP MARION

SECTION 3

T 3 N R 7 E

TYPE MONUMENT SM.R.R.SPIKE



ON SURFACE - ~~BELOW~~ ON _____

~~LEFT~~ - Q PAV'T - RIGHT 6'

_____ TO _____ EDGE PAVEMENT

S.L.M. 578+21

Grid: Northing: _____ Easting: _____

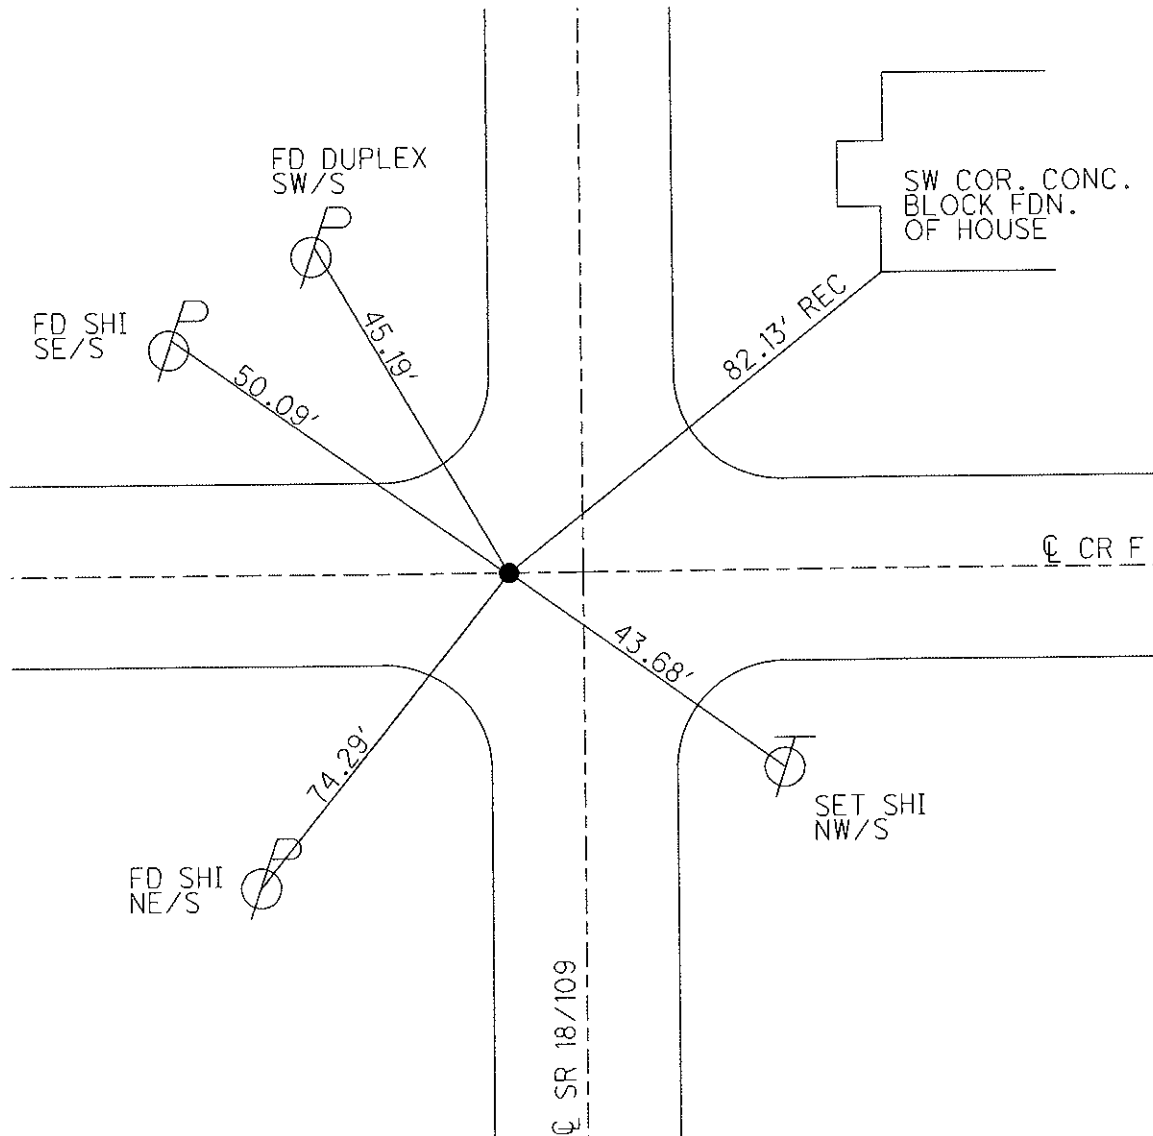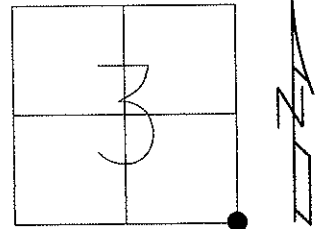

O.D.O.T. DISTRICT 2 SURVEY OFFICE

PERSONNEL _____

REFERENCE NO. 23

SHEET 12 OF _____

NOTES CANTERBURY

H.C. CANTERBURY

R.C. Rousos

DATE 8-18-98

WEATHER PTLY CLDY.

TEMP. +80° F

ROUTE 18 & 109

COUNTY HENRY

TOWNSHIP MARION

SECTION 3

T 3 N R 7 E



TYPE MONUMENT SM. R.R. SPK.

ON SURFACE - ~~BELOW~~ ON SURFACE

~~LEFT - & PART.~~ - RIGHT 6' W. OF & PART

TO EDGE PAVEMENT ON & C.R. EAST

S.L.M. 578 + 21

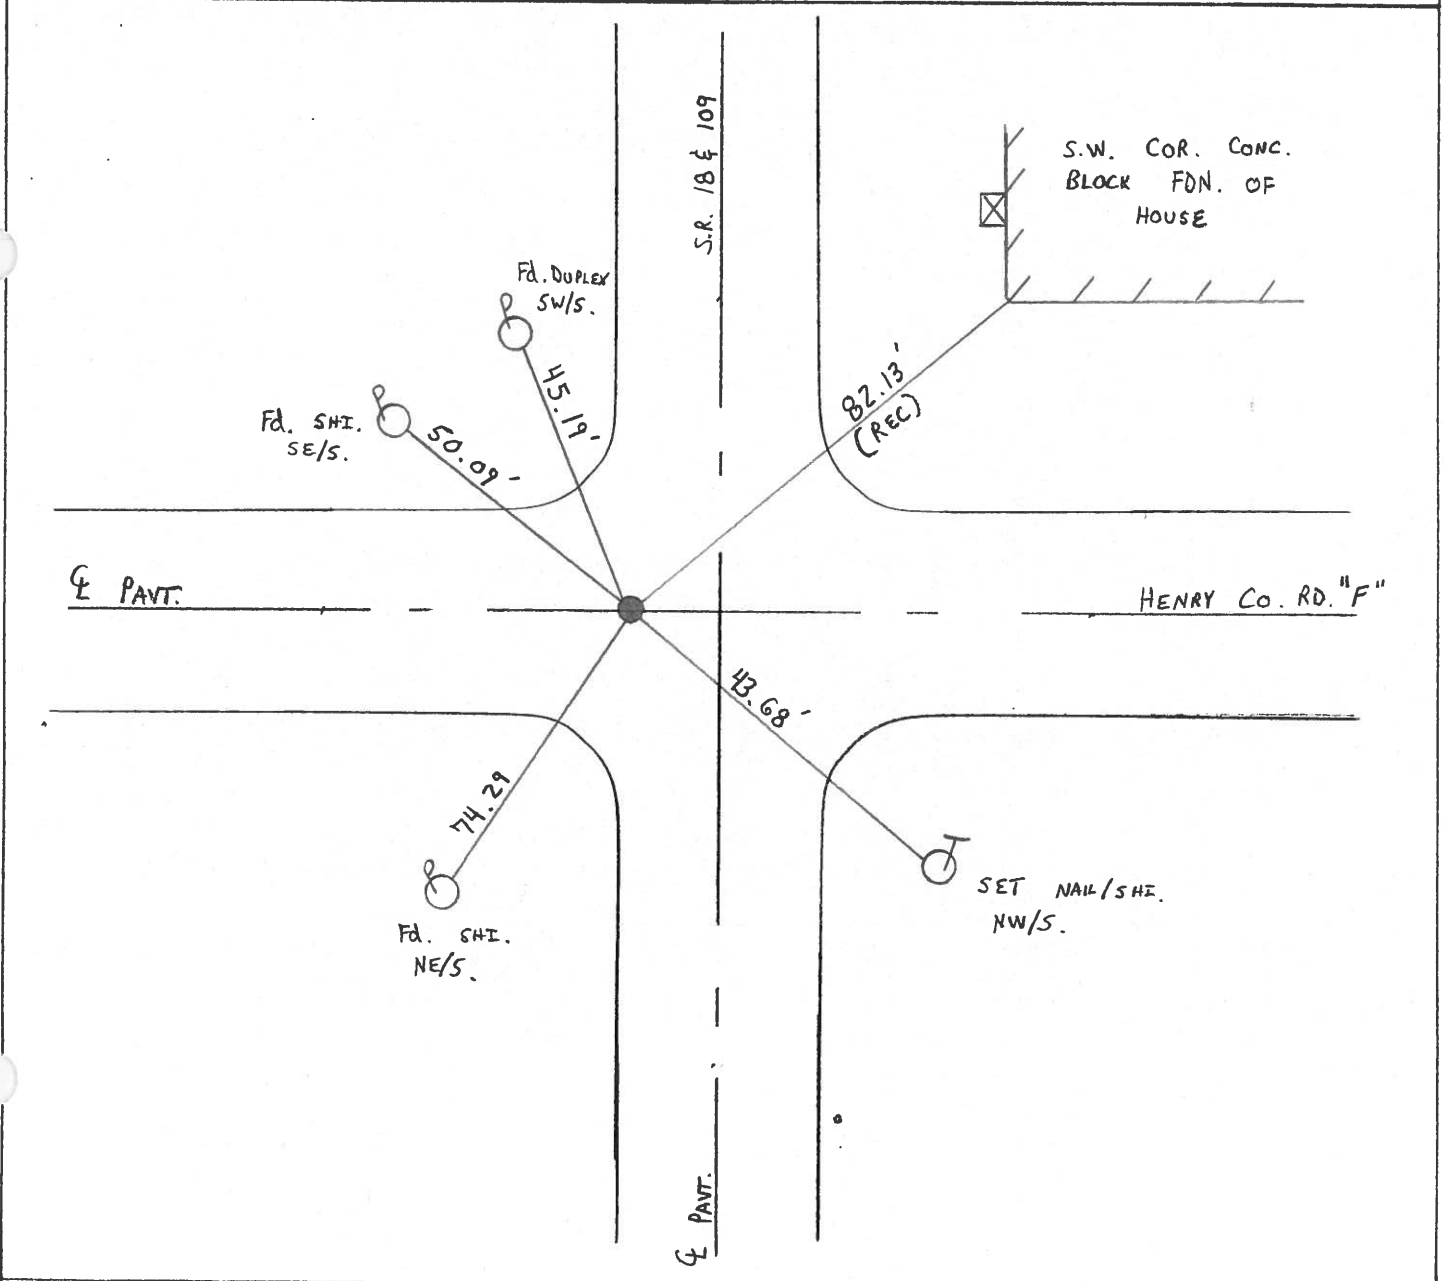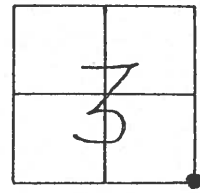

O.D.O.T. DISTRICT 2 SURVEY OFFICE

PERSONNEL _____

REFERENCE NO. 23

SHEET 12 OF _____

NOTES BARNHISEL

H.C. " "

R.C. Loehake

DATE 4-3-89

WEATHER cloudy

TEMP. +48°

ROUTE 18 & 109

COUNTY HENRY

TOWNSHIP MARION

SECTION 3

T 3 N R 7 E


TYPE MONUMENT PK & WASHER

ON SURFACE - BELOW YES

LEFT - 0 PAV'T. - RIGHT 7.0'


 TO EDGE PAVEMENT

S.L.M. 578+310

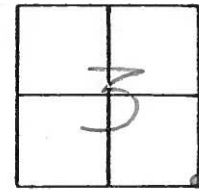

(5x7' S. & OF HENRY Co.
RD. "F." TO THE WEST.)

Set 5m RR Spk
6-23-89
mDB

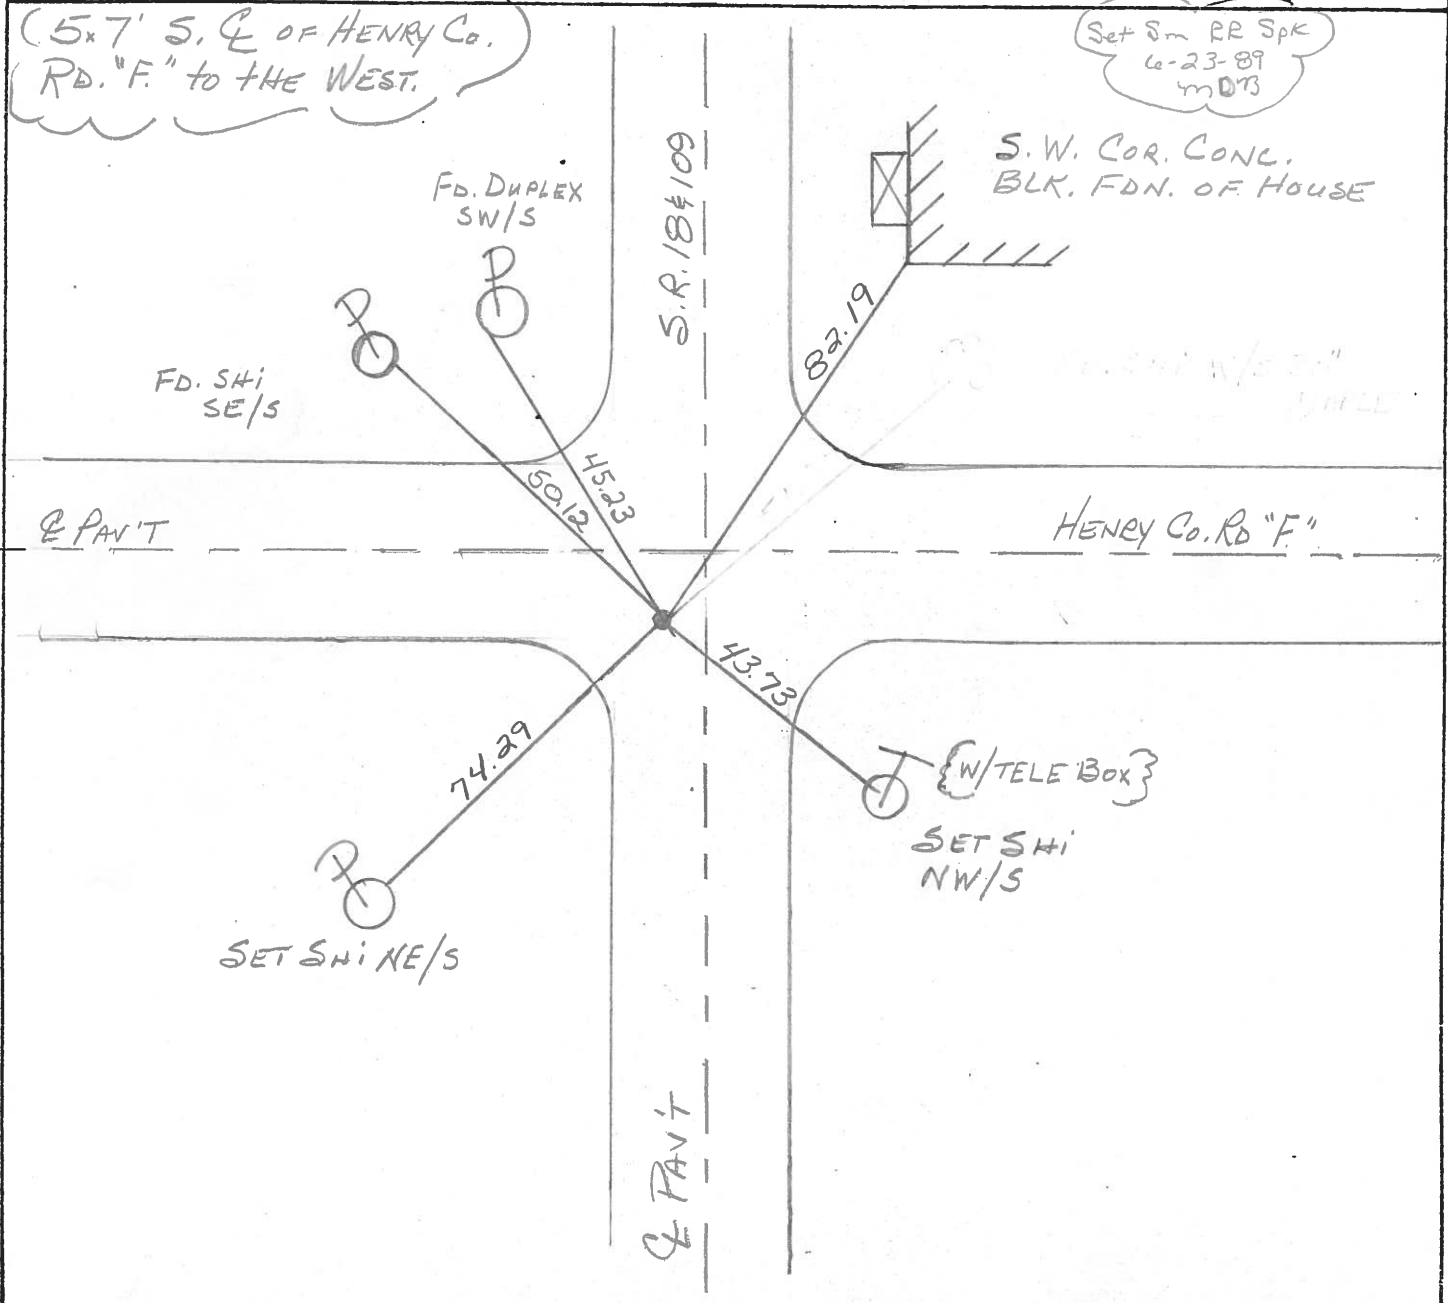

O.D.O.T. DISTRICT 2 SURVEY OFFICE

SHEET 19 OF

County HENRY S.R. 18-109

Date 5-29-81

Township MARION

Weather PARTLY CLOUDY

Section 3

Temp. +75°


T3N, R7E

Personnel J. Hoffmann


C. Doehrke

L. HOUSEHOLDER


#23

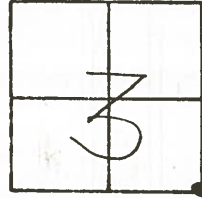

Fd. R.R. SPK @ SURFACE
6' w. of & PAUT.

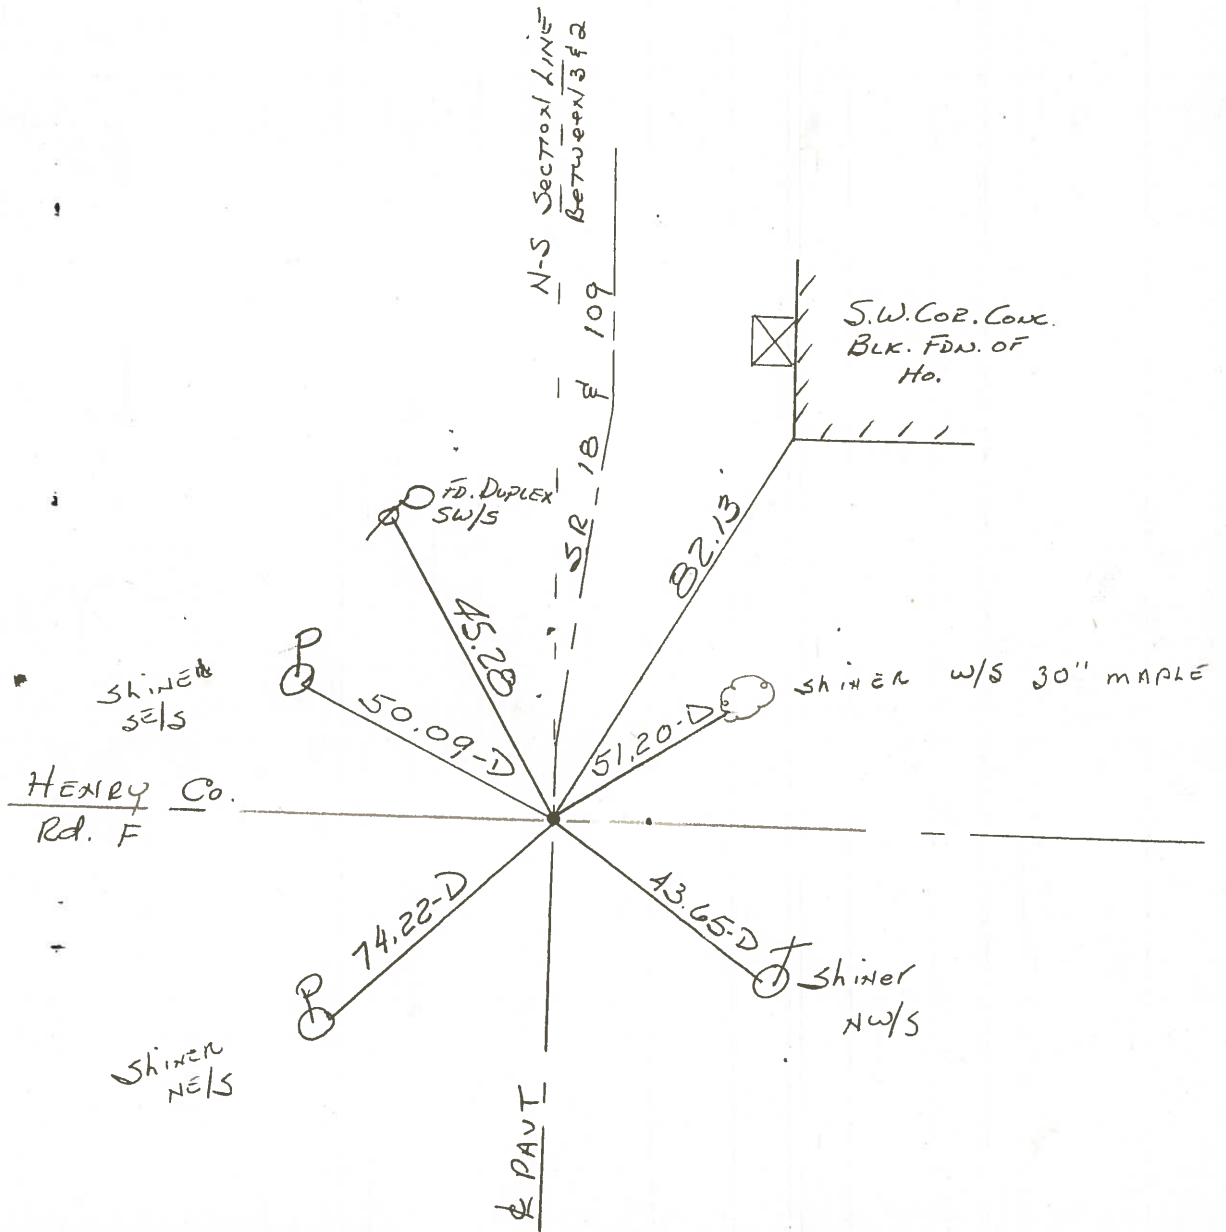


PERSONNEL	TITLE	PERSONNEL	TITLE	COUNTY	Henry	DATE	13 May 74
Stone				S. R.	#18	WEATHER	Cloudy
Michalak				SEC.	Marion Twp.	TEMP.	52°
Dennis				DESCRIPTION	Refs. to Control Points	JOB NO.	02999(0)
Curtis				LEFT	CENTER LINE	RIGHT	

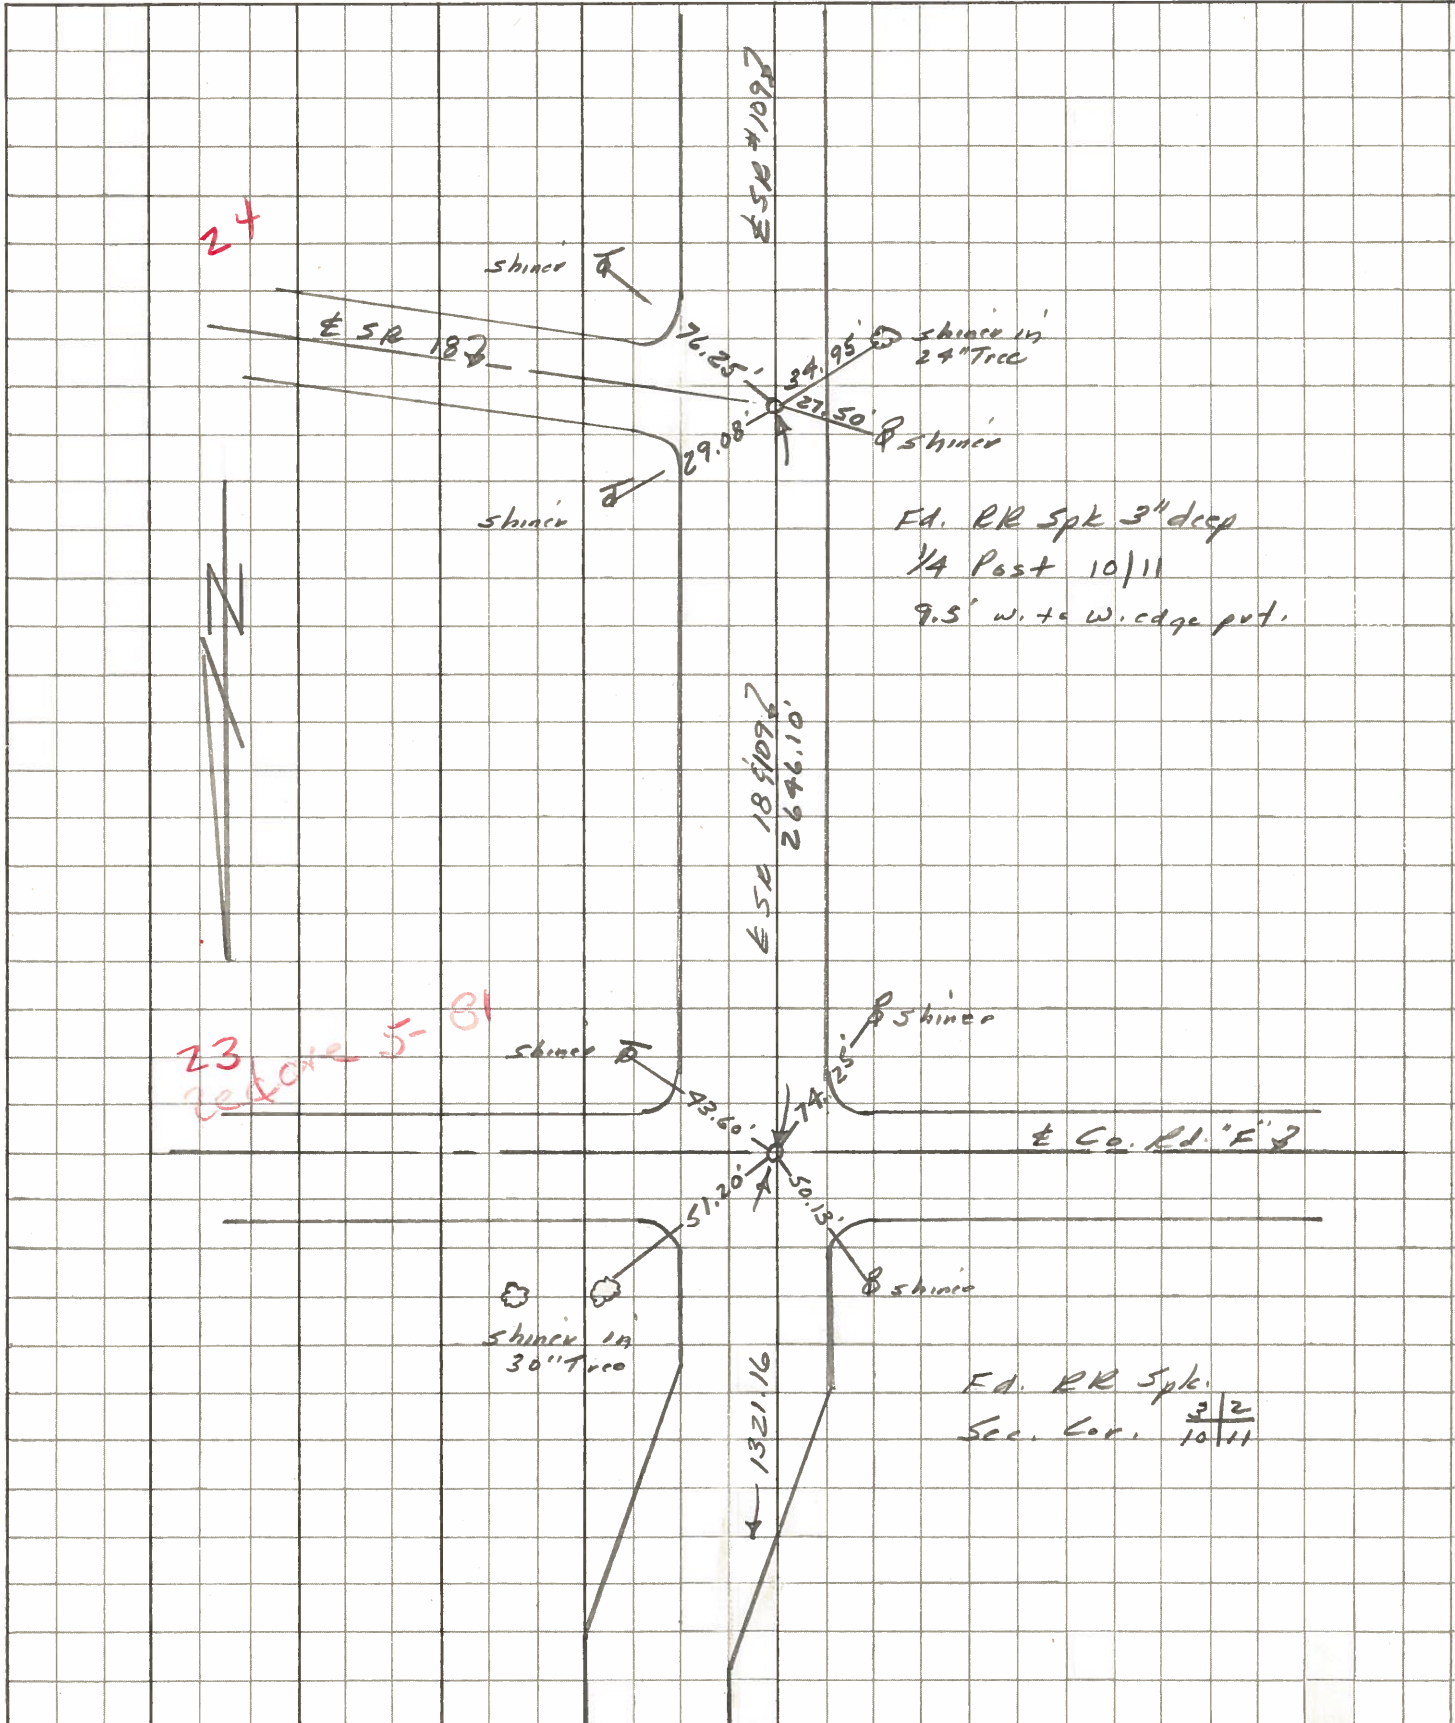

PERSONNEL	TITLE	PERSONNEL	TITLE
Stone			
Michalak			
Denno			
Curtis			

COUNTY Henry DATE 23 April 79
 S. R. 18 WEATHER Cloudy
 SEC. Marion Twp. TEMP. 45°

DESCRIPTION Alignment JOB NO. 02799(0)

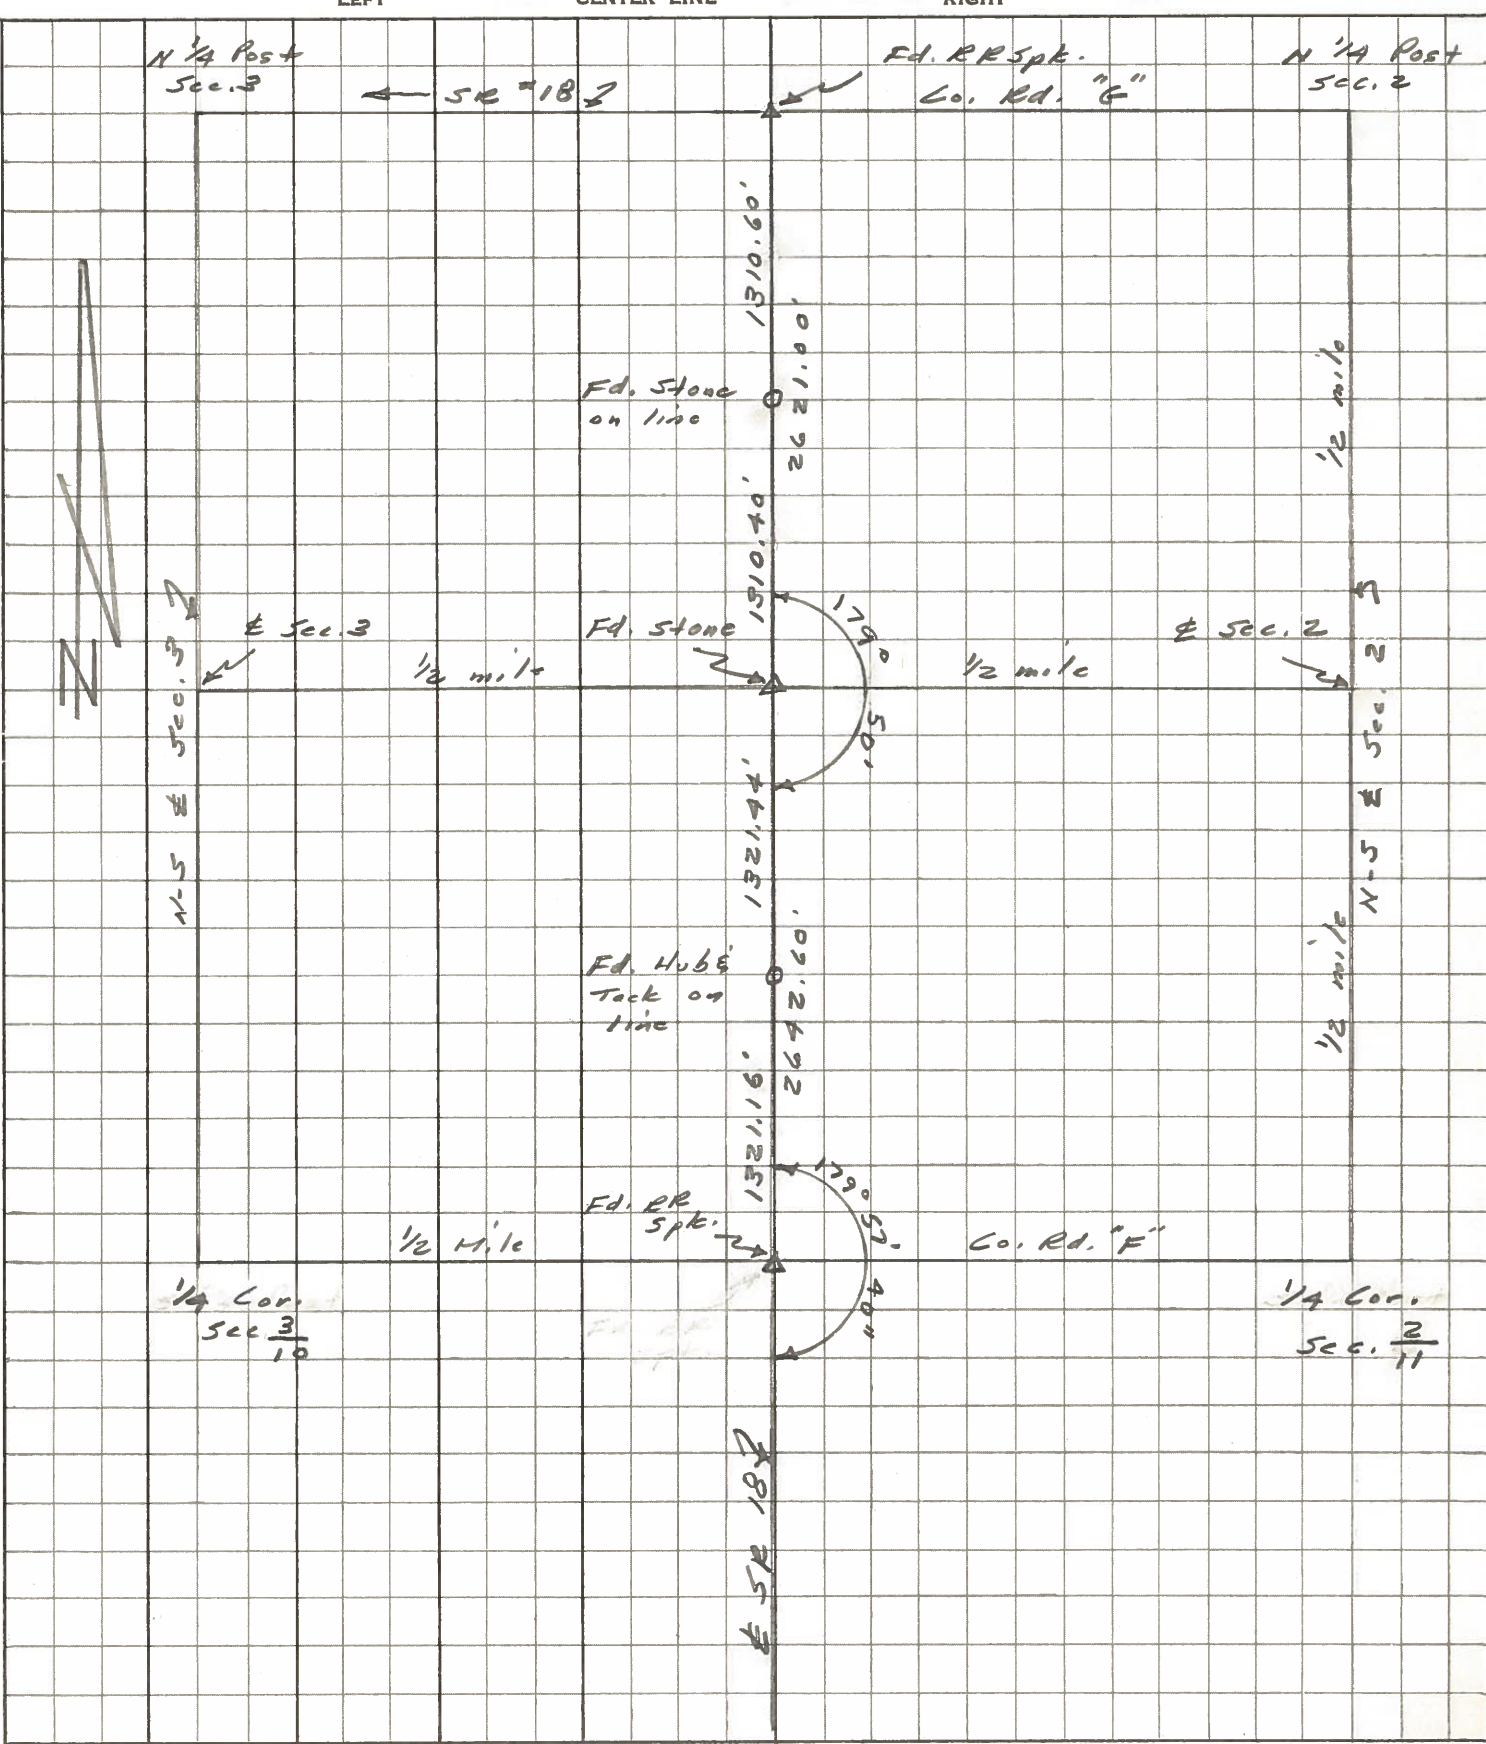

PERSONNEL	TITLE	PERSONNEL	TITLE
Stone			
Michalak			
Dunn			
Curtis			

COUNTY Henry DATE 23 April 74
 S. R. #18 WEATHER Cloudy
 SEC. Marion Twp. TEMP. 75°

DESCRIPTION _____ Alignment _____ JOB NO. 02999(c)
 LEFT _____ CENTER LINE _____ RIGHT _____

