

O.D.O.T. DISTRICT 2 SURVEY OFFICE (USE ONLY)

PERSONNEL

REFERENCE NO. 24A

SHEET OF

NOTES BARRIERE DATE 10/4/24

H.C. MILLER WEATHER SUNNY

R.C. BARRIERE TEMP. 54°

ROUTE SR 18

COUNTY HENRY

TOWNSHIP MARION

SECTION 11

DWG BY BARRIERE PID 99587

T 3 N R 7 E

TYPE MONUMENT MAG NAIL/WASHER

ON SURFACE - BELOW ON

OFFSET $\varnothing$ PAVEMENT 4.5' RT LT : RT

 TO EDGE PAVEMENT

STATION:

HORIZ.DATUM: HENRY LDP


GEOID: 18

GRID: NORTHING:

EASTING:

LDP: NORTHING: 430703.786

EASTING: 181801.363

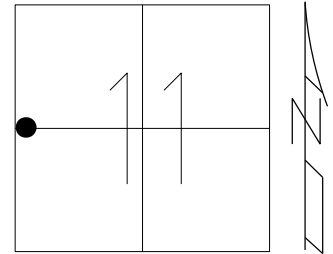

RECORD:

FD MAG NAIL
REF24A
4/4/24, JAM
SET MAG/WASHER
10/4/24, JAM

