

O.D.O.T. DISTRICT 2 SURVEY OFFICE (USE ONLY)

PERSONNEL

REFERENCE NO. 25C

SHEET ____ OF ____

NOTES BARRIERE DATE 10/4/24

H.C. MILLER WEATHER SUNNY

R.C. BARRIERE TEMP. 54°

ROUTE SR 18

COUNTY HENRY

TOWNSHIP MARION

SECTION 11

DWG BY BARRIERE PID 99587

T 3 N R 7 E

TYPE MONUMENT MAG NAIL/WASHER

ON SURFACE - BELOW ON

OFFSET $\odot$ PAVEMENT 0.8' LT LT : RT

TO EDGE PAVEMENT

STATION: _____

HORIZ.DATUM: HENRY LDP


GEOID: 18

GRID: NORTHING: _____

EASTING: _____

LDP: NORTHING: 430560.109

EASTING: 182297.129

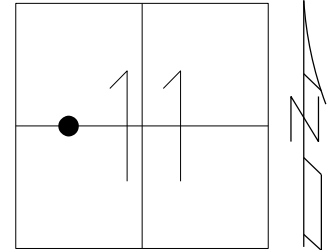

RECORD:
FD MAG NAIL
REF25C
4/4/24, JAM
SET MAG/WASHER
10/4/24, JAM

NOTE:

FROM HEN-39-064
SURVEY DONE BY
JUSTIN NIESE

