


O.D.O.T. DISTRICT 2 SURVEY OFFICE (USE ONLY)


PERSONNEL _____ REFERENCE NO. 26 SHEET 28 OF 31
 NOTES NUHFER DATE 6/26/08 ROUTE SR 18
 H.C. MOSE WEATHER SUNNY COUNTY HENRY
 R.C. NUHFER TEMP. 85° TOWNSHIP MARION
 _____ SECTION 11
 _____ T 3 N R 7 E

TYPE MONUMENT MON.BOX
 ON SURFACE - ~~BELOW~~ ON
 LEFT - CL PAV'T - RIGHT ON
10.7' TO LT EDGE PAVEMENT
 S.L.M. 612+75
 Grid: Northing: 573854.069 Easting: 1546863.809

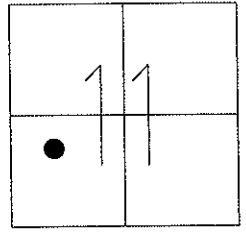

MON.BOX AT SURFACE
 8/19/88, JHR
 DID NOT OPEN
 FD 1/23/07, 6/26/08
 GPS, REF 26
 6/30/08, KPM

RECORD:
 P.I. STA. 612+46.68
 $\Delta = 2^\circ 0' \text{ LT}$
 ALSO, 1932 PLAN
 STA. 11+18.45
 $\Delta = 2^\circ 0' \text{ LT}$

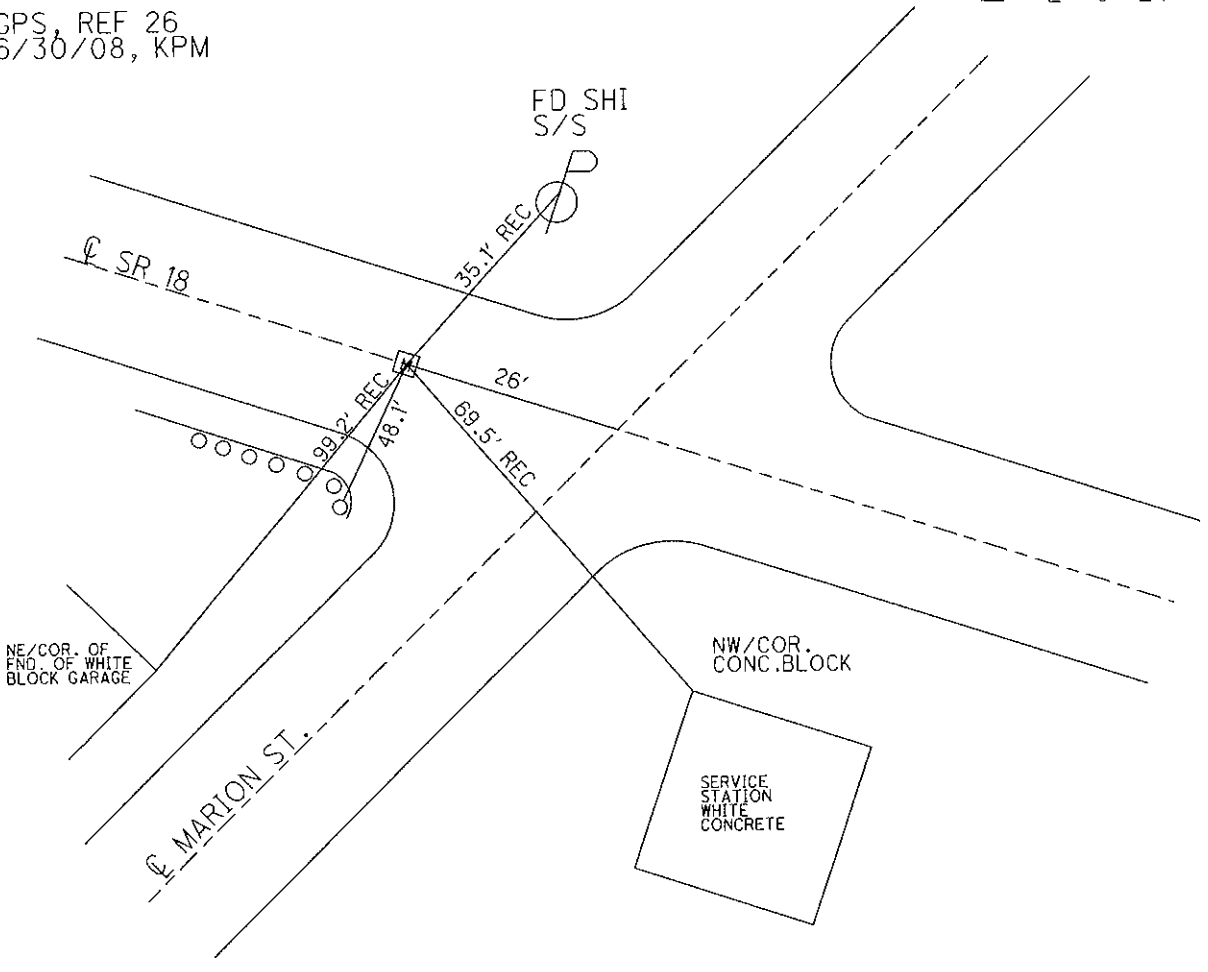

O.D.O.T. DISTRICT 2 SURVEY OFFICE

PERSONNEL

REFERENCE NO. 26

SHEET 1 OF 13

NOTES HUSS

H.C. VAN DUSEN

DATE 6-7-95

ROUTE 18

R.C. MOSER

WEATHER SUNNY/CLEAR

COUNTY HENRY

TEMP. 80°F

TOWNSHIP MARION

SECTION 11

T3 N R 7 E


TYPE MONUMENT MON. BOX

ON SURFACE - ~~BELOW~~ YES

~~LEFT- & PAV'T. - RIGHT~~ & YES

10.7 TO LT EDGE PAVEMENT

S.L.M. 612+75

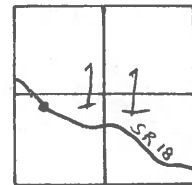

RECORD:

P.I. STA 612+96.68

$\Delta = 2^{\circ}-0' LT$

ALSO


1932 PLAN STA 11+18.95

$\Delta = 2^{\circ}-0' LT$

MON. @ SURFACE

8/19/88 SHR

DID NOT OPEN

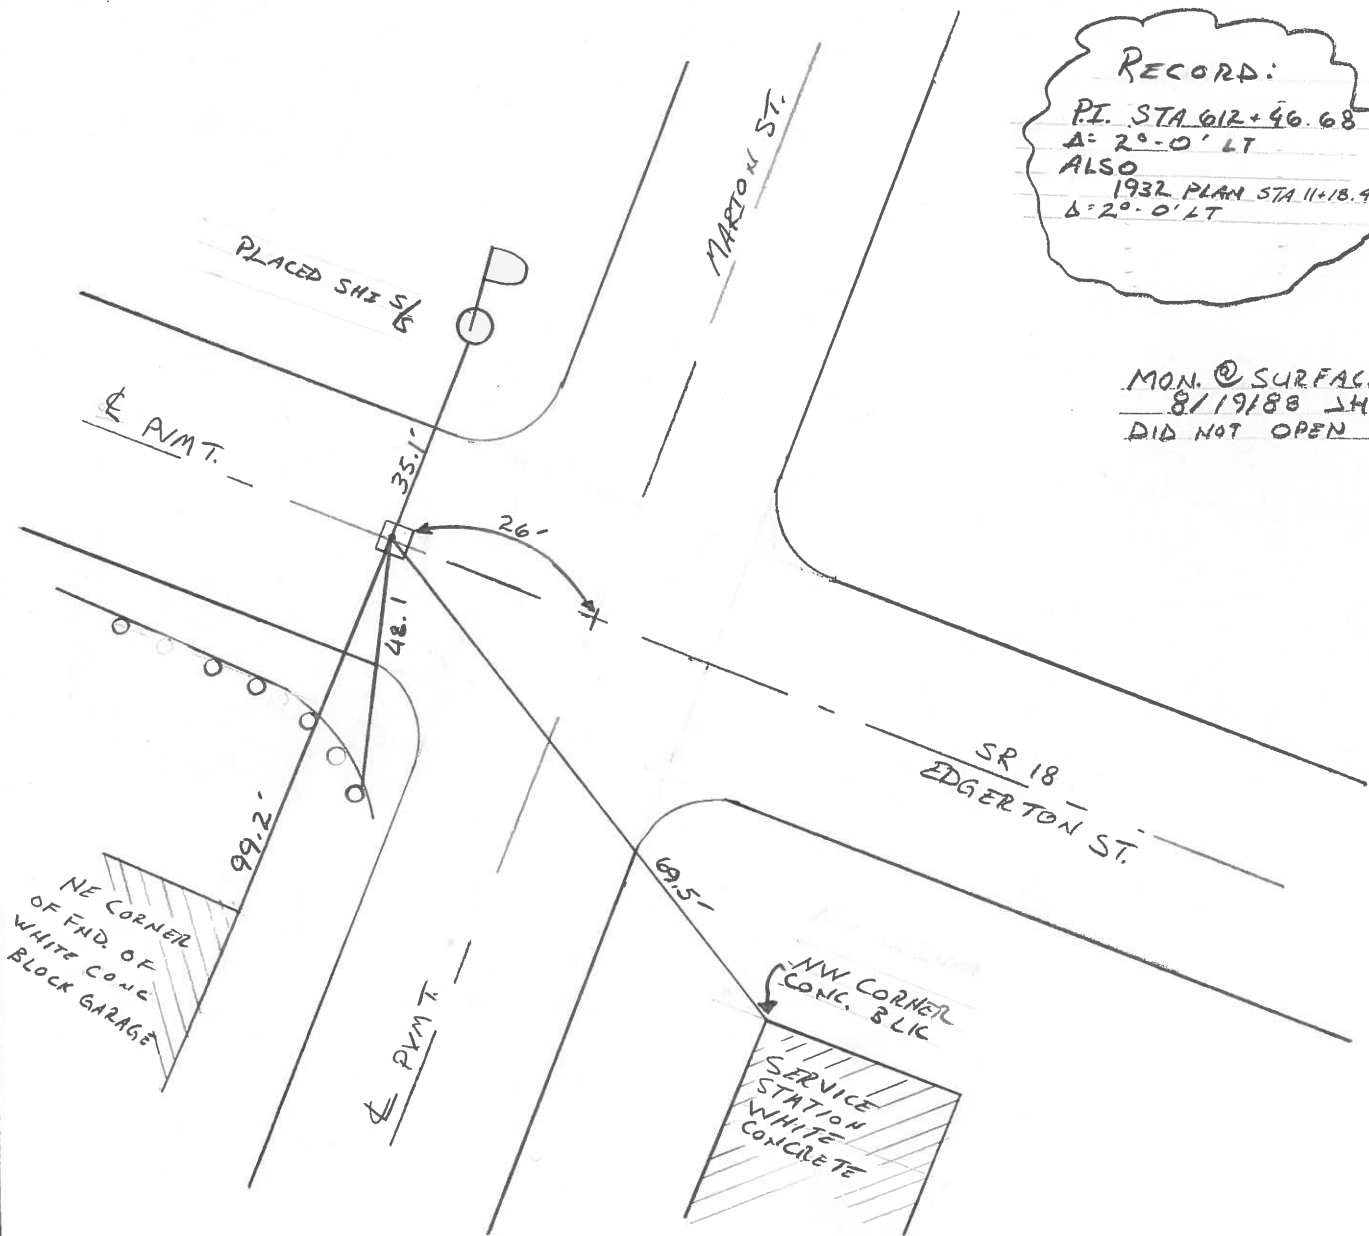

Resurfaced 1995

O.D.O.T. DISTRICT 2 SURVEY OFFICE

PERSONNEL

REFERENCE NO. 26

SHEET 15 OF _____

NOTES BARNHISEL

H.C. _____

DATE 3-29-89

ROUTE 18

R.C. HOFFMAN

WEATHER cloudy-windy

COUNTY HENRY

TEMP. +44°

TOWNSHIP MARION

SECTION 11

T 3 N R 7 E



TYPE MONUMENT MON. BOX

ON SURFACE - BELOW YES

LEFT - & PAV'T. - RIGHT & YES.

11.8 TO LT. EDGE PAVEMENT 26' W OF & MARION ST.

S.L.M. 612 + 75

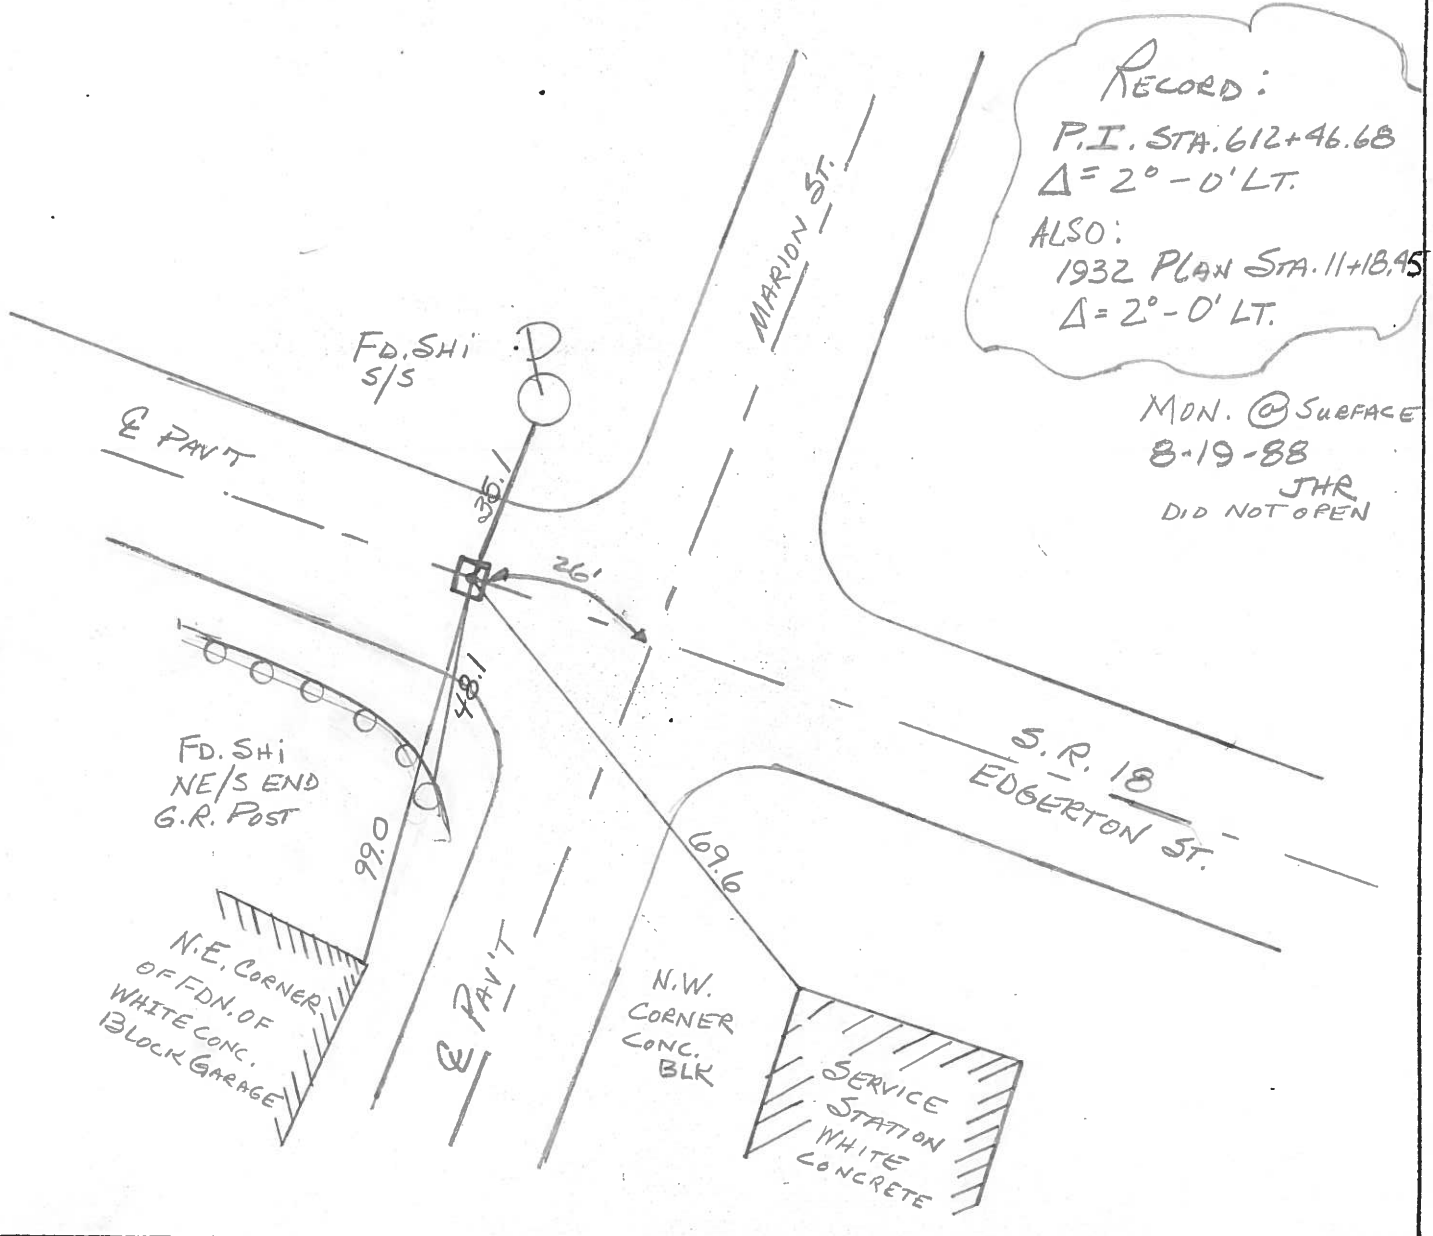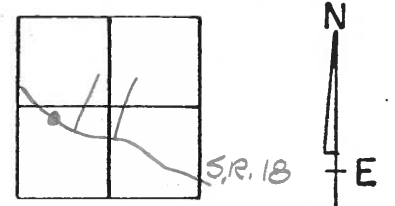

RECORD:
 P.I. STA. 612+46.68
 $\Delta = 2^\circ - 0' LT.$
 ALSO:
 1932 PLAN STA. 11+18.45
 $\Delta = 2^\circ - 0' LT.$
 MON. @ SURFACE
 8-19-88
 JHR
 DID NOT OPEN

O.D.O.T. DISTRICT 2 SURVEY OFFICE

SHEET _____ OF _____

County HENRY S.R. 18

Date April 19, 83

Township MARION

Weather CLEAR

Section 11 IN HAMLER

Temp. +34°

T3N, R7E

Personnel Hoffman

LOEHRKE

BARNHISEL

#26



Fd "□" MON BOX ON SURFACE

DID NOT OPEN
USED TIES
BY BURNSIDE
4-19-78

ON & PAUT SR18
11.9' TO N.E.P.


S.L.M. 612+60

Record:

P.I. STA 612+46.
 $\Delta = 2^{\circ} - 0' LT.$

ALSO:
1932 PLAN STA 1171
 $\Delta = 2^{\circ} - 0' LT.$


MON @ SURFACE
9-19-83
804

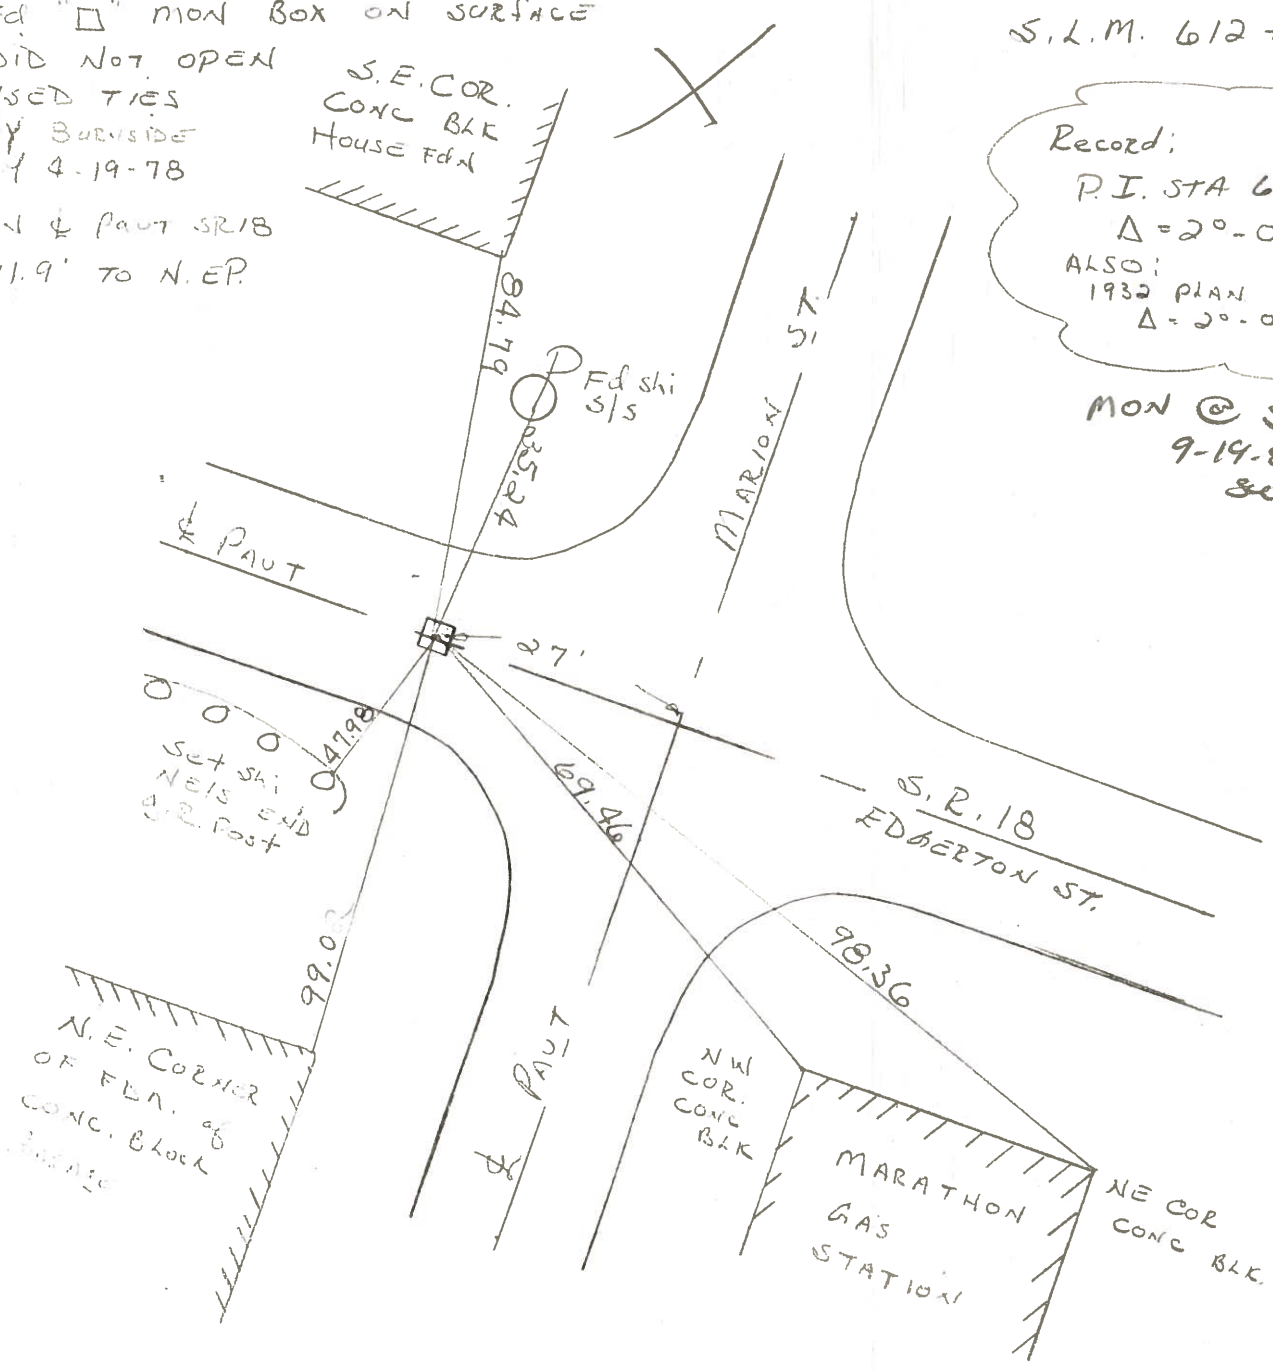


PERSONNEL	TITLE	PERSONNEL	TITLE
BURNSIDE			
SMITH			
BOWERS			
MEAD			

COUNTY HENRY DATE 4-19-78
 S. R. 18 @ MARION ST. WEATHER Cloudy
 SEC. 11.56 HAMLER, O. TEMP. +56°

DESCRIPTION REF. TO P.I. & SURVEY & RW JOB NO. 028280

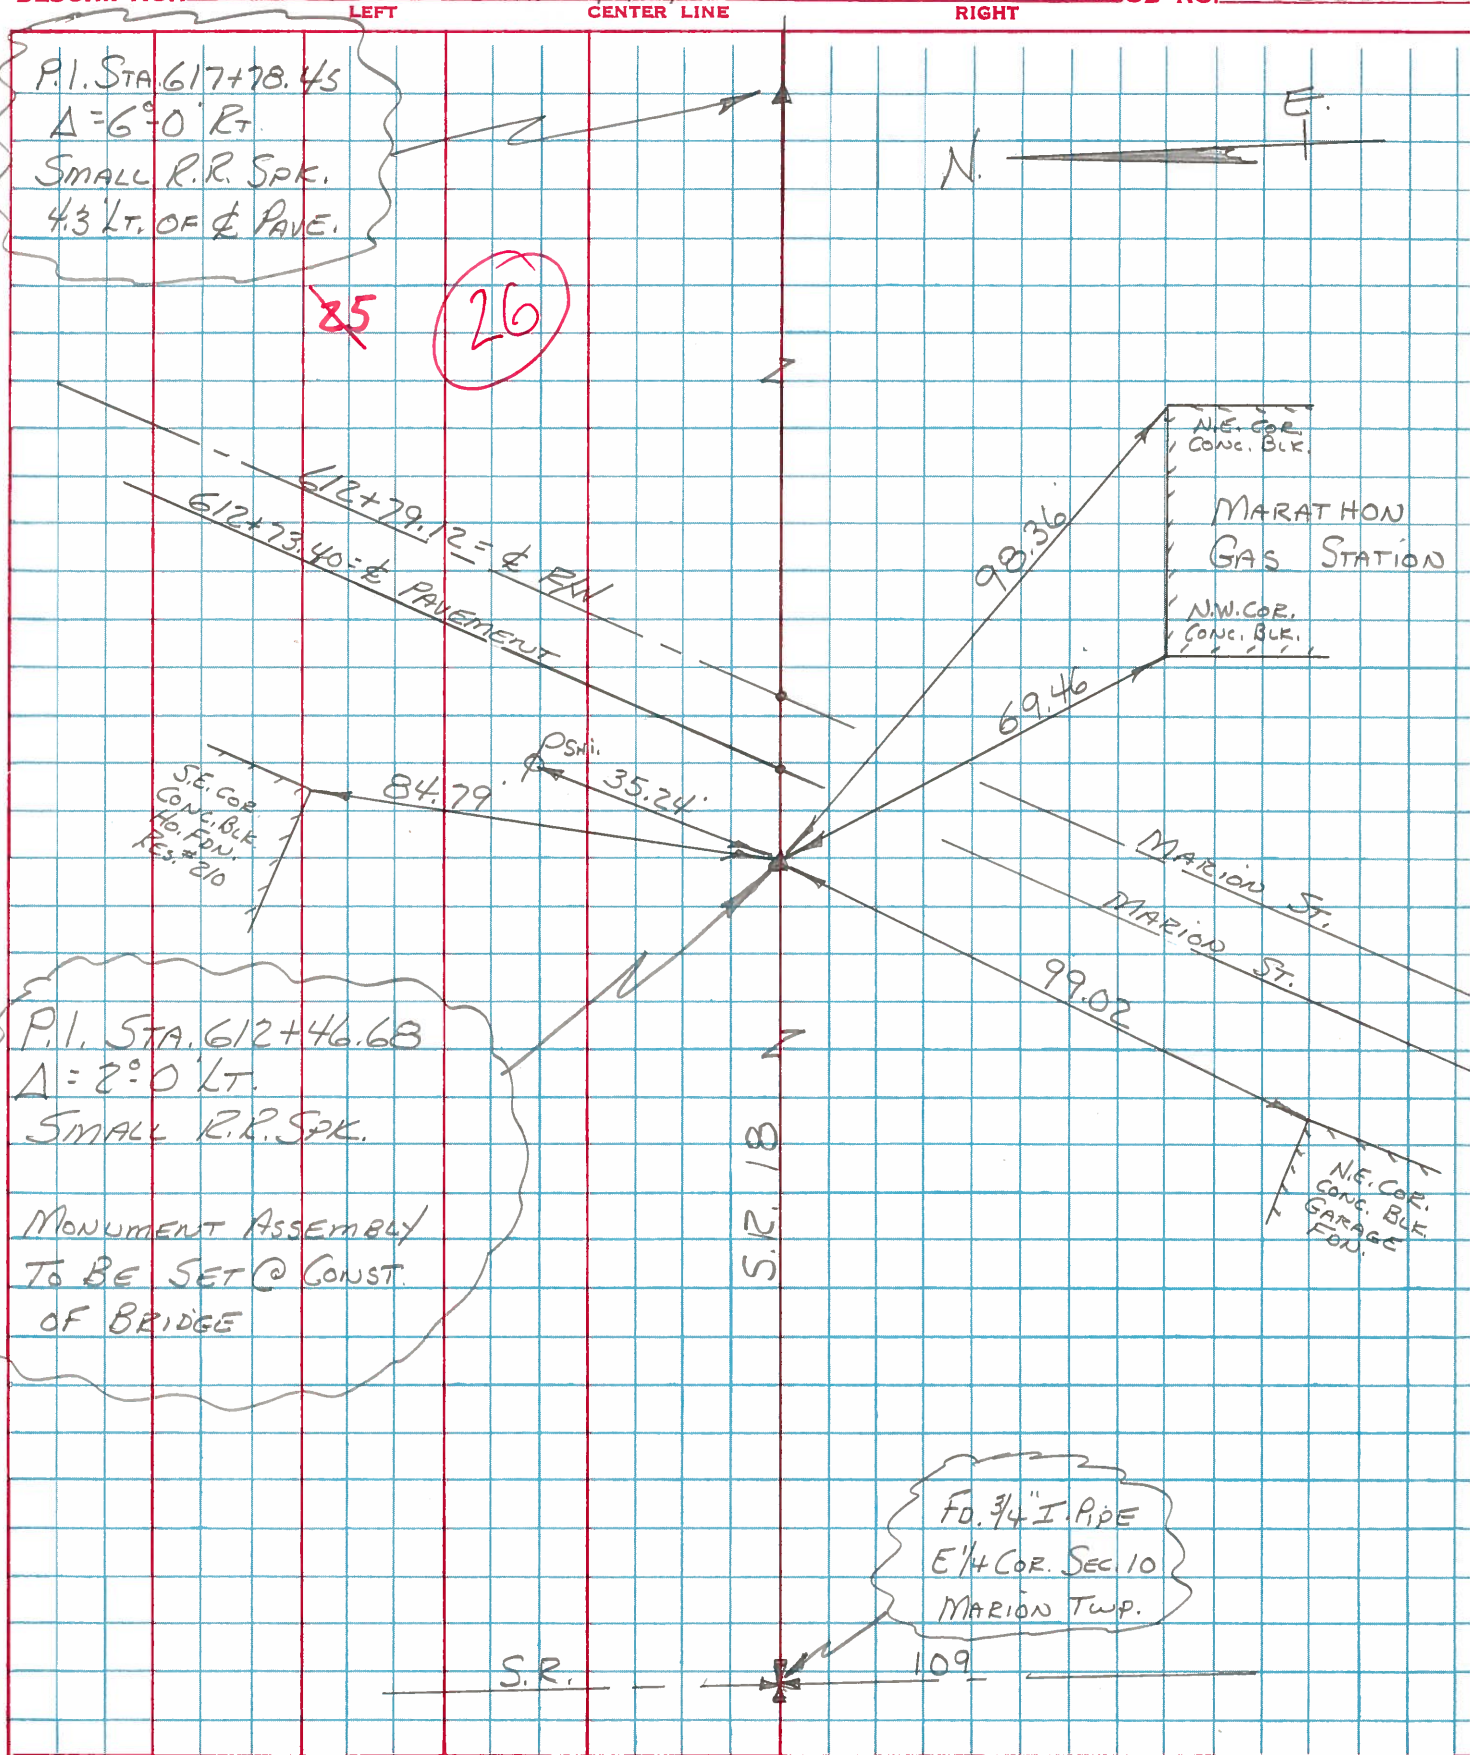

PERSONNEL	TITLE	PERSONNEL	TITLE	COUNTY	DATE	WEATHER	TEMP.
Stone				Henry	16 May 74	Cloudy	55°
Michalek				S. R. #18			
Denn				SEC. Hamler			
DESCRIPTION				Refs to Central Points	JOB NO.	02999(0)	
LEFT		CENTER LINE		RIGHT			

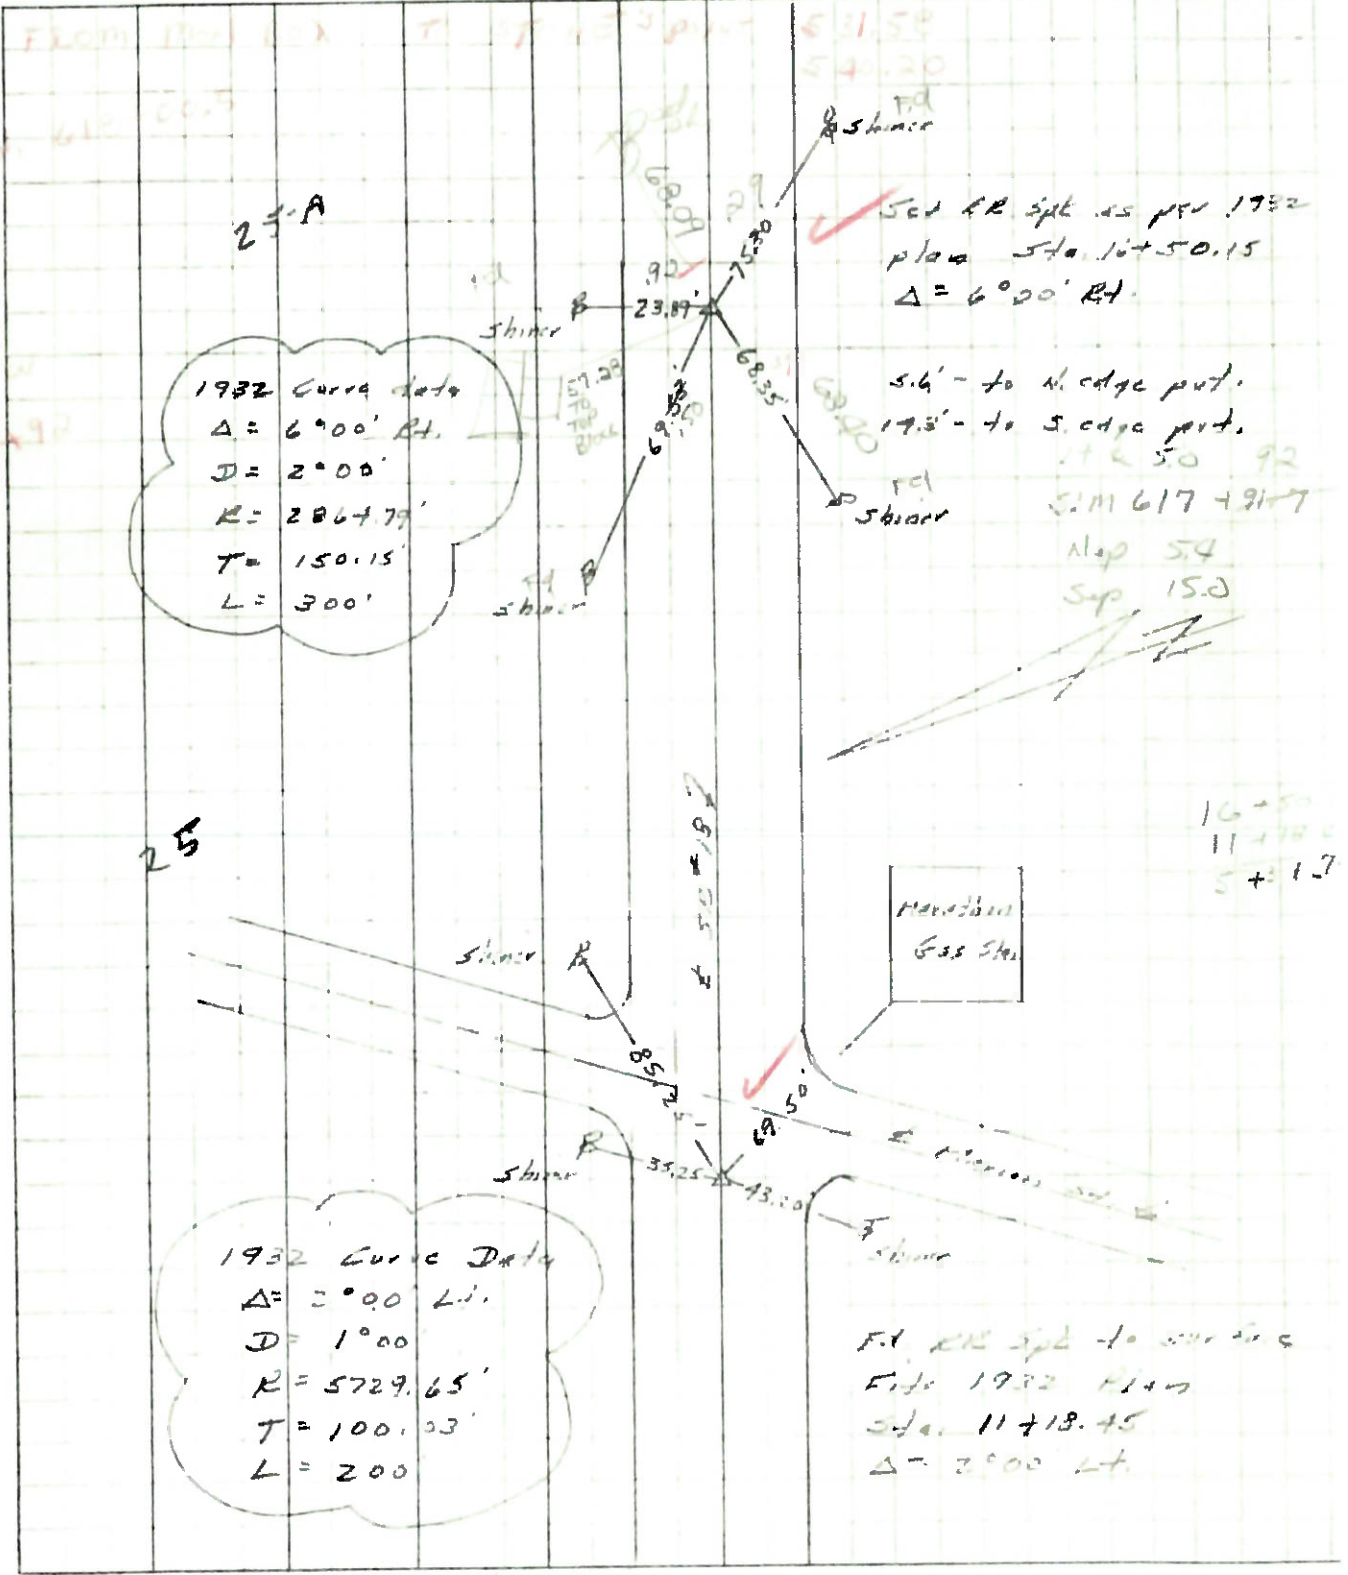


PERSONNEL	TITLE	PERSONNEL	TITLE
Stone			
Michalek			
Dennis			

COUNTY Henry DATE 16 May 74

S. R. 18 WEATHER Cloudy


SEC. Hamber TEMP. 70°

DESCRIPTION Refs. to Control Points JOB NO. 02999(2)

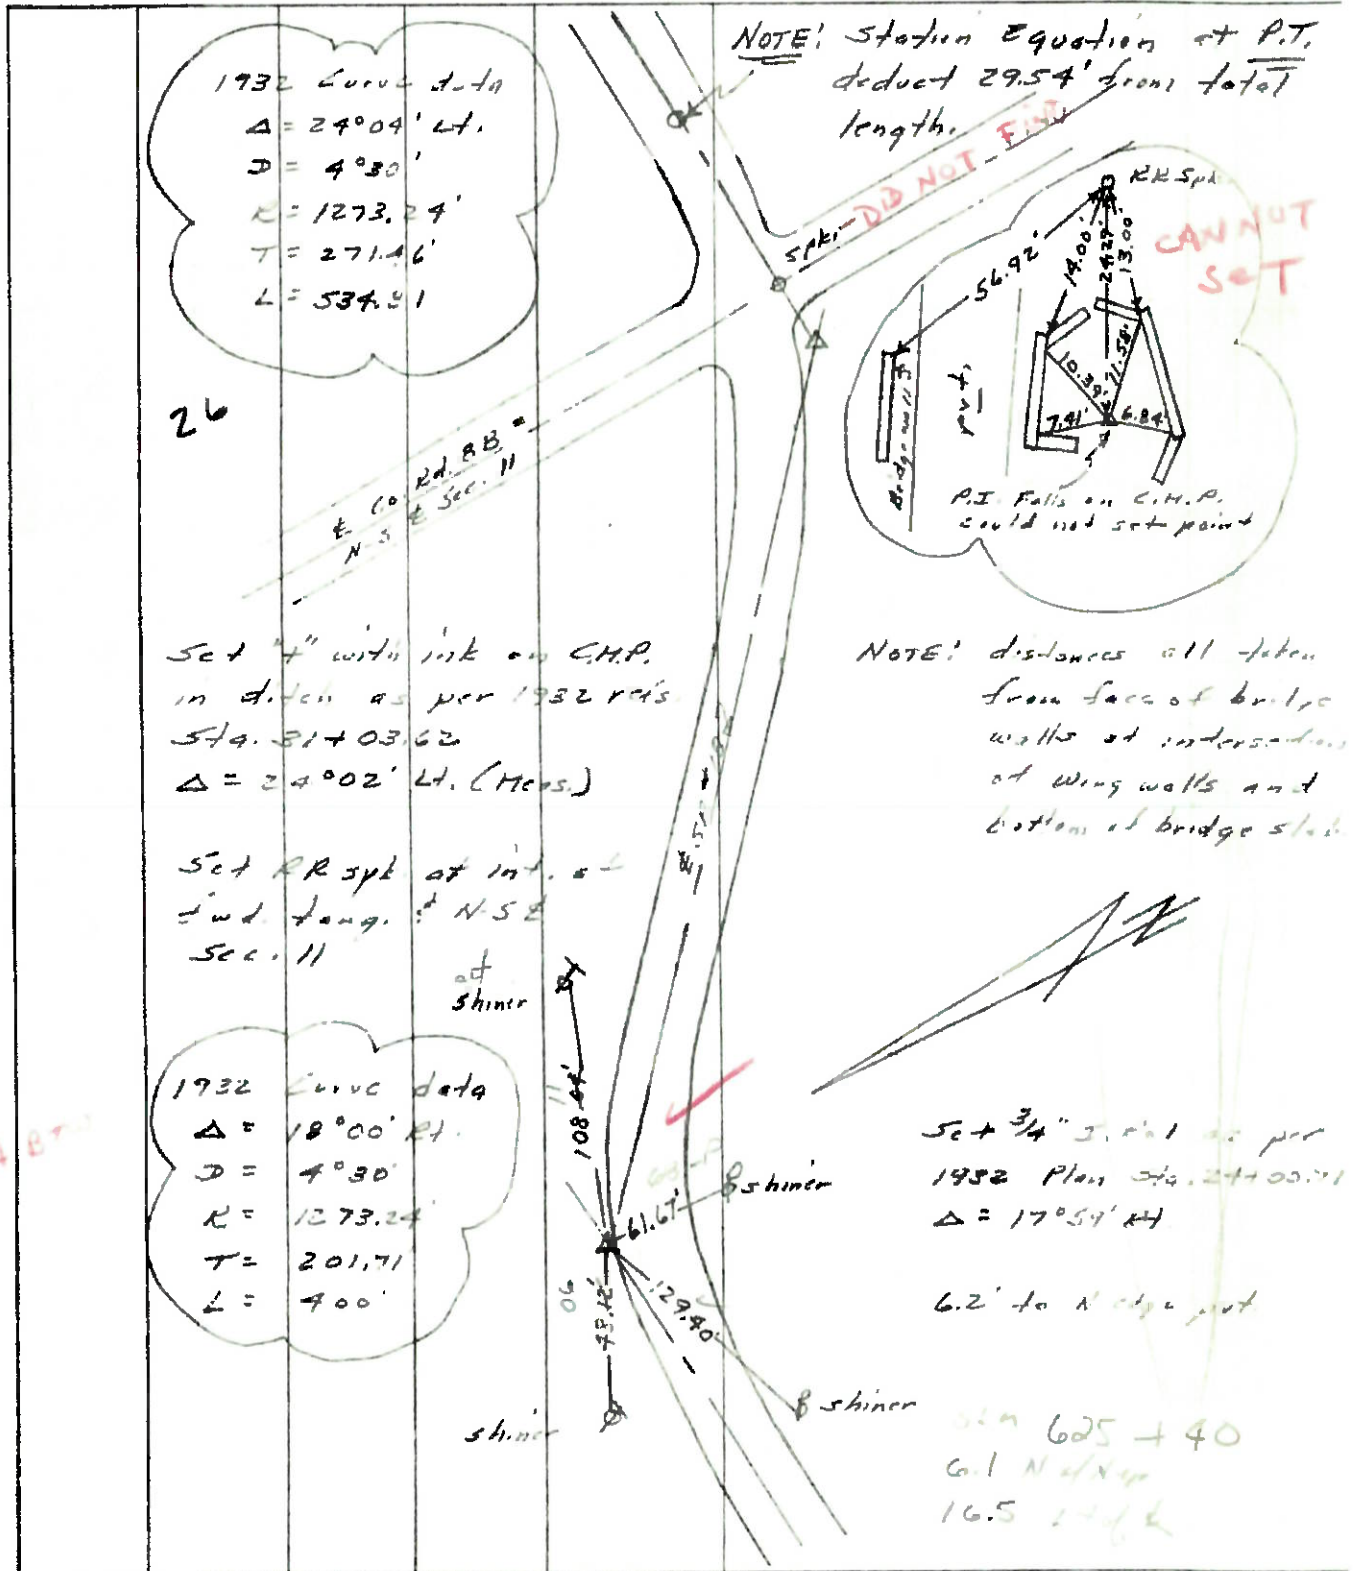

PERSONNEL TITLE PERSONNEL TITLE COUNTY Henry DATE 23 April 79
Stone _____ Michalak _____ S. R. #18 WEATHER Cloudy
Dennis _____ Curtis _____ SEC. Marion Twp. TEMP. 45°

DESCRIPTION Alignment CENTER LINE RIGHT JOB NO. 82999(6)

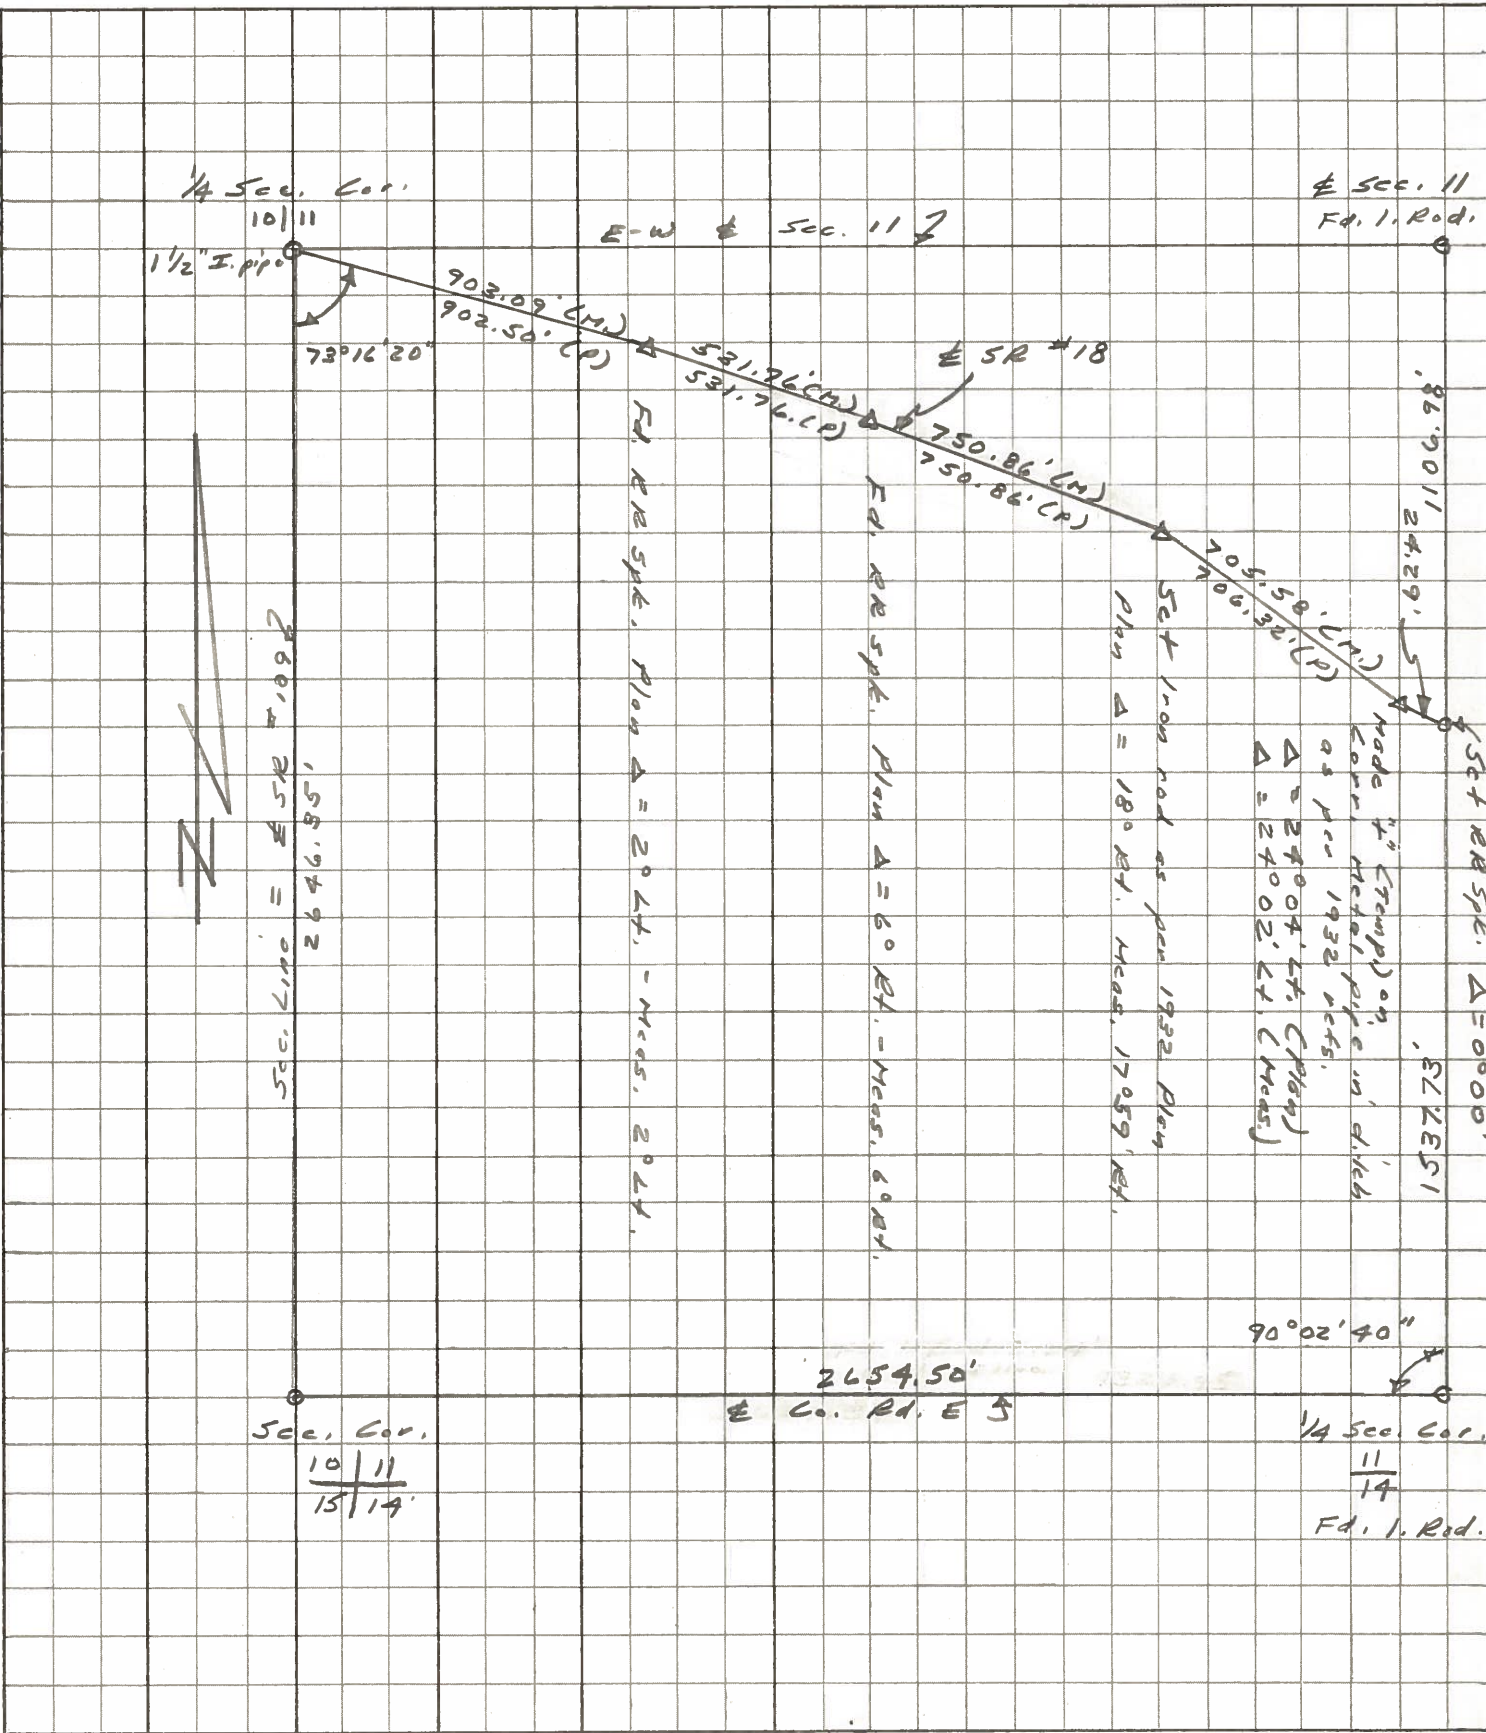


PERSONNEL	TITLE	PERSONNEL	TITLE
BURNSIDE			
SMITH			
BOWERS			
MEAD			

COUNTY HENRY DATE 3-12-74

S. R. 18^E 109 WEATHER Cloudy

SEC. HAMLER, O. TEMP. 35°

DESCRIPTION ADDITIONAL RW INFO. MARION ST. JOB NO. 028280

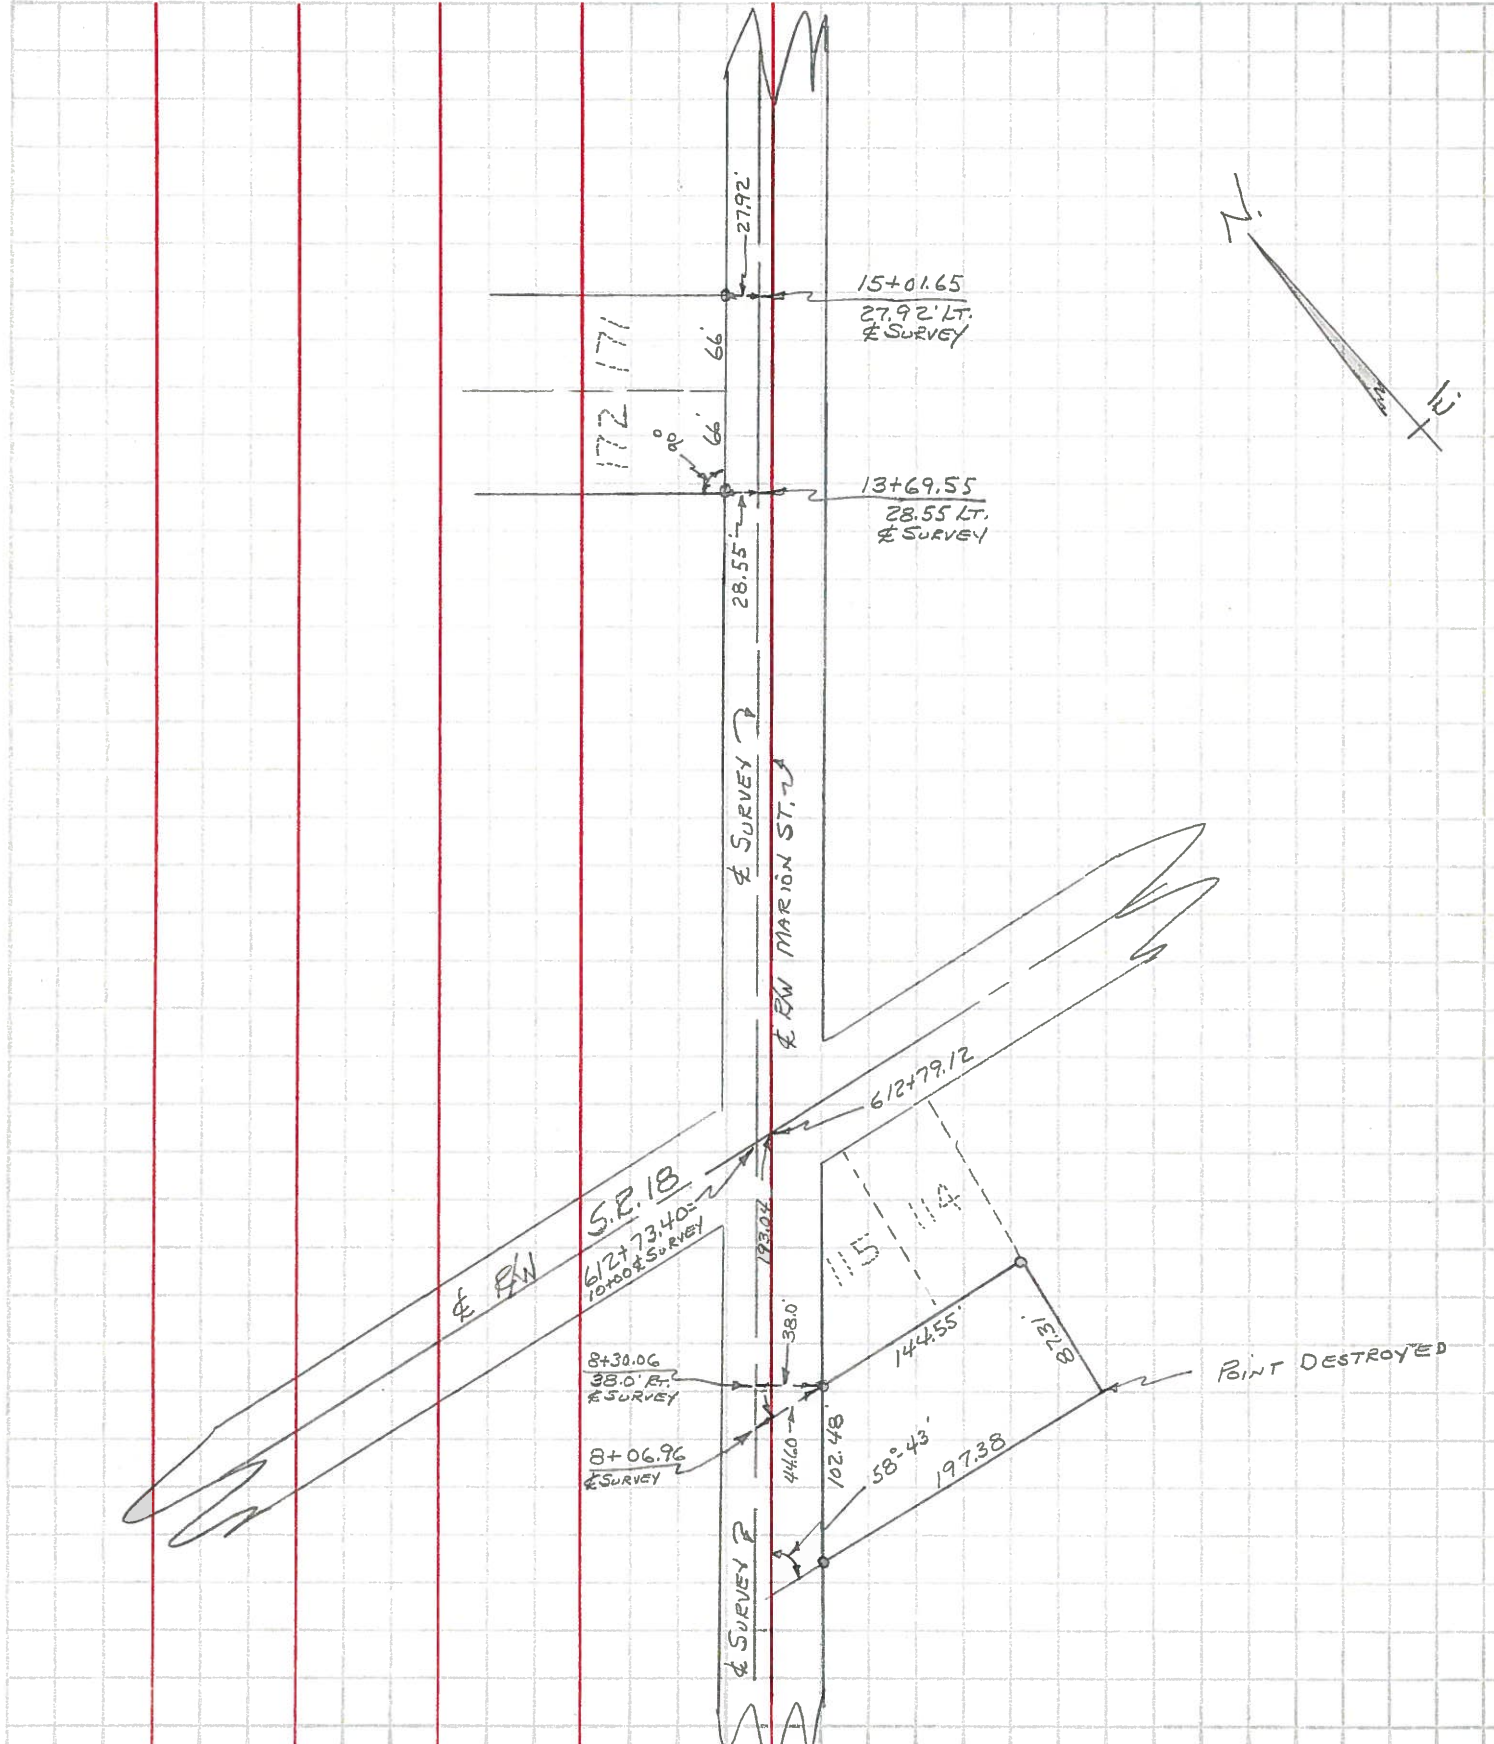


PERSONNEL	TITLE	PERSONNEL	TITLE
BURNSIDE			
SMITH			
MEAD			

COUNTY HENRY DATE 11-7-73

S. R. 18 & 109 HAMLER, O. WEATHER CLEAR

SEC. _____ TEMP. +42°


DESCRIPTION ALIGNMENT FOR MARION STREET JOB NO. 028280

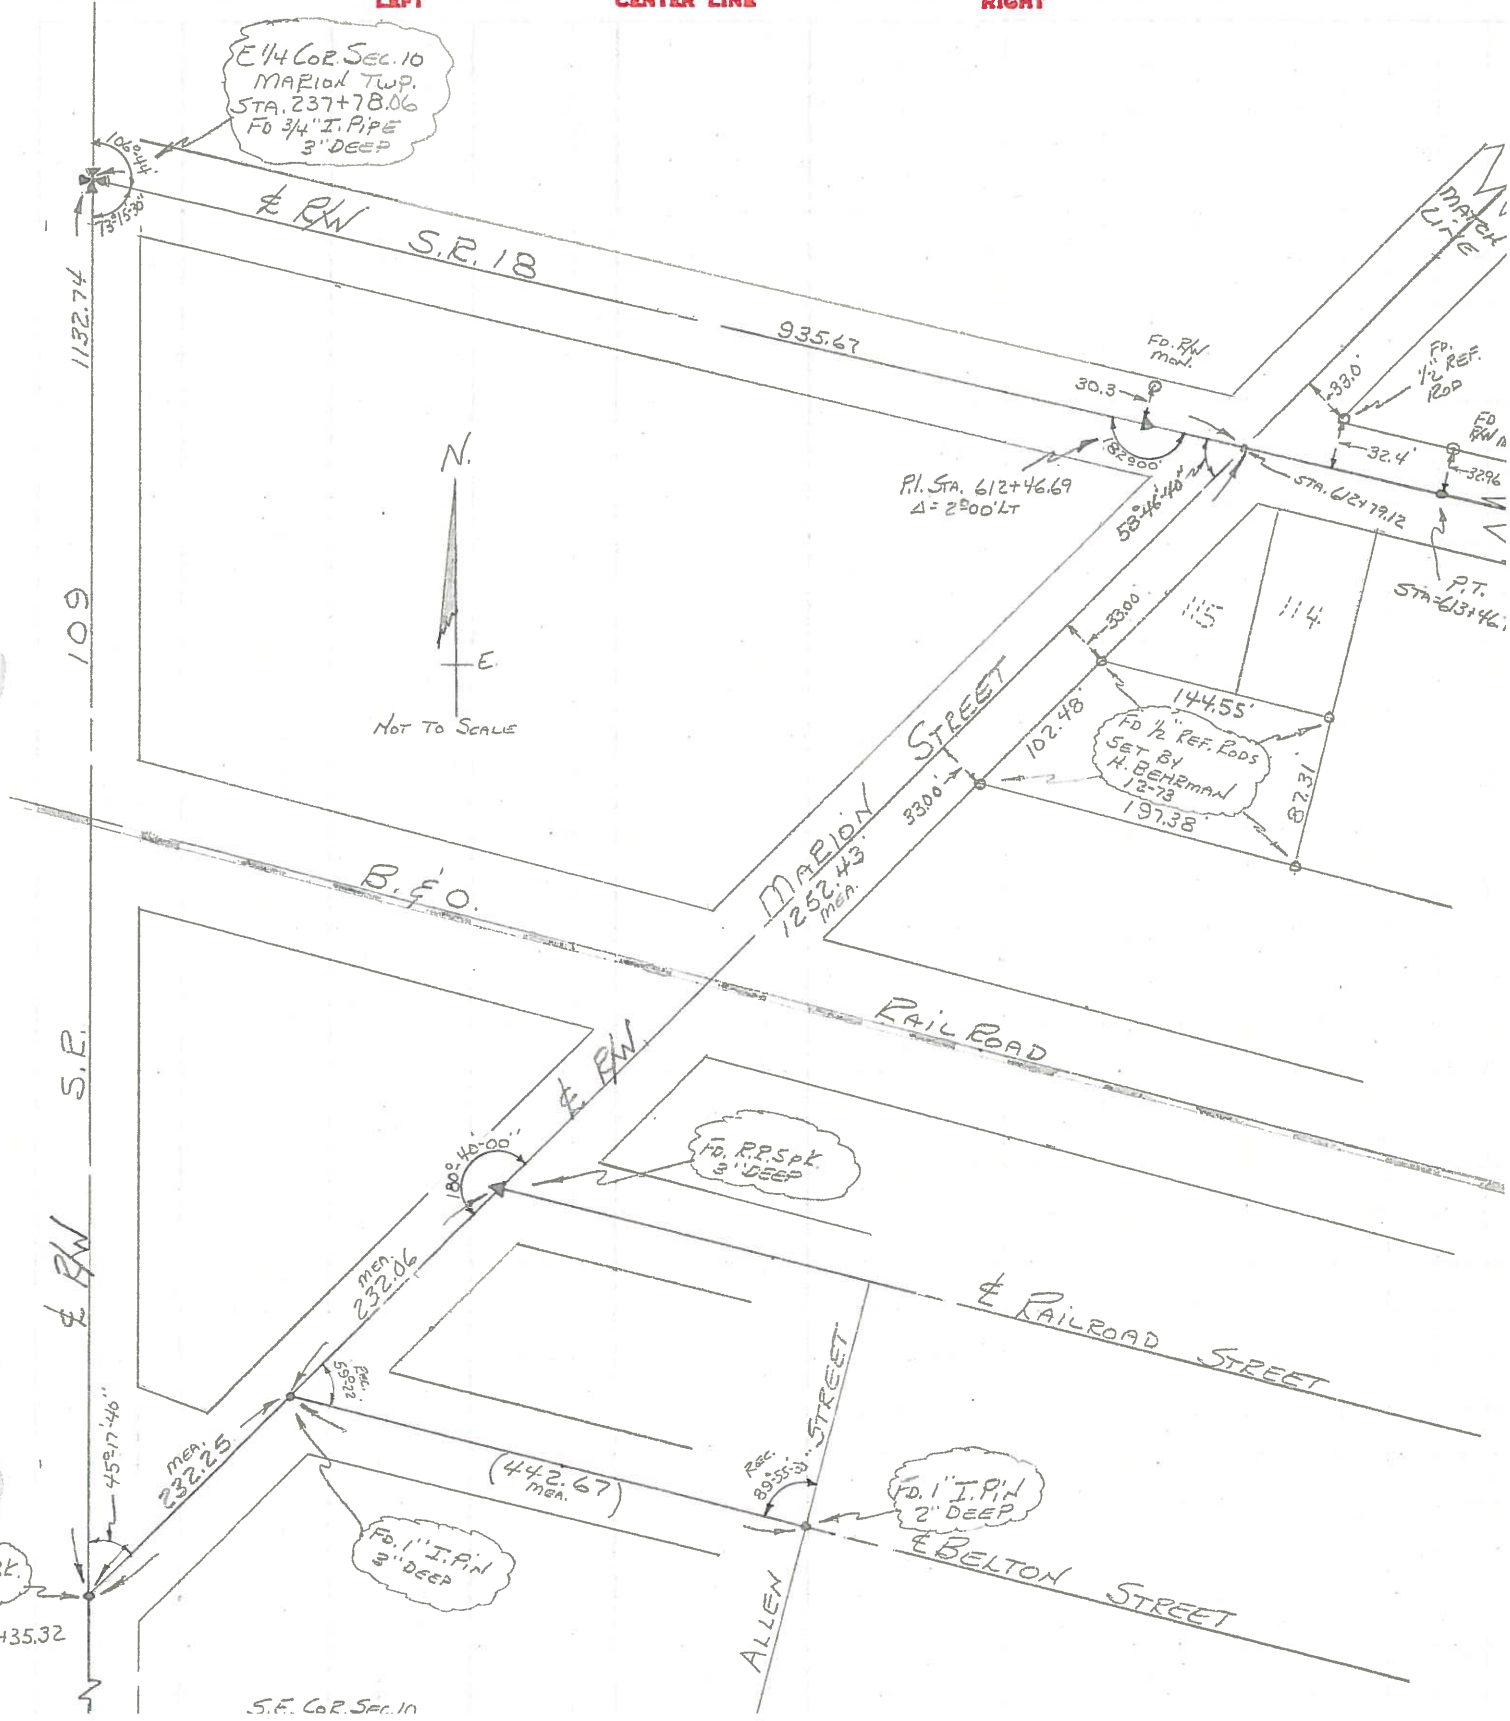

PERSONNEL	TITLE	PERSONNEL	TITLE
BURNSIDE			
SMITH			
BOWERS			
MEAD			

COUNTY HENRY DATE 11-7-73
 S. R. 18 & 109 HAMLER O. WEATHER CLEAR
 SEC. _____ TEMP. +45°

DESCRIPTION ± R/W ALIGNMENT FOR MARION STREET JOB NO. 028280
 LEFT CENTER LINE RIGHT

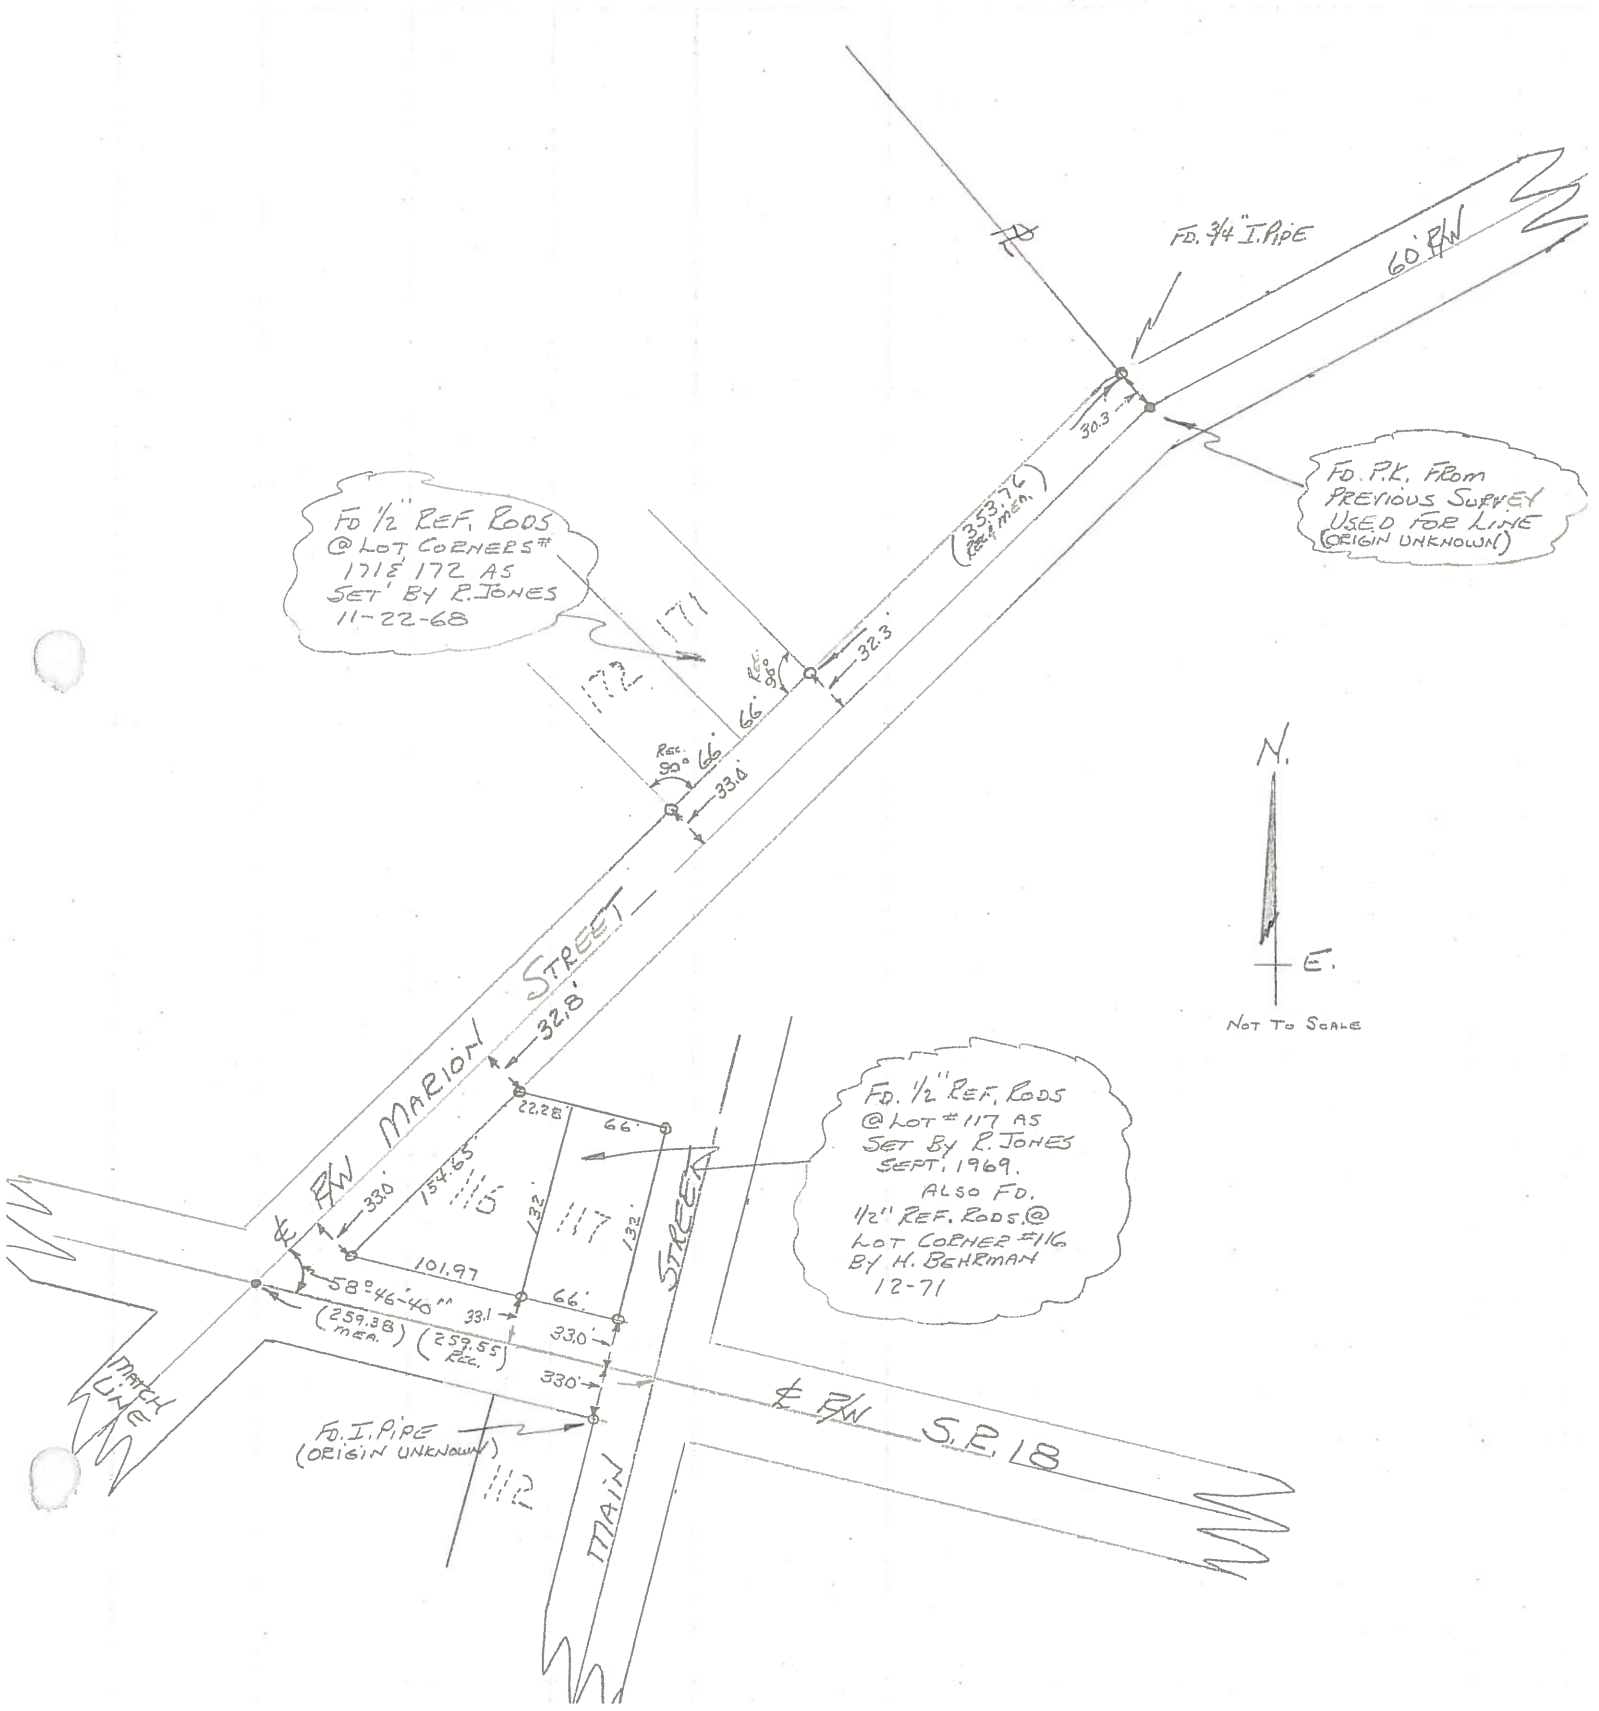

PERSONNEL TITLE PERSONNEL TITLE
 BURNSIDE
 SMITH
 KIJOWSKI

COUNTY HENRY DATE 8-7-72

S. R. 18 WEATHER SHOWERS

SEC. HAMLER TEMP. +68°

DESCRIPTION CONTROL TIES LEFT CENTER LINE RIGHT JOB NO. 028280

26A

P.I. S.L.M. STA.
 617+78.45
 $\Delta = 6^{\circ} 0' RT.$
 SET SMALL R.F. Spk
 4.3' LT. OF & PAVMT.

COR. CONC.
 SLAB PORCH.
 (ENTRANCE TO
 HOUSE)

COR. CONC.
 B.L.C. Ho.
 FDN.

24.73
 61.09

58.68

67.80

76.40

SHI.

SHI.



26

P.I. S.L.M. STA.
 612+46.68
 $\Delta = 2^{\circ} 0' LT.$
 SET SMALL R.F. Spk.

N.W. COR.
 CONC. BLK.
 MARATHON
 GAS. STATION

& PAVEMENT MARION

SHI.

85.22

58°43'

612+73.40
 S.L.M.
 69.46

35.24'

SHI.

STREET

99.02'

43.18'

SHI.

N.E. COR.
 CONC. BLK.
 FON. GARAGE

S.R. 109

E 1/4 COR. SEC. 10
 MARION TWP