

O.D.O.T. DISTRICT 2 SURVEY OFFICE (USE ONLY)

PERSONNEL

REFERENCE NO. 32

SHEET 7 OF 12

NOTES AUBLE

DATE 5/17/21

ROUTE SR 18

H.C. NIESE

WEATHER CLOUDY

COUNTY HENRY

R.C. O'DONNELL

TEMP. 63°

TOWNSHIP BARTLOW

DWG BY NIESE

PID PAVETRAIN

SECTION 8

T 3 N R 8 E

TYPE MONUMENT SM.R.R.SPIKE

~~ON SURFACE~~ - BELOW 3.5"

OFFSET Q PAVEMENT ON LT : RT

9.3' TO RT EDGE PAVEMENT


STATION: 793+86

HORIZ.DATUM: NAD83(2011)


GEOID: NAVD88 2012A

GRID: NORTHING: 571235.565

EASTING: 1564554.627

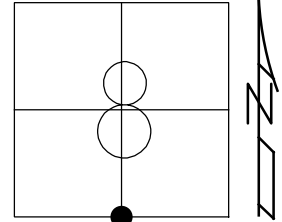


RECORD:
 FD 1" IPIN
 6" DOWN
 SET R.R.SPIKE
 ATOP 1" IPIN
 SET SM.R.R.SPIKE
 10/14/86, MDB
 SET P.K./WASHER
 9/7/95, SAH
 FD P.K./WASHER
 5/13/10, KPM
 SET MAG/WASHER
 7/20/10, SAH
 FD SM.R.R.SPIKE
 REF32
 5/17/21, JFO
 9/3/21, TDN

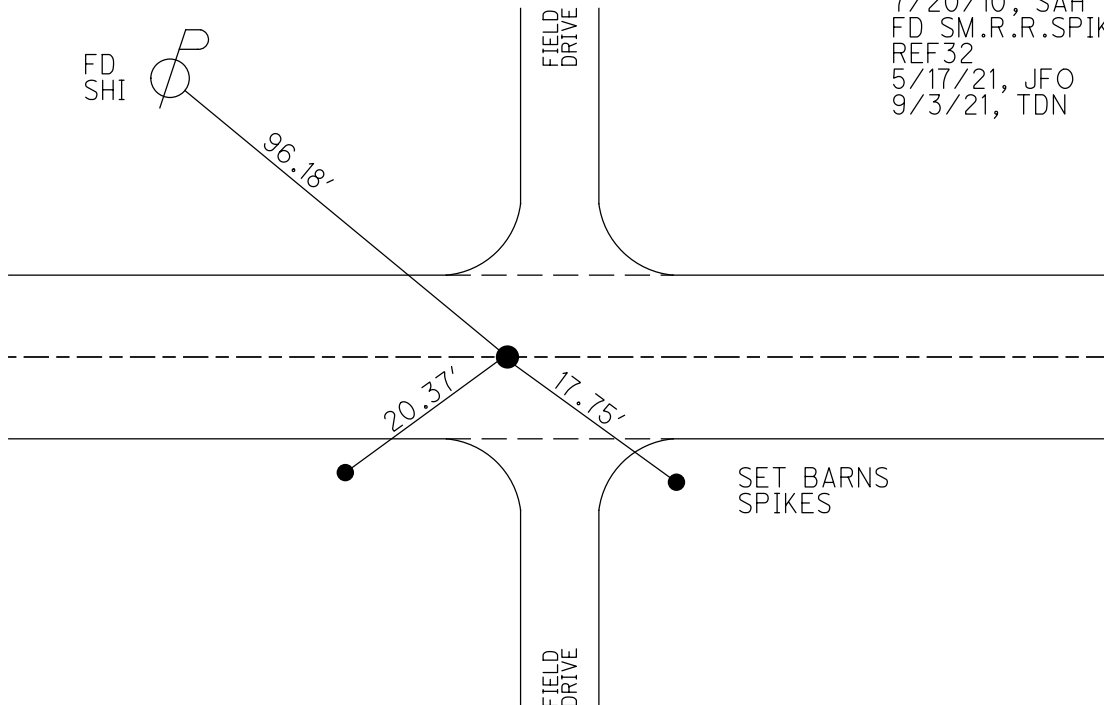


O.D.O.T. DISTRICT 2 SURVEY OFFICE (USE ONLY)

PERSONNEL _____ REFERENCE NO. 32 SHEET 7 OF 12
 NOTES MOSER DATE 5-13-10 ROUTE SR 18
 H.C. MOSER WEATHER CLOUDY COUNTY HENRY
 R.C. GOLDBERG TEMP. 70° TOWNSHIP BARTLOW
 _____ SECTION 8
 _____ T 3 N R 8 E

TYPE MONUMENT _____ P.K./WASHER _____
 ON SURFACE - ~~BELOW~~ _____ ON _____
 LEFT - ☉ PAV'T - RIGHT _____ ON _____
9.3' TO RT EDGE PAVEMENT
 S.L.M. 793+86
 GRID: NORTHING: 571235.581 EASTING: 1564554.625

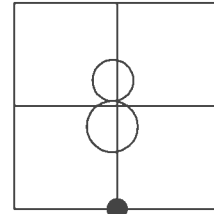


RECORD:
 FD 1" IRON PIN
 6" DEEP
 SET R.R.SPIKE
 ATOP 1" IPIN
 SET SM.R.R.SPIKE
 10-14-86, MDB
 SET PK/WASHER
 9-7-95, SAH
 SET MAG/WASHER
 7-20-10, SAH

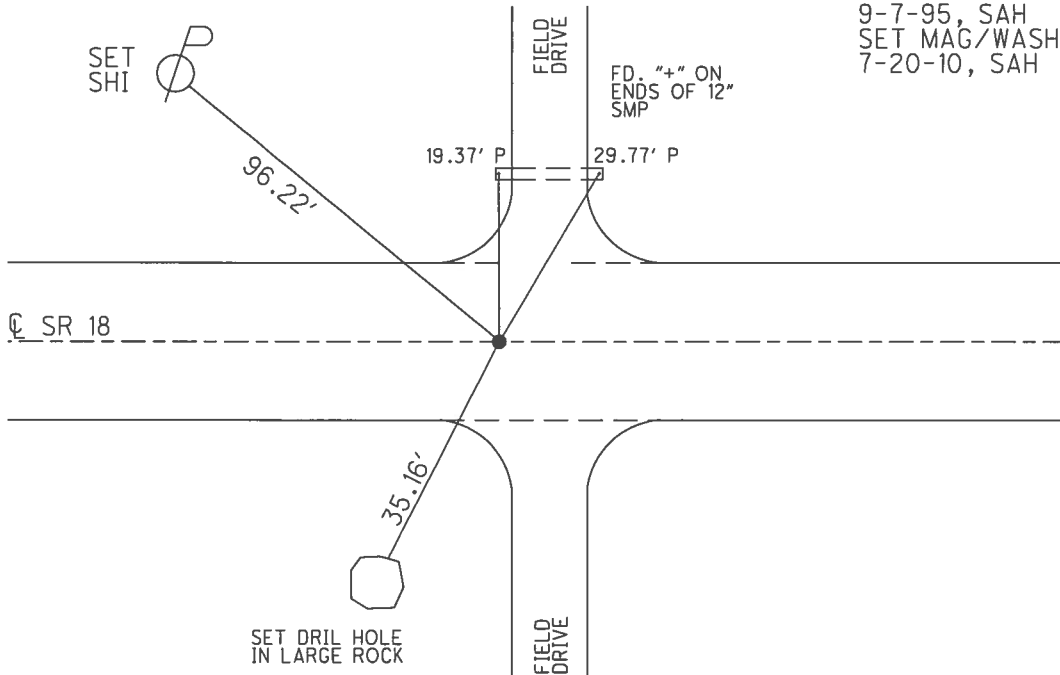

O.D.O.T. DISTRICT 2 SURVEY OFFICE

PERSONNEL _____ REFERENCE NO. 32 SHEET 11 OF 13
 NOTES MOSER DATE 5-13-10 ROUTE SR 18
 H.C. MOSER WEATHER CLOUDY COUNTY HENRY
 R.C. GOLDBERG TEMP. 70° TOWNSHIP BARTLOW
 SECTION 8
 T 3 N R 8 E

TYPE MONUMENT PK & WASHER
 ON SURFACE - ~~BELOW~~ YES
~~LEFT~~ - Q PAV'T - ~~RIGHT~~ YES
9.3' TO RT. EDGE PAVEMENT
 S.L.M. 793+86
 Grid: Northing: 571235.581 Easting: 1564554.625

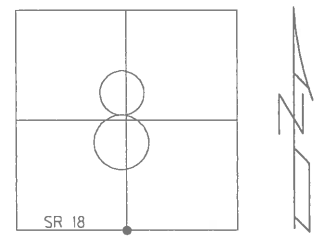


RECORD:
 FD 1" IRON PIN
 6" DEEP. SET
 RR SPK OVER

SET SM RR SPK
 10-14-86 MDB

SET PK WASHER
 9-7-95 SAH

SET MAG WASHER
 7-20-10 SAH

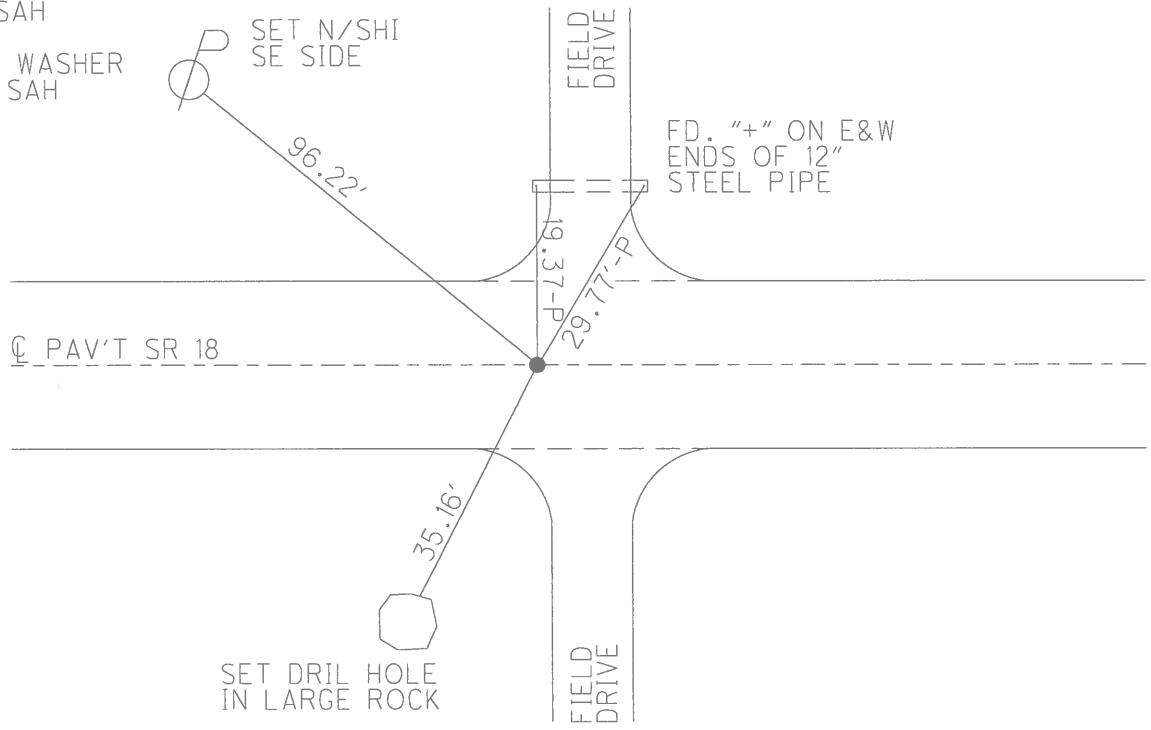


O.D.O.T. DISTRICT 2 SURVEY OFFICE (USE ONLY)

PERSONNEL	REFERENCE NO. <u>32</u>	SHEET <u>2</u> OF <u>3</u>
NOTES <u>CANTERBURY</u>	DATE <u>06-04-07</u>	ROUTE <u>SR 18</u>
H.C. <u>CANTERBURY</u>	WEATHER <u>SUNNY</u>	COUNTY <u>HENRY</u>
R.C. <u>MIKLOVICK</u>	TEMP. <u>+80°</u>	TOWNSHIP <u>BARTLOW</u>
		SECTION <u>8</u>
		T <u>3</u> N R <u>8</u> E

TYPE MONUMENT FD. PK/WASHER
 ON SURFACE - ~~BELOW~~ ON SURFACE
 LEFT - C PAV'T - RIGHT ON CL.
9.4' TO RT. EDGE PAVEMENT
 S.L.M. 794+02 (SV4)

Grid: Northing: 571235.644 Easting: 1564554.630

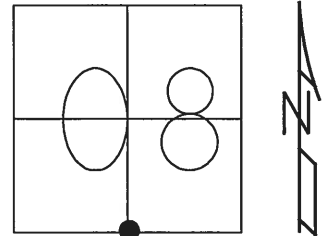


FD. PK. WASHER
06-07-95 SAH

SET PK. WASHER
09-07-95 SAH

RECORD: 1" I.P. 6" DEEP
SET RR.SP.K. OVER

SET SM.RR.SP.K.
10-14-86
M.D.B.

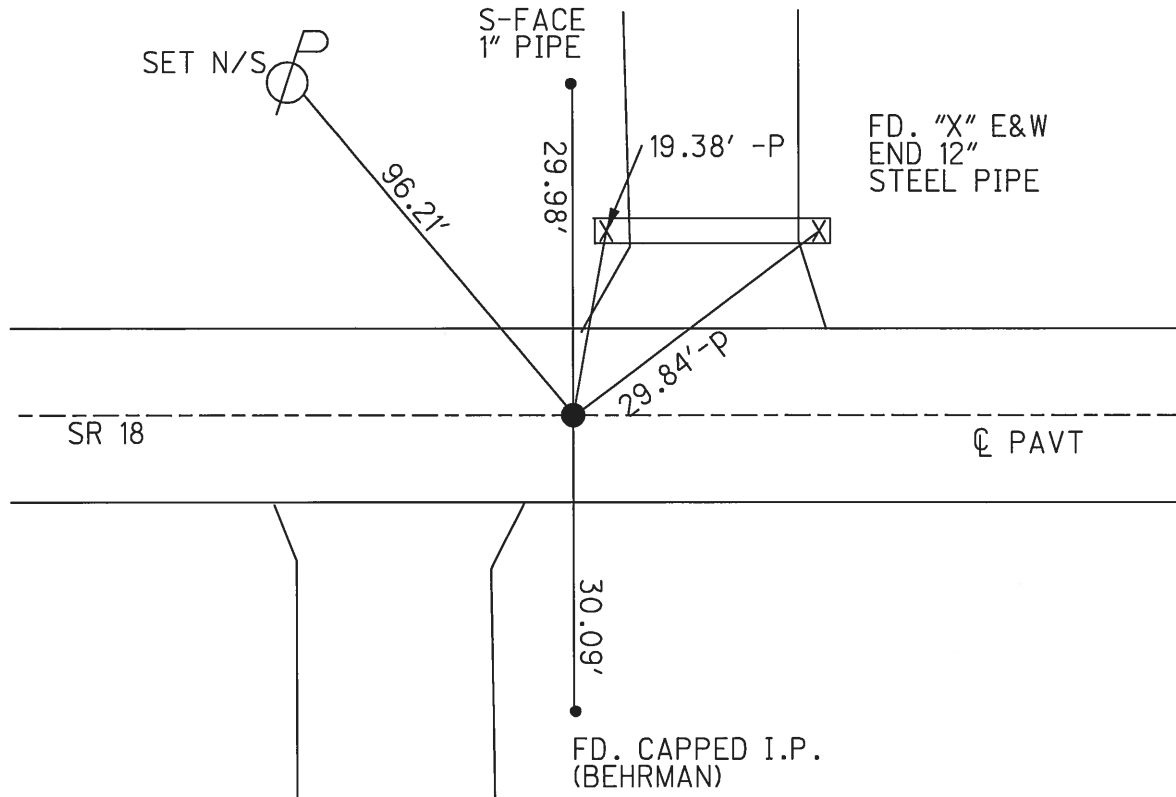

O.D.O.T. DISTRICT 2 SURVEY OFFICE

PERSONNEL

REFERENCE NO. 32

SHEET 11 OF 13

NOTES HUSS

H.C. VAN DUSEN

DATE 6-7-95

ROUTE SR 18

R.G. MOSEY

WEATHER SUNNY

COUNTY Henry

TEMP. +80°F

TOWNSHIP Bartlow

SECTION 8

T 3 N R 8 E


TYPE MONUMENT PK'S WASHER

ON SURFACE - ~~BELOW~~ YES


~~LEFT~~ - PAV'T. - ~~RIGHT~~ YES

7.4 TO RT EDGE PAVEMENT

S.L.M. 773+380

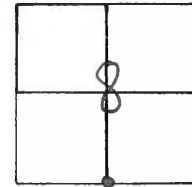

SET PK & WASHER
9-7-95
SAH

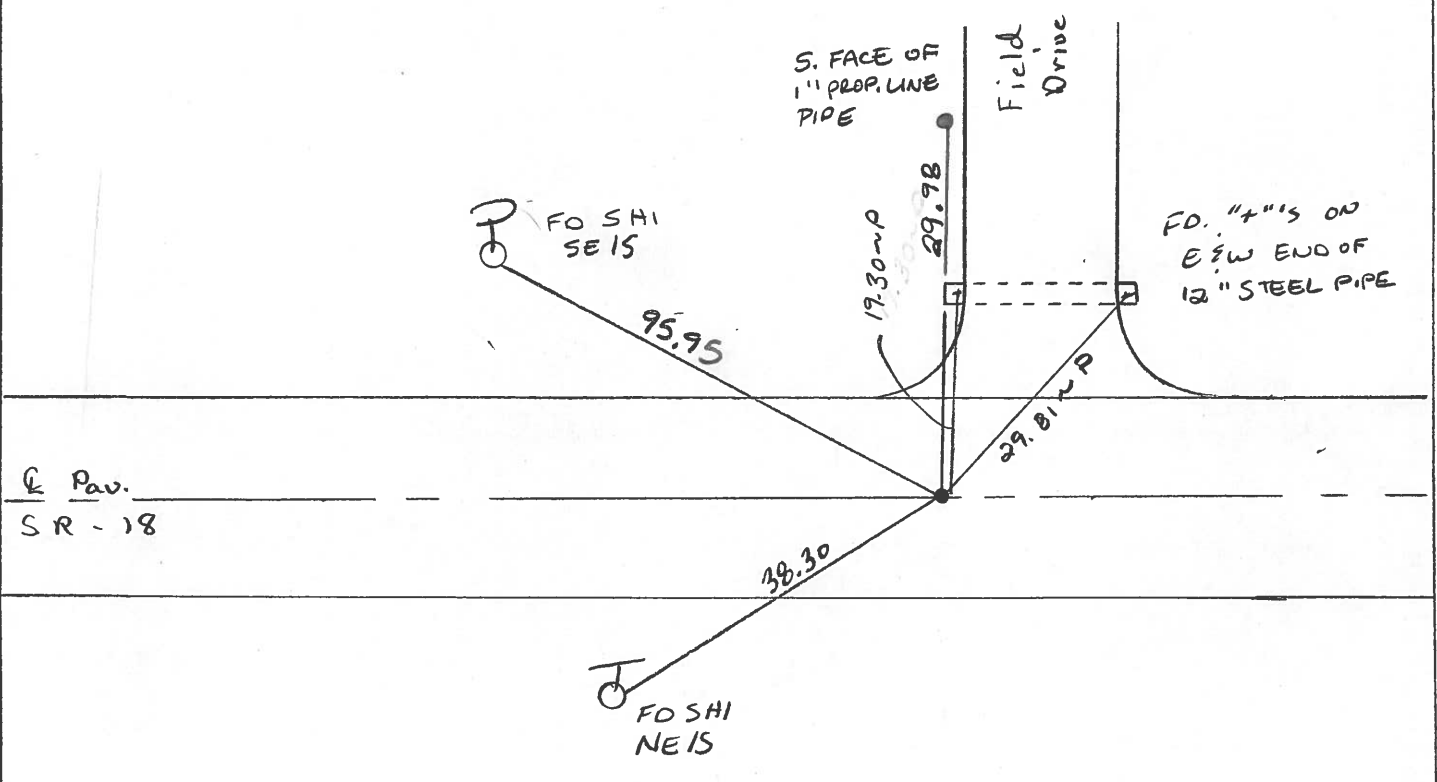

← Pav.
SR - 18

Set Sme RR Spk
10-14-86
M.D.B.

Record:
Fd 1" iron pin 6" dp
Set RR Spk. over

O.D.O.T. DISTRICT 2 SURVEY OFFICE

PERSONNEL

REFERENCE NO. 32

SHEET OF

NOTES BARNHISEL

H.C. Loehrke

R.C. SOCKMAN

DATE Aug 4, 1986

WEATHER SUNNY

TEMP. +84°

ROUTE SR 18

COUNTY HENRY

TOWNSHIP Barthow

SECTION 8

T3 N R 8 E


TYPE MONUMENT Sm RR Spk

ON SURFACE - BELOW yes


LEFT- & PAV'T. - RIGHT yes

8.8 TO RT EDGE PAVEMENT

S.L.M. 793+65

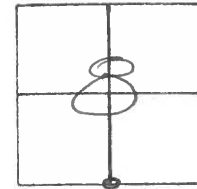

Set Sm RR Spk
10-14-86
MAB

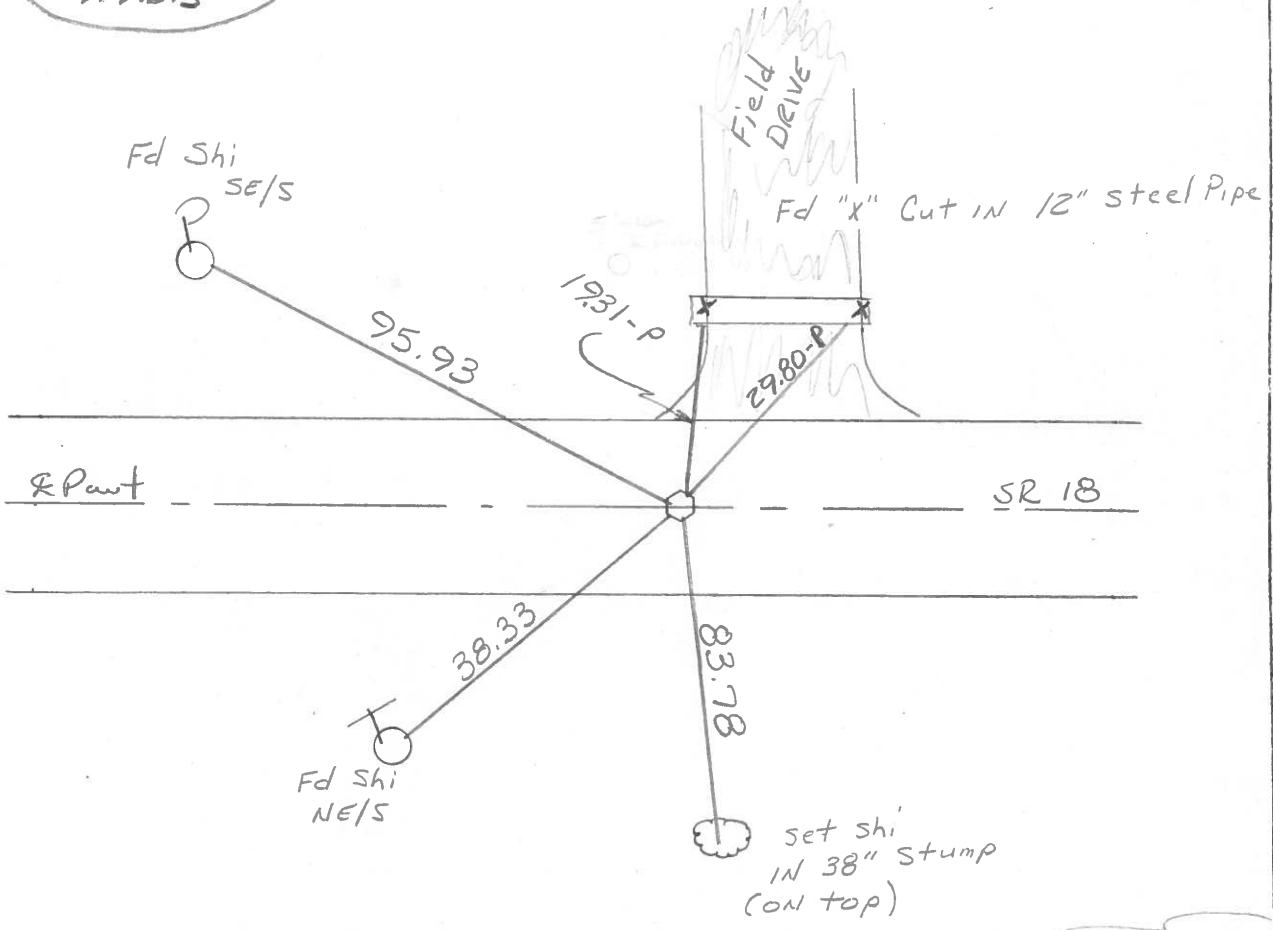


Record:
Fd 1" I. Pin 6" deep
Set R.R. Spk over

PERSONNEL	TITLE	PERSONNEL	TITLE	COUNTY	DATE
<u>Stone</u>				<u>Heary</u>	<u>8 Oct. 74</u>
<u>Michalek</u>				<u>#18</u>	<u>WEATHER Cool</u>
<u>Danna</u>				<u>SEC. Bartlow Twp.</u>	<u>TEMP. 45°</u>
<u>Curtis</u>					

DESCRIPTION Rifs. to Central points JOB NO. _____

LEFT CENTER LINE RIGHT

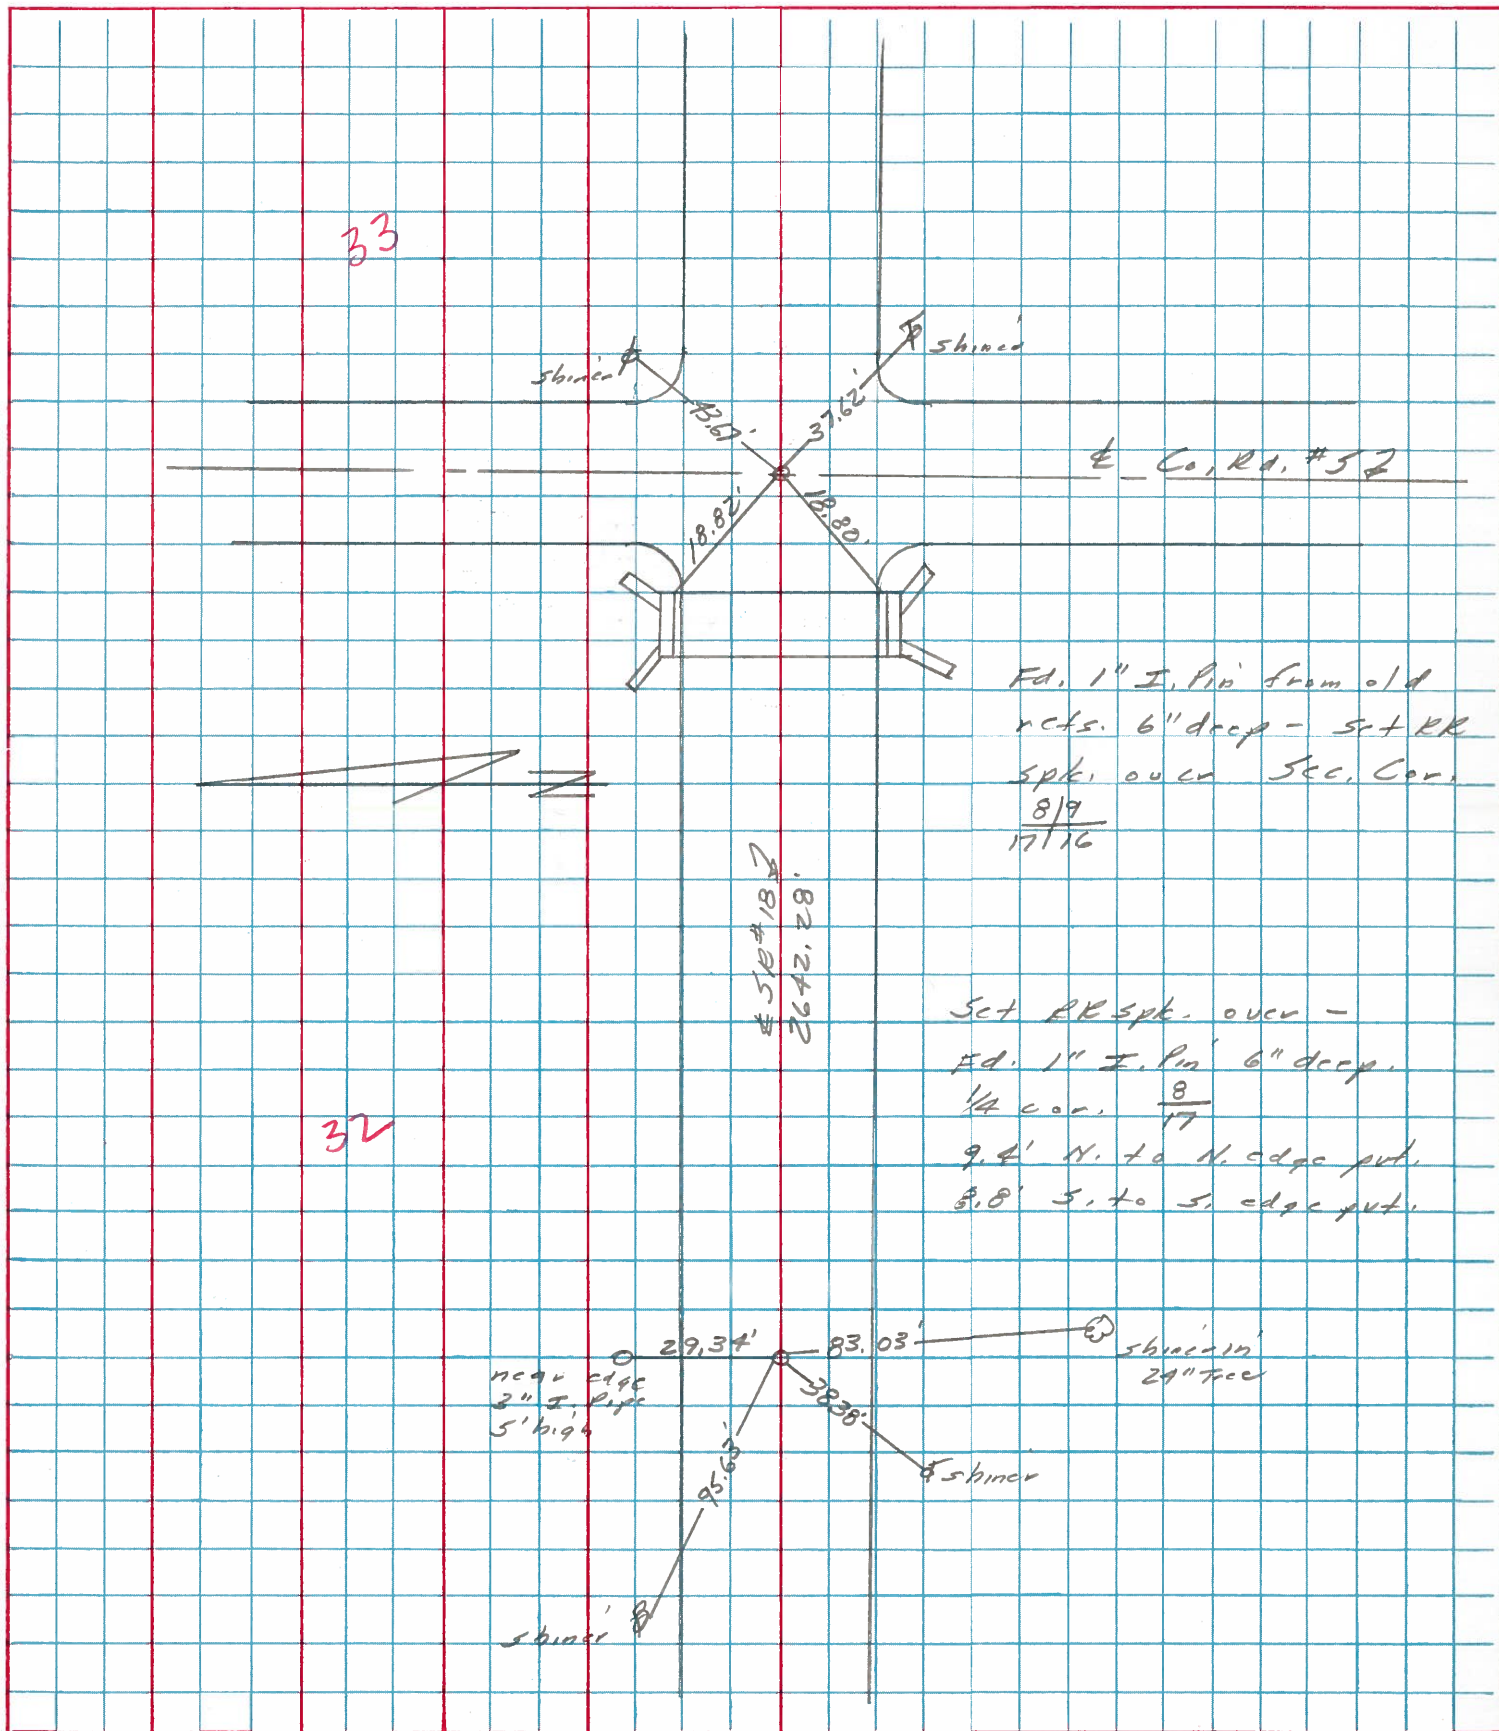

PERSONNEL TITLE PERSONNEL TITLE

Stone
 Michalak
 Deane
 Curtis

COUNTY Henry DATE 8 May 79

S. R. #18 WEATHER Cool

SEC. Bartlow Twp TEMP. 57°

DESCRIPTION


Alignment

JOB NO. 02999(10)

LEFT

CENTER LINE

RIGHT

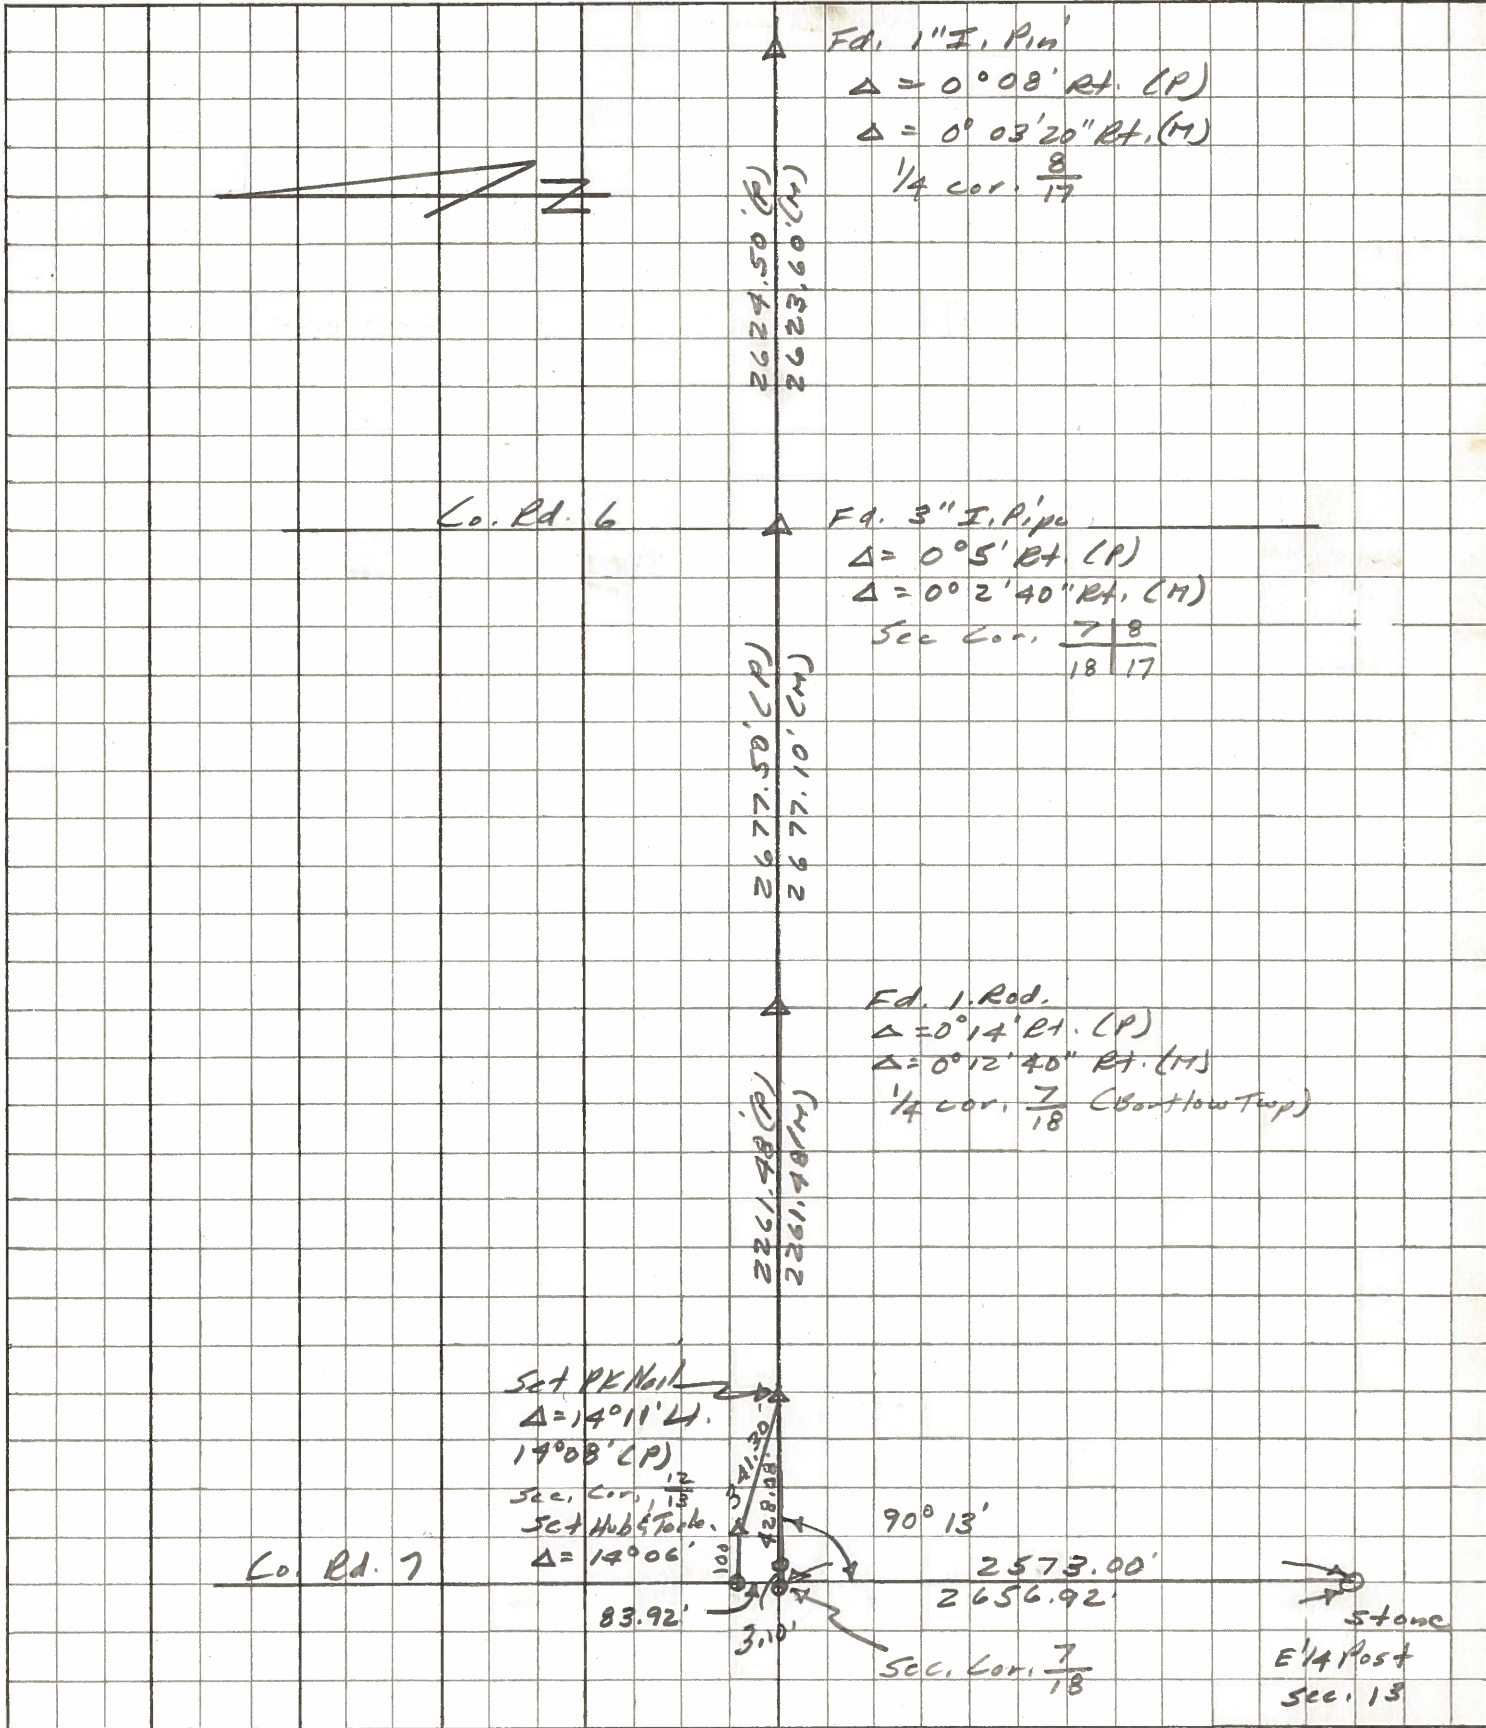

PERSONNEL	TITLE	PERSONNEL	TITLE	COUNTY	Henry	DATE	8 May 74
Stone				S. R.	18	WEATHER	Coal
Michalak				SEC.	Beetlow Top	TEMP.	50°
Dennis							
Curtis							

DESCRIPTION Alignment JOB NO. 02999(0)

