


O.D.O.T. DISTRICT 2 SURVEY OFFICE (USE ONLY)

PERSONNEL \_\_\_\_\_ REFERENCE NO. 36 SHEET 11 OF 12  
 NOTES RHOADES DATE 5/3/17 ROUTE SR 18  
 H.C. O'DONNELL WEATHER CLOUDY COUNTY HENRY  
 R.C. HELDMAN TEMP. 52° TOWNSHIP BARTLOW  
 \_\_\_\_\_ SECTION 16  
 \_\_\_\_\_ T 3 N R 8 E


TYPE MONUMENT MAG/WASHER  
 ON SURFACE - ~~BELOW~~ ON  
~~LEFT~~ - ☉ PAV'T - RIGHT 0.3'  
9.4' TO LT EDGE PAVEMENT  
 S.L.M. 900+20

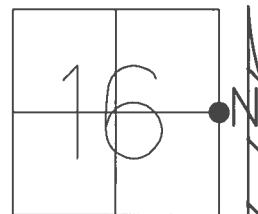

GRID: NORTHING: 568566.514 EASTING: 1572515.193

RECORD:  
 FD P.K./WASHER  
 9/9/02, DCH  
 SET P.K./WASHER  
 11/14/02, MB  
 FD P.K./WASHER  
 7/10/12, MC  
 FD MAG/WASHER  
 REF8  
 5/10/17, JFO  
 SET MAG/WASHER  
 NEWREF8  
 9/20/17, JFO

NOTE: REF 8 SR 65

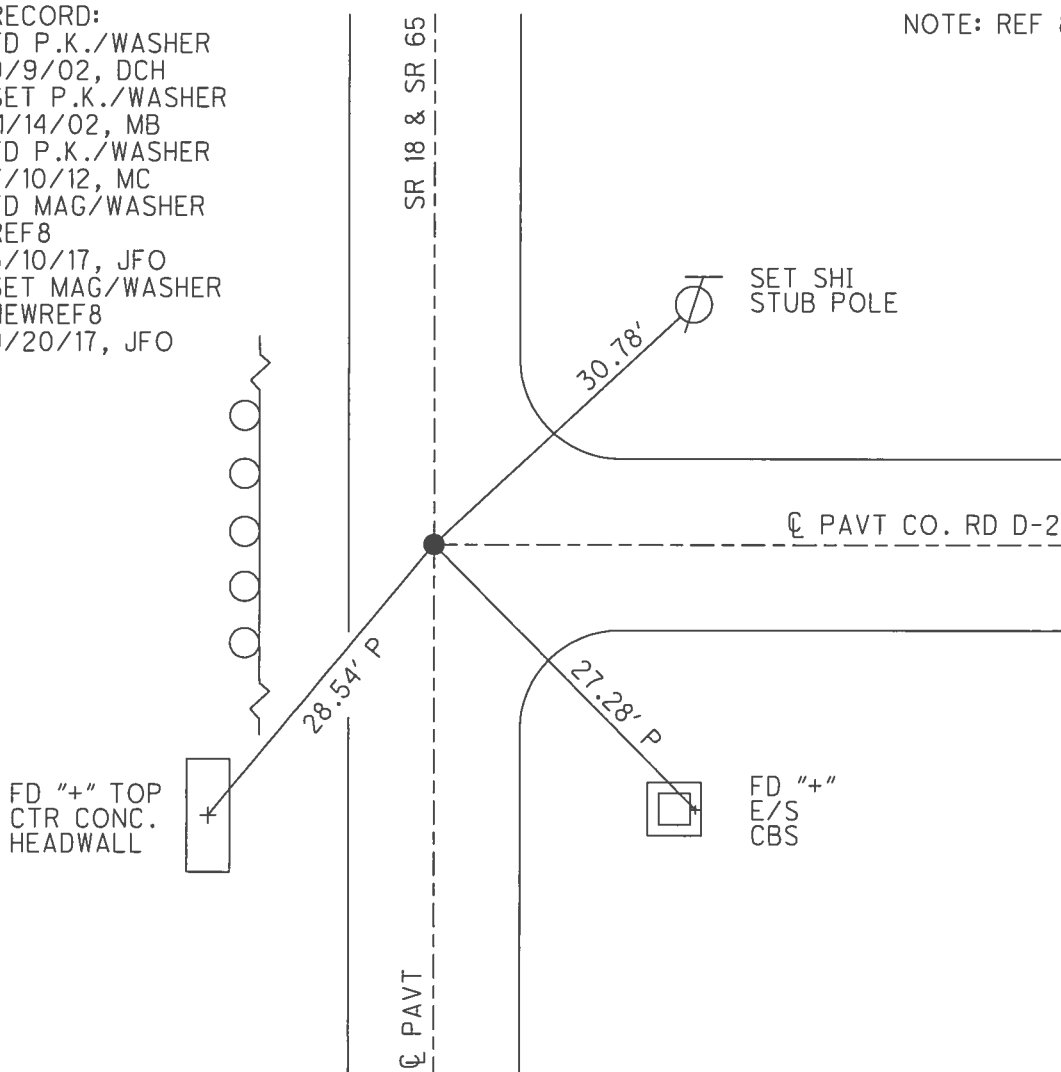

# O.D.O.T. DISTRICT 2 SURVEY OFFICE

SR #18 = #36

PERSONNEL \_\_\_\_\_

REFERENCE NO. 8

SHEET 9 OF 29

NOTES BARNHISEL RC

H.C. CANTERBURY

DATE 9-16-02

ROUTE 65

R.C. \_\_\_\_\_

WEATHER SUNNY

COUNTY HENRY

TEMP. +70°

TOWNSHIP BARTLOW

SECTION 16

T 3 N R 8 E


TYPE MONUMENT PK & WASHER

ON SURFACE - BELOW YES


LEFT - & PAV'T. - RIGHT YES

9.4' TO LT EDGE PAVEMENT

S.L.M. 184+90 SR 65 / 900+20 SR 18

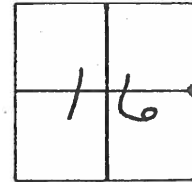

Reset PK & washer  
11-14-02  
MB

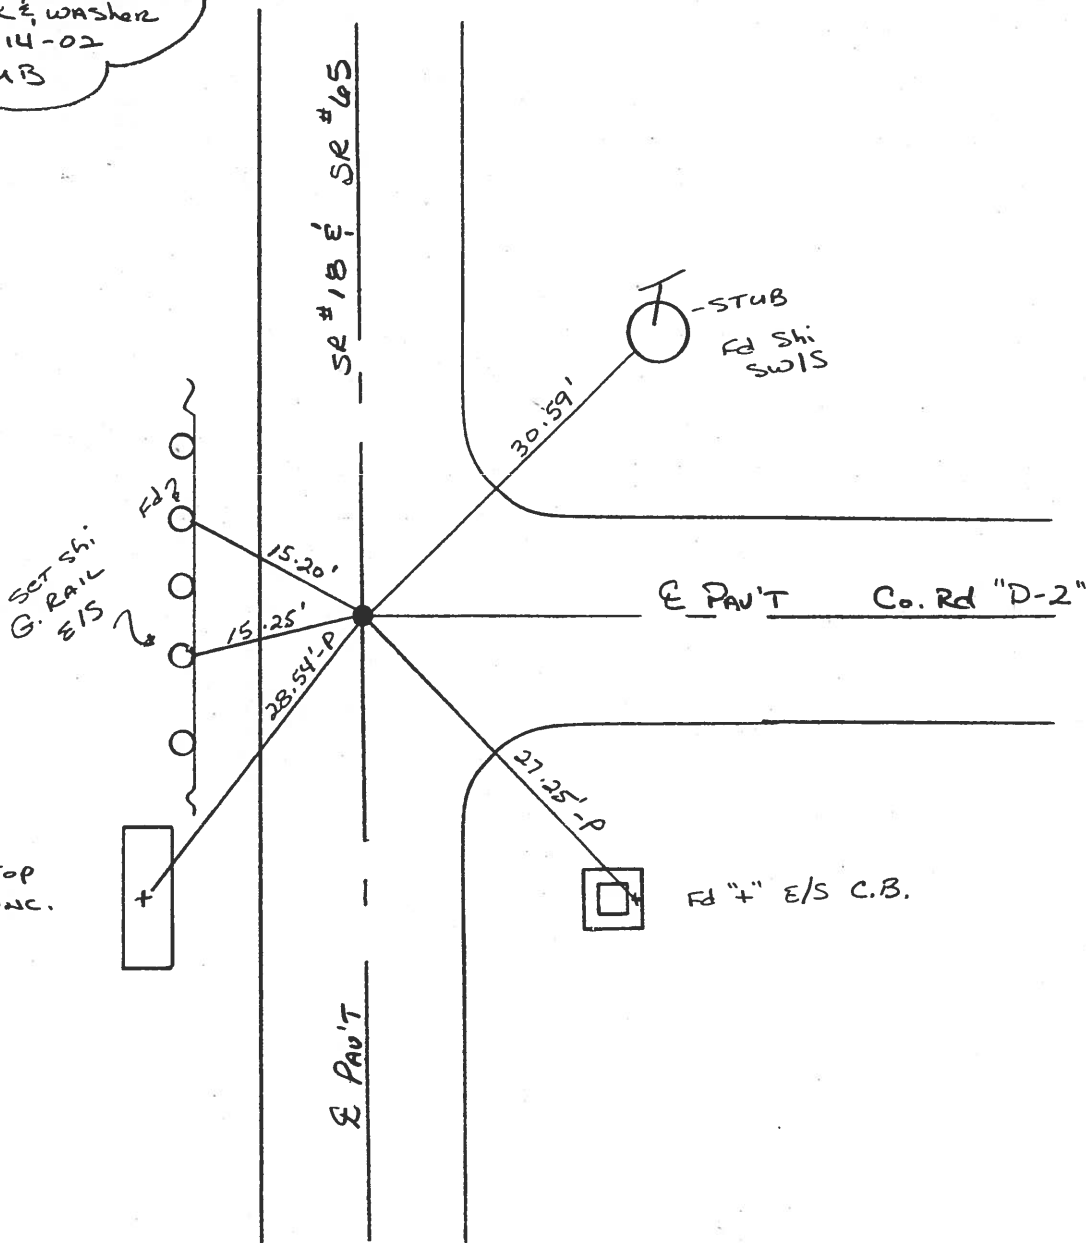

Fd "+" TOP  
CTR CONC.  
Hdwl

Fd "+" E/S C.B.

# O.D.O.T. DISTRICT 2 SURVEY OFFICE

PERSONNEL

REFERENCE NO.

S.R. 65 = #8

S.R. 18 = #34

SHEET 9 OF 18

NOTES BARNHISEL

H.C. KUSZ

DATE 7-21-93

ROUTE S.R. 65

R.C. BARNHISEL

WEATHER SUNNY

COUNTY Henry

OTTO A

TEMP. +25° F

TOWNSHIP Barlow

SECTION 16

T 3 N R 8 E


TYPE MONUMENT P.K. + WASHER

ON SURFACE - ~~BELOW~~ YES


LEFT - & PAV'T. - RIGHT YES

2.8 TO LT. EDGE PAVEMENT

S.L.M. 200+82 (SR 18) 185+44 (SR 65)

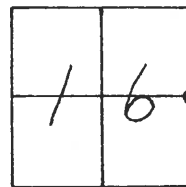


SET PK & WASHER  
 10-13-93  
 MB

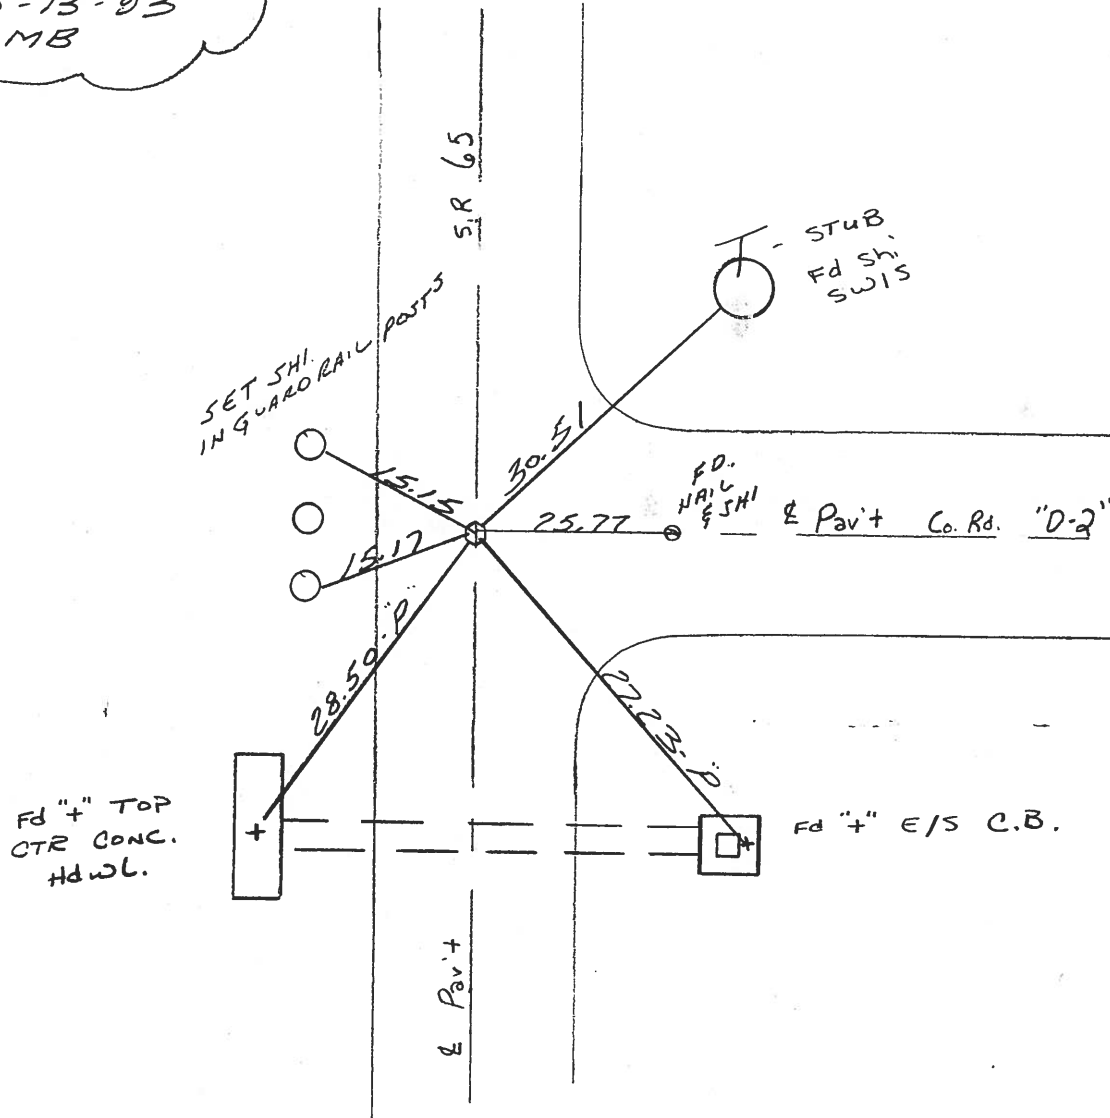

PERSONNEL	TITLE	PERSONNEL	TITLE	COUNTY	DATE	WEATHER	TEMP.
Stone				Henry	8 Oct. 74	Cool	50°
Michalek				#18			
Denno				Sec. Part low Twp			
Curtis							

DESCRIPTION Refs. to Control Points LEFT CENTER LINE RIGHT JOB NO.

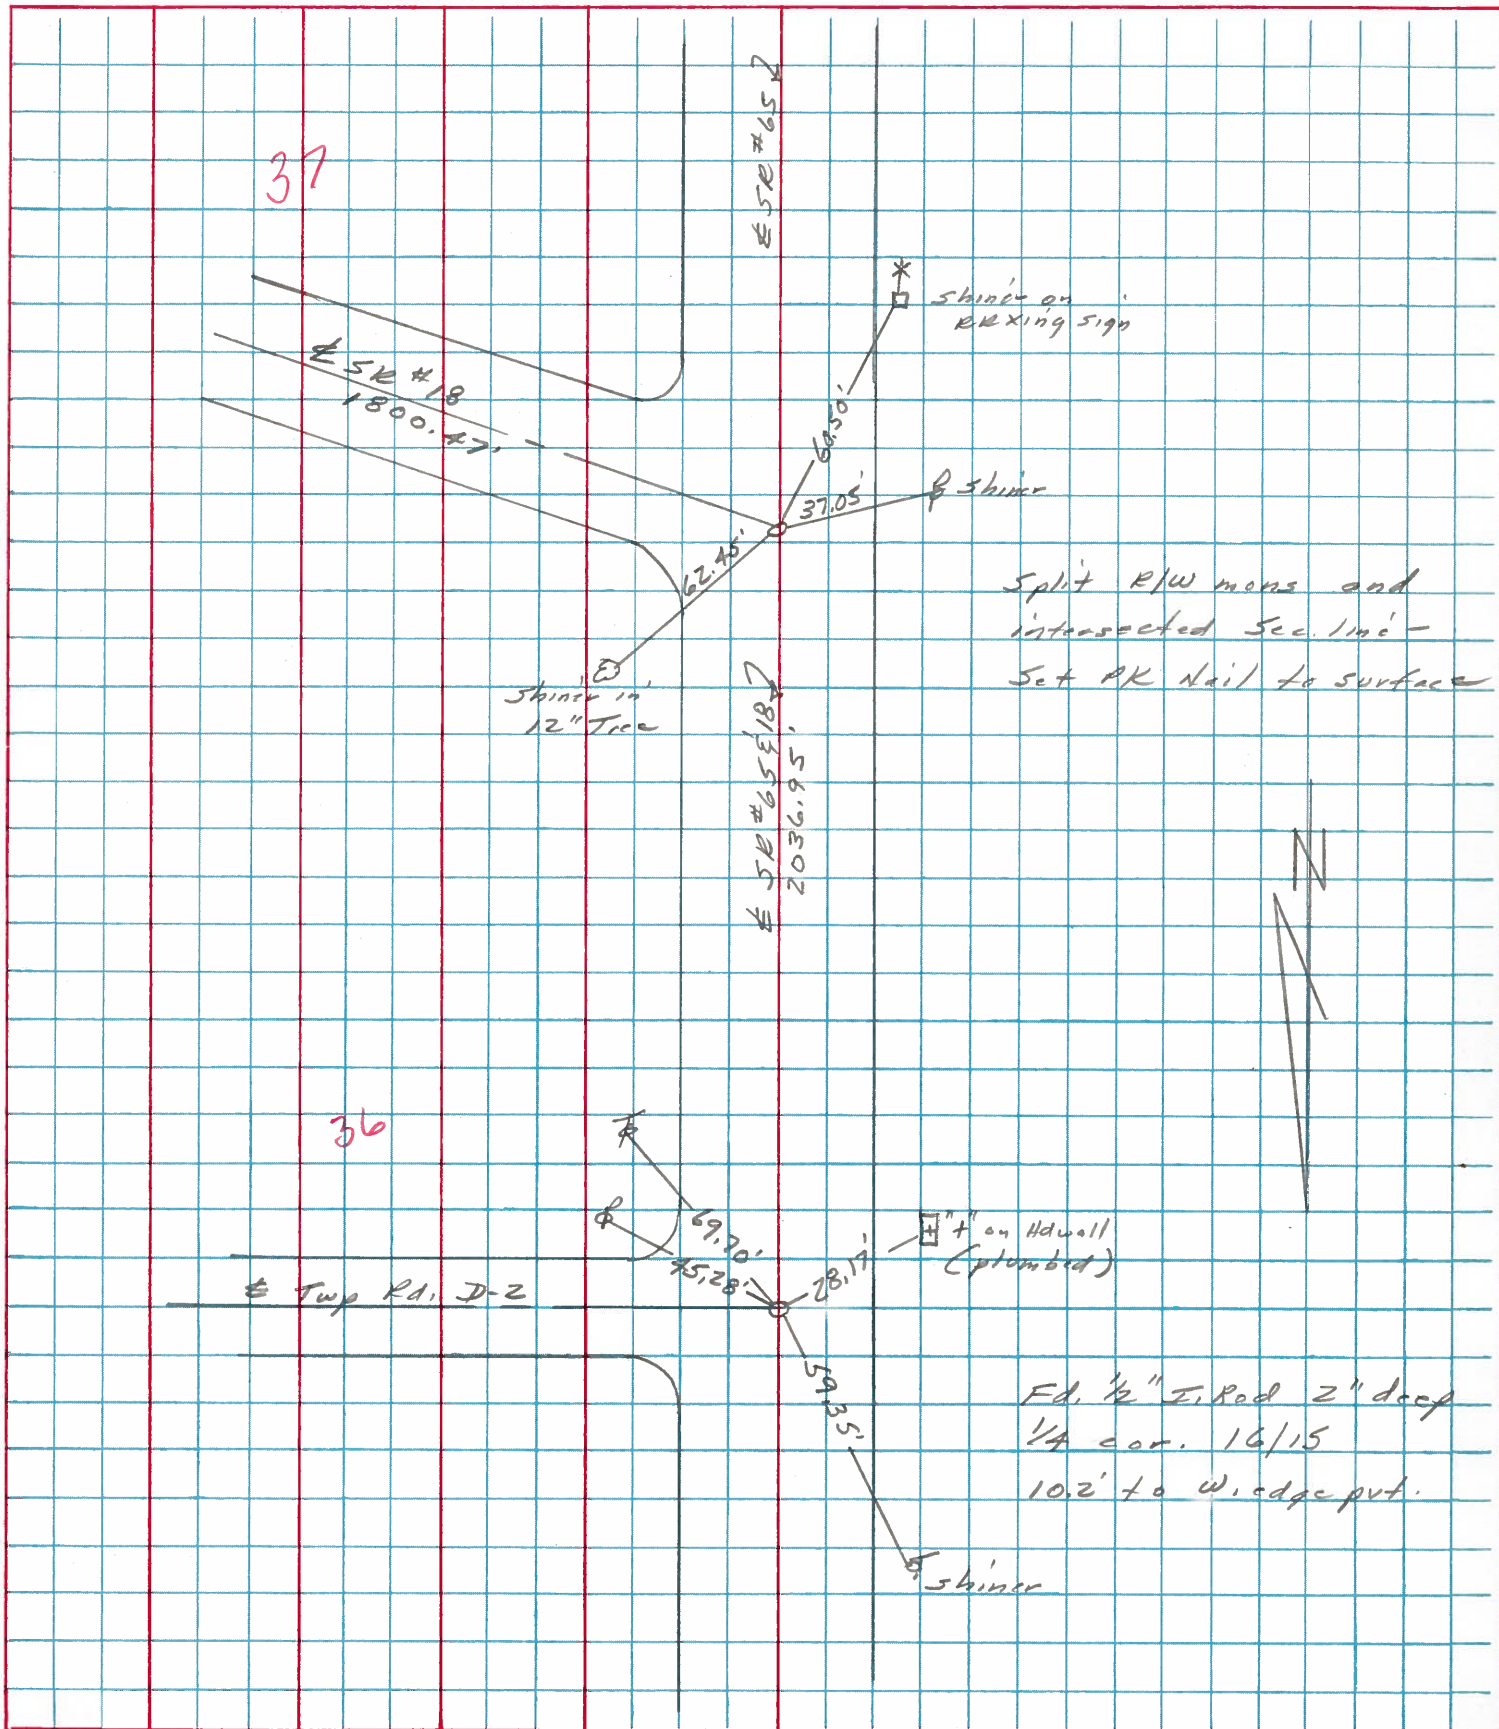

PERSONNEL TITLE PERSONNEL TITLE

Stone  
 Michalak  
 Deane  
 Curtis

COUNTY Henry DATE 8 May 79

S. R. #18 WEATHER Cool

SEC. Bartlow Twp TEMP. 57°

DESCRIPTION


Alignment

JOB NO. 02999(10)

LEFT

CENTER LINE

RIGHT

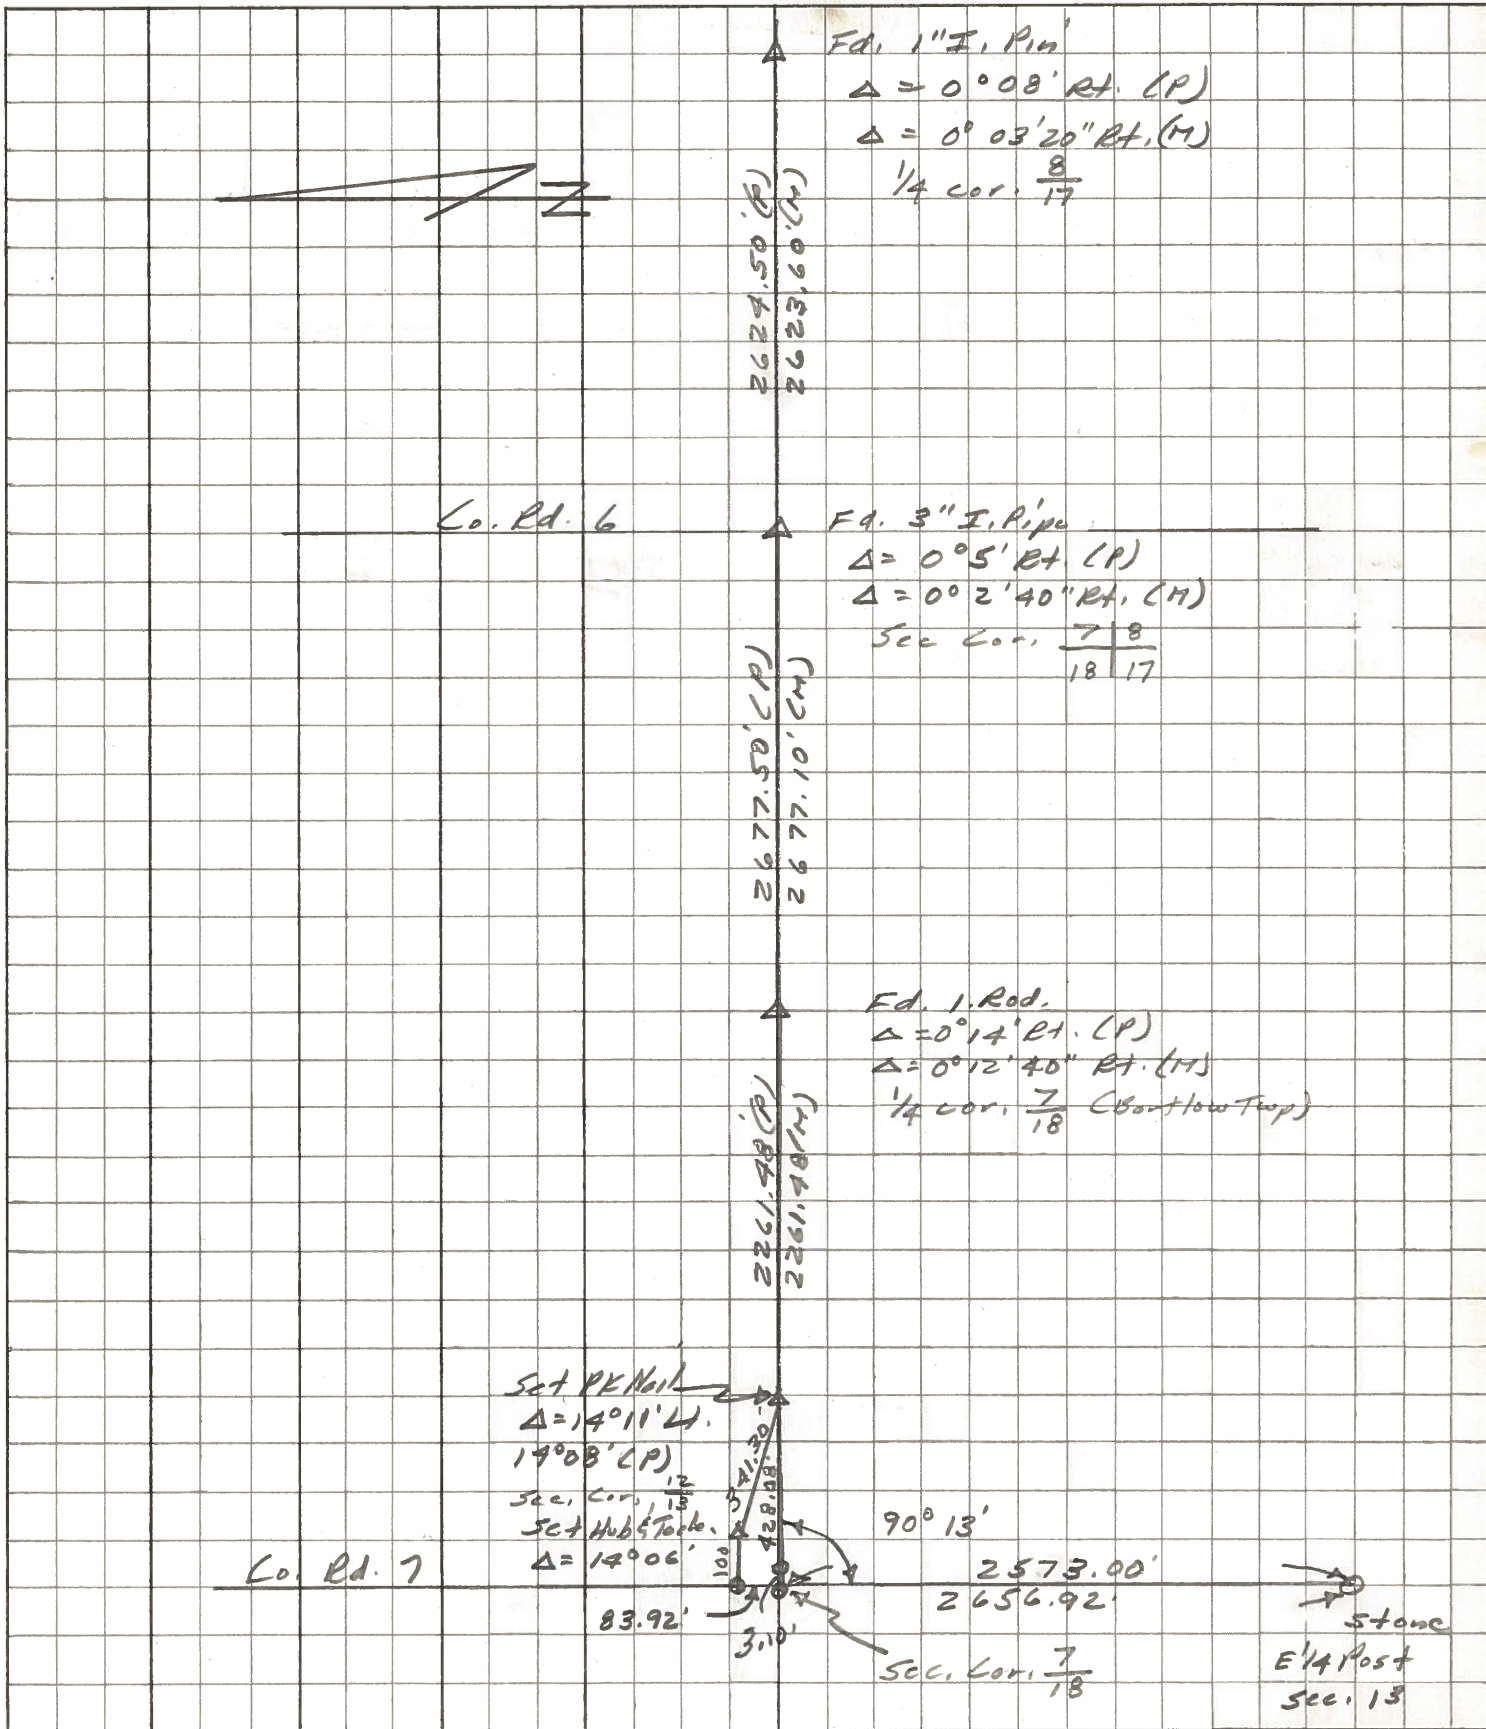

PERSONNEL	TITLE	PERSONNEL	TITLE	COUNTY	Henry	DATE	8 May 74
Stone				S. R.	18	WEATHER	Cool
Michalak				SEC.	Beetlow Top	TEMP.	50°
Dennis							
Curtis							

DESCRIPTION Alignment JOB NO. 02999(0)

