

O.D.O.T. DISTRICT 2 SURVEY OFFICE (USE ONLY)

PERSONNEL

REFERENCE NO. 38

SHEET 1 OF 17

NOTES AUBLE
 H.C. NIESE
 R.C. O'DONNELL

DATE 5/17/21
 WEATHER CLOUDY
 TEMP. 70°

ROUTE SR 18
 COUNTY HENRY
 TOWNSHIP BARTLOW
 SECTION 15
 T 3 N R 8 E

DWG BY NIESE PID PAVETRAIN

TYPE MONUMENT MAG/WASHER

ON SURFACE - ~~BELOW~~ ON

OFFSET \odot PAVEMENT 2.0' ~~LT~~ : RT

7.5' TO RT EDGE PAVEMENT


STATION: 938+54

HORZ.DATUM: NAD83(2011)


GEOID: NAVD88 2012A

GRID: NORTHING: 566059.803

EASTING: 1574244.271

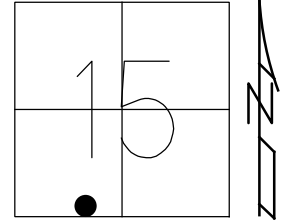


RECORD:
 FD P.K./WASHER
 9/16/02, MB
 SET MAG/WASHER
 NEWREF38
 5/17/21, JFO
 FD MAG/WASHER
 9/3/21, TDN

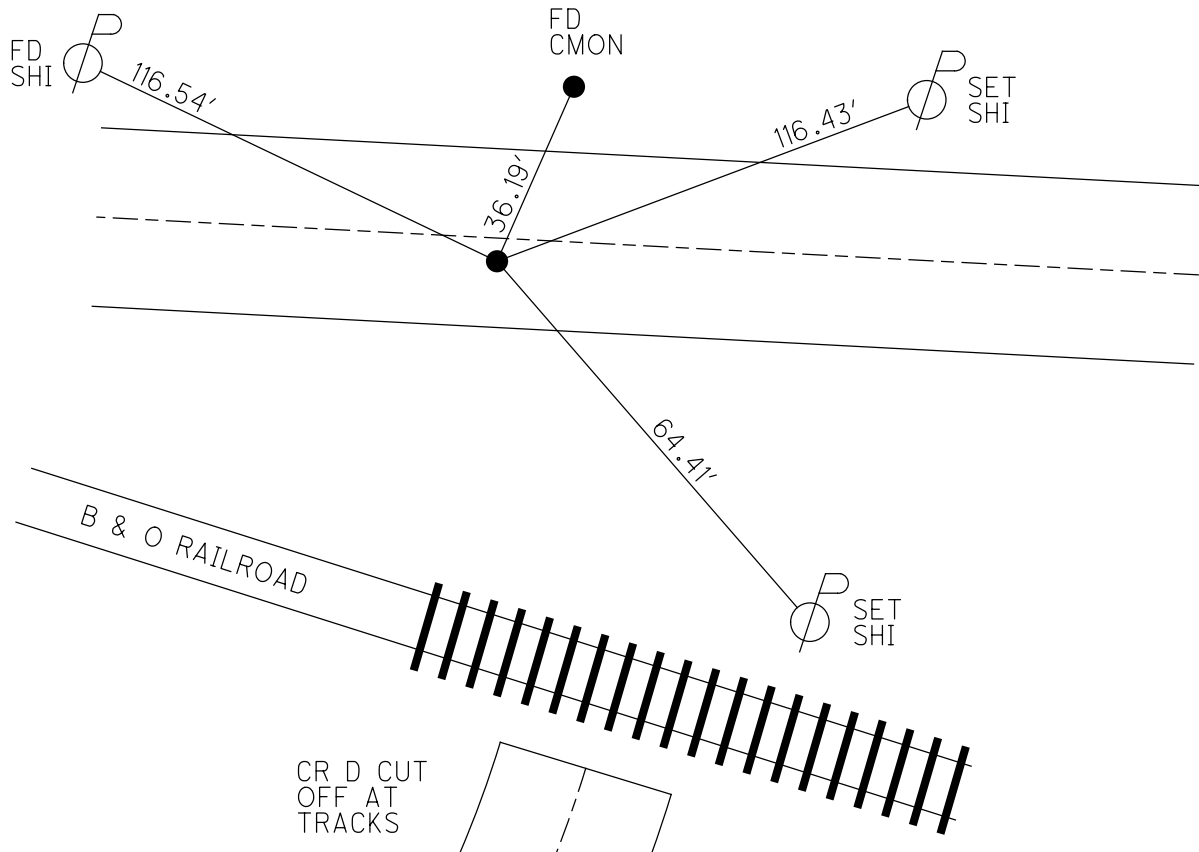

O.D.O.T. DISTRICT 2 SURVEY OFFICE (USE ONLY)


PERSONNEL _____ REFERENCE NO. 38 SHEET 1 OF 17
 NOTES BARNHISEL DATE 9/16/02 ROUTE SR 18
 H.C. CANTERBURY WEATHER SUNNY COUNTY HENRY
 R.C. BARNHISEL TEMP. 70° TOWNSHIP BARTLOW
 SECTION 15
 DWG BY NIESE PID _____ T 3 N R 8 E

TYPE MONUMENT P.K./WASHER
 ON SURFACE - ~~BELOW~~ ON
 OFFSET 7.5' TO RT EDGE PAVEMENT
 STATION: 938+54

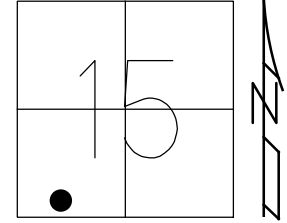

HORZ. DATUM: _____ GEOID: _____
 GRID: NORTHING: _____ EASTING: _____

RECORD:
 FD P.K./WASHER
 9/16/02, MB


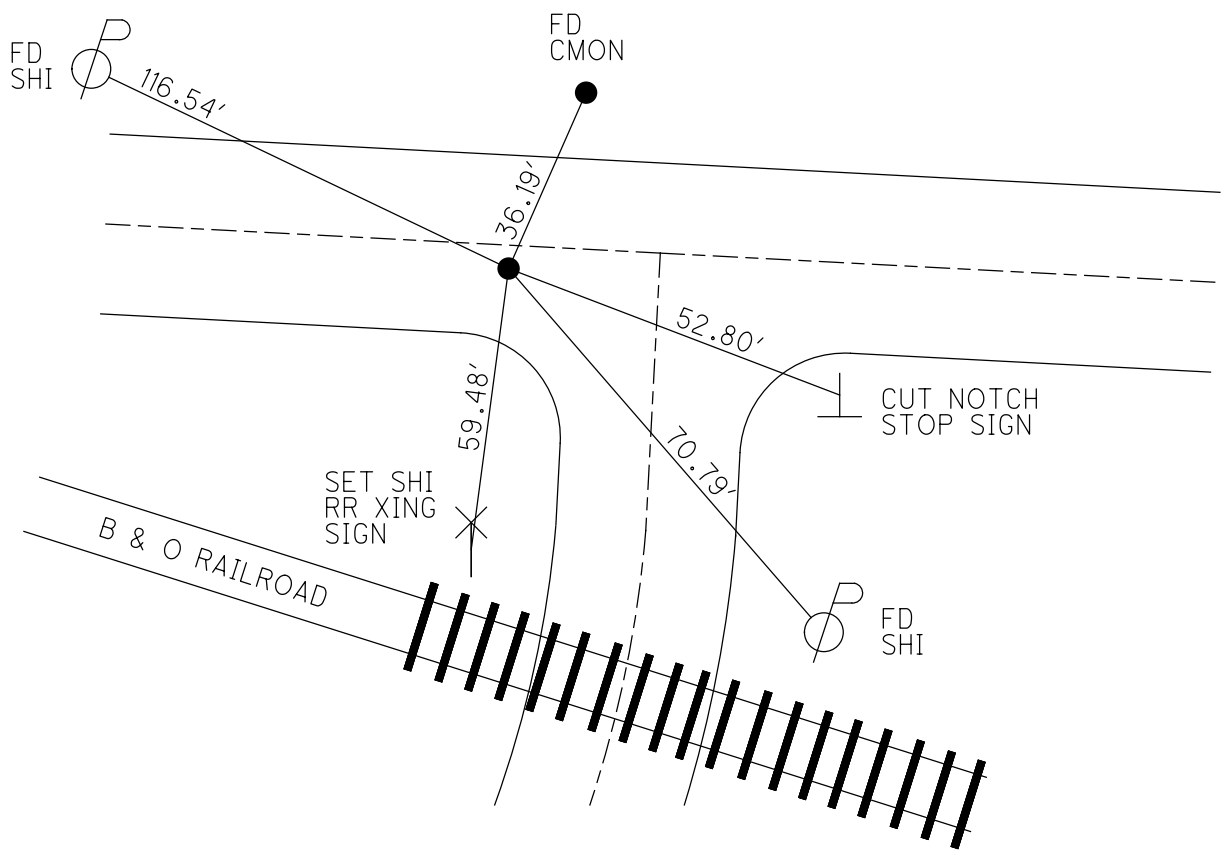


O.D.O.T. DISTRICT 2 SURVEY OFFICE

PERSONNEL _____ REFERENCE NO. 38 SHEET 1 OF 3

NOTES Barnhisel
 H.C. Canterbury DATE 9-16-02 ROUTE SR 18
 R.C. Barnhisel WEATHER Sunny COUNTY Henry
 _____ TEMP. +70° TOWNSHIP Bartlow
 _____ SECTION 15
 T. 3 N. R 8 E

TYPE MONUMENT PK + Washer
 ON SURFACE - ~~BELOW~~ on surface
~~LEFT - PAV'T - RIGHT~~ 2'
7.5' TO RT EDGE PAVEMENT
 S.L.M. 938+54 31' west of E Rd. "D"

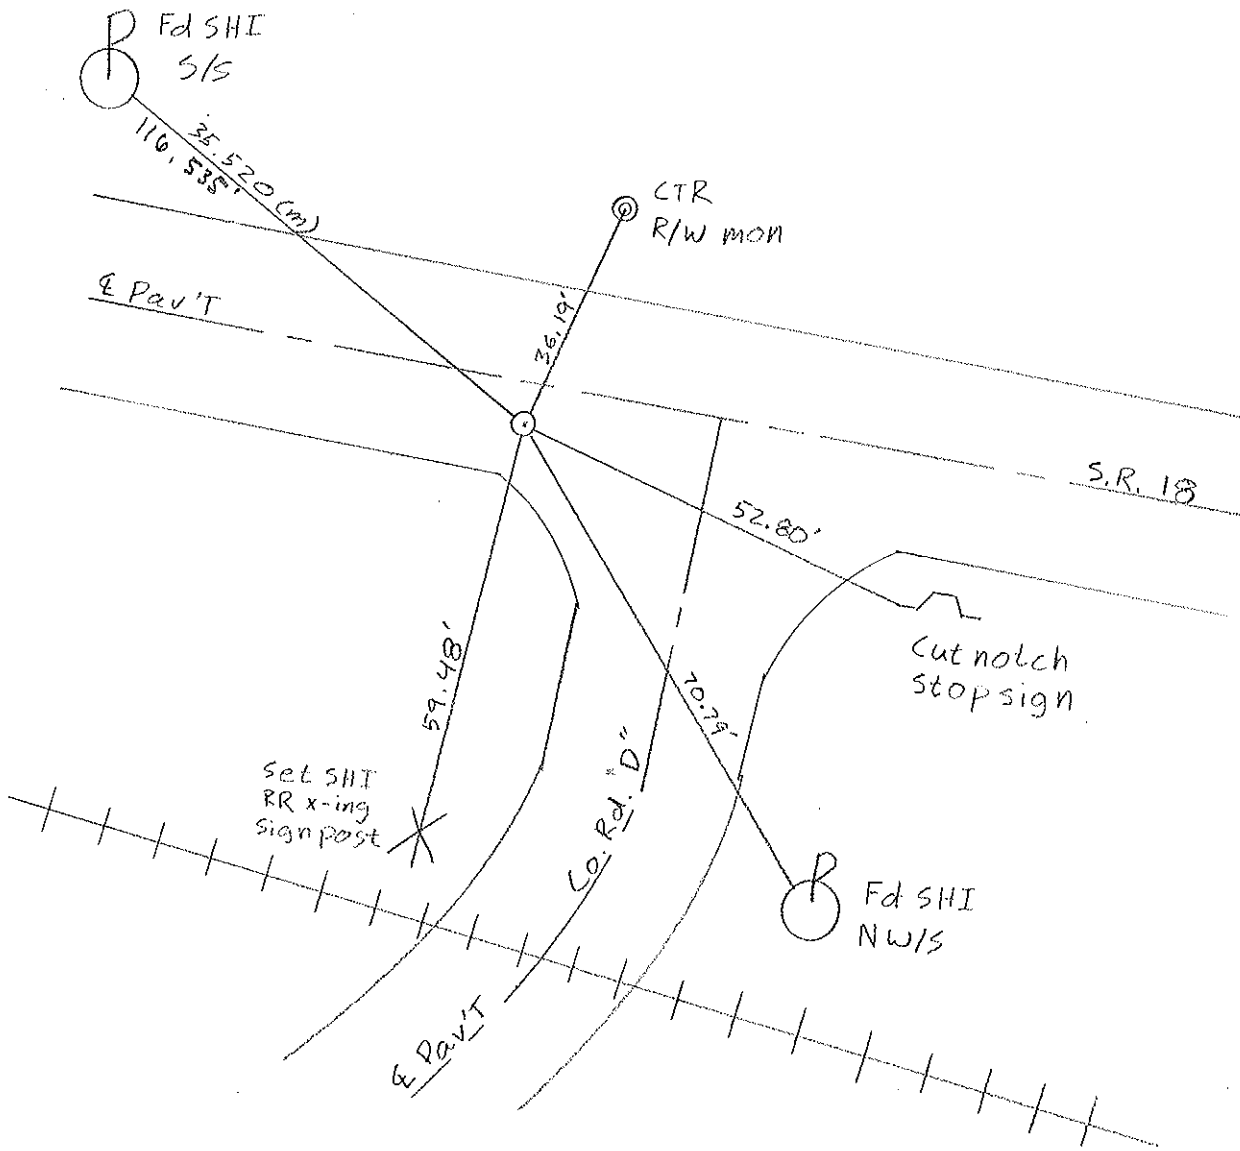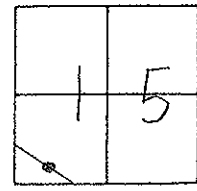

RESURFACED 2003

O.D.O.T. DISTRICT 2 SURVEY OFFICE

PERSONNEL

REFERENCE NO. 38

SHEET 1 OF 3

NOTES OTTO

H.C. KUSZ

R.C. BARNHISEL

DATE 7-22-93

WEATHER SUNNY

TEMP. +65°

ROUTE SR 18

COUNTY HENRY

TOWNSHIP BARTLOW

SECTION 15

T3 N R 8 E

TYPE MONUMENT PK & WASHER


ON SURFACE - ~~BELOW~~ YES

~~EST~~ - PAV'T. - RIGHT 1.9


8.5 TO RT EDGE PAVEMENT

S.L.M. 938+54

31' WEST OF E Rd "D"

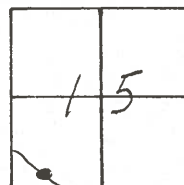

Reset PK & WASHER
10-13-93
M13

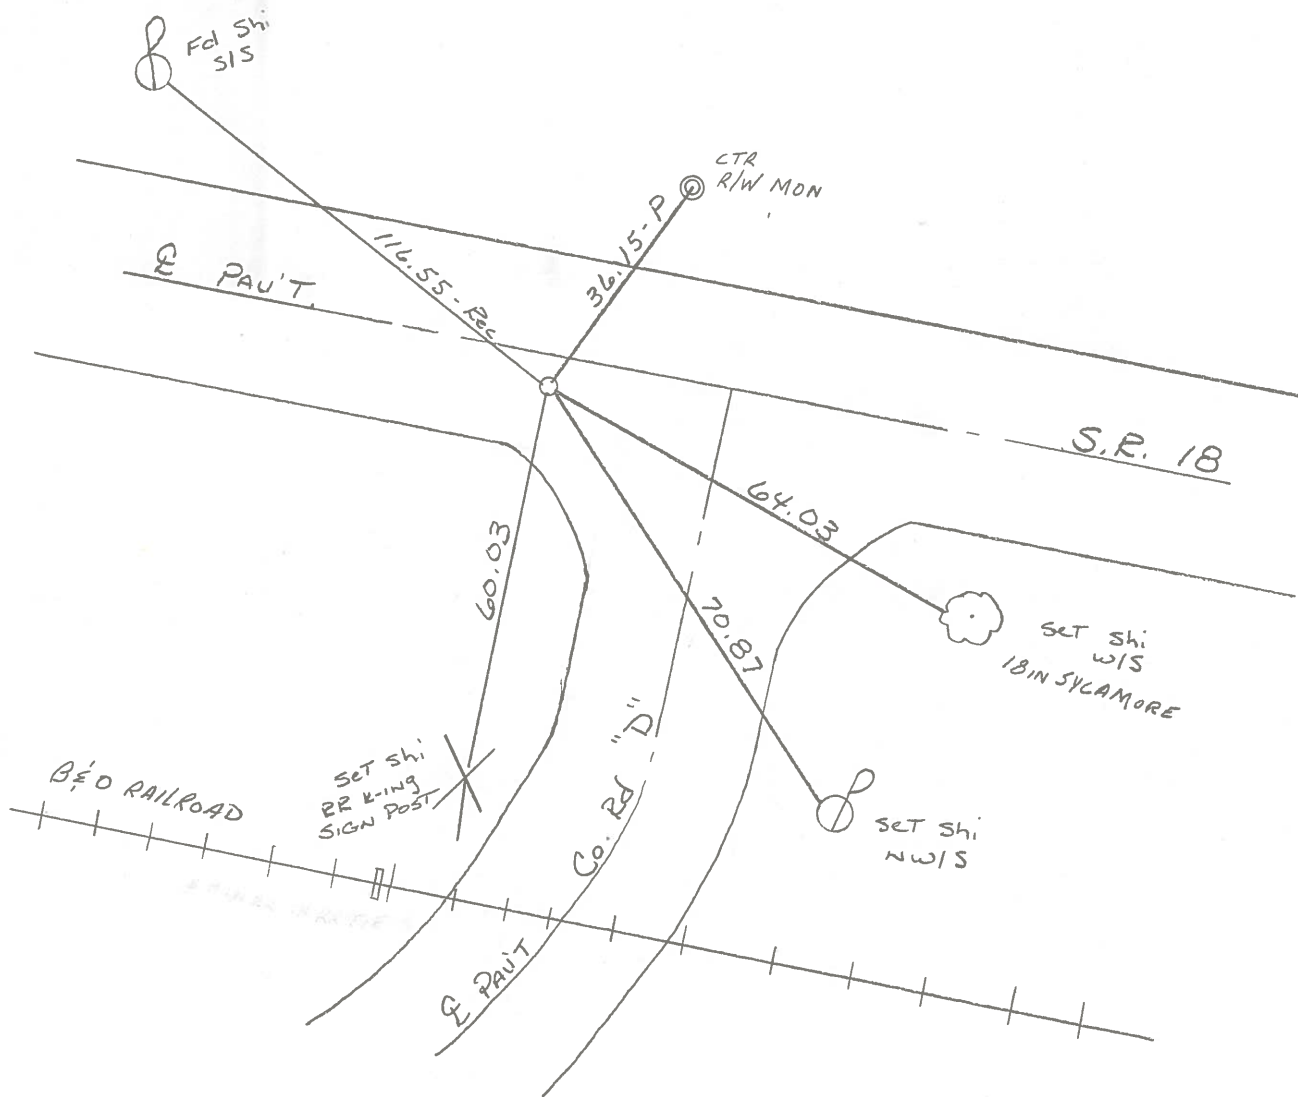

Resurfaced 1993

O.D.O.T. DISTRICT 2 SURVEY OFFICE

PERSONNEL

REFERENCE NO. 38

SHEET ___ OF ___

NOTES Hoffman

H.C. BARNHISEL

R.C. LOWENKUE

DATE 5-15-85

WEATHER Cloudy

TEMP. 70°

ROUTE SR 18

COUNTY HENRY

TOWNSHIP BARTLOW

SECTION 15

T3 N R 8 E


TYPE MONUMENT P.K.

ON SURFACE - ~~BELOW~~ yes


LEFT - ~~C~~ PAV'T. - RIGHT 2.0'

8.0 TO RT EDGE PAVEMENT

S.L.M. 939 + 79

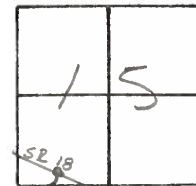


Set PK/Washer
 5-28-85
 M.D.B.

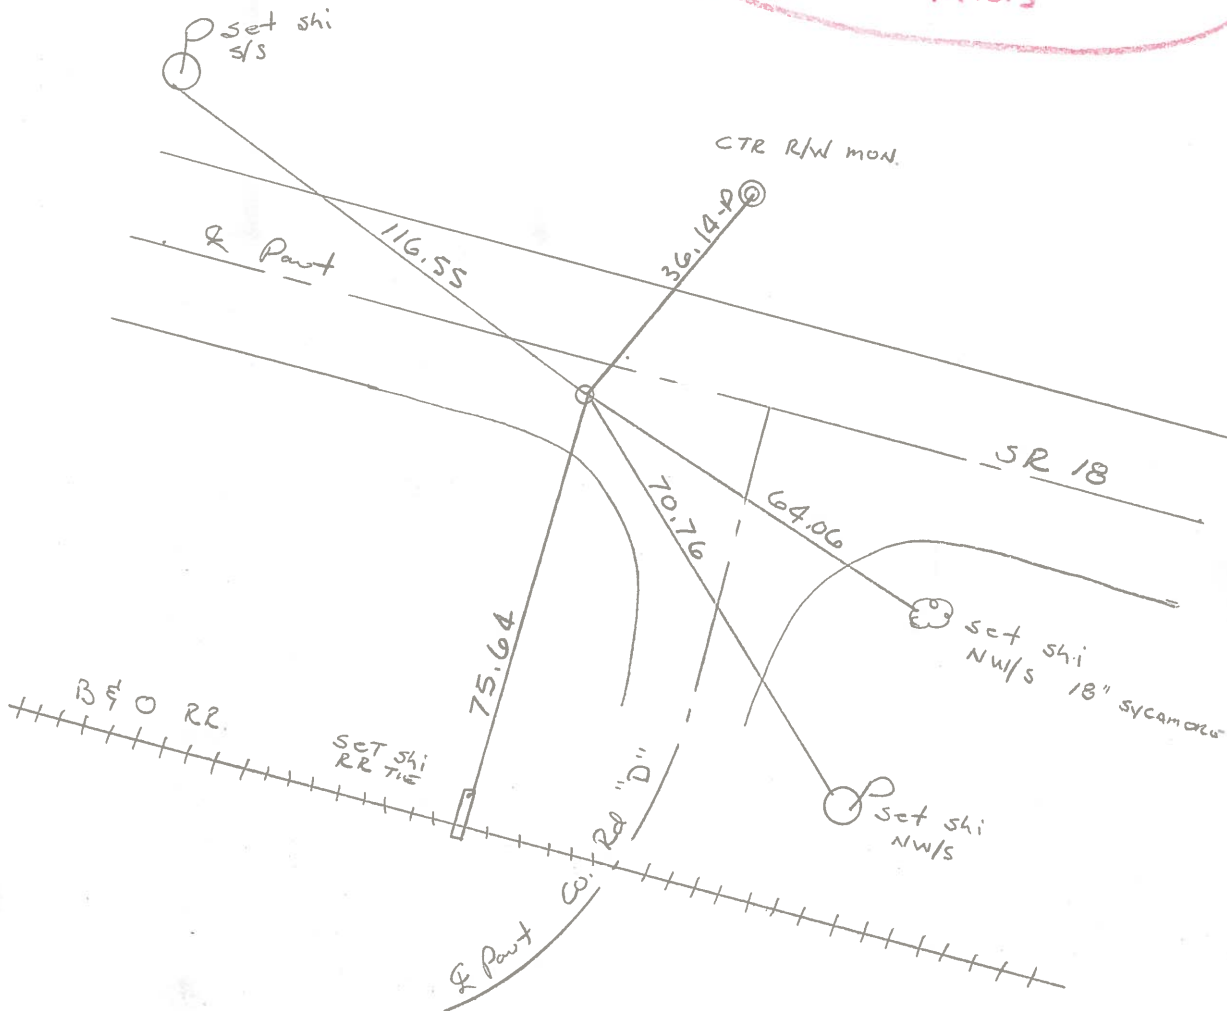

PERSONNEL	TITLE	PERSONNEL	TITLE	COUNTY	DATE
Stave				Henry	8 Oct. 74
Michalale				S. R. #18	WEATHER Cool
Denno				SEC. Bartlow Twp	TEMP. 50°
Curtis					

DESCRIPTION Refs. to Control Points JOB NO. _____

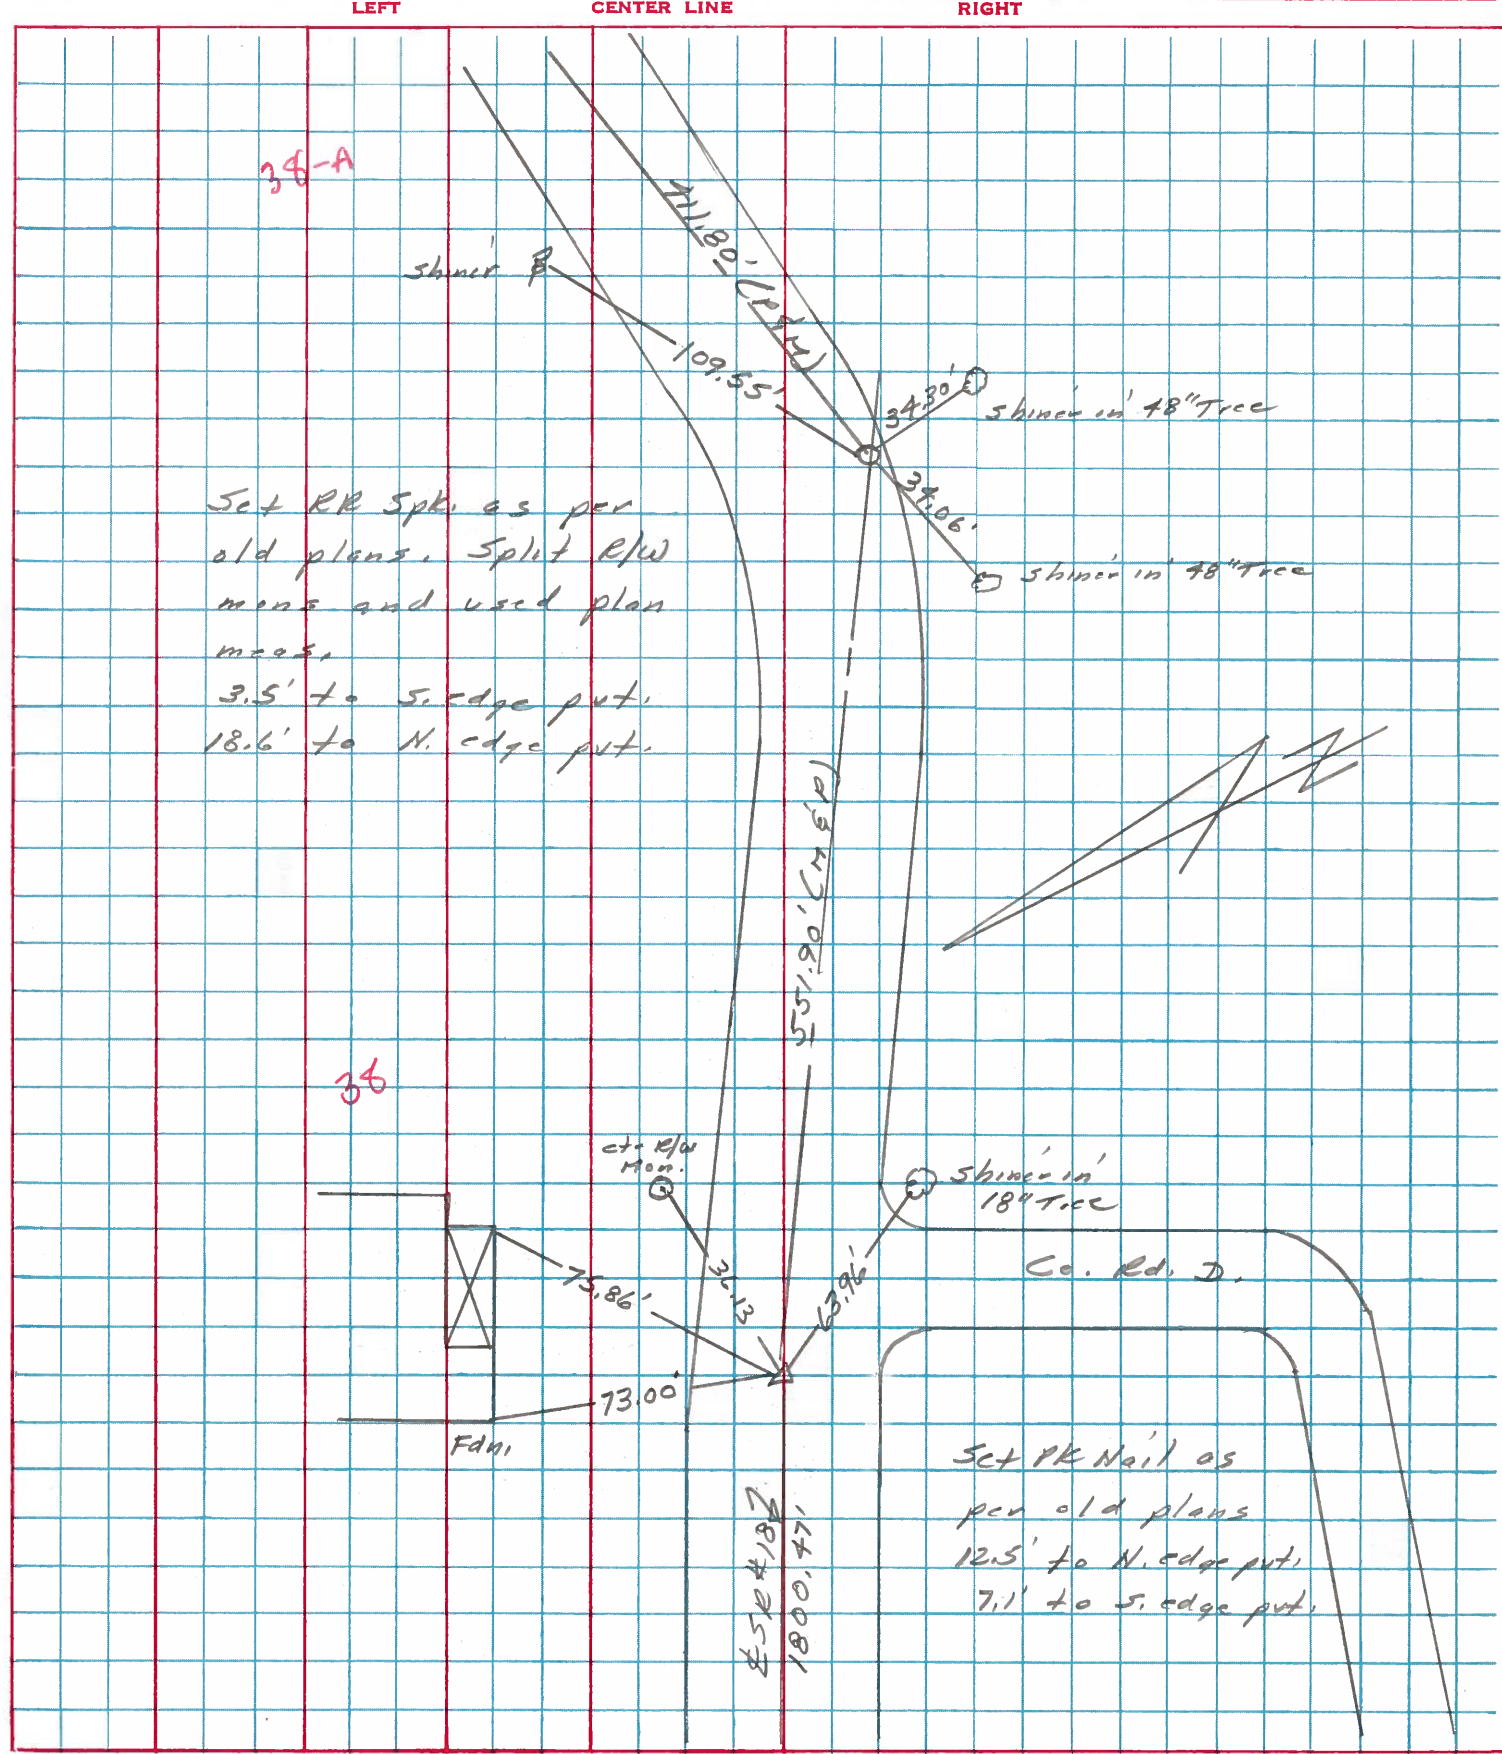

PERSONNEL TITLE PERSONNEL TITLE

Stone
 Michalak
 Deane
 Curtis

COUNTY Henry DATE 8 May 79

S. R. #18 WEATHER Cool

SEC. Bartlow Twp TEMP. 57°

DESCRIPTION

Alignment

JOB NO. 02999(10)

LEFT

CENTER LINE

RIGHT

