



O.D.O.T. DISTRICT 2 SURVEY OFFICE (USE ONLY)

PERSONNEL _____ REFERENCE NO. 40 A SHEET 4 OF 16
 NOTES RHOADES DATE 4/14/14 ROUTE SR 18
 H.C. ROUSOS WEATHER CLOUDY COUNTY HENRY
 R.C. RHOADES TEMP. 58° TOWNSHIP BARTLOW
 _____ SECTION 23
 _____ T 3 N R 8 E

TYPE MONUMENT PK/WASHER
 ON SURFACE - ~~BELOW~~ ON _____
 LEFT - ☉ PAV'T - ~~RIGHT~~ 0.5'
9.7' TO LT EDGE PAVEMENT
 S.L.M. 982+23.53

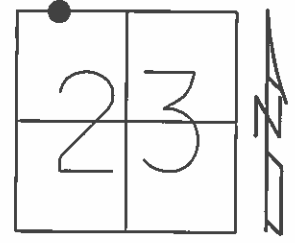

Grid: Northing: 565914.632 Easting: 1580823.638

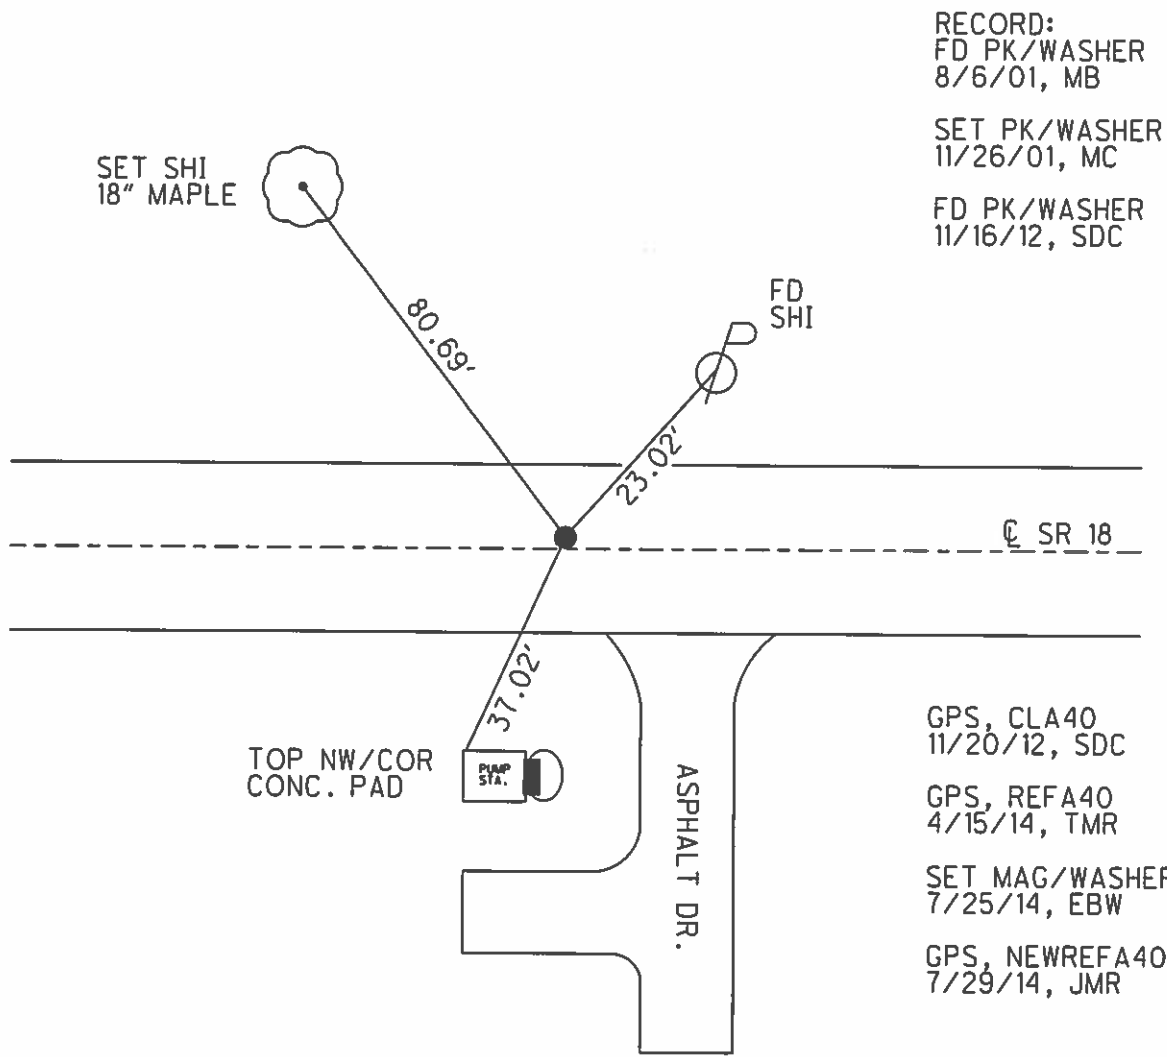

- RECORD:
FD PK/WASHER
8/6/01, MB
- SET PK/WASHER
11/26/01, MC
- FD PK/WASHER
11/16/12, SDC
- GPS, CLA40
11/20/12, SDC
- GPS, REFA40
4/15/14, TMR
- SET MAG/WASHER
7/25/14, EBW
- GPS, NEWREFA40
7/29/14, JMR

O.D.O.T. DISTRICT 2 SURVEY OFFICE

PERSONNEL _____

REFERENCE NO. 40-A

SHEET 2 OF 14

NOTES CANTERBURY

H.C. BARNHISEL

R.C. MOSEK

DATE 8/6/01

WEATHER SUN

TEMP. +93°

ROUTE 18

COUNTY HENRY

TOWNSHIP BARTLOW

SECTION 23

T.3 N. R. 8 E


TYPE MONUMENT P.K. + WASHER

ON SURFACE - ~~BELOW~~ SURFACE


LEFT - ~~PAV'T.~~ RIGHT 0.5' LT &

9.7' TO LT EDGE PAVEMENT

S.L.M. 982+22

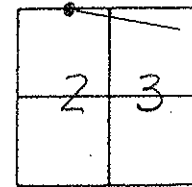

RESET PK/WASHER
 11-26-01
 M.R.C.

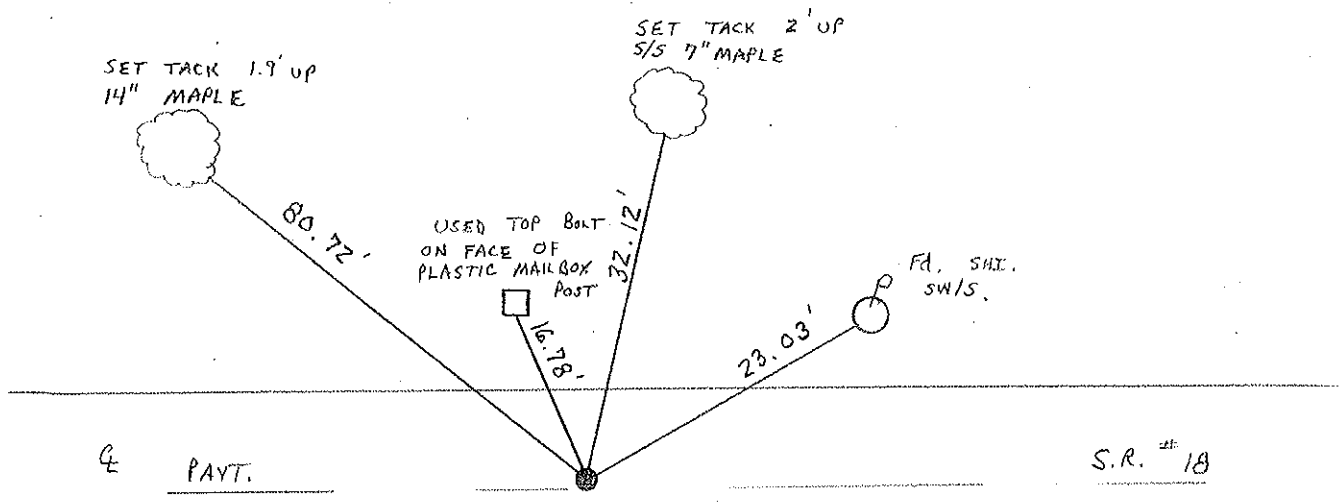

O.D.O.T. DISTRICT 2 SURVEY OFFICE

PERSONNEL

REFERENCE NO. 40-A

SHEET OF

NOTES BARNHISEL

H.C. " "

R.C. HOFFMAN

DATE 10-19-90

WEATHER cloudy

TEMP. +43°

ROUTE 18

COUNTY HENRY

TOWNSHIP BAETZOW

SECTION 23

T 3 N R 8 E


TYPE MONUMENT P.K. & Washer

ON SURFACE - ~~BELOW~~ yes


LEFT- & PAV'T. - ~~RIGHT~~ 0.8

9.5 TO LT EDGE PAVEMENT

S.L.M. 982+22

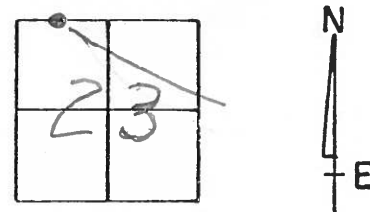

Set P.K. & Washer
11-13-90
MB

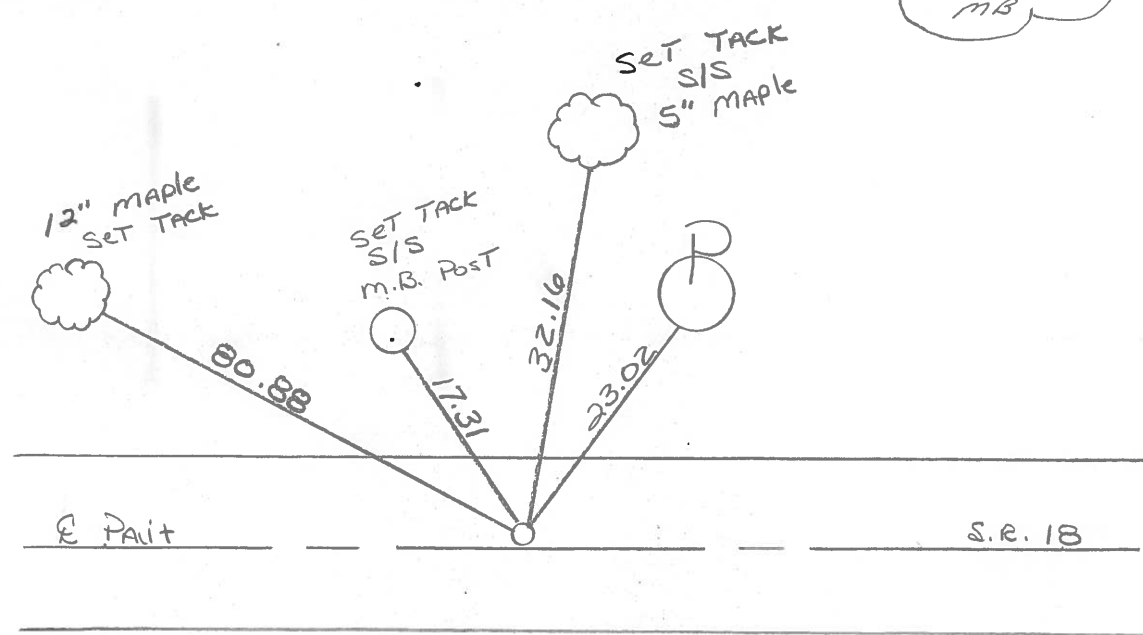

County HENRY S.R. 18

Date April 7, 83

Township BARTLOW

Weather OVERCAST

Section 23

Temp. +40°

T3N, R8E


Personnel HOFFMAN

LOHRKE

HOUSEHOLDER

BARWISSEL

#40-A

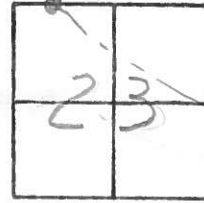

Fd R.R. SPK @ SURFACE

SLM 982+24


on & PAUT

9.4 TO N.E.P.

10.2 TO S.E.P.


SET P.K./WASHER

9-20-83 C.L.

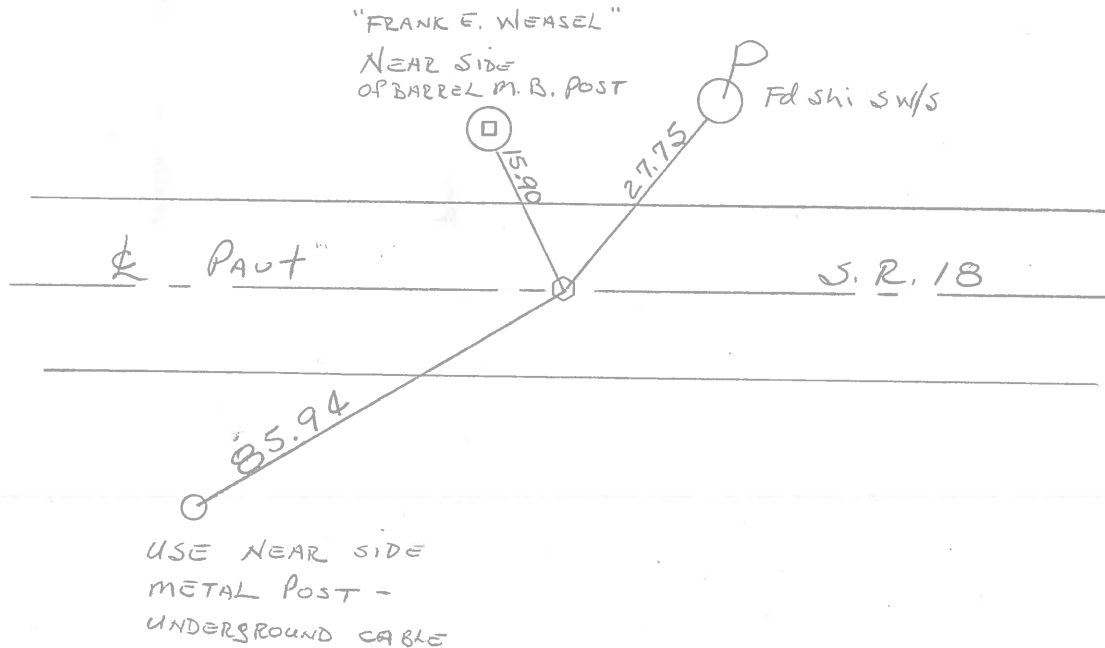

PERSONNEL	TITLE	PERSONNEL	TITLE	COUNTY	<u>Henry</u>	DATE	<u>8 Oct. 74</u>
<u>Stone</u>				S. R.	<u>#18</u>	WEATHER	<u>Cool</u>
<u>Dennis</u>				SEC.	<u>Barlow Twp.</u>	TEMP.	<u>50°</u>
<u>Curtis</u>							
<u>Michalak</u>							

DESCRIPTION Refs. to Central Points JOB NO. _____

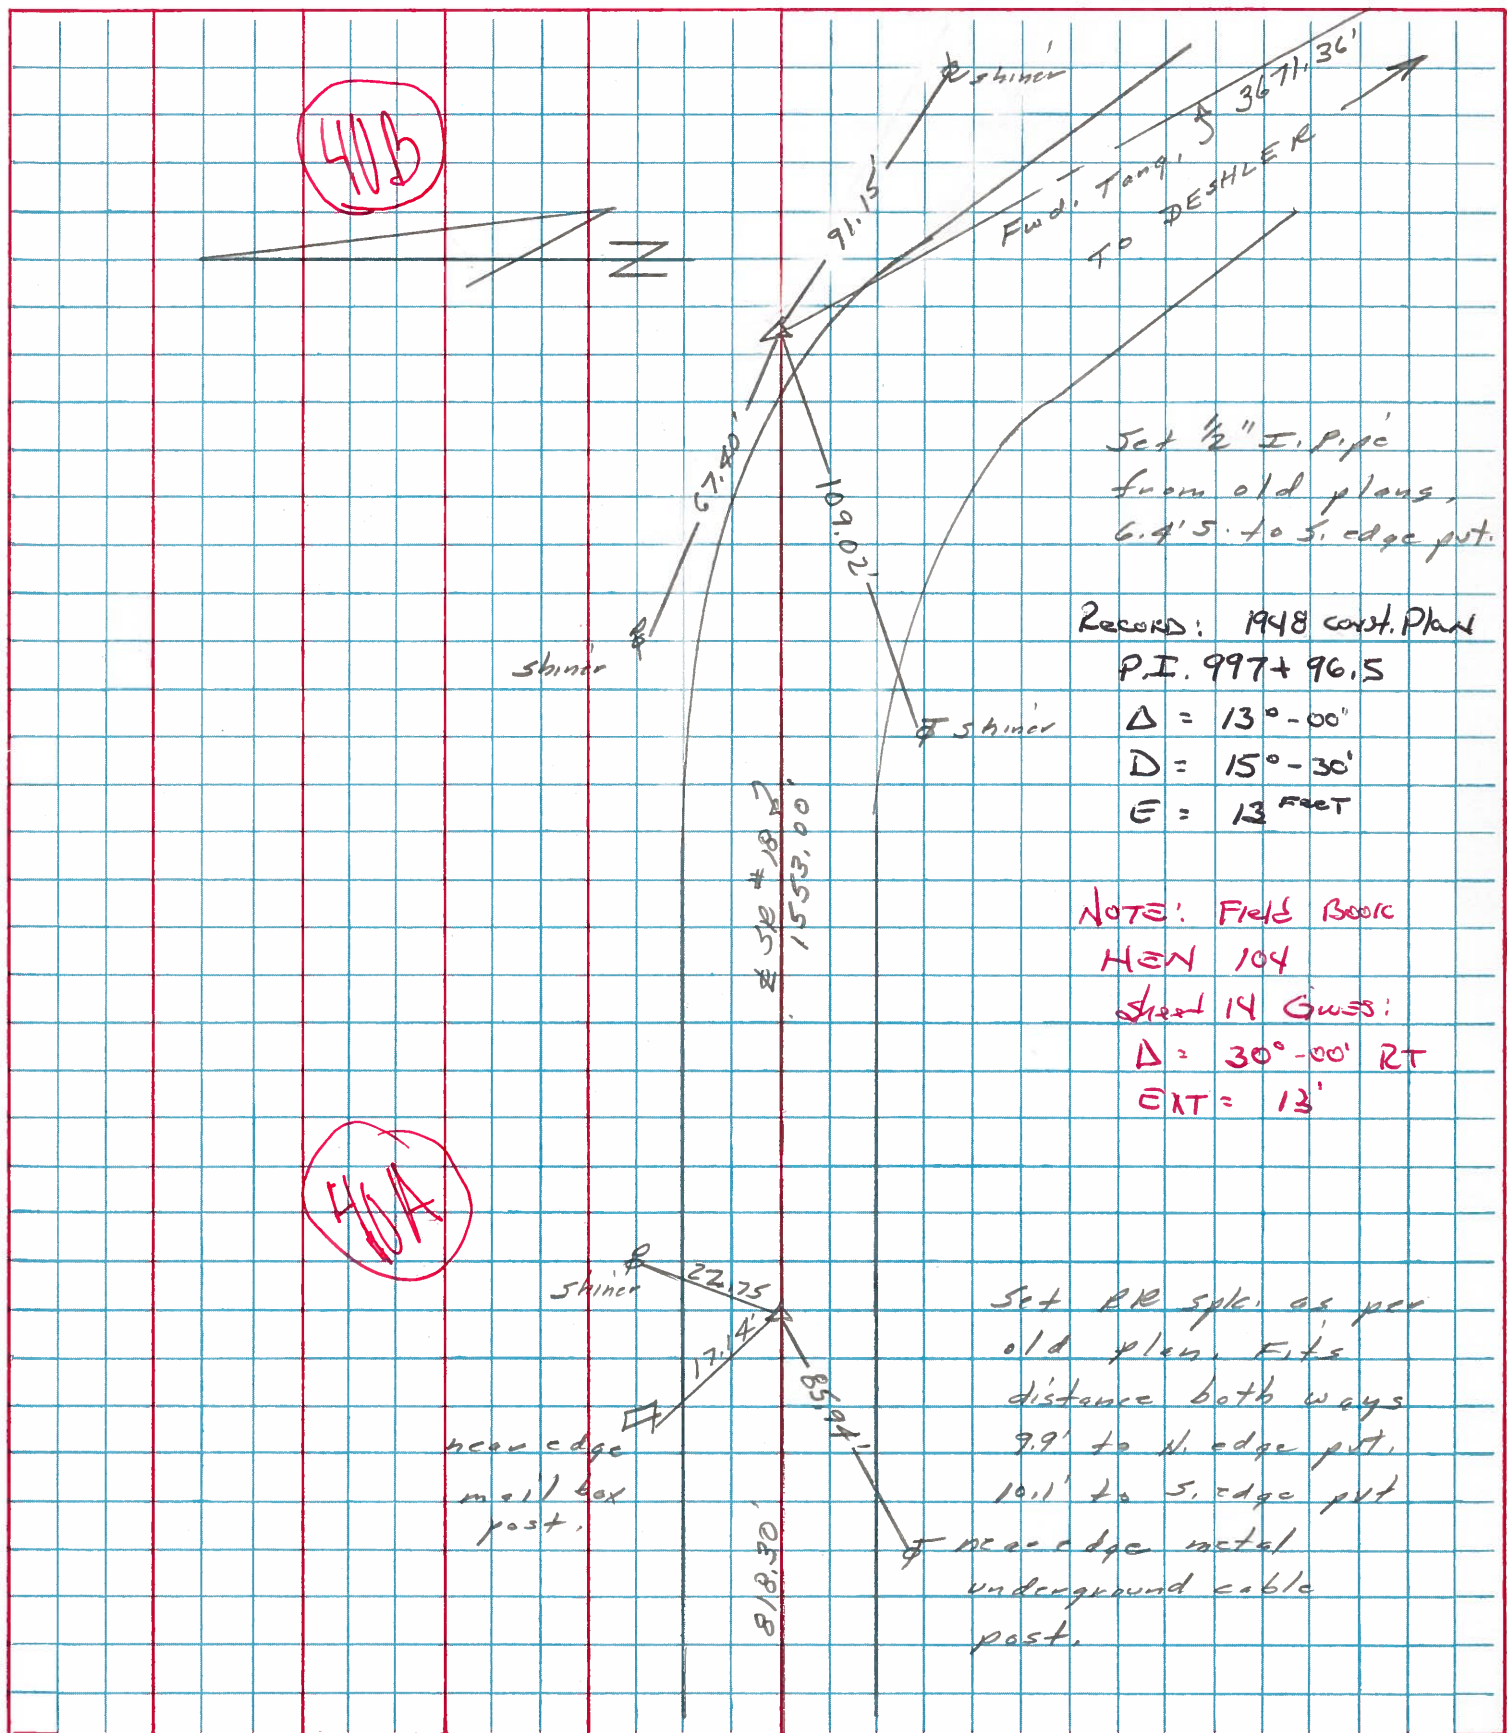

Set 1/2" I. pipe from old plans, 6.4' S. to S. edge pt.

Records: 1948 const. Plan
P.I. 997+96.5
Δ = 13°-00"
D = 15°-30"
E = 13 Feet


NOTE: Field Book
MEN 104
Start 14 Guess:
Δ = 30°-00' RT
EXT = 13'

Set RR spl. as per old plans. Fits distance both ways 9.9' to N. edge pt, 10.1' to S. edge pt

near edge metal underground cable post.

PERSONNEL TITLE PERSONNEL TITLE COUNTY Henry DATE 3 Sept. 74
 Stone _____
 Michelak _____ S. R. #18 WEATHER Cloudy
 Denna _____
 Curtis _____ SEC. Berlow Twp. TEMP. 56°

DESCRIPTION Alignment CENTER LINE RIGHT JOB NO.

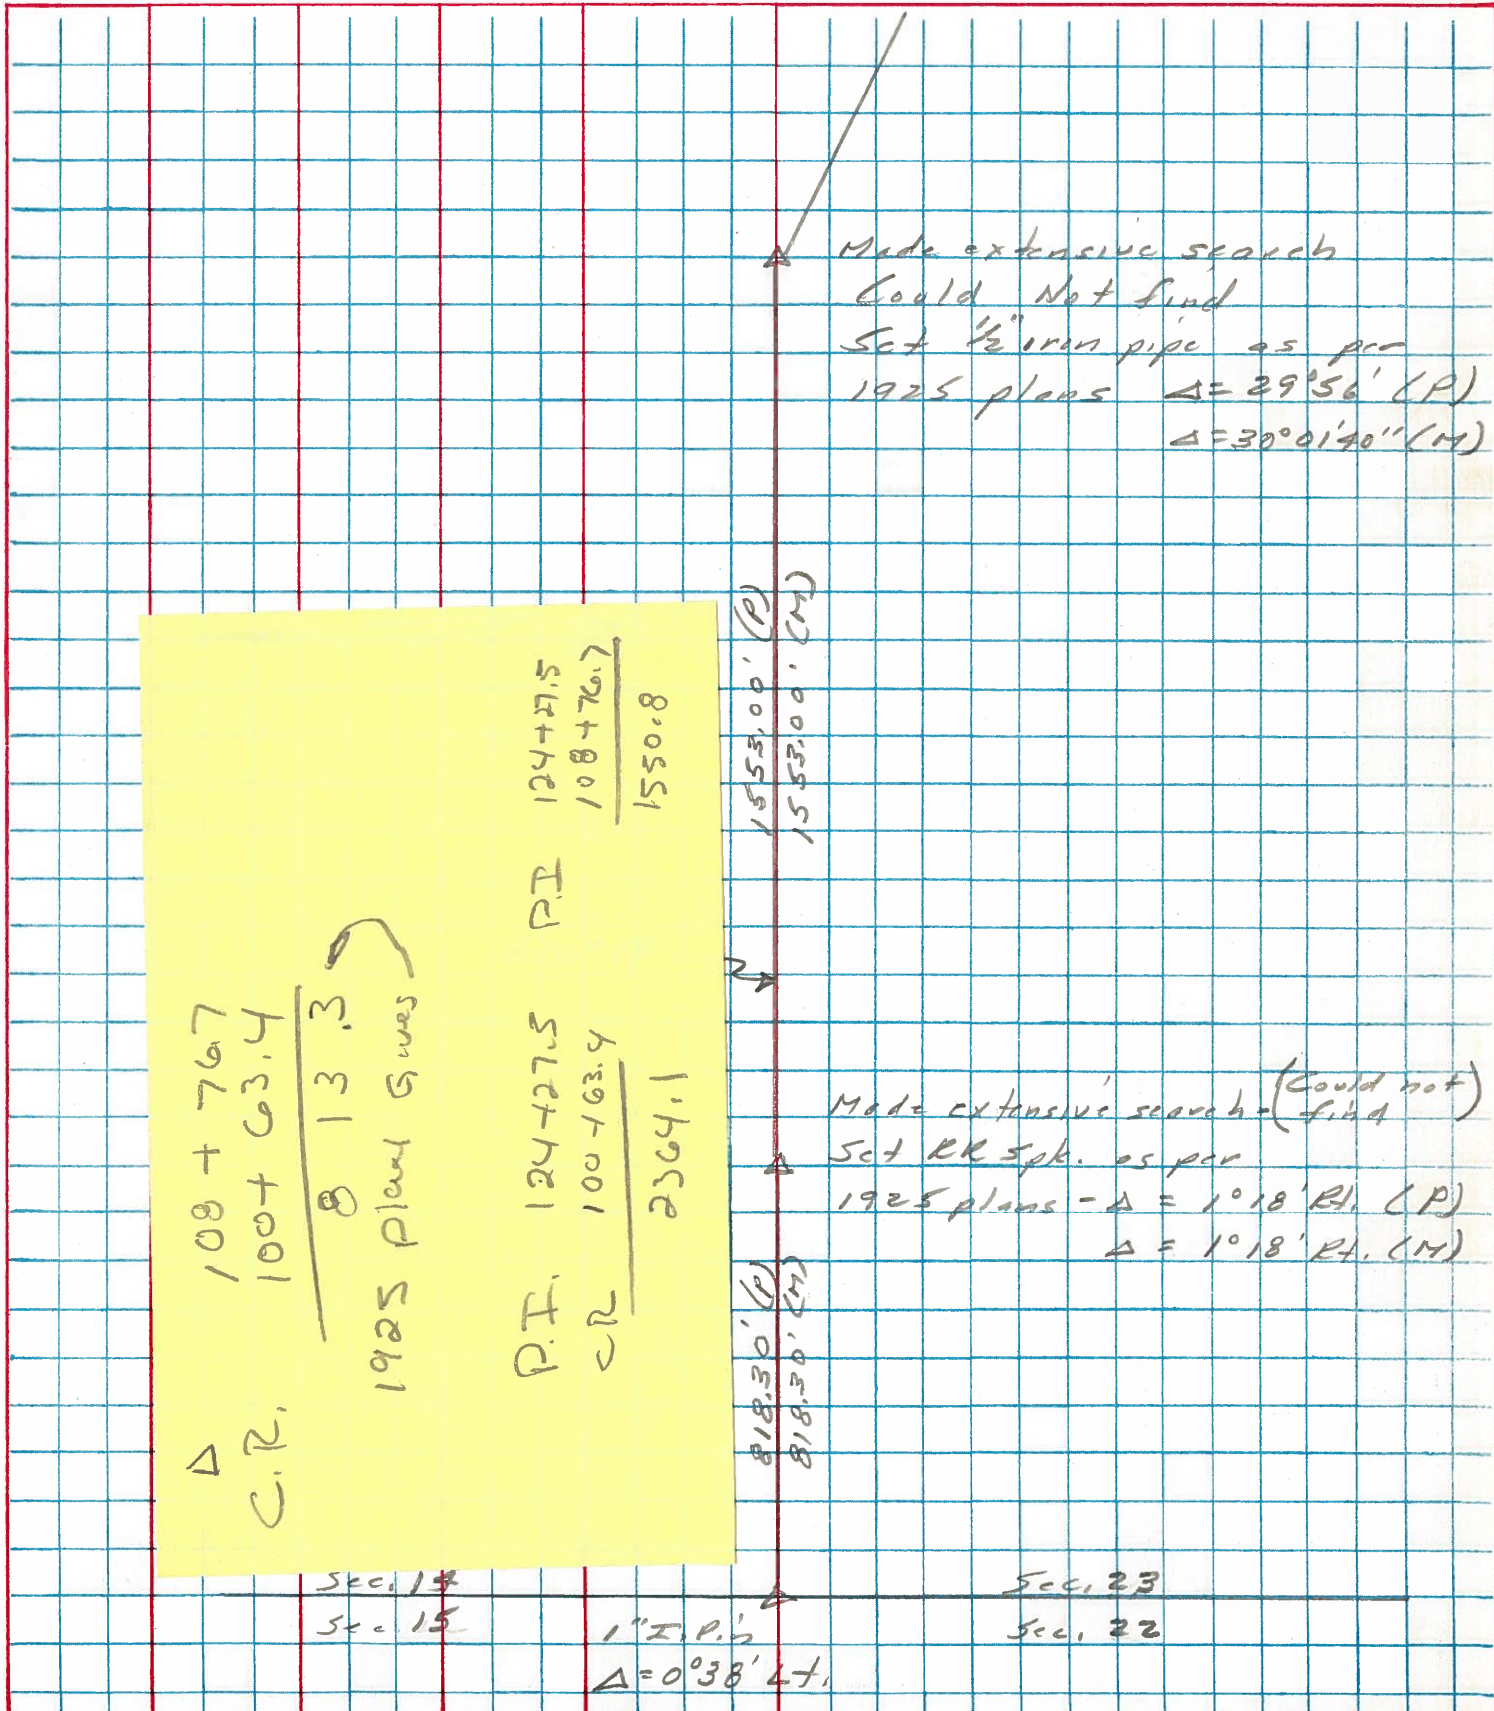

Δ 108 + 767
 C.R. 100 + 63.4
 8 13.3
 1925 Plans Gives
 P.I. 124 + 27.5 P.I.
 C.R. 100 + 63.4
 2364.1

1553.00' (P)
 1553.00' (M)

→

818.30' (P)
 818.30' (M)

Sec. 14
 Sec. 15

1" I.P. Δ = 0°38' Lt.

Sec. 23
 Sec. 22