


O.D.O.T. DISTRICT 2 SURVEY OFFICE (USE ONLY)


PERSONNEL \_\_\_\_\_ REFERENCE NO. 40 B SHEET 5 OF 16

NOTES RHOADES DATE 4/14/14 ROUTE SR 18  
 H.C. ROUSOS WEATHER CLOUDY COUNTY HENRY  
 R.C. RHOADES TEMP. 58° TOWNSHIP BARTLOW  
 \_\_\_\_\_ SECTION 23  
 \_\_\_\_\_ T 3 N R 8 E

TYPE MONUMENT 1/2" IPIPE  
~~ON SURFACE~~ - BELOW 4"  
 LEFT - ☉ PAV'T - ~~RIGHT~~ 19.0'  
8' LT TO LT EDGE PAVEMENT  
 S.L.M. 997+77.01  
 Grid: Northing: 565895.386 Easting: 1580204.019

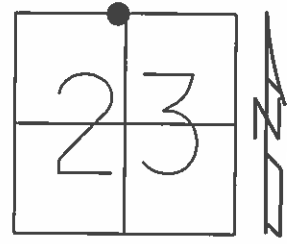

RECORD:  
 FD 1/2" IPIPE  
 8/6/01, MB  
 FD 1/2" IPIPE  
 11/16/12, SDC  
 GPS, CLB40  
 11/20/12, SDC  
 GPS, REFB40  
 4/15/14, TMR

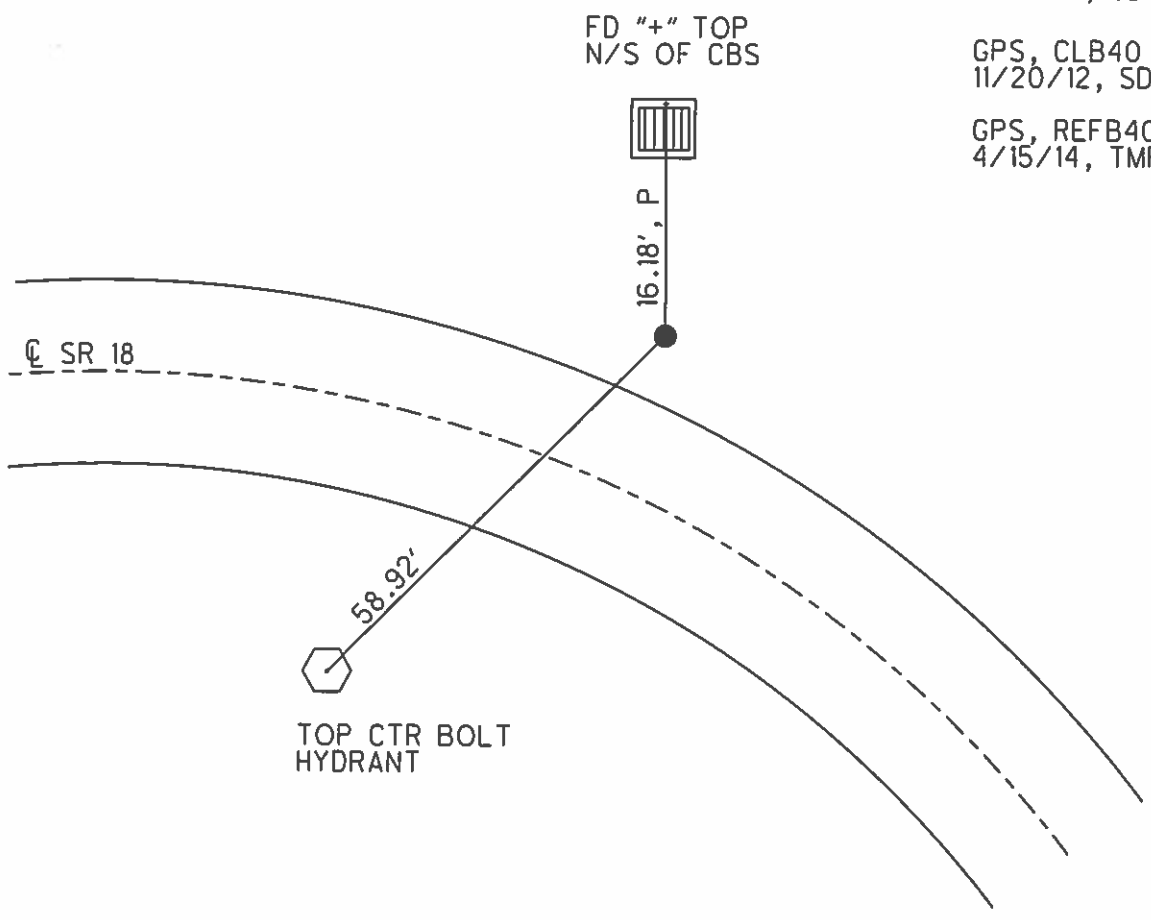

# O.D.O.T. DISTRICT 2 SURVEY OFFICE

PERSONNEL \_\_\_\_\_

REFERENCE NO. 40-8

SHEET 3 OF 14

NOTES CANTERBURY

H.C. BARNHISEL

R.C. MOSEK

DATE 8/6/01

WEATHER SUN

TEMP. +93°

ROUTE 18

COUNTY HENRY

TOWNSHIP BARTLOW

SECTION 23

T 3 N R 8 E


TYPE MONUMENT 1/2" IRON PIPE

ON SURFACE - BELOW 2" DOWN


LEFT - ~~☉~~ PAV'T. - RIGHT 19.0' LT ☉

8.0' LT. ☉ OF LT. EDGE PAVEMENT

S.L.M. 997 + 73

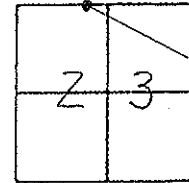

RESET PK/WASHER  
 11-26-01  
 M.R.C.

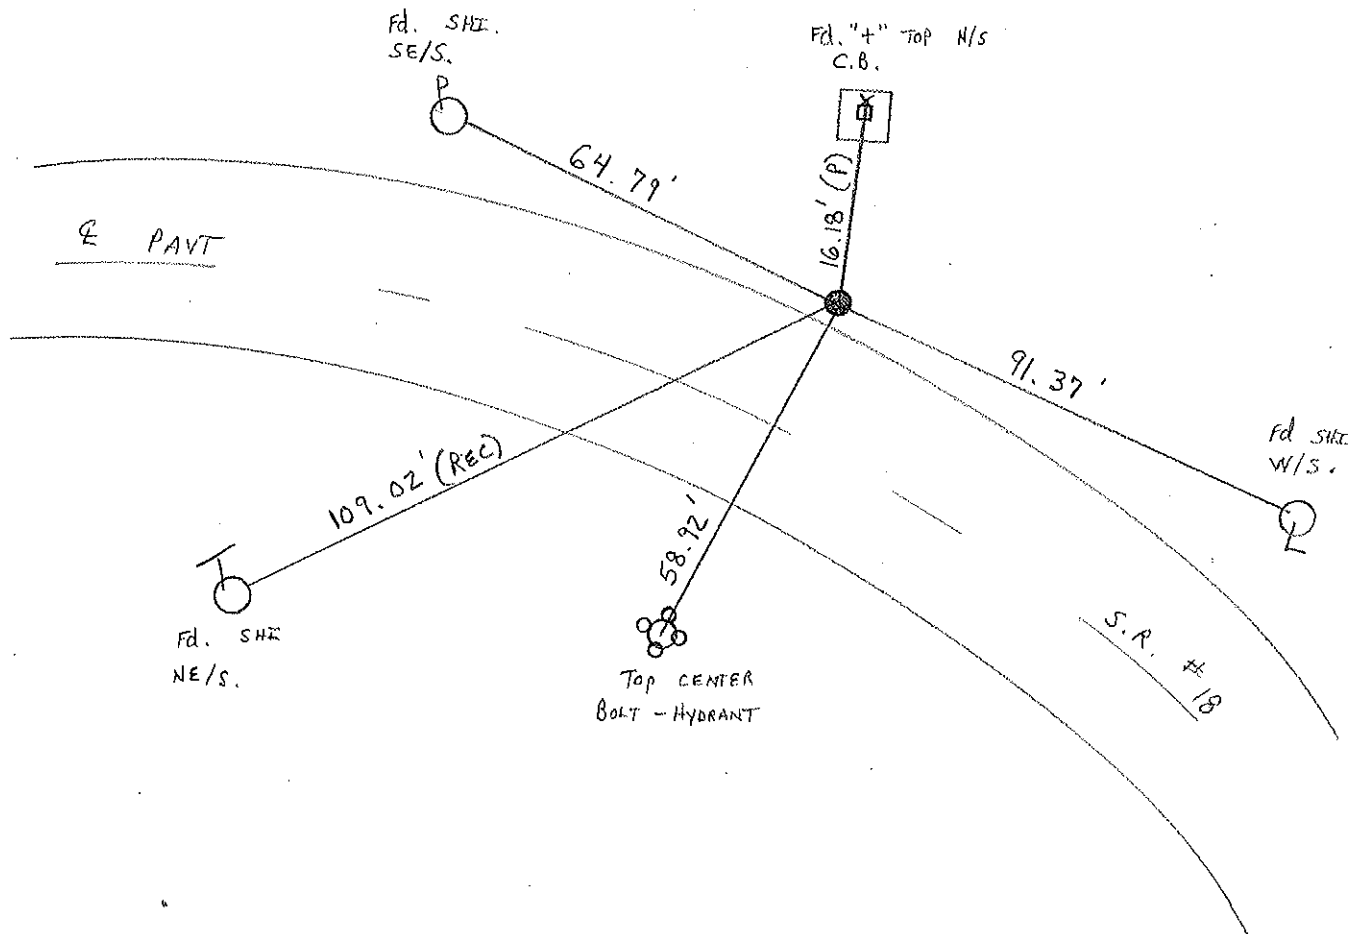

# O.D.O.T. DISTRICT 2 SURVEY OFFICE

PERSONNEL \_\_\_\_\_

REFERENCE NO. 40-B

SHEET \_\_\_\_\_ OF \_\_\_\_\_

NOTES BAENHISEL

H.C. \_\_\_\_\_

DATE 10-19-90

ROUTE 18

R.C. HOFFMAN

WEATHER cloudy

COUNTY HENRY

\_\_\_\_\_

TEMP. +43°

TOWNSHIP BAETLOW

\_\_\_\_\_

SECTION 23

T 3 N R 8 E



TYPE MONUMENT 1/2" IRON PIPE

ON SURFACE - BELOW 2"

LEFT - & PAV'T. - RIGHT 18.7

8.1 <sup>LT. OF</sup> TO LT EDGE PAVEMENT

S.L.M. 997+73

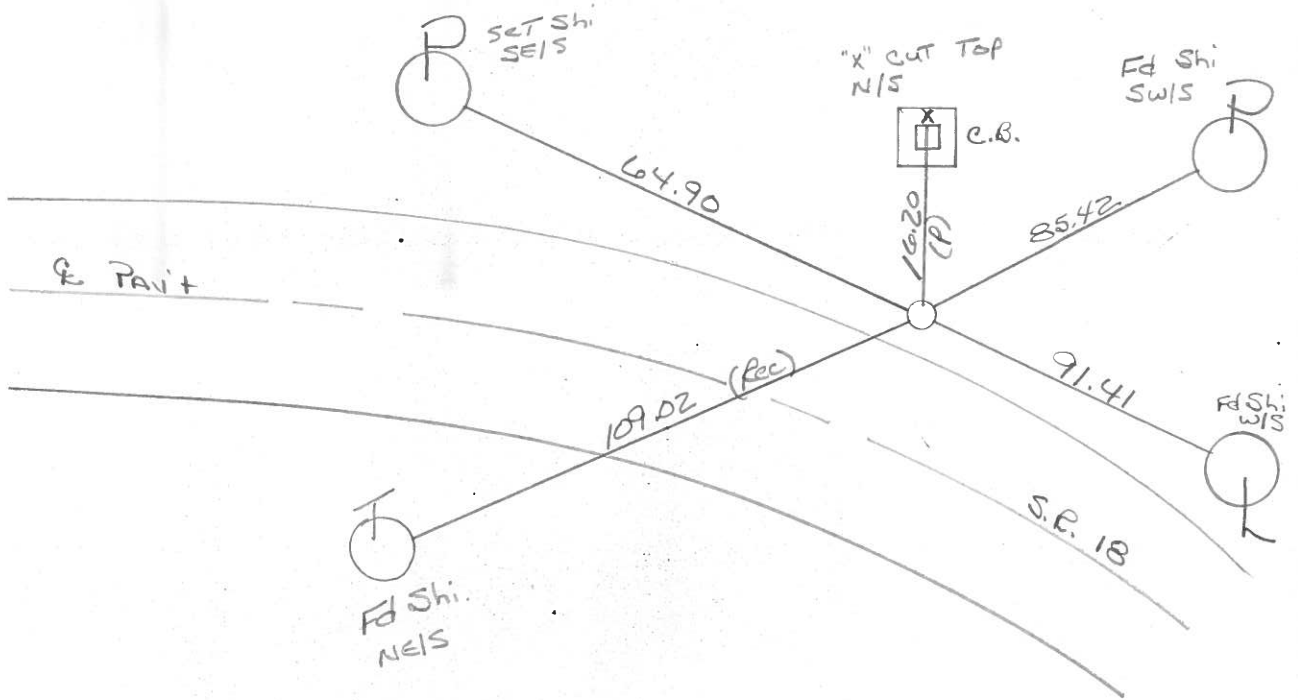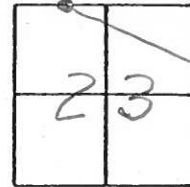

County HENRY S.R. 18

Date April 7, 83

Township BARTLOW

Weather OVERCAST

Section 23 (IN DESHLER)

Temp. +40°

T3N, R8E


Personnel HOFFMAN

LOEHRKE

HOUSEHOLDER


BARNHISEL

#40-B

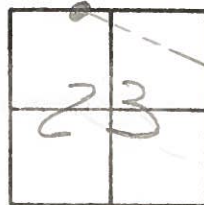

Fd 1/2" IRON PIPE 1" Below surface  
 18.7' Lt of & Pant  
 6.6' N. of N.E.R

SLM 997+75

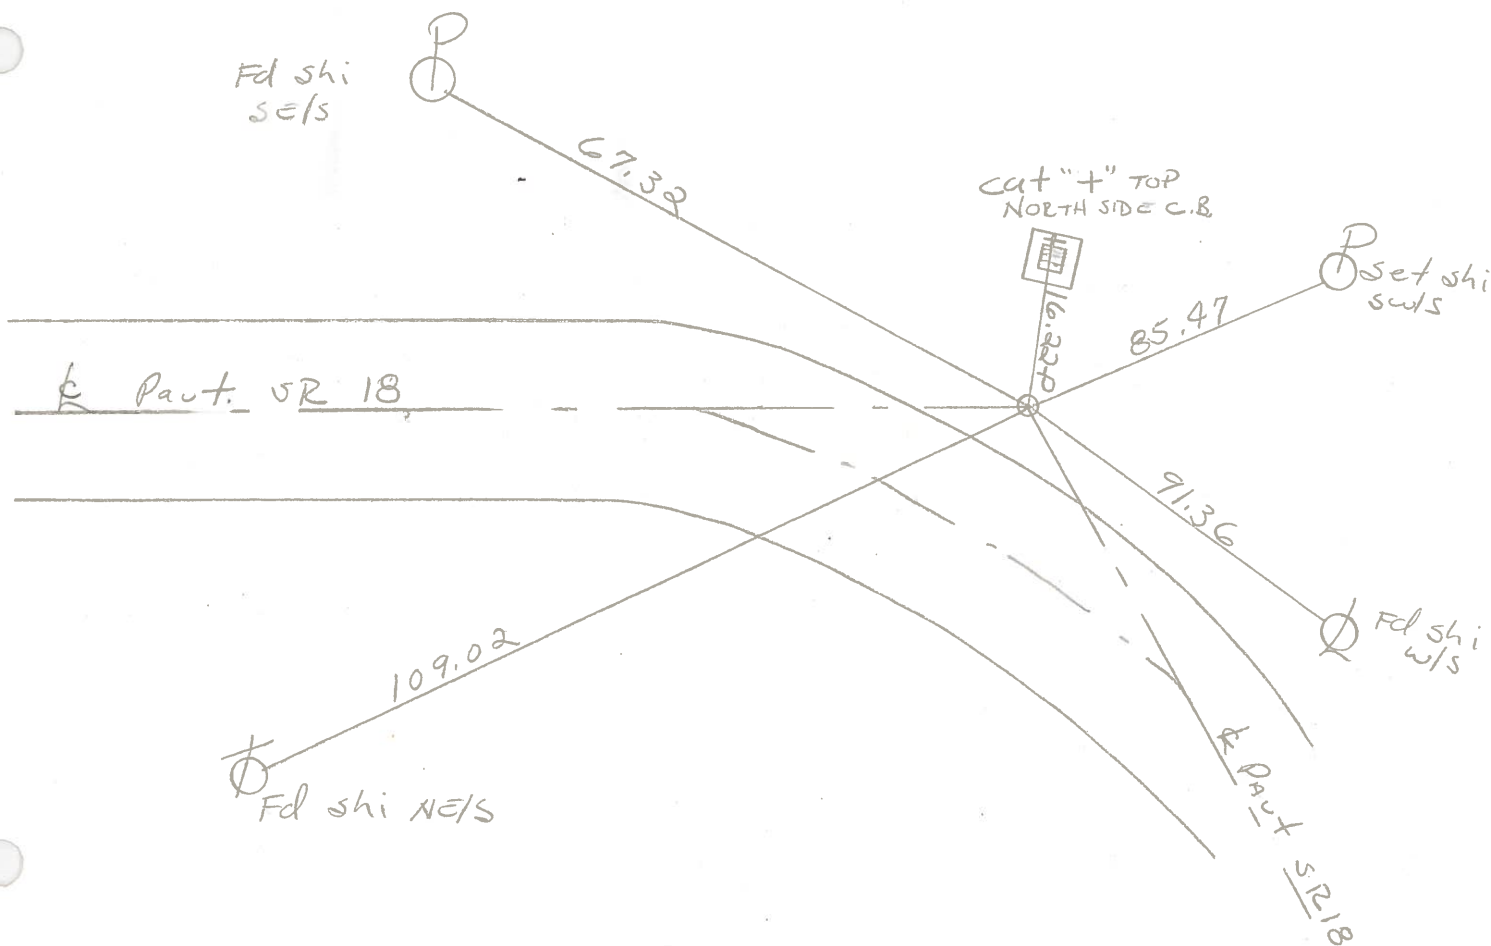

PERSONNEL TITLE PERSONNEL TITLE

Stone

COUNTY Henry

DATE 8 Oct. 74

Dennis

S. R. #18

WEATHER Cool

Curtis

SEC. Bartlow Twp.


TEMP. 50°

Michalak

DESCRIPTION

Refs. to Central Points

JOB NO.

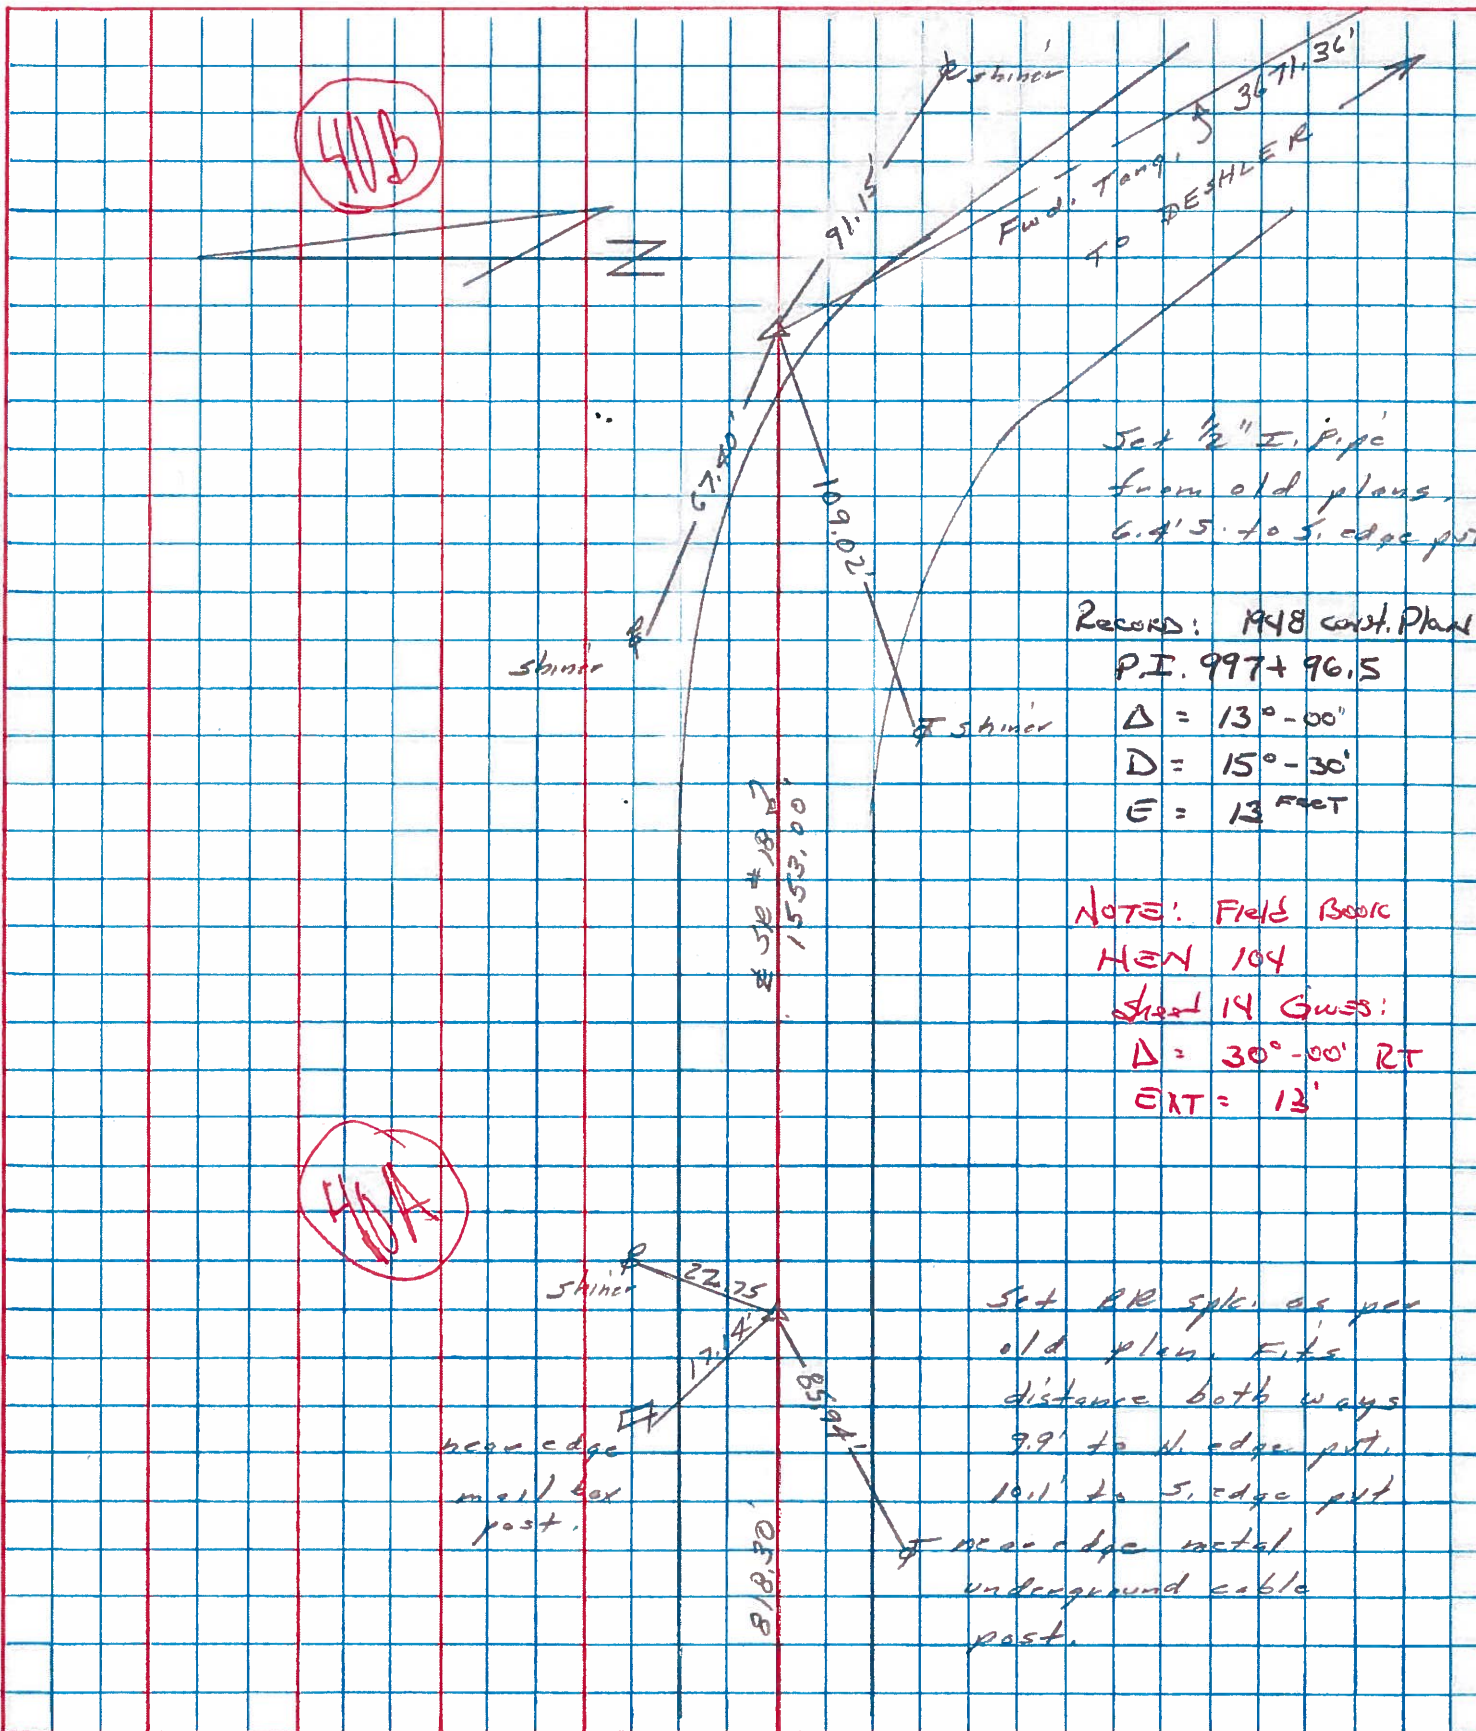

Set 1/2" I. Pipe from old plans, 6.4' 5" to S. edge put

Records: 1948 const. Plan  
 P.I. 997+96.5  
 $\Delta = 13^\circ - 00'$   
 $D = 15^\circ - 30'$   
 $E = 13$  FEET

NOTE: Field Book  
 MEN 104  
 Street 14 Guess:  
 $\Delta = 30^\circ - 00'$  RT  
 $EXT = 13'$

Set RR spike as per old plan. Fits distance both ways 9.9' to N. edge put, 10.1' to S. edge put  
 near edge metal underground cable post.

PERSONNEL	TITLE	PERSONNEL	TITLE	COUNTY	DATE
Stone				Henry	3 Sept. 74
Michalak				S. R. #18	WEATHER Cloudy
Dennis				SEC. Barlow Twp.	TEMP. 56°
Curtis					

DESCRIPTION Alignment LEFT CENTER LINE RIGHT JOB NO.

