

O.D.O.T. DISTRICT 2 SURVEY OFFICE (USE ONLY)

PERSONNEL \_\_\_\_\_ REFERENCE NO. 41 B SHEET 8 OF 16

NOTES RHOADES DATE 11/20/12 ROUTE SR 18  
 H.C. CODER WEATHER CLEAR COUNTY HENRY  
 R.C. RHOADES TEMP. 46° TOWNSHIP BARTLOW  
 \_\_\_\_\_ SECTION 24  
 \_\_\_\_\_ T 3 N R 8 E



TYPE MONUMENT CROSS CUT MH RIM

ON SURFACE - ~~BELOW~~ ON \_\_\_\_\_

LEFT - ☉ PAV'T - ~~RIGHT~~ 1.0', ☉ NORTH  
 - TO - EDGE PAVEMENT

S.L.M. 1034+48.10

Grid: Northing: 564018.037 Easting: 1583358.683

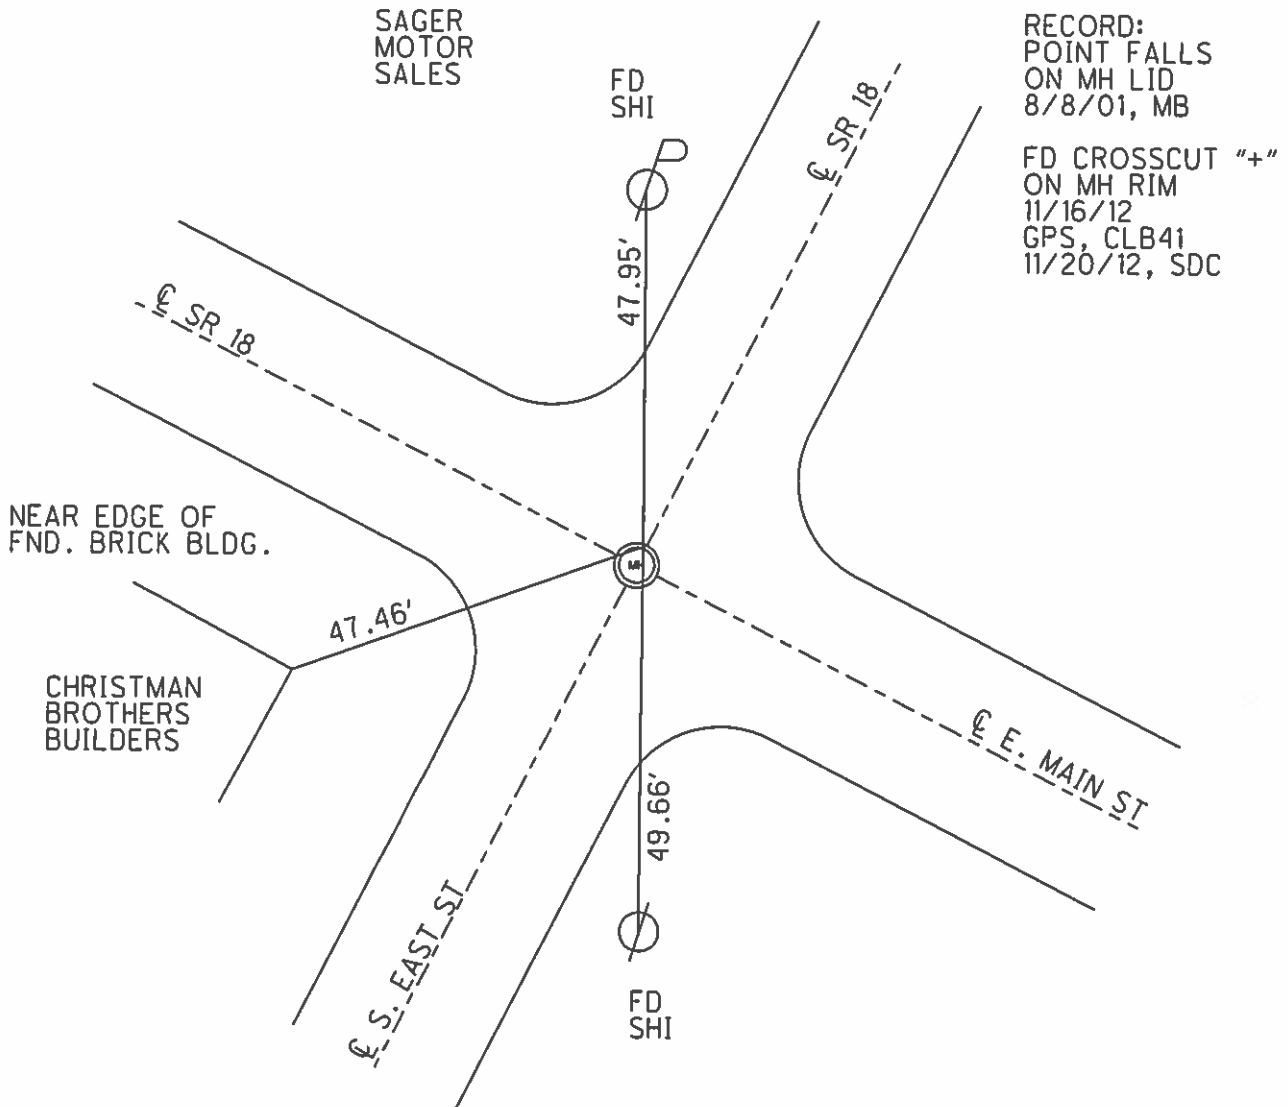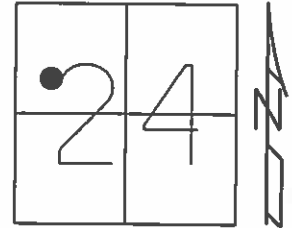

# O.D.O.T. DISTRICT 2 SURVEY OFFICE

PERSONNEL

REFERENCE NO. 41-B

SHEET 7 OF 14

NOTES CANTERBURY

H.C. BARNHISEL

R.C. MOSEK

DATE 8/8/01

WEATHER SUN

TEMP. + 85°

ROUTE 18



COUNTY HENRY

TOWNSHIP BARTLOW

SECTION 24

T 3 N R 8 E

TYPE MONUMENT POINT FALLS ON M.H. LID  
 ON SURFACE - BELOW SURFACE  
 LEFT - PAV'T. - RIGHT 1.0' LT. OF S.R. #18 N.  
— TO — EDGE PAVEMENT 1.0' RT. OF S.R. #18 W.  
 S.L.M. 1034 + 42

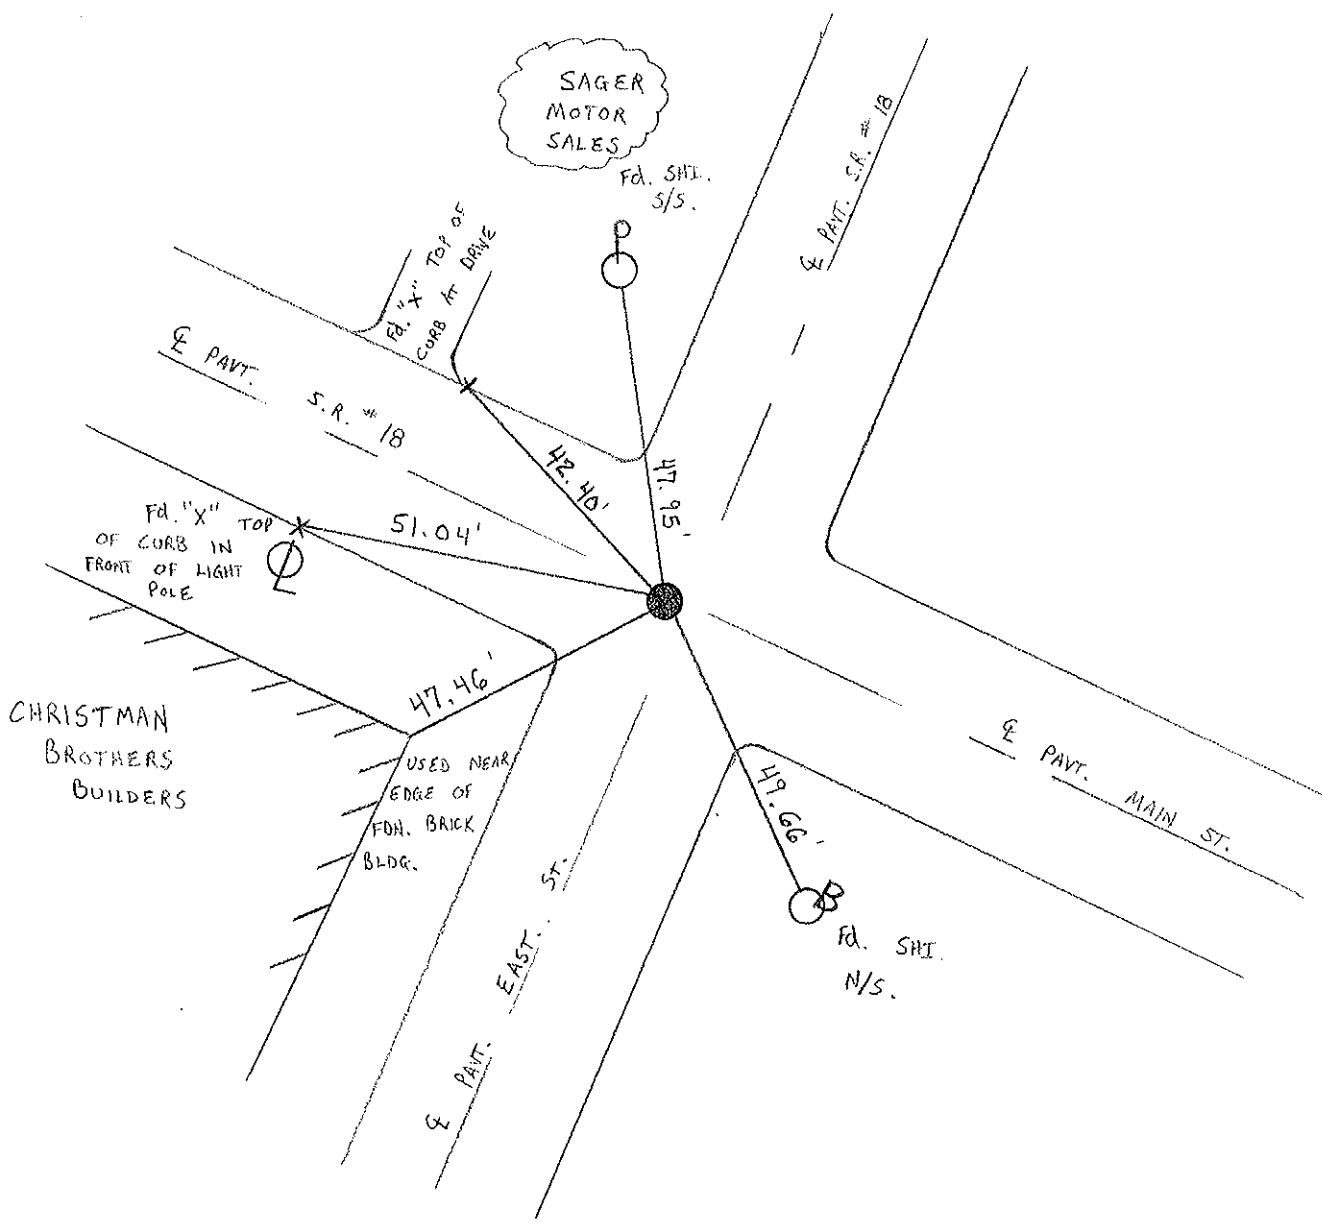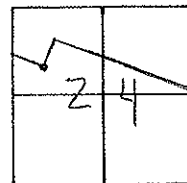

# O.D.O.T. DISTRICT 2 SURVEY OFFICE

PERSONNEL

REFERENCE NO. 41-B

SHEET      OF     

NOTES BARNHISEL

H.C.     "    "

R.C. HOFFMAN

DATE 10-19-90

WEATHER Cloudy

TEMP. +43°

ROUTE 18

COUNTY HENRY

TOWNSHIP BARTLOW

SECTION 24

T3 N R B E



TYPE MONUMENT Fd "X" ON M.H. Lid

ON SURFACE - BELOW yes

LEFT - & PAV'T. - RIGHT yes

- TO - EDGE PAVEMENT

S.L.M. 1034+22

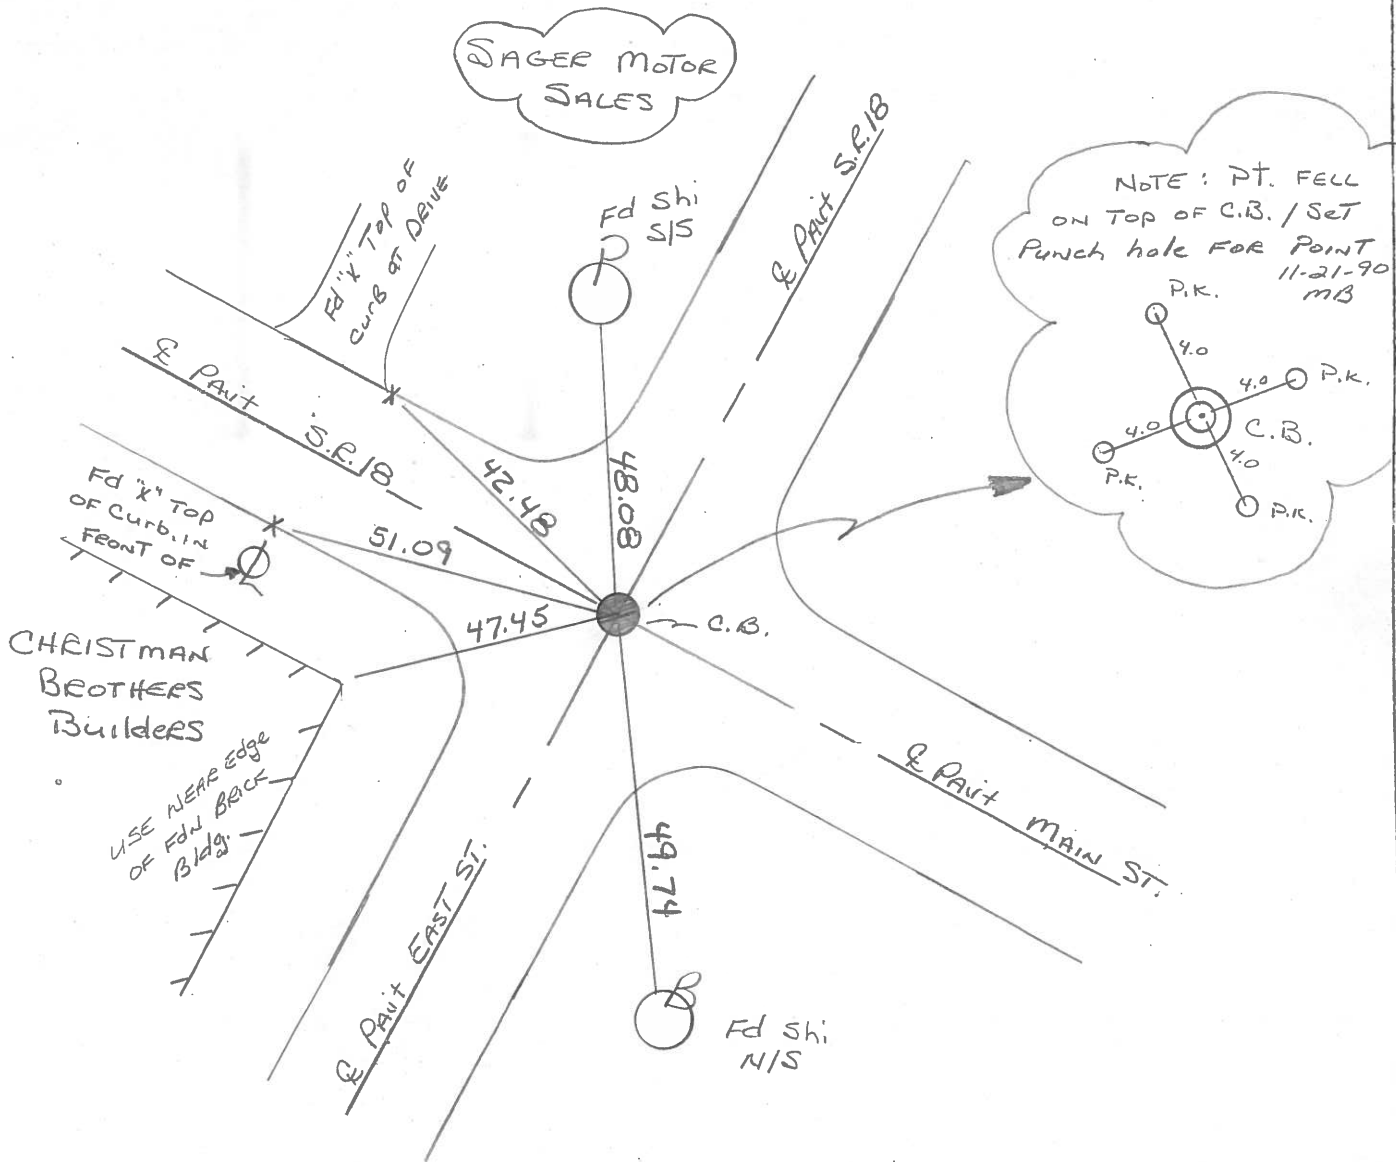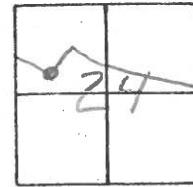

County HENRY S.R. 18

Date April 6, 83

Township BARTLOW

Weather OVERCAST

Section 24 (IN DESHLER)

Temp. +50°


T3N, R0E

Personnel Hoffman

HOUSEHOLDER

BARNHISEL

#41-B

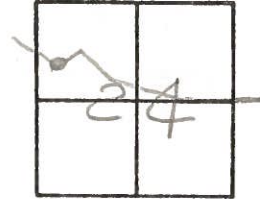


Fd "t" top m.h. DID NOT FIT TIES, LID APPARENTLY MOVED.

SLM 1034+42

USED TIES TO ESTABLISH POINT, THEN

Ref. this point

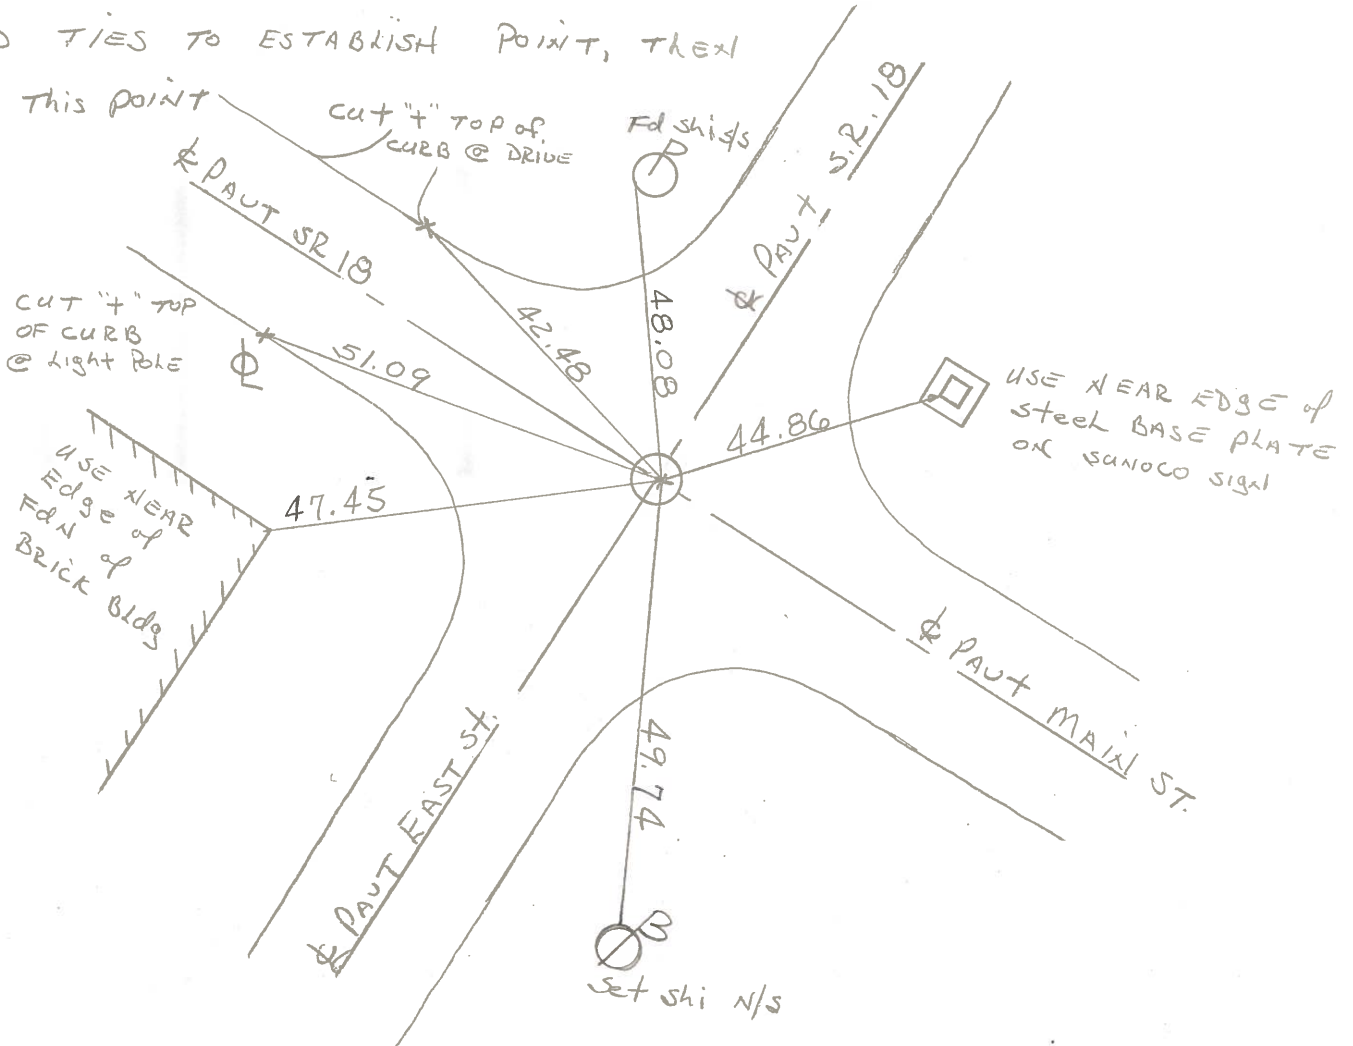


TIES CROSS M.H.

| PERSONNEL | TITLE | PERSONNEL | TITLE | COUNTY           | DATE         |
|-----------|-------|-----------|-------|------------------|--------------|
| Stone     |       |           |       | Henry            | 8 Oct. 74    |
| Denno     |       |           |       | S. R. #18        | WEATHER Cool |
| Curtis    |       |           |       | SEC. Bartlow Twp | TEMP. 50°    |
| Michalek  |       |           |       |                  |              |

DESCRIPTION References to Control Points JOB NO. \_\_\_\_\_

LEFT                      CENTER LINE                      RIGHT

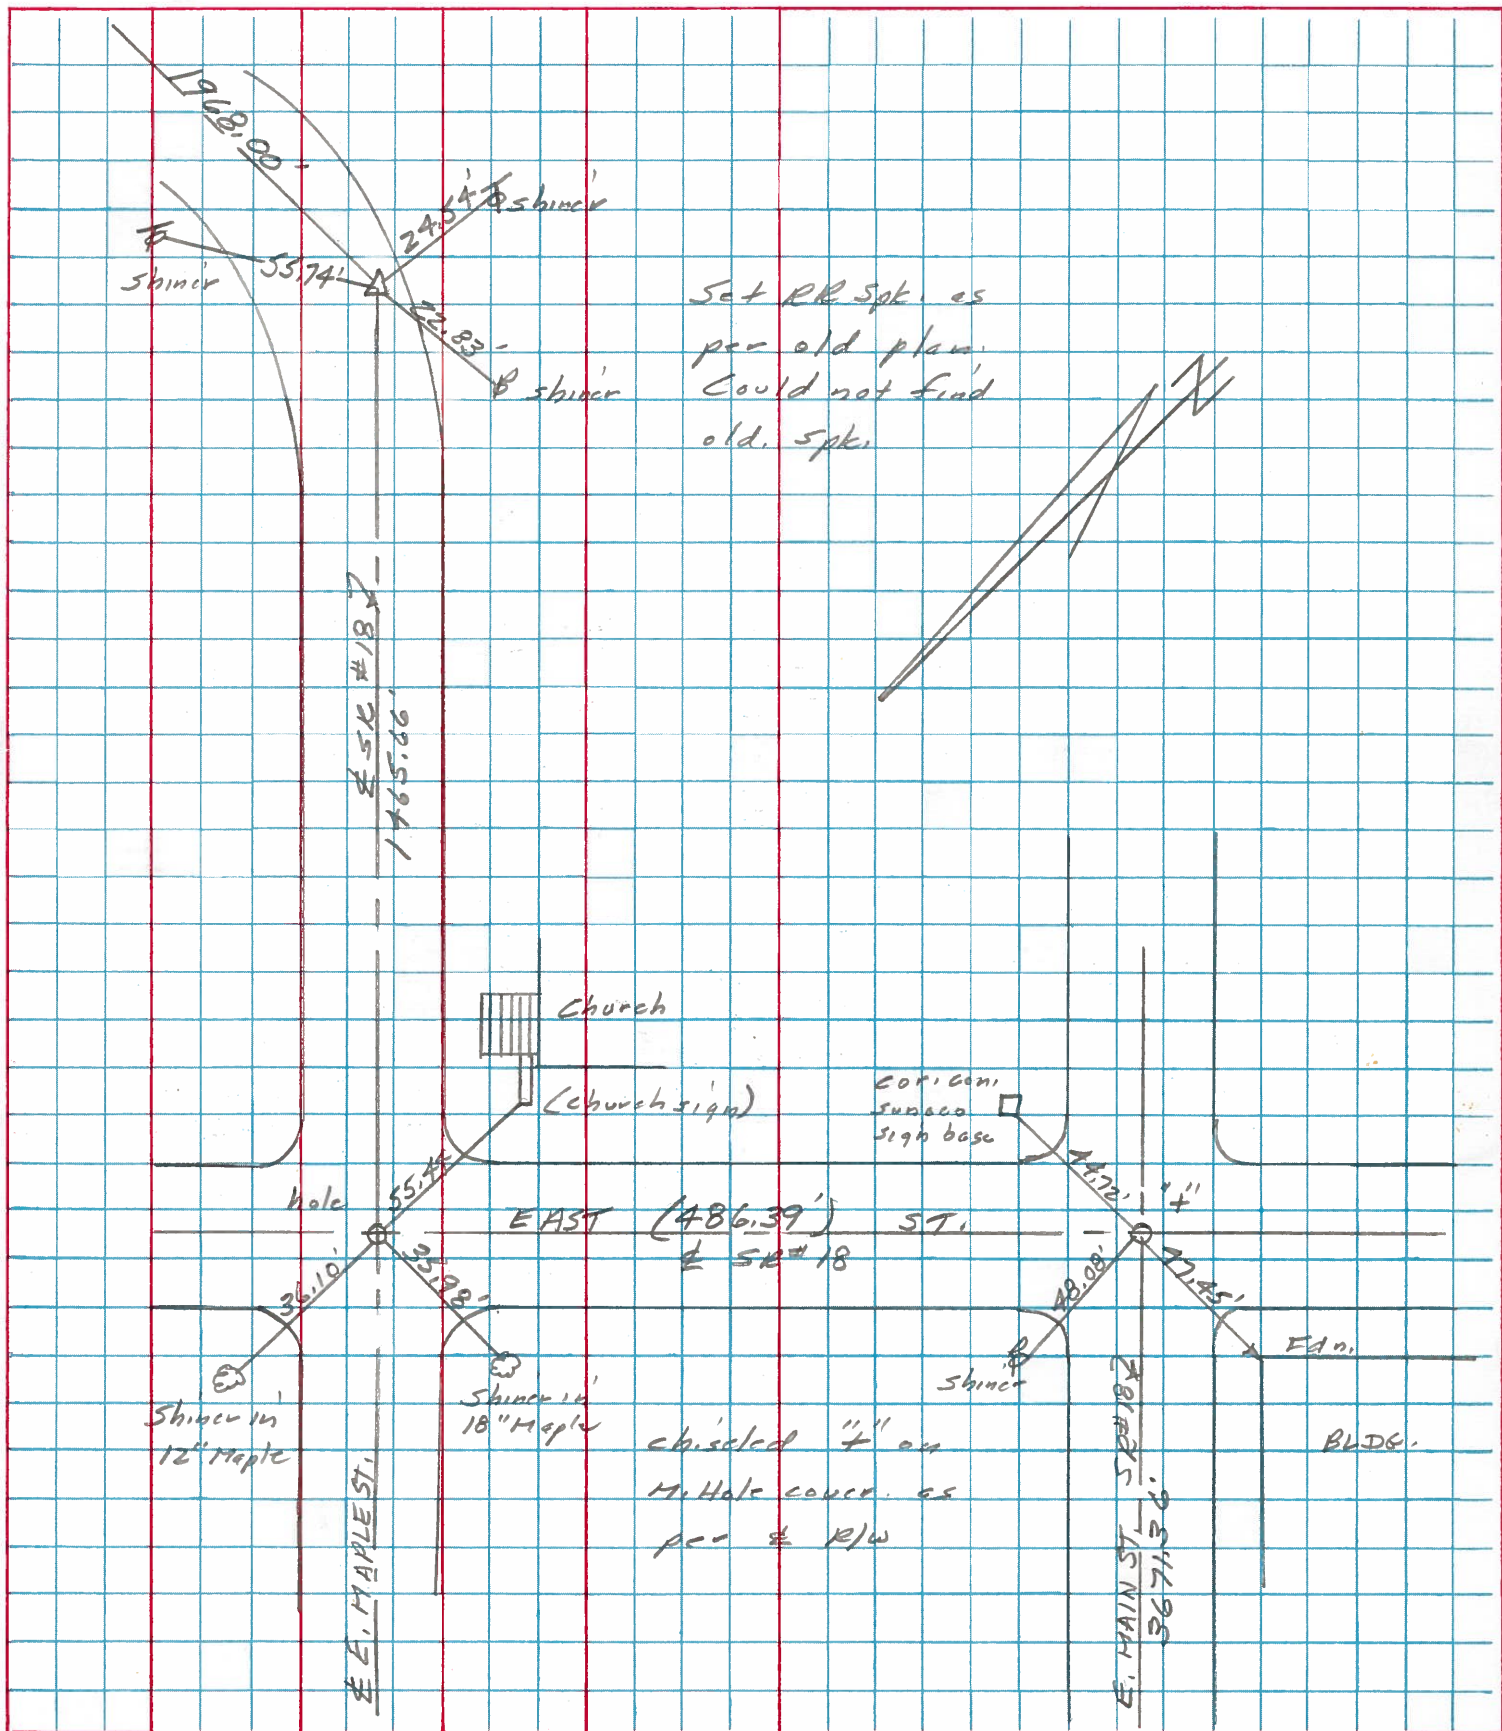

| PERSONNEL | TITLE | PERSONNEL | TITLE | COUNTY | DATE        | S. R. | WEATHER | SEC.    | TEMP. |
|-----------|-------|-----------|-------|--------|-------------|-------|---------|---------|-------|
| Stone     |       |           |       | Henry  | 18 Sept. 74 | #18   | Mild    | Deshler | 70°   |
| Michalak  |       |           |       |        |             |       |         |         |       |
| Denno     |       |           |       |        |             |       |         |         |       |
| Curtis    |       |           |       |        |             |       |         |         |       |

DESCRIPTION Alignment LEFT CENTER LINE RIGHT JOB NO. 02999(6)

