


O.D.O.T. DISTRICT 2 SURVEY OFFICE (USE ONLY)

PERSONNEL \_\_\_\_\_ REFERENCE NO. 42 SHEET 9 OF 16  
 NOTES RHOADES DATE 4/14/14 ROUTE SR 18  
 H.C. ROUSOS WEATHER CLOUDY COUNTY HENRY  
 R.C. RHOADES TEMP. 58° TOWNSHIP BARTLOW  
 \_\_\_\_\_ SECTION 24  
 \_\_\_\_\_ T 3 N R 8 E


TYPE MONUMENT 1/2" DRILL HOLE  
 ON SURFACE - ~~BELOW~~ ON  
 LEFT - ☉ PAV'T - RIGHT ON  
- TO - EDGE PAVEMENT  
 S.L.M. 1039+34.64

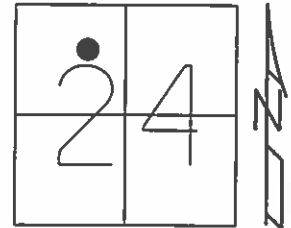

Grid: Northing: 564436.023 Easting: 1583607.516

RECORD:  
 SET A 1/2" "STAR DRILL"  
 IN CONC. AROUND MH  
 11/21/90, MB  
  
 DNF DRILL HOLE  
 SET CHISELED "+"  
 W/ EXISTING TIES  
 11/16/12, SDC

GPS, CL42  
 11/20/12, SDC  
  
 GPS, REF42  
 4/15/14, TMR  
  
 SET DRILL HOLE  
 N/S CONC. F/ SSMH  
 GPS, NEWREF42  
 7/29/14, TMR

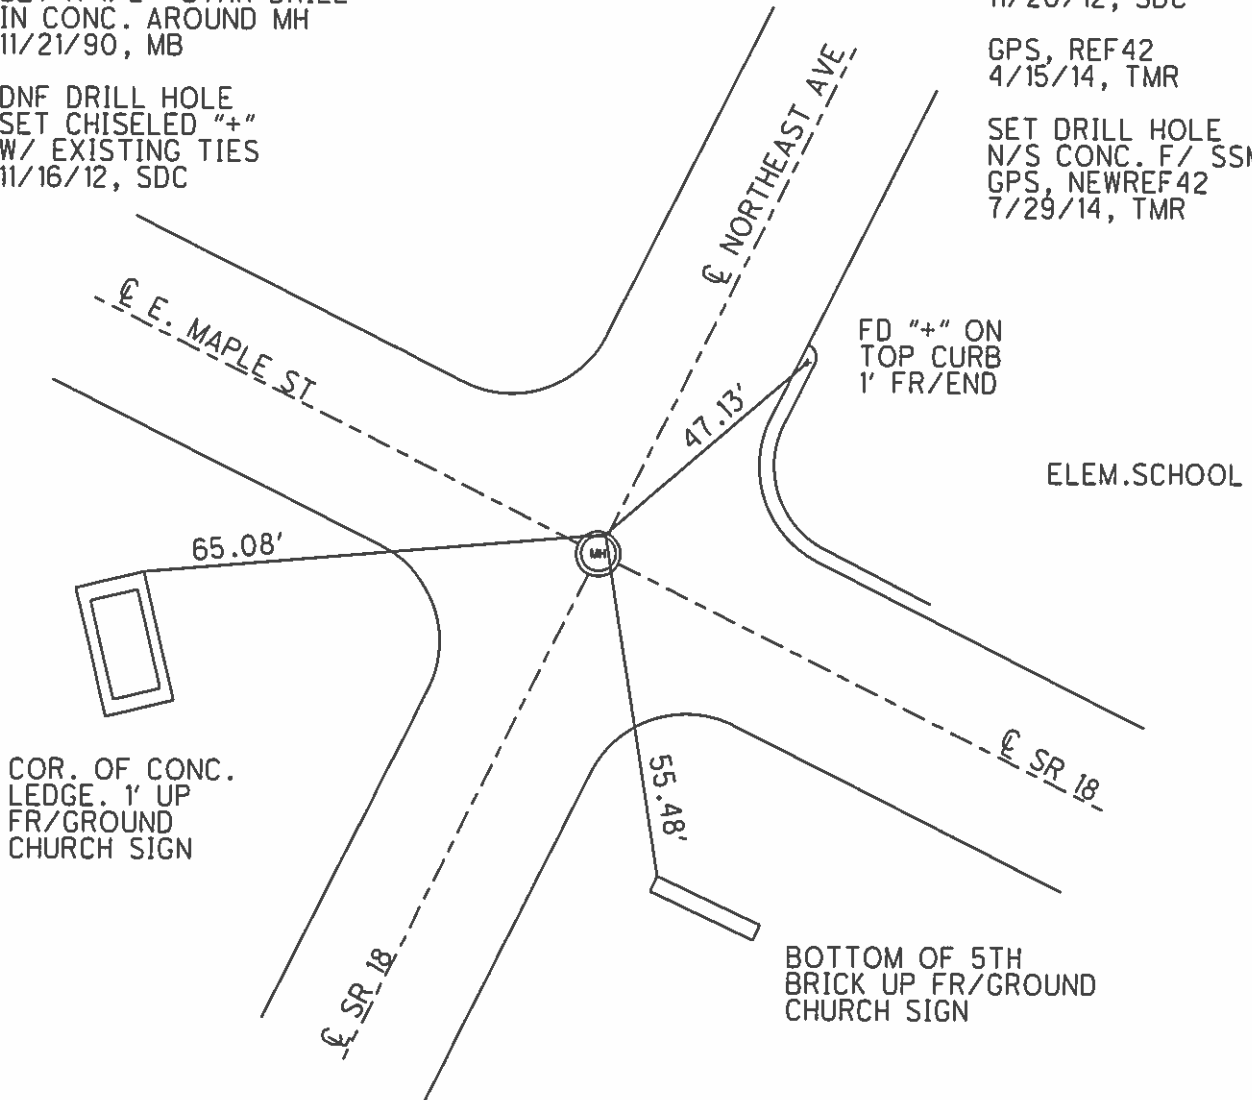

# O.D.O.T. DISTRICT 2 SURVEY OFFICE

PERSONNEL

REFERENCE NO. 42

SHEET 8 OF 14

NOTES CANTERBURY

H.C. BARNHISEL

DATE 8/8/01

ROUTE 18

R.C. MOSE

WEATHER SUN

COUNTY HENRY

TEMP. +80°

TOWNSHIP BARTLOW

SECTION 24

T 3 N R 8 E

TYPE MONUMENT 1/2" DRILL HOLE IN CONC. AROUND M.H.


ON SURFACE - BELOW SURFACE

LEFT - ☉ PAV'T. - RIGHT CNTR. OF - BOTH

— TO — EDGE PAVEMENT


S.L.M. 1039 + 29

NOT COVERED  
W/ THIS JOB

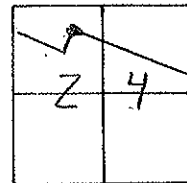

RECORD: USED "STAR DRILL" TO DRILL  
A 1/2" HOLE FOR PT., BECAUSE PT WAS  
LOCATED IN CONC. AROUND M.H.  
11-21-90  
M.B.

FUNERAL  
HOME

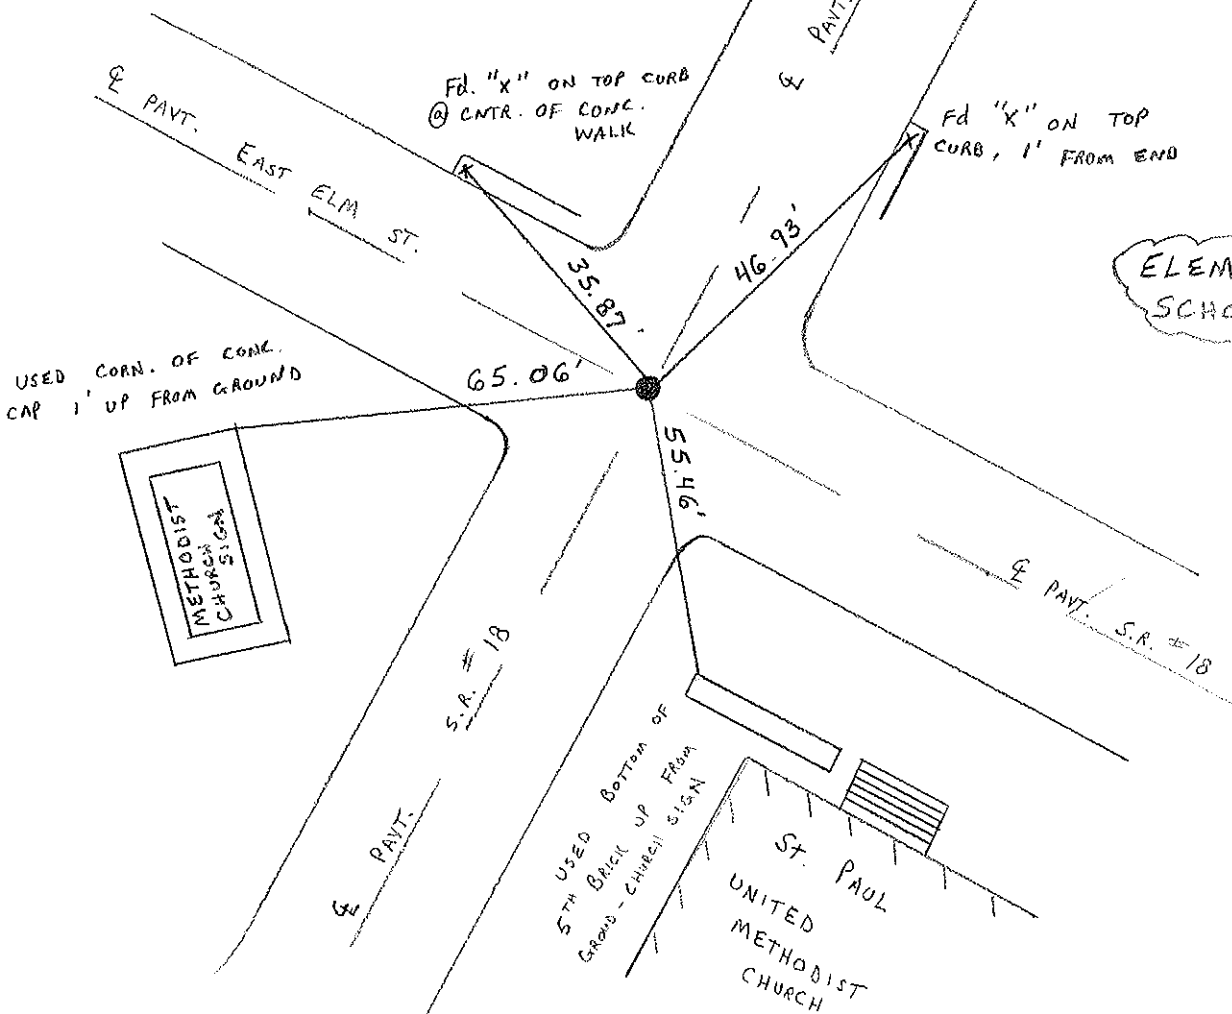

# O.D.O.T. DISTRICT 2 SURVEY OFFICE

PERSONNEL \_\_\_\_\_

REFERENCE NO. 42

SHEET \_\_\_\_\_ OF \_\_\_\_\_

NOTES BAENHISEL

H.C. " "

DATE 10-19-90

ROUTE 18

R.C. HOFFMAN

WEATHER cloudy

COUNTY HENRY

TEMP. +43°

TOWNSHIP BAETLOW

SECTION 24

T 3 N R 8 E


TYPE MONUMENT CONC. NAIL

ON SURFACE - BELOW yes

LEFT - & PAV'T. - RIGHT yes - BOTH


TO EDGE PAVEMENT

S.L.M. 1039+29

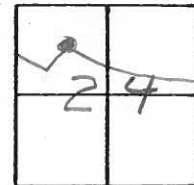

NOTE: USED "STAR DRILL"  
TO DRILL A 1/2" HOLE  
FOR PT., BECAUSE PT.  
WAS LOCATED IN CONC.  
AROUND C.B.  
11-21-90  
MB

FUNERAL HOME

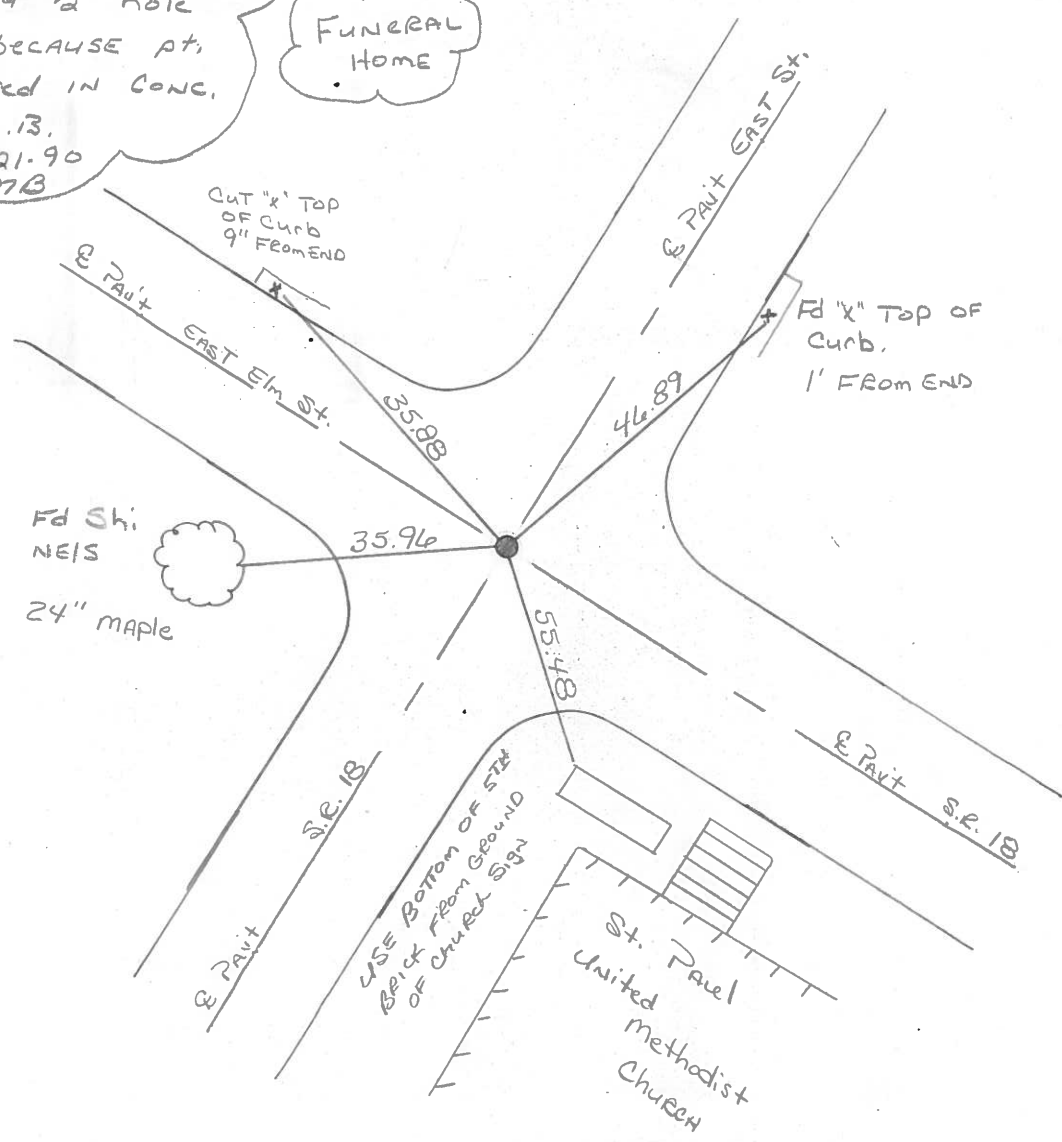

County HENRY S.R. 18

Date April 6, 83

Township BARTLOW

Weather OVERCAST

Section 24 (IN DESHLER)

Temp. +50°


T3N, R8E

Personnel HOFFMAN

#42

HOUSEHOLDER

BARNHISEL

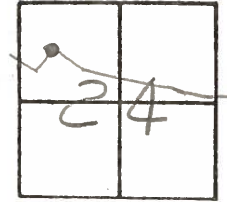


Fd SMALL R.R. spk @ surface  
 Removed & Fd. HOLE Below IN  
 CONC of M.H. Set P.K./WASHER  
 @ surface  
 POINT IS 1.4' FROM CTR of M.H. Lid

S.L.M 1039+28


SET CONCRETE NAIL  
 9-20-83  
 C.L.

NAIL IS 1.36' NORTH  
 OF CENTER OF M.H.

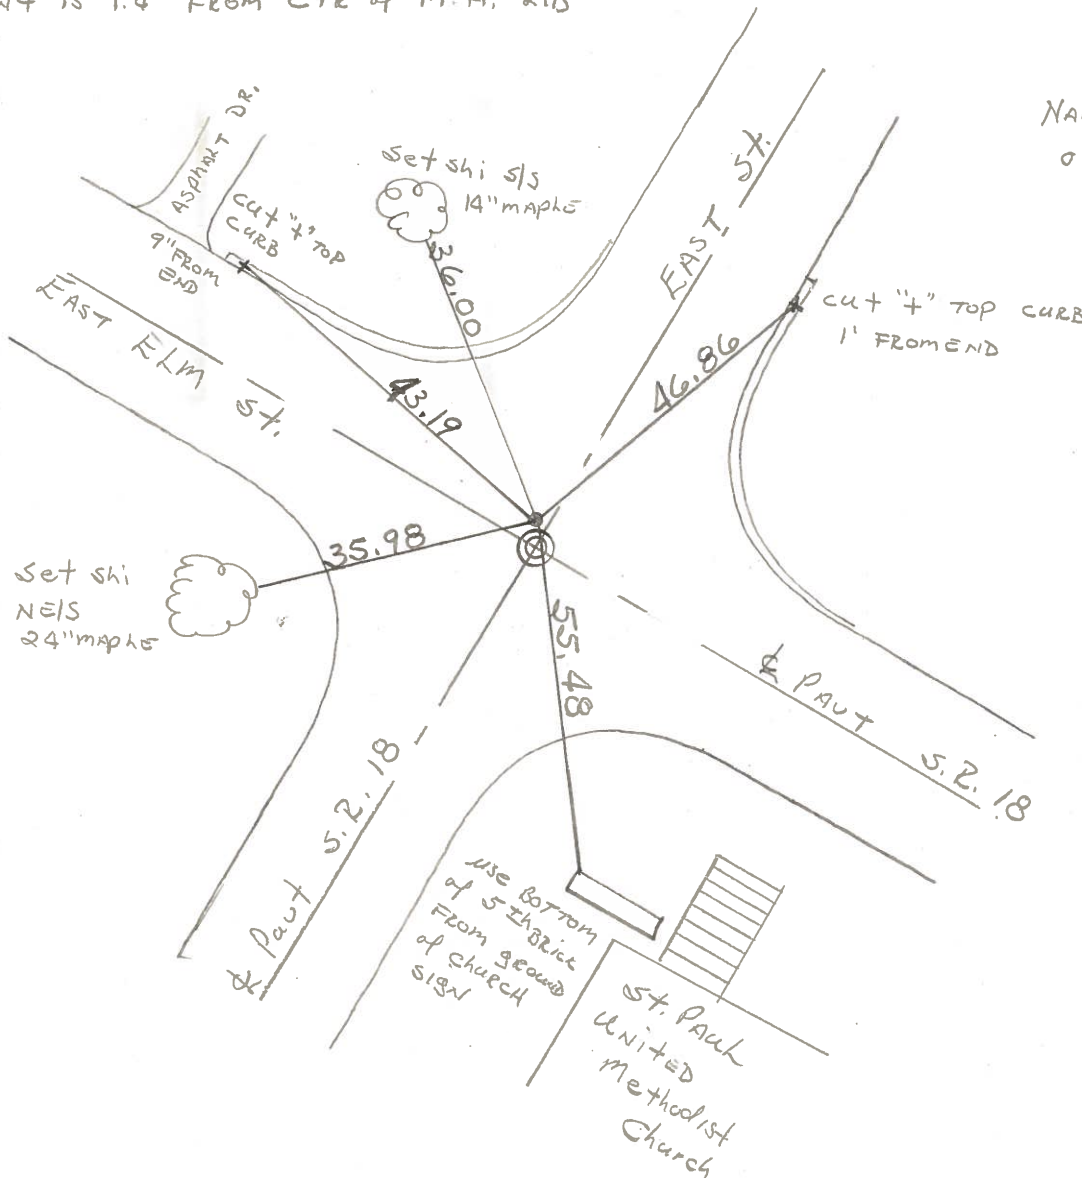

PERSONNEL	TITLE	PERSONNEL	TITLE	COUNTY	DATE
Stone				Henry	8 Oct. 74
Denno				S. R. #18	WEATHER Cool
Curtis				SEC. Bartlow Twp	TEMP. 50°
Michalek					

DESCRIPTION References to Control Points JOB NO.

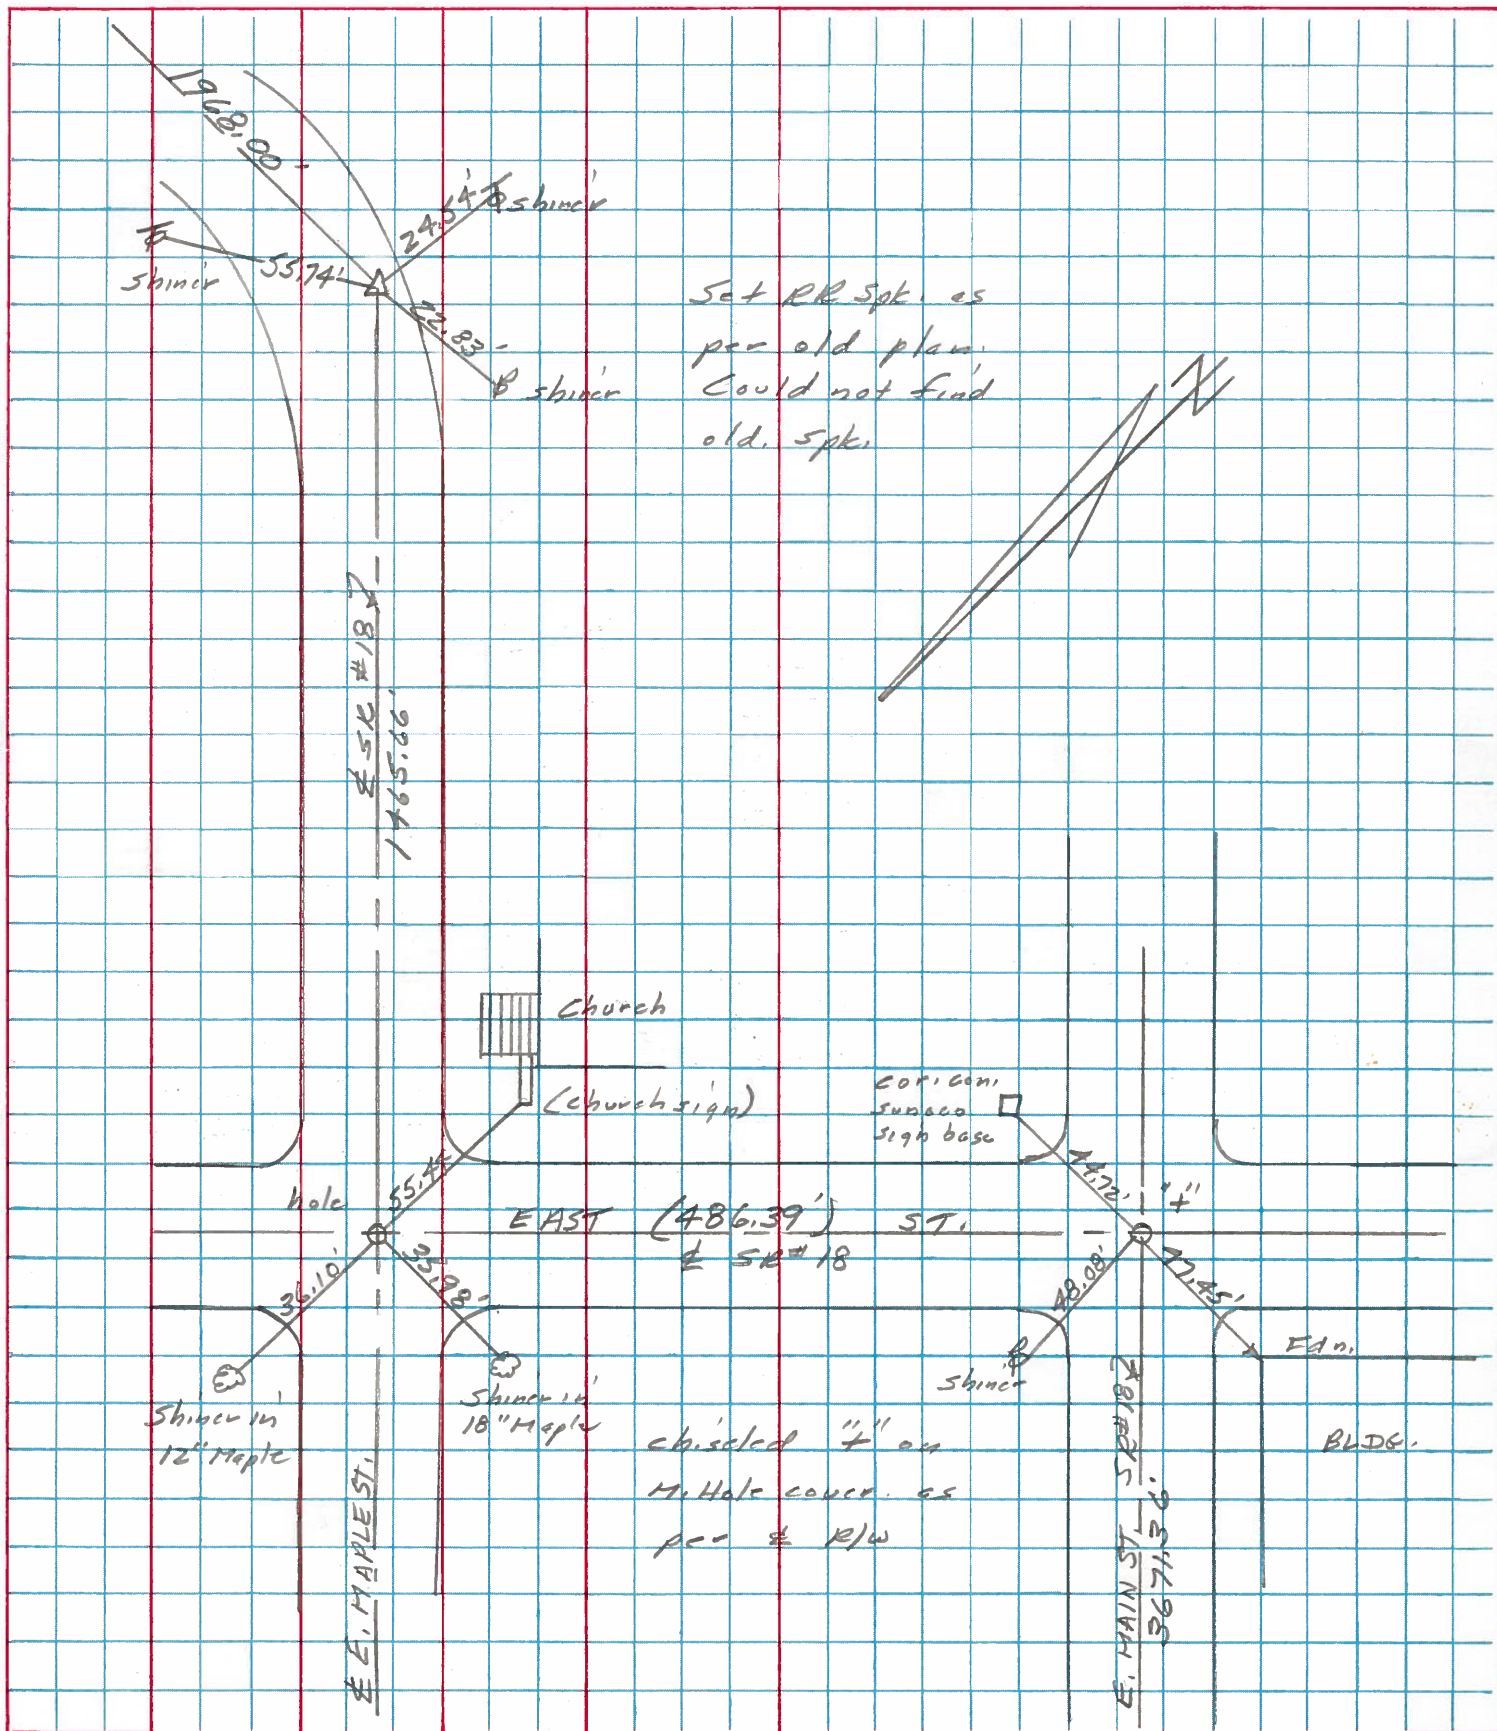



PERSONNEL	TITLE	PERSONNEL	TITLE	COUNTY	DATE	WEATHER	TEMP.
Stone				Henry	18 Sept. 74	Mild	70°
Michalak				S. R. #18			
Denno				SEC. Deshler			
Curtis							

DESCRIPTION Alignment JOB NO. 02999(6)

LEFT CENTER LINE RIGHT

